KEY PLAN SCALE 1/100

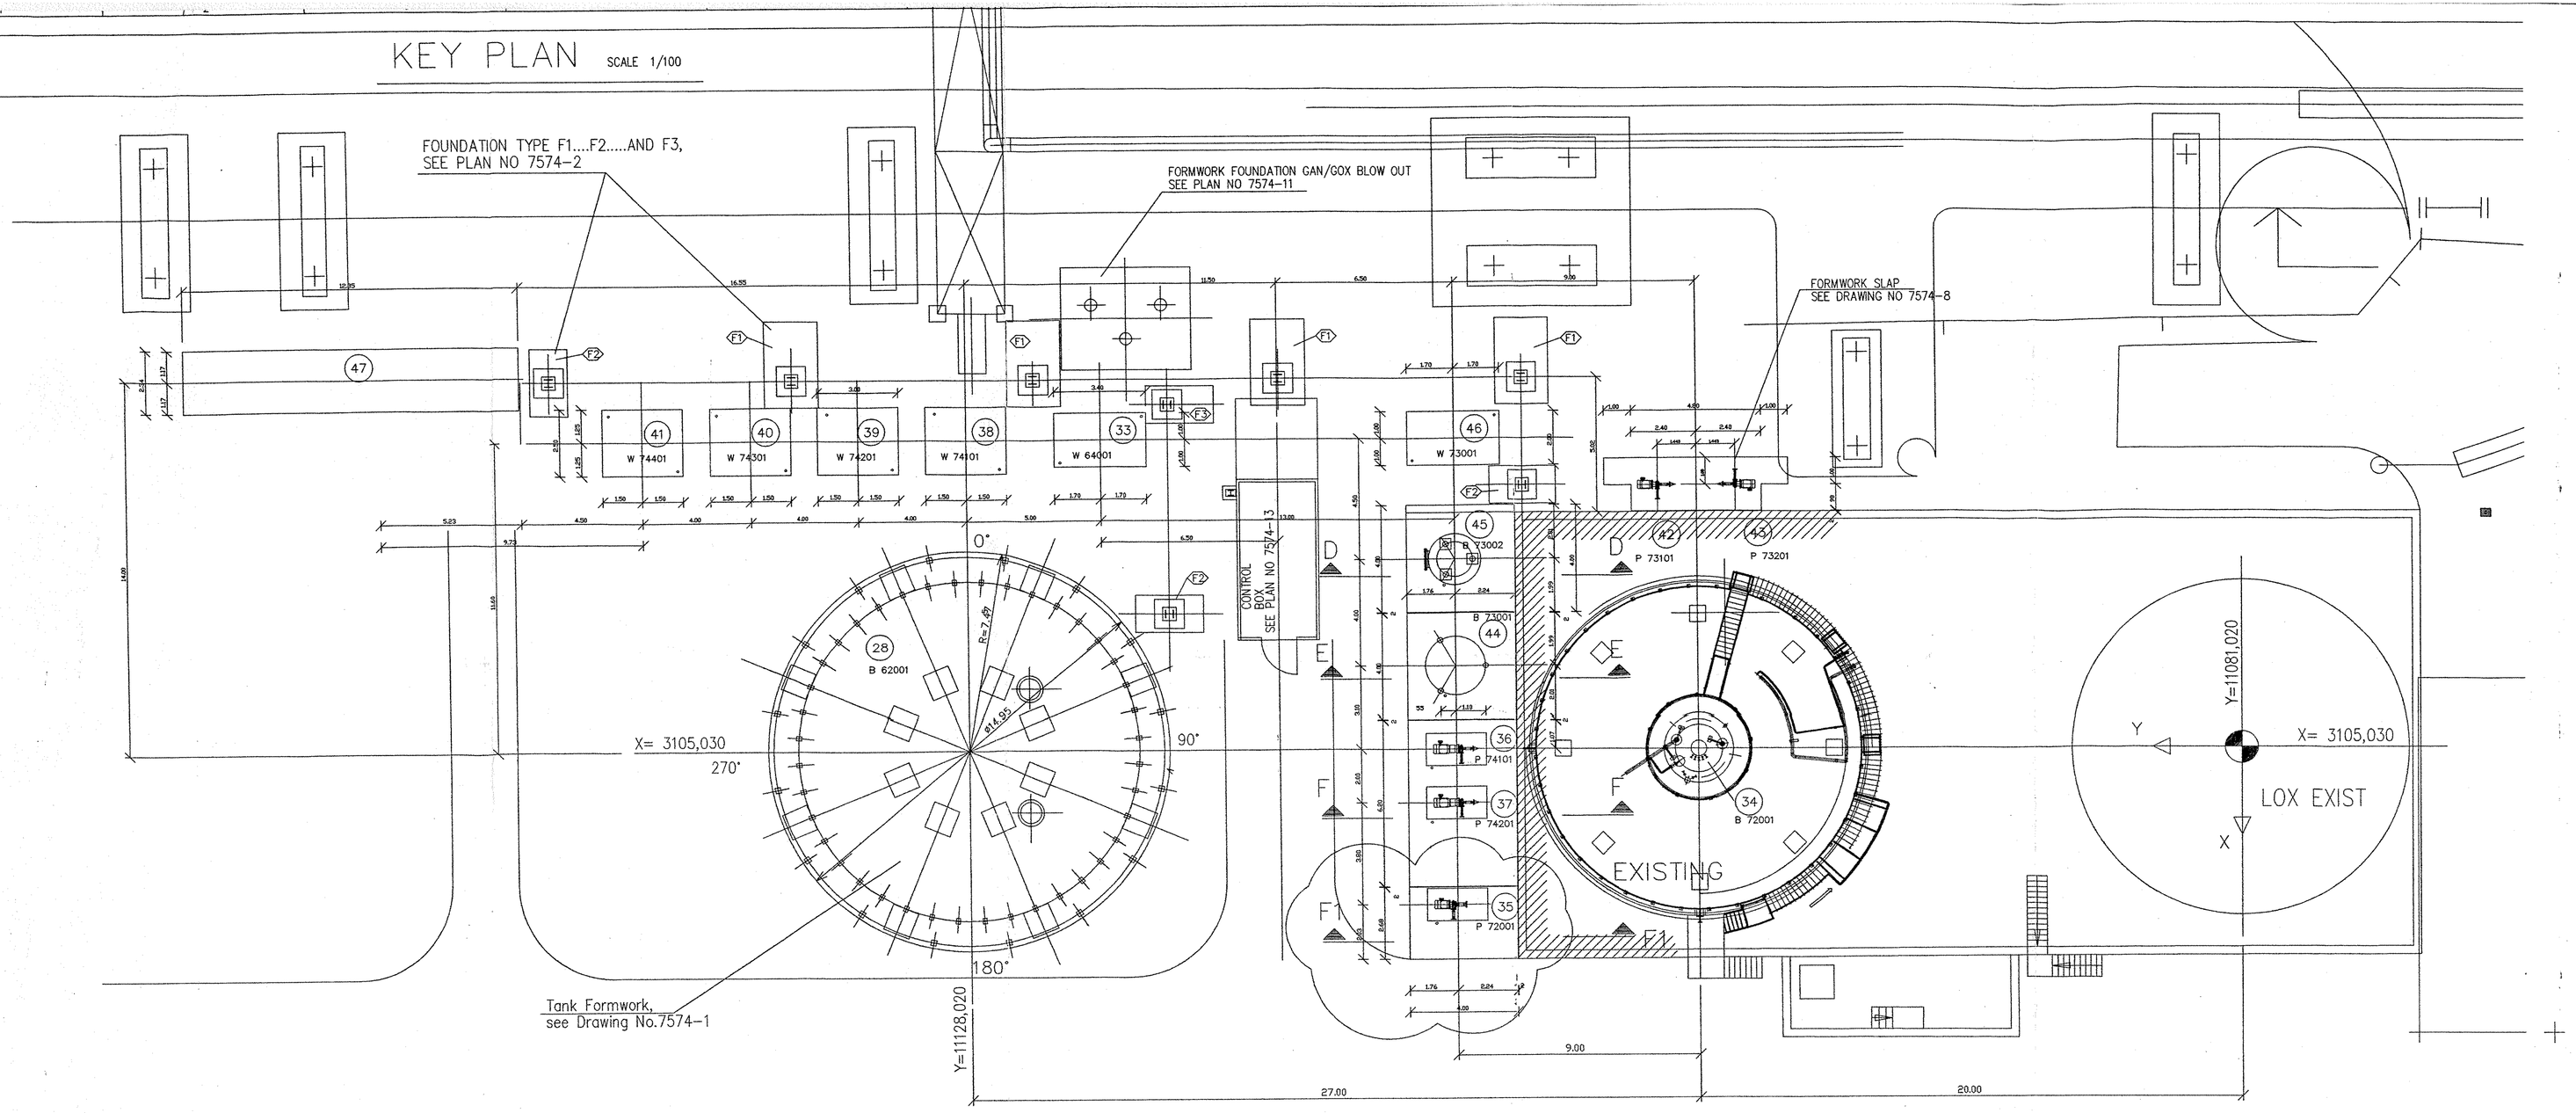

TOP VIEW FOUNDATION SCALE 1/50

TYP (33) (LOX WATER BATH VAPORIZER) W 64001

(46) (LIN WATER BATH VAPORIZER) W 73001

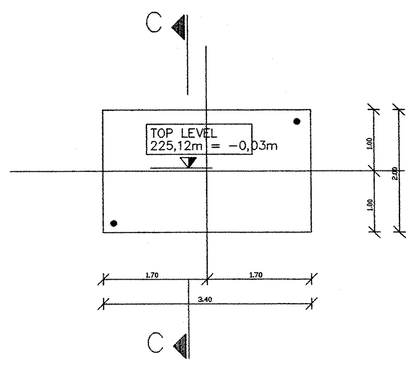

SECTION C–C

SCALE 1/50

(33) W 64001

(46) W 73001

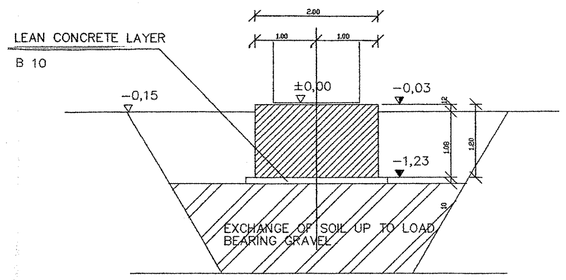

TOP OF INTERNAL ROADS: 225,00m NM. = −0,15m

BOTTOM OF STEEL STRUCTURE :

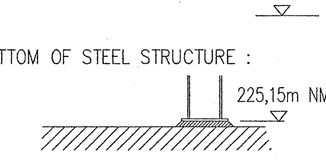

TOP VIEW FOUNDATION SCALE 1/50

TYP (47) (LIN WATER BATH VAPORIZER)

● GROUNDING STRIP
1.50 m OVER ± 0.00 NM.

SECTION A–A

SCALE 1/50

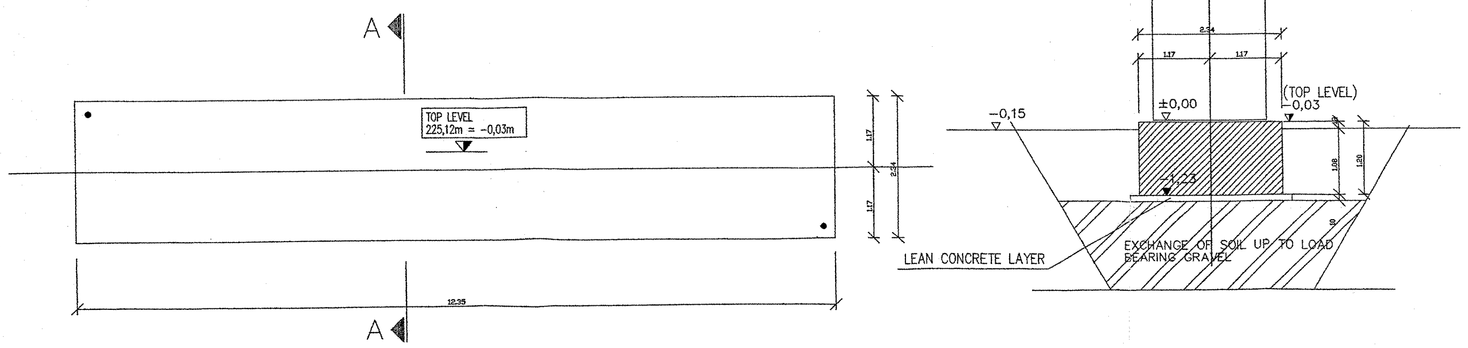

TOP VIEW FOUNDATION SCALE 1/50

TYP (38) (39) (40) AND (41) (HP–LIN VAPORIZER)

W 74101 W 74201 W 74301 W 74401

SECTION B–B

SCALE 1/50

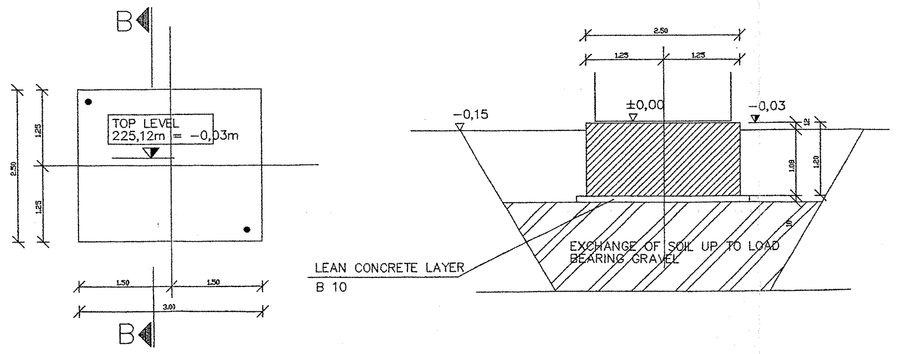

SUBSEQUENT TREATMENT OF CONCRETE ACC. TO PARTICULAR SLOVAKIAN REGULATIONS.

REQUIRED FOUNDATION PRESSURE
sigma APPROVAL = 250 KN/qm
APPRUVED MASS TOLERANCE ±0,5cm OF CONCRETE
CONCRETE GRADE : B 25

LEVEL OF STRUCTURE WITHOUT FINISH

LEVEL OF STRUCTURE WITH FINISH

LEVEL OF STRUCTURE WITHOUT FINISH = LEVEL OF STRUCTURE WITH FINISH

SECTION D–D

SCALE 1/50

FOUNDATION–TYP (45) (HP–GAN RESERVOIR)

B 73002

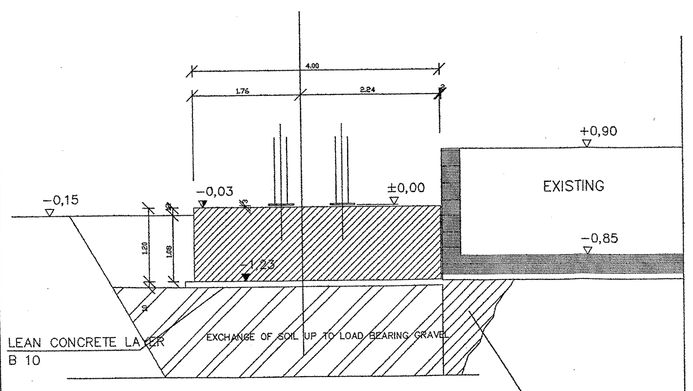

SECTION E–E

SCALE 1/50

FOUNDATION–TYP (44) (MP–LIN STORAGE TANK)

B 73001

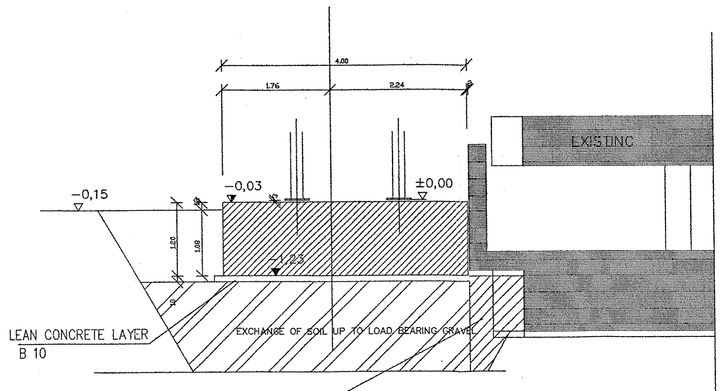

TO BE FILLED UP ALTERNATELY WITH CONCRETE B 15 IN SEPERATE SECTORS

SECTION F–F

SCALE 1/50

FOUNDATION–TYP (36) (37) (LIN TRUCK FILLING PUMP) (HP –LIN BACKUP PUMP)

P 74101 P 74201

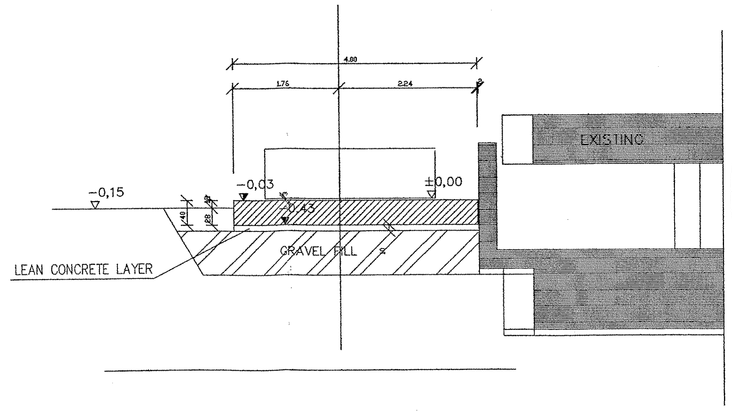

SECTION F1–F1

SCALE 1/50

FOUNDATION–TYP (35) (LIN TRUCK FILLING PUMP)

P 72001

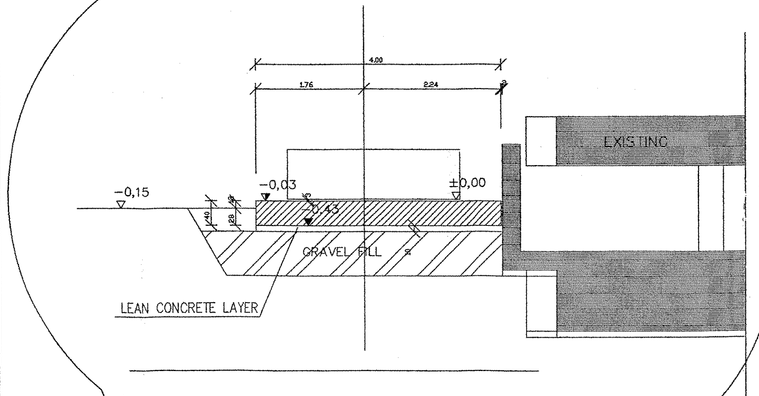

PROJEKT SKUTOČNÉHO VYHOTOVENIA

FREIGABE FOR CONSTRUCTION Ra 14.12.04

Stand 10.12.04

Rev.	Revisions	Date	Name	checked
A	P 72001	06.12.04	SP	M. Orth
0	FirstDeliveri	23.09.04	SP	M. Orth

Plan–No.: 7574–2

SUBJECT: TANK FARM
FOUNDATION FORMWORK PLAN
KEY PLAN ASU NO. 9

Dipl.–Ing. Mühlhäusler
Dipl.–Ing. Weisang
KMI
Saarbrücker Strasse 9 – 10
66130 SAARBRÜCKEN–BREBACH
Tel.:(0681)88313–0 Fax:(0681)88313388

AIR LIQUIDE
Air Liquide AGS GmbH

Date :	Name :	Checked :	History file :
06.09.2004	Speicher	M.Orth	792.87041–002.doc

Job code: K70101
Reference: ASU No. 9 KOSICE
Scale 1:50 1:100
Original format A0
Sheet: 002 of Sheets
Replaces: 79_-------
Replaced by: 79_-------
Title: TANK FARM
Drawing No.: 792.87041
Rev. A

Diese Zeichnung ist urheberrechtlich geschützt. Sie darf ohne unsere schriftliche Genehmigung weder vervielfältigt noch in irgendeiner Weise verwertet oder Dritten mitgeteilt bzw. weitergegeben werden.