



TOP VIEW FOUNDATION
TYP (47) (LIN WATER BATH VAPORIZER)

SCALE 1/50
2x5=10x8/20/12.00

1X

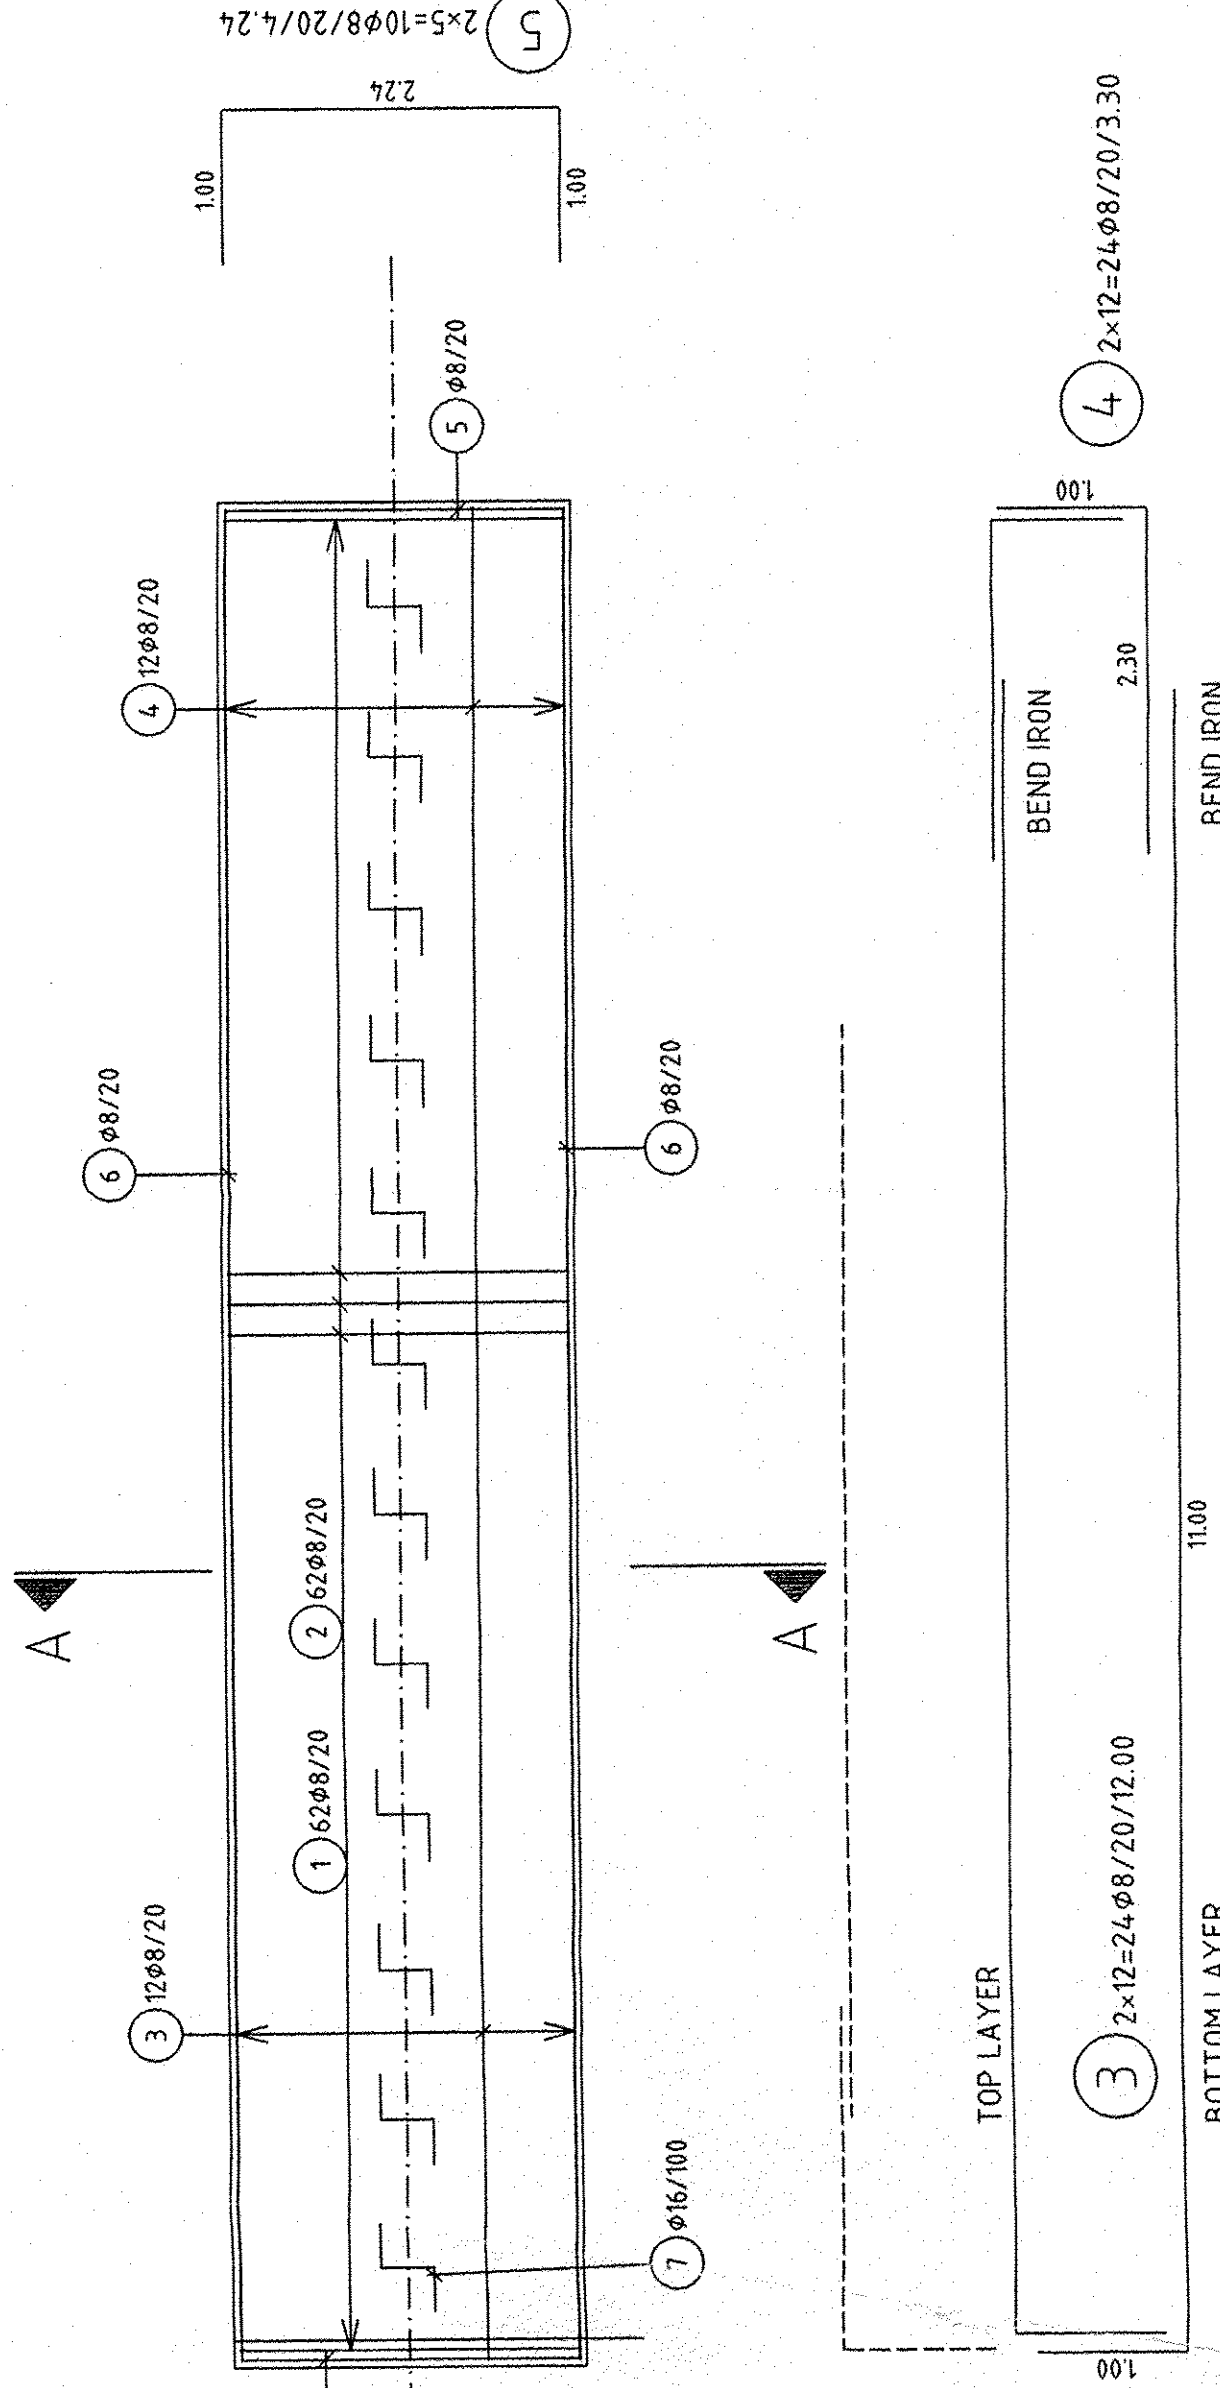


SECTION A-A
SCALE 1/50

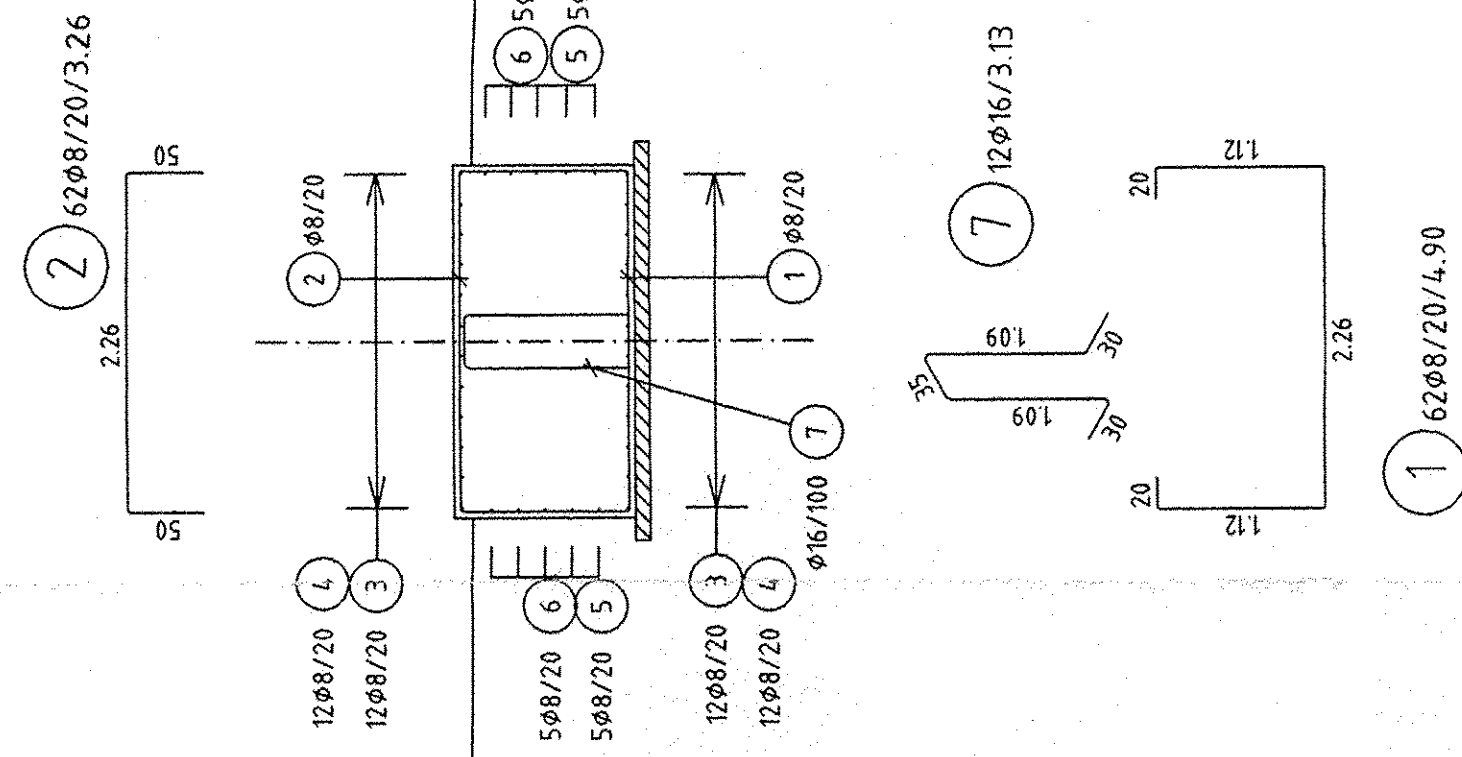


TOP VIEW FOUNDATION
TYP (38) (39) (40) AND (41) (HP-LIN VAPORIZER)

SCALE 1/50
4x

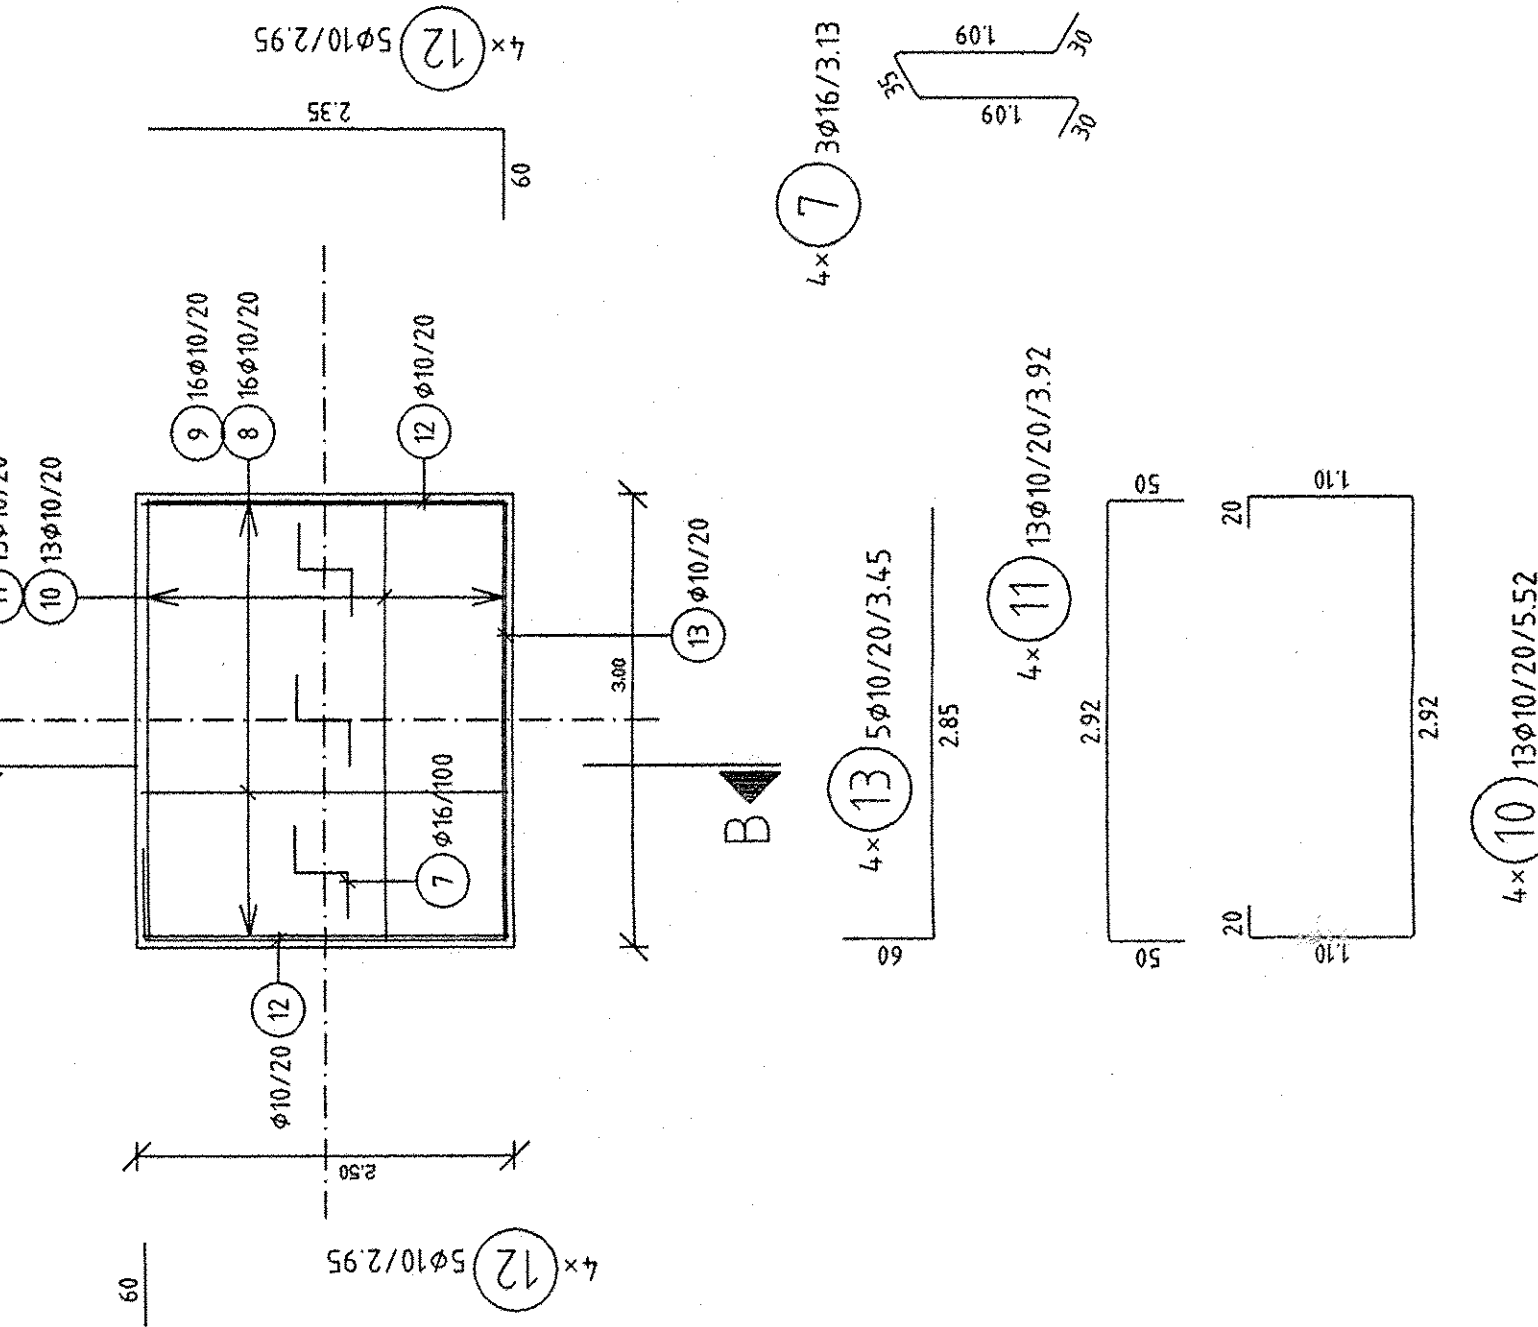


SECTION B-B
SCALE 1/50

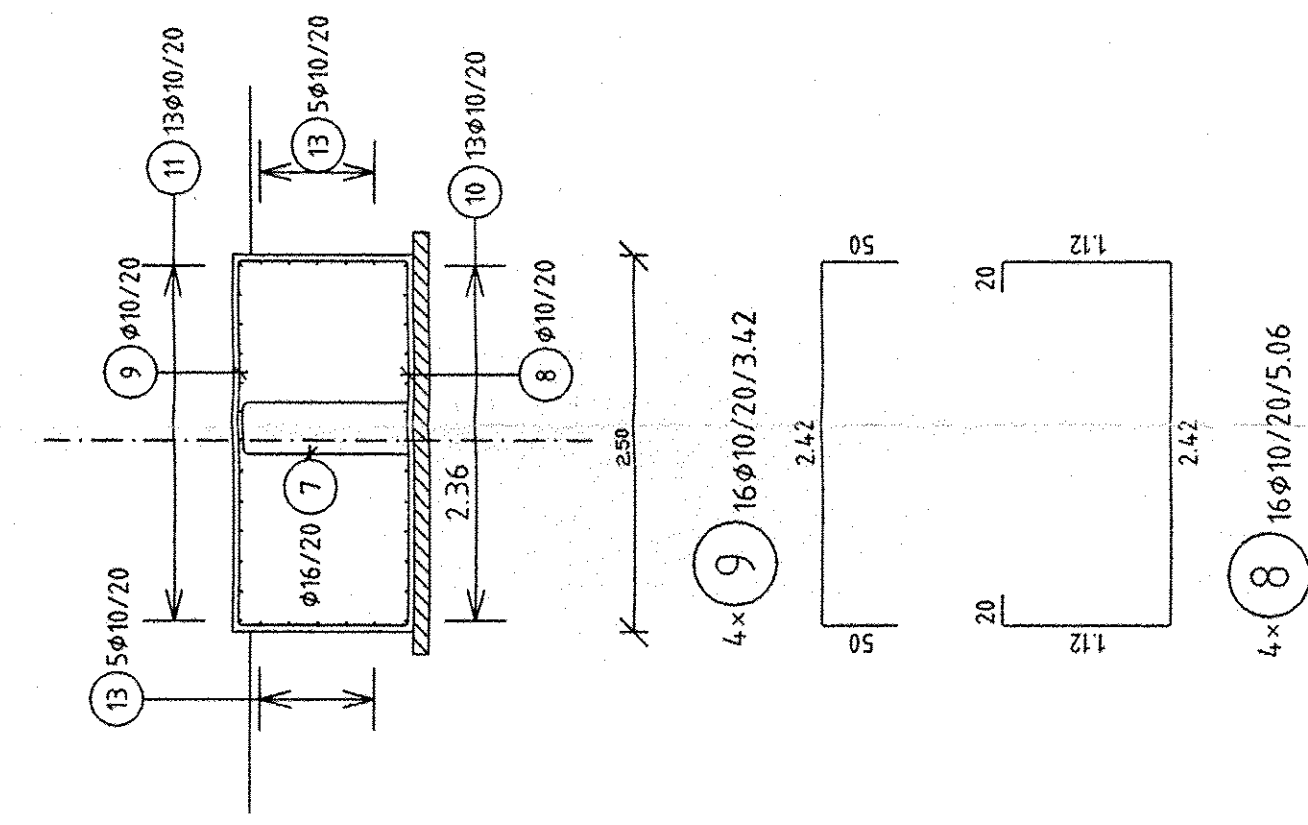

2X

TOP VIEW FOUNDATION
TYP (33) (LOX WATER BATH VAPORIZER)
(46) (LIN WATER BATH VAPORIZER)

SCALE 1/50

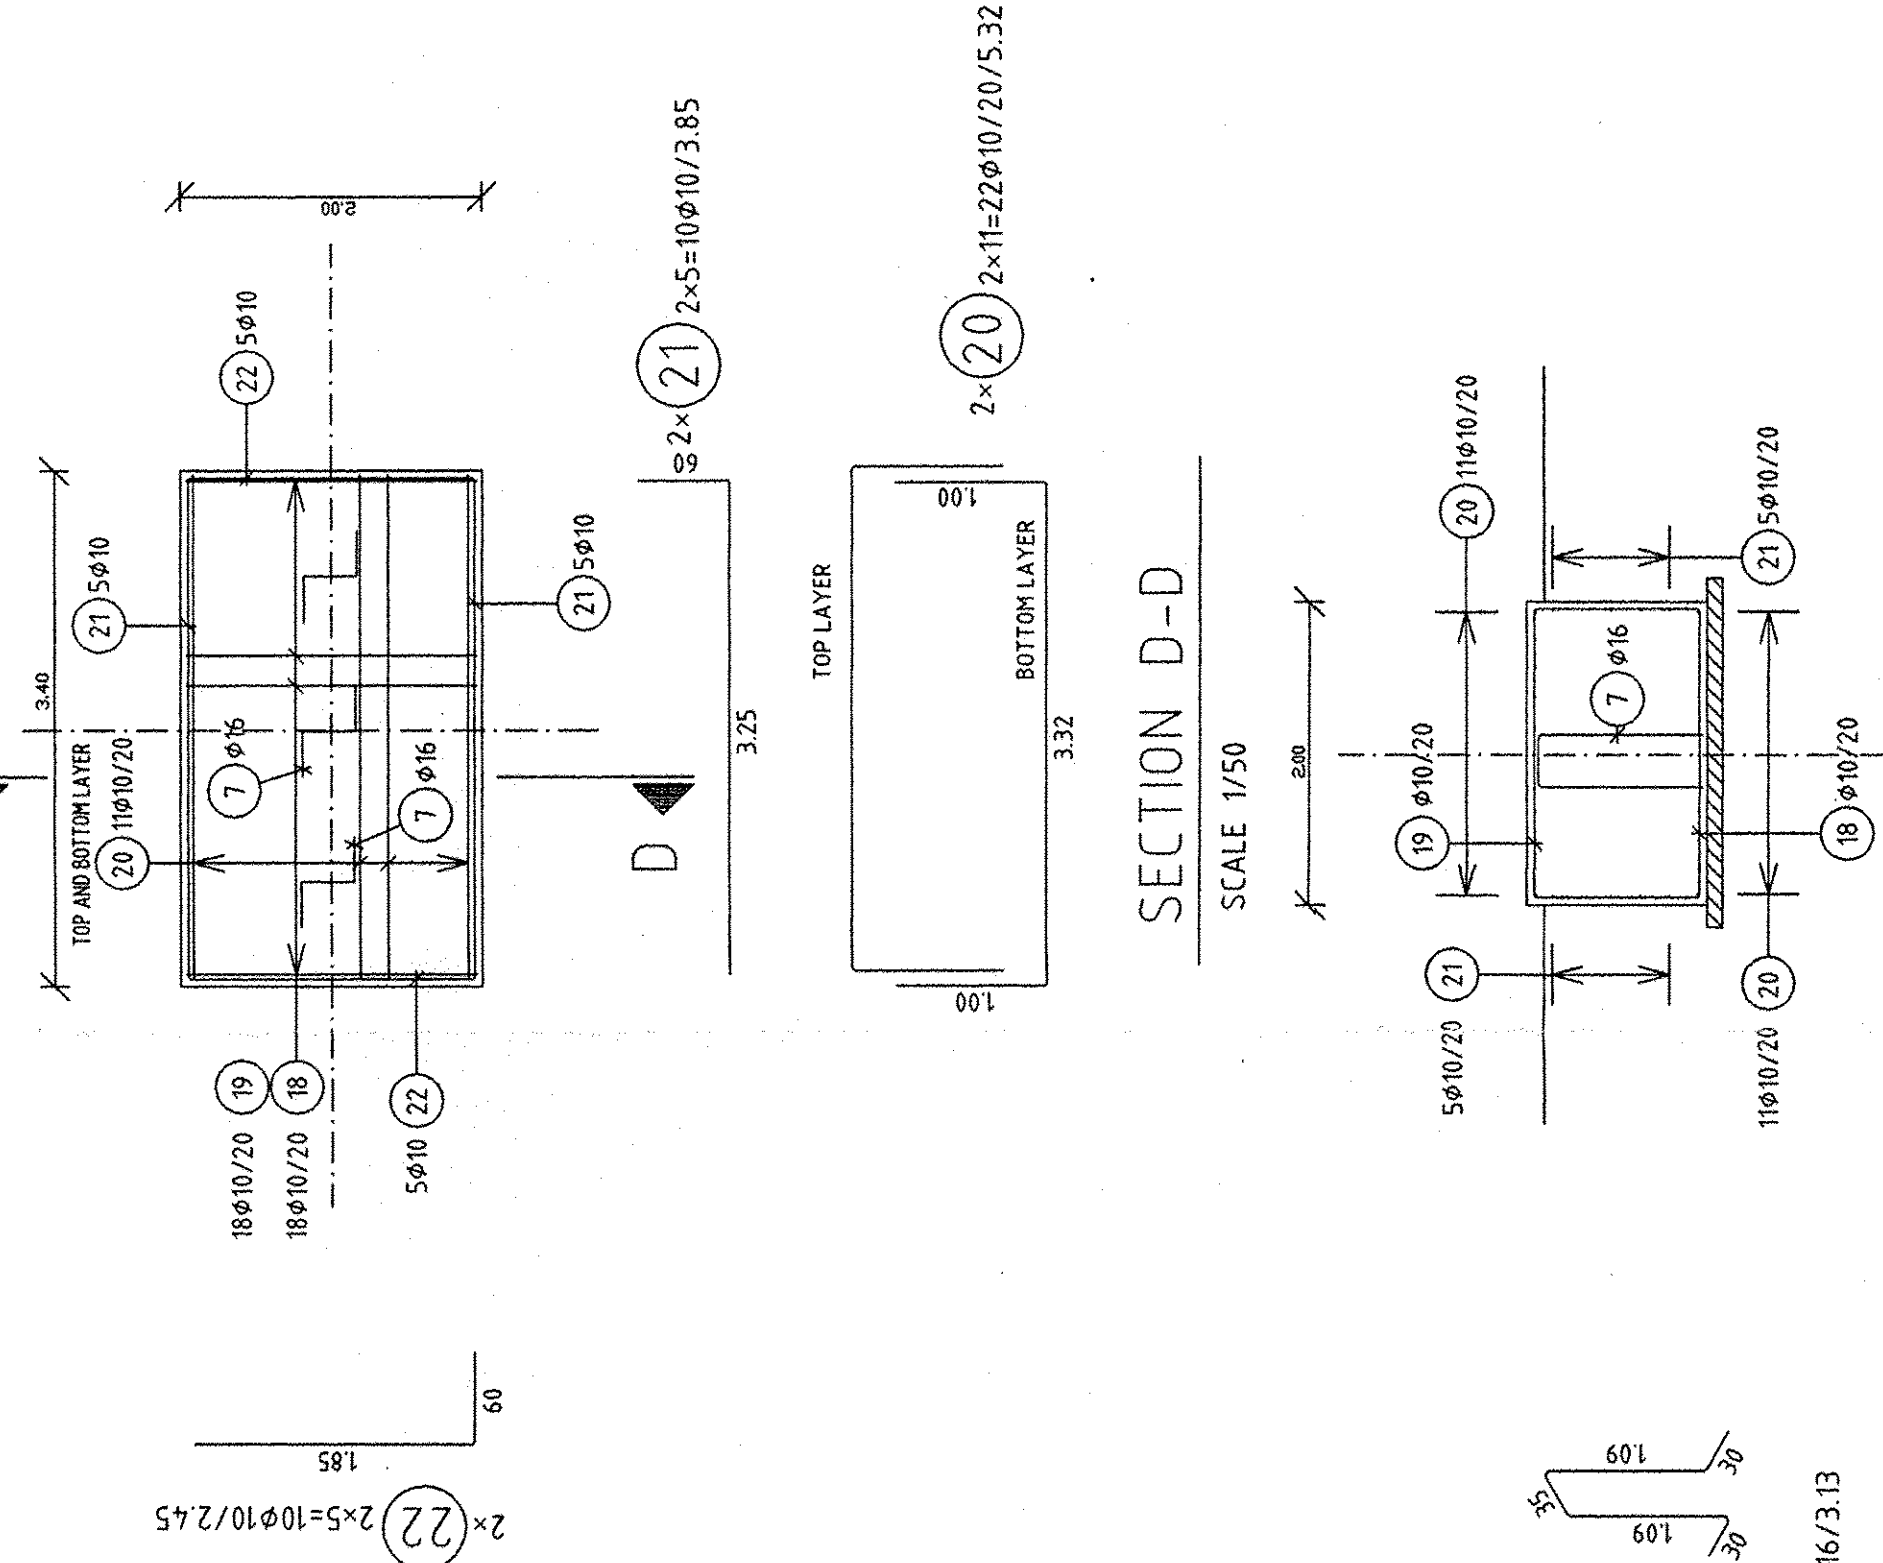

SECTION D-D
SCALE 1/50


2x(20) 2x11=22x10/20/5.32

TOP VIEW FOUNDATION

SCALE 1/50

FOUNDATION-TYP (44) (HP-LIN STORAGE TANK)
FOUNDATION-TYP (45) (HP-GAS RESERVOIR)

2X

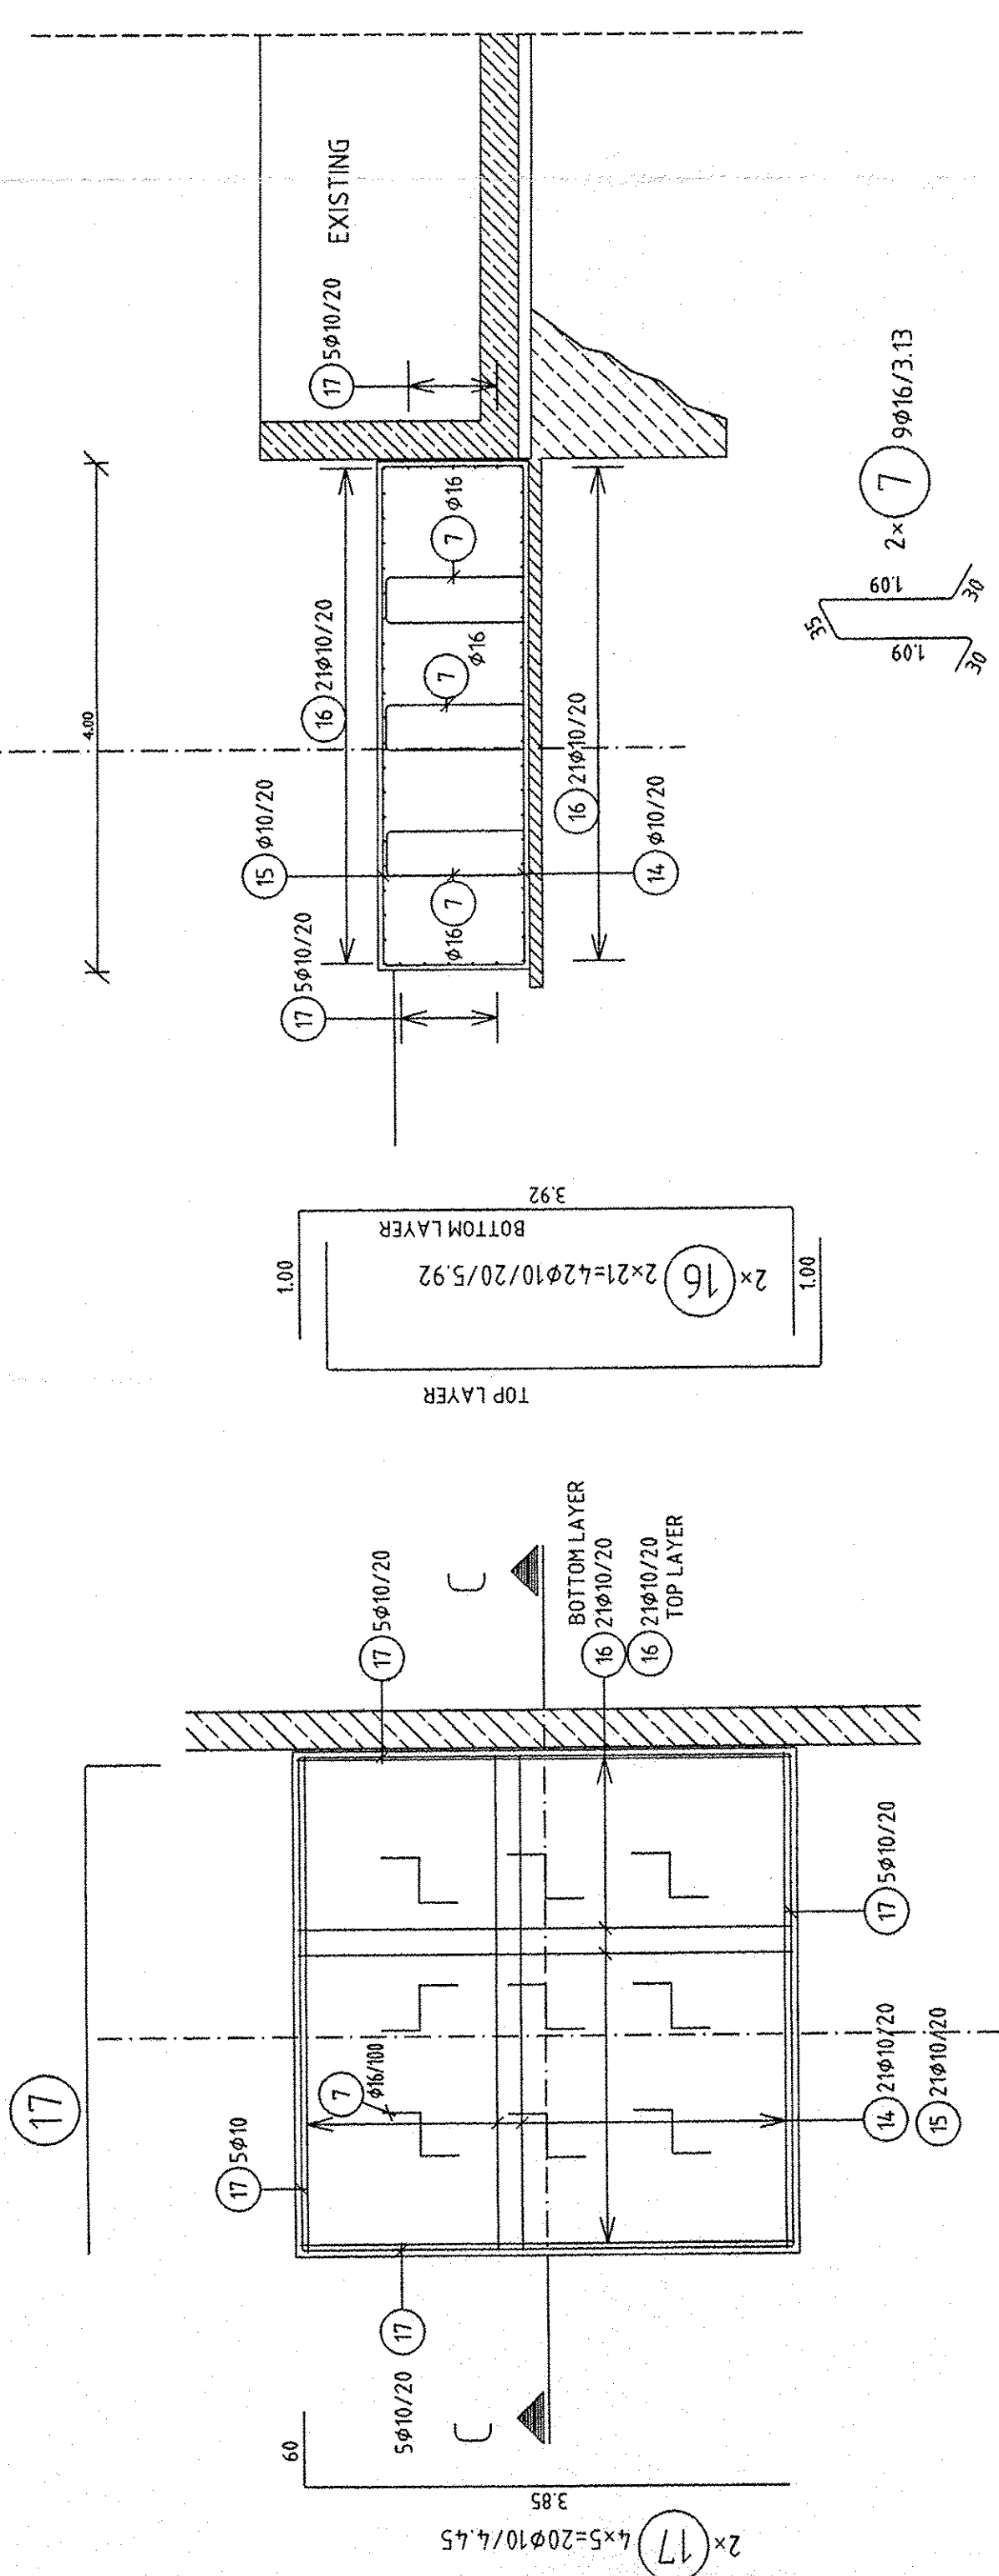


TOP VIEW FOUNDATION

SCALE 1/50

FOUNDATION-TYP (35) (36) (37) (LIN TRUCK FILLING PUMP)
FOUNDATION-TYP (35) (36) (37) (HP-LIN BACKUP PUMP)


1X

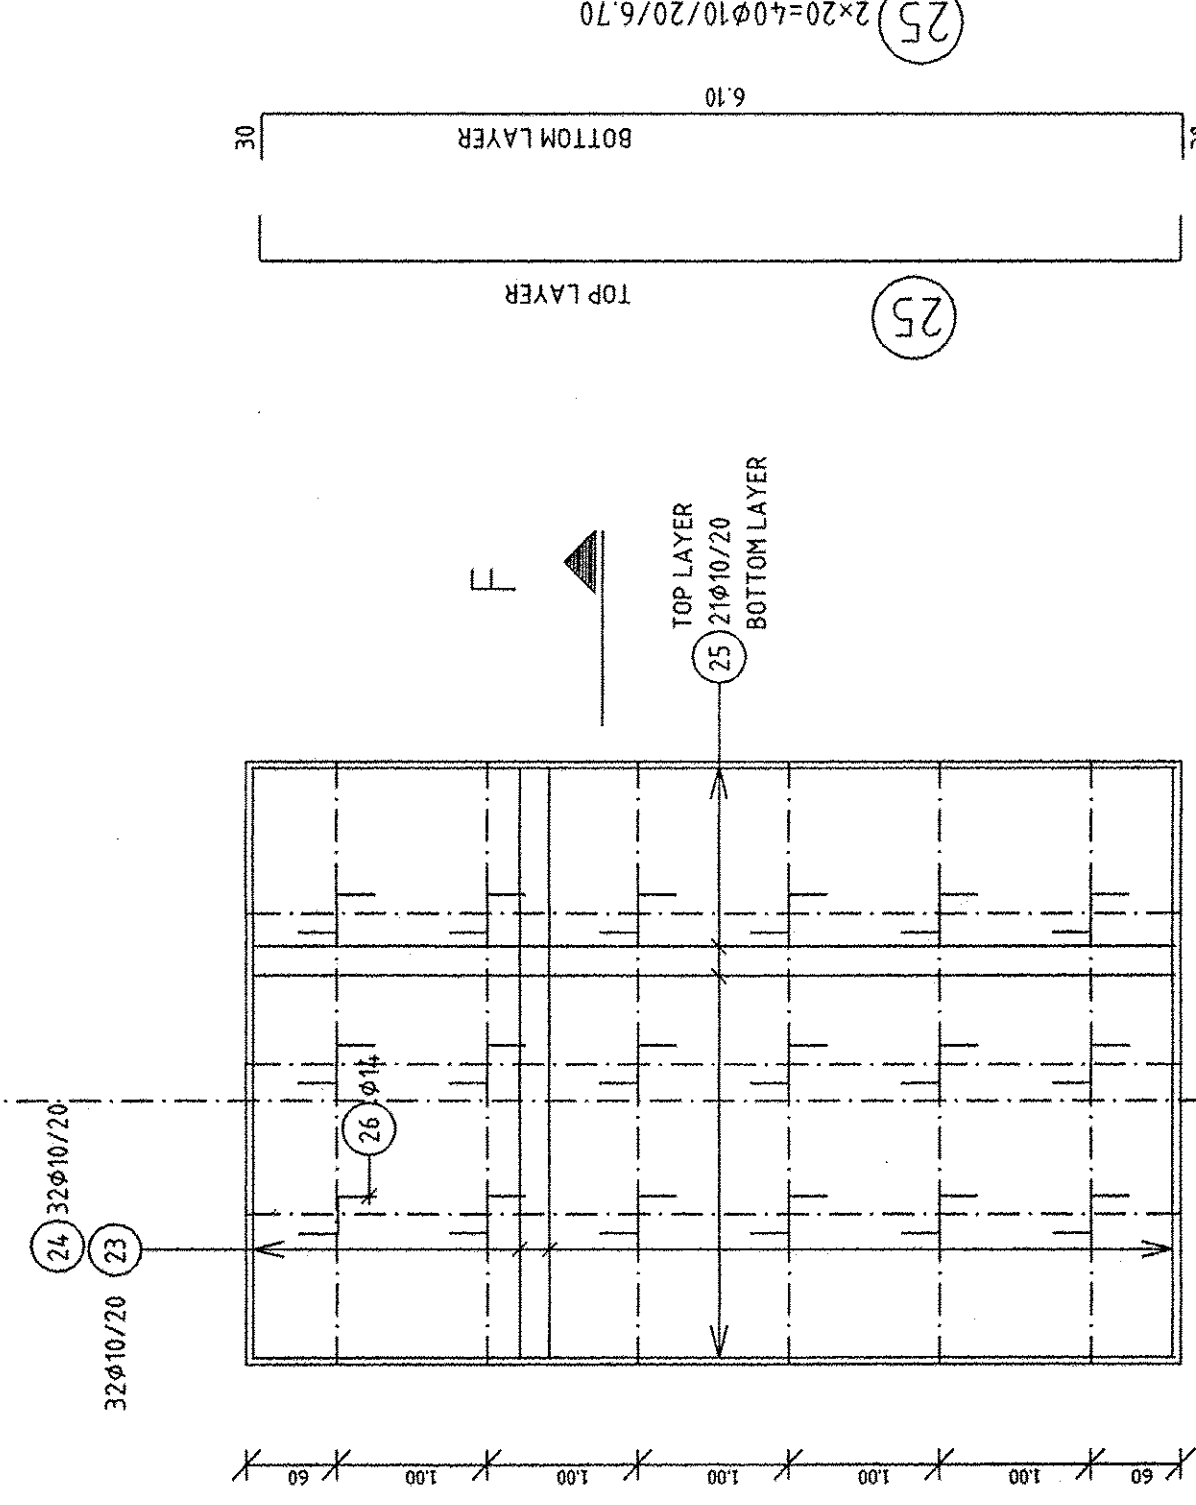


SECTION F-F
SCALE 1/50

FOUNDATION-TYP (35) (36) (37)

26) 6x3=18x14/133

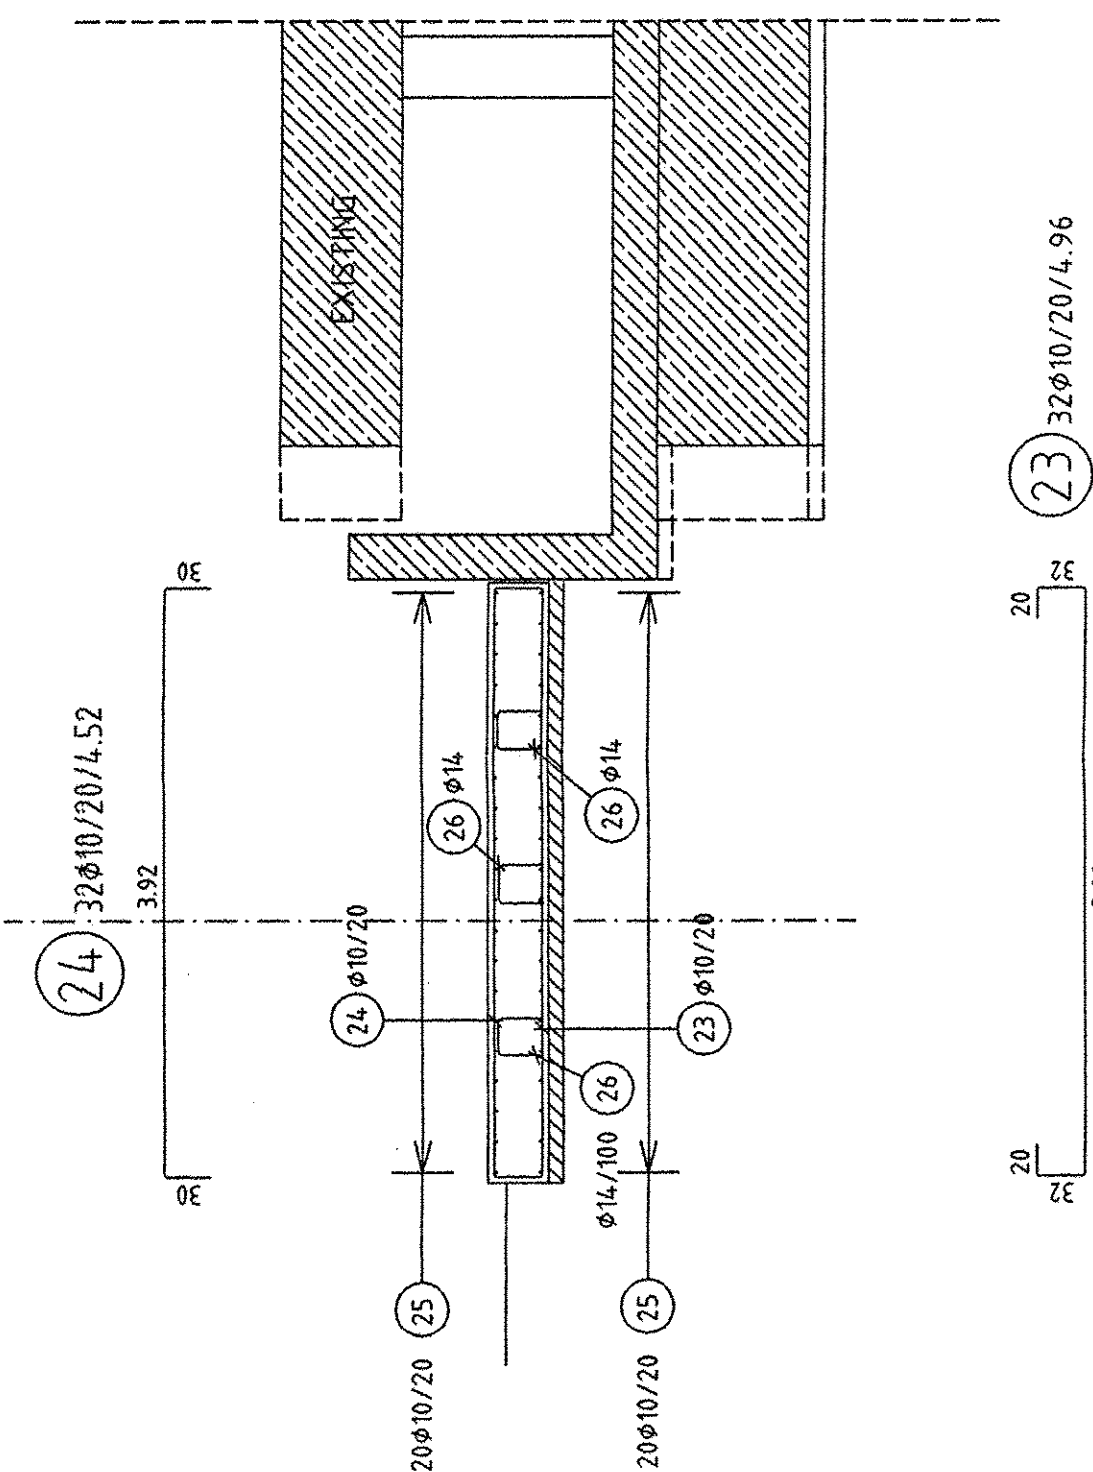

KEY PLAN
SCALE 1/200

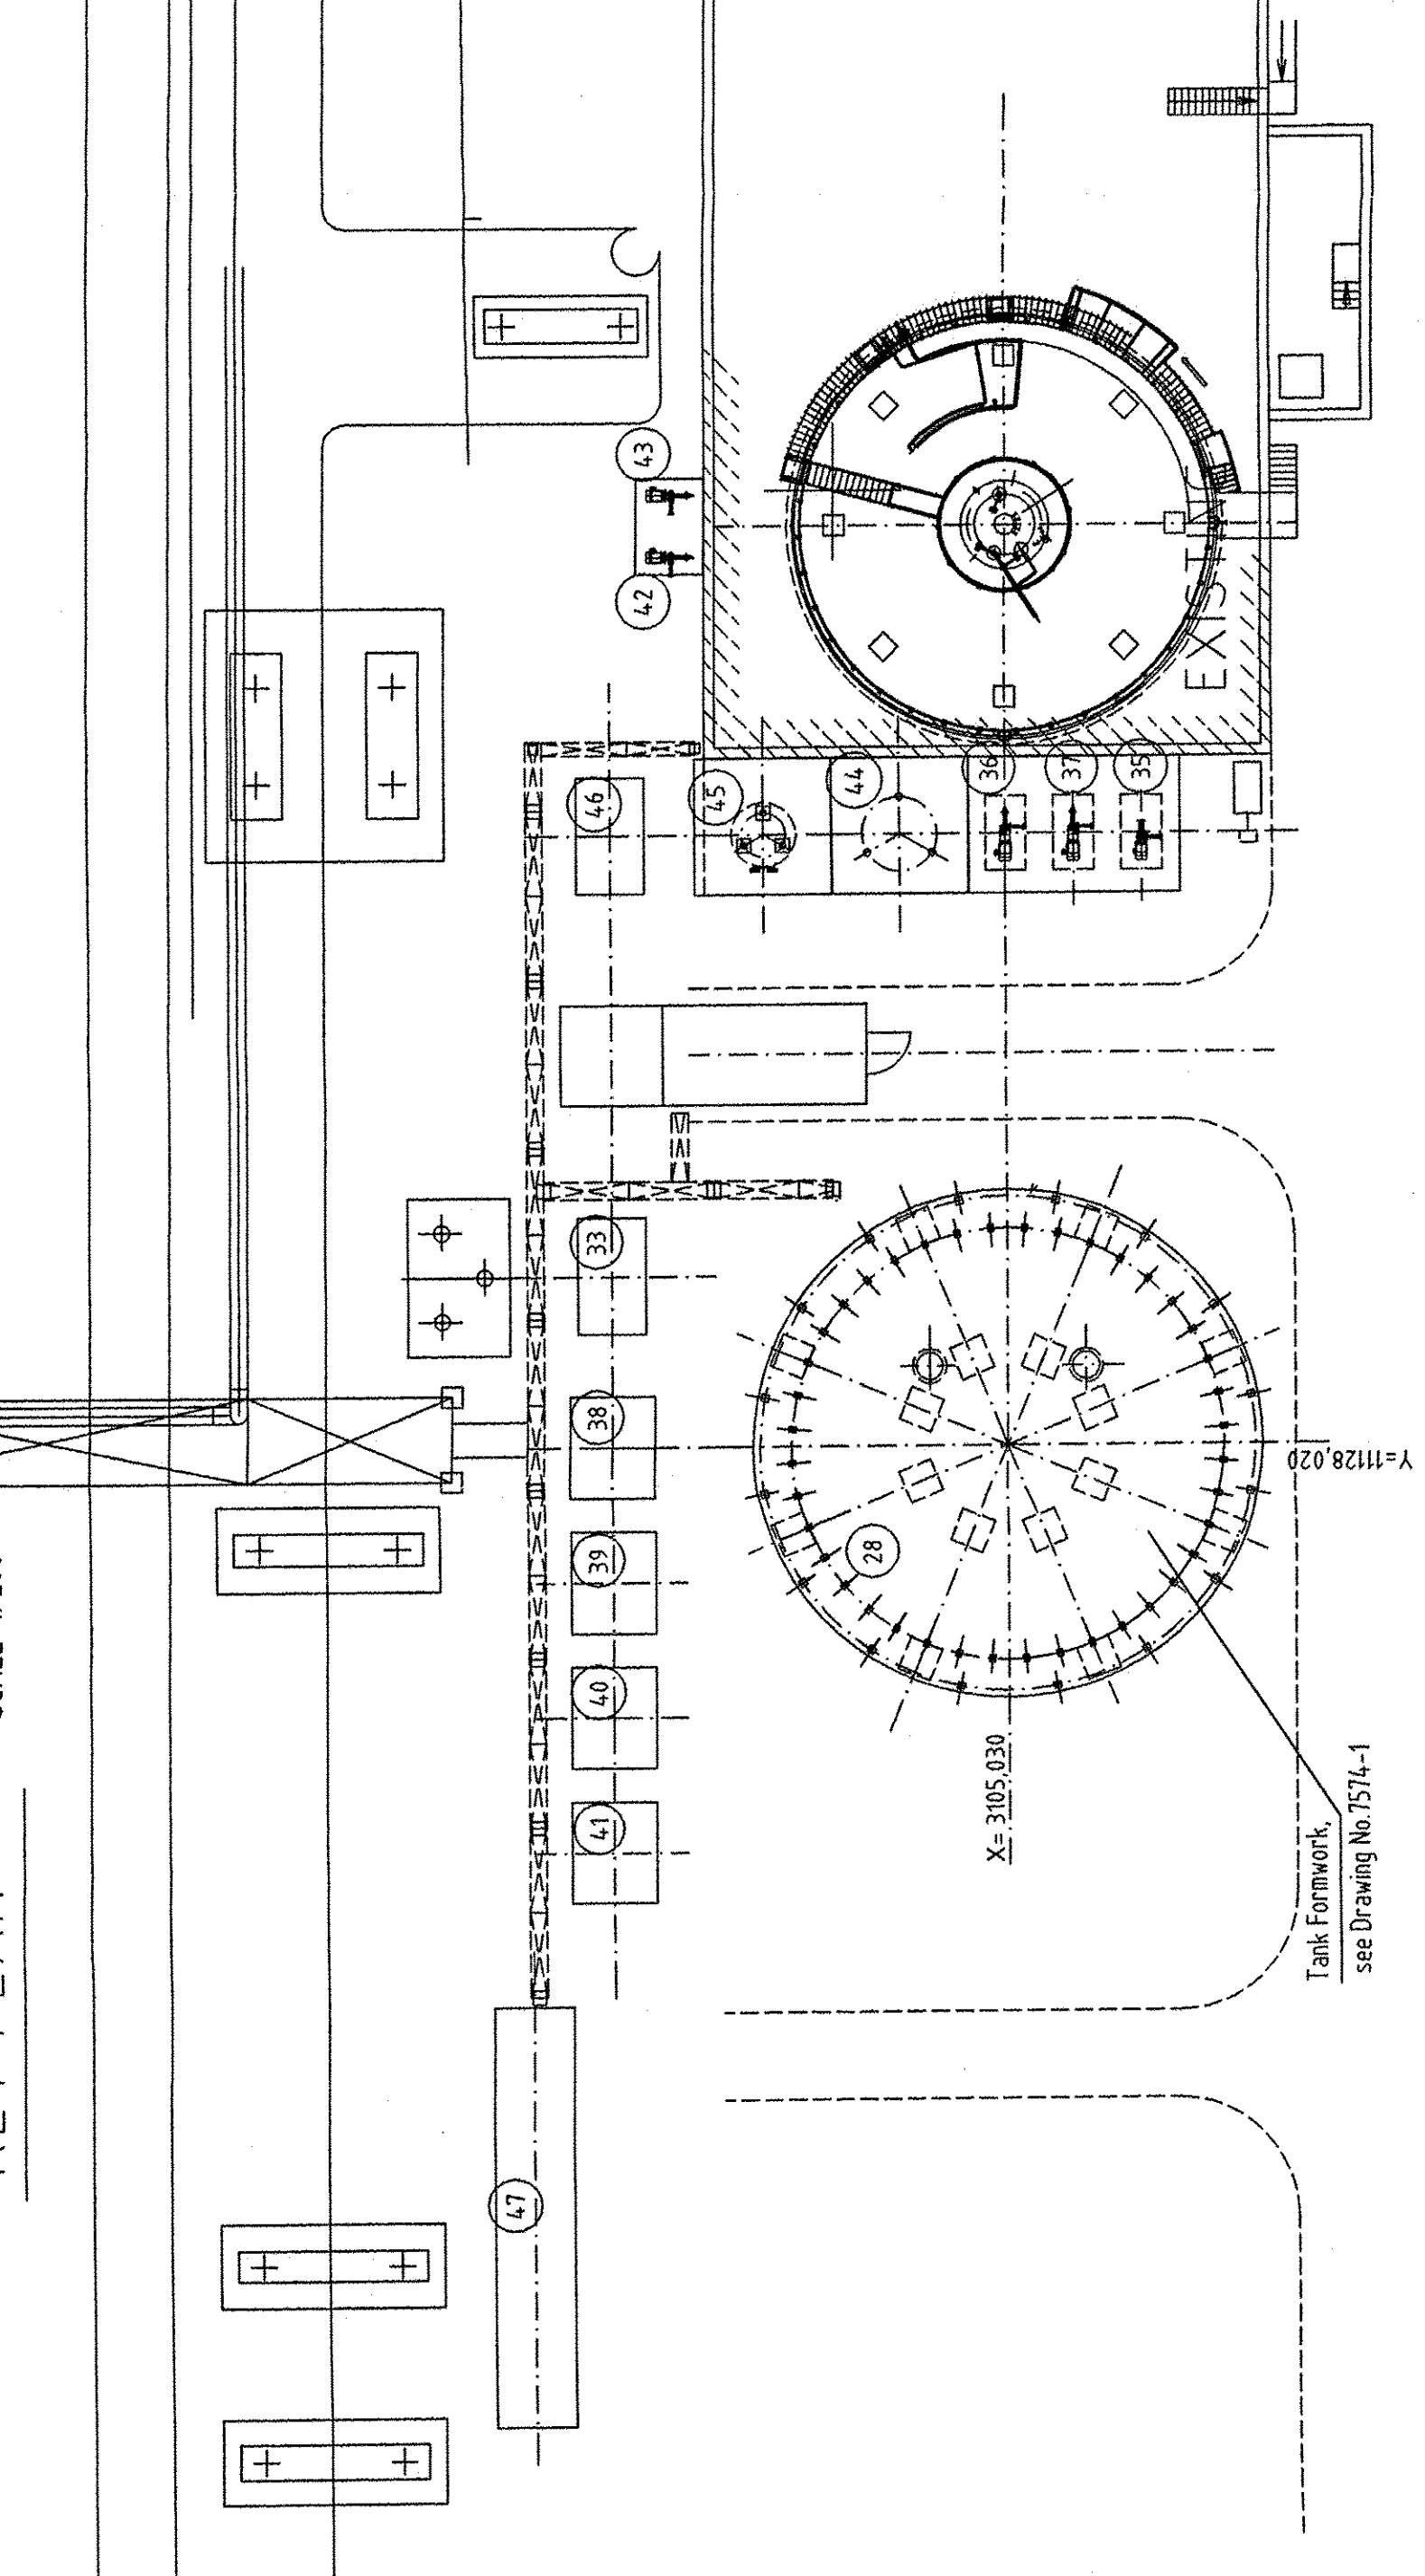

CURING AFTER CASTING OF CONCRETE ACC. TO
THE RESPECTIVE DIRECTIONS.
(FREE SURFACES OF CONCRETE TO BE COVERED AND
MOISTENED DURING TWO WEEKS)

SEE DRAWING-No: 7574-2
(FOUNDATION TANK FARM FORMWORK)

PROJEKT SKUTOCNEHO
TECHNICKY DOKUMENT
HS HSY s.r.o. KOSICE

FOR CONSTRUCTION
FREIGABE

Plan-Nr. : 7574-5	REINFORCEMENT	FOUNDATION TANK FARM
SUBJECT:	FOUNDATION TANK FARM	

MATERIAL:
CONCRETE GRADE: B 25
BST 500 (BST IV)

CONCRETE COVER
FOR REINFORCEMENT : 4CM