


DRAFT FOR OVERFLOW OF LOX-TANK
SHAFT ELEMENTS FILLED WITH RIVER
GRAVEL

EXACT POSITION ACCORDING TO LOCALITY
ON SITE !

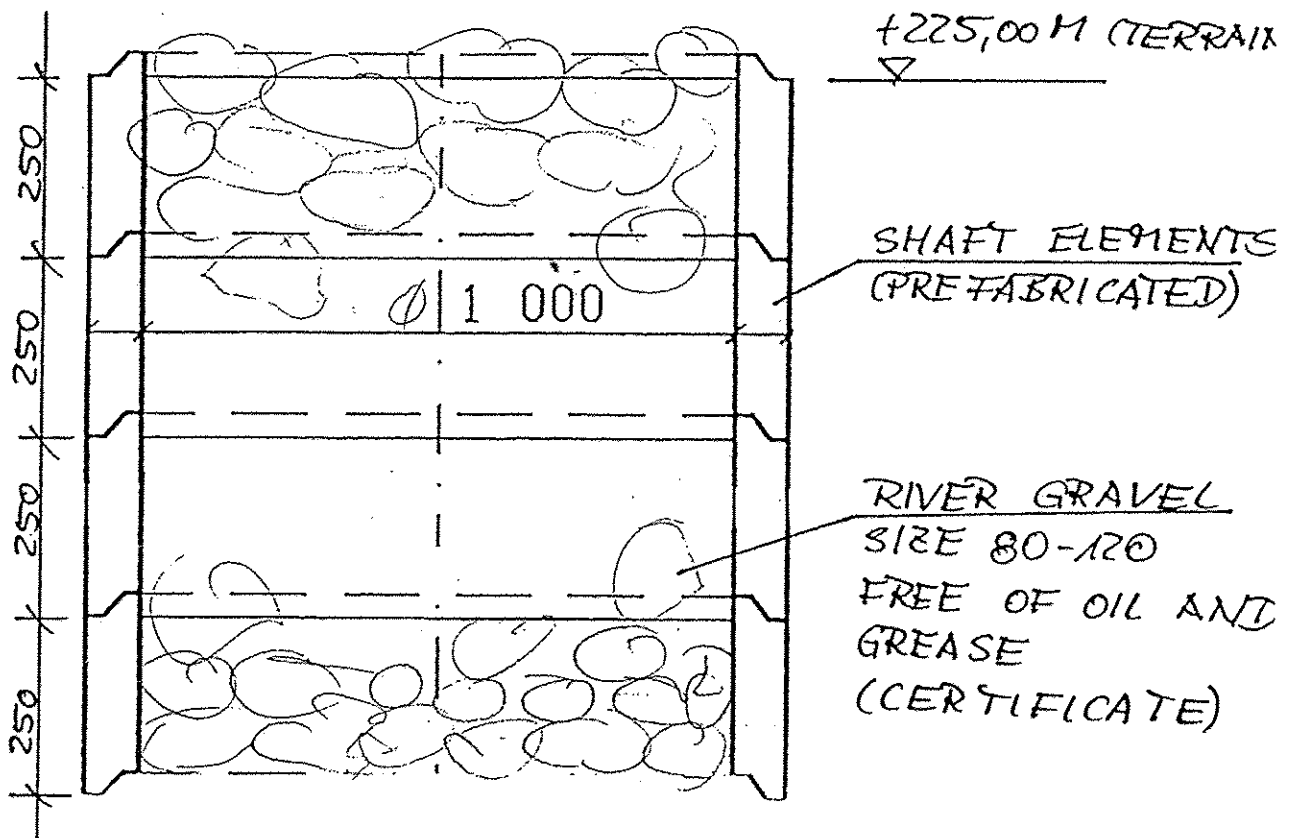

HS HSV s.r.o. KOŠICE
Technický úsek

**FREIGABE
FOR CONSTRUCTION**

Ra 11.11.05

R. J. B. 827
04/11/2005

PROJEKT SKUTOČNÉHO
VYHOTOVENIA

792.87056 Sheet 8