TOP VIEW SLAB

(LIN TANK B72001)

SCALE 1/50

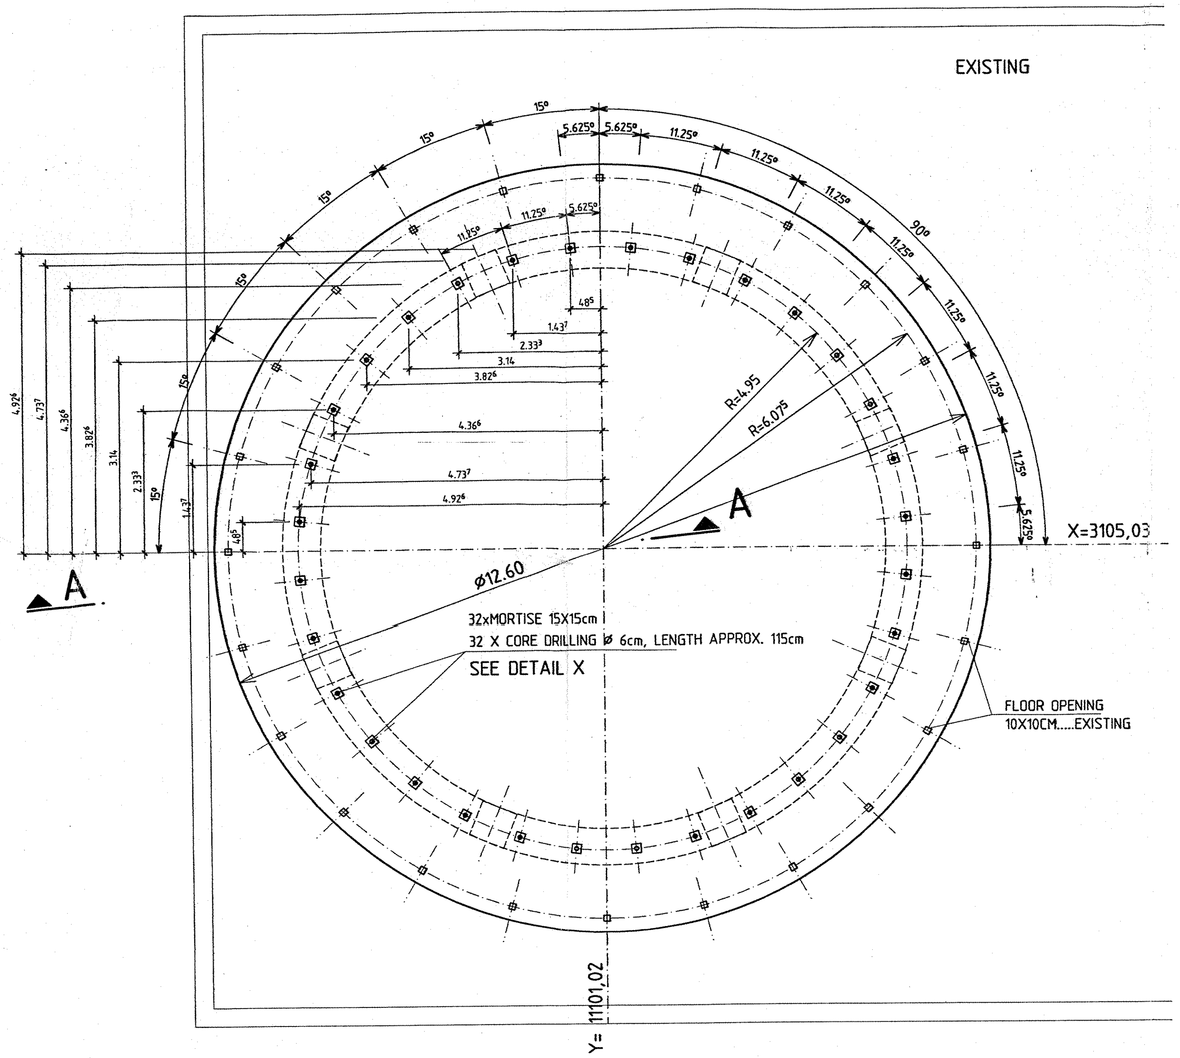

PLAN COLUMNS EXISTING

SCALE 1/50

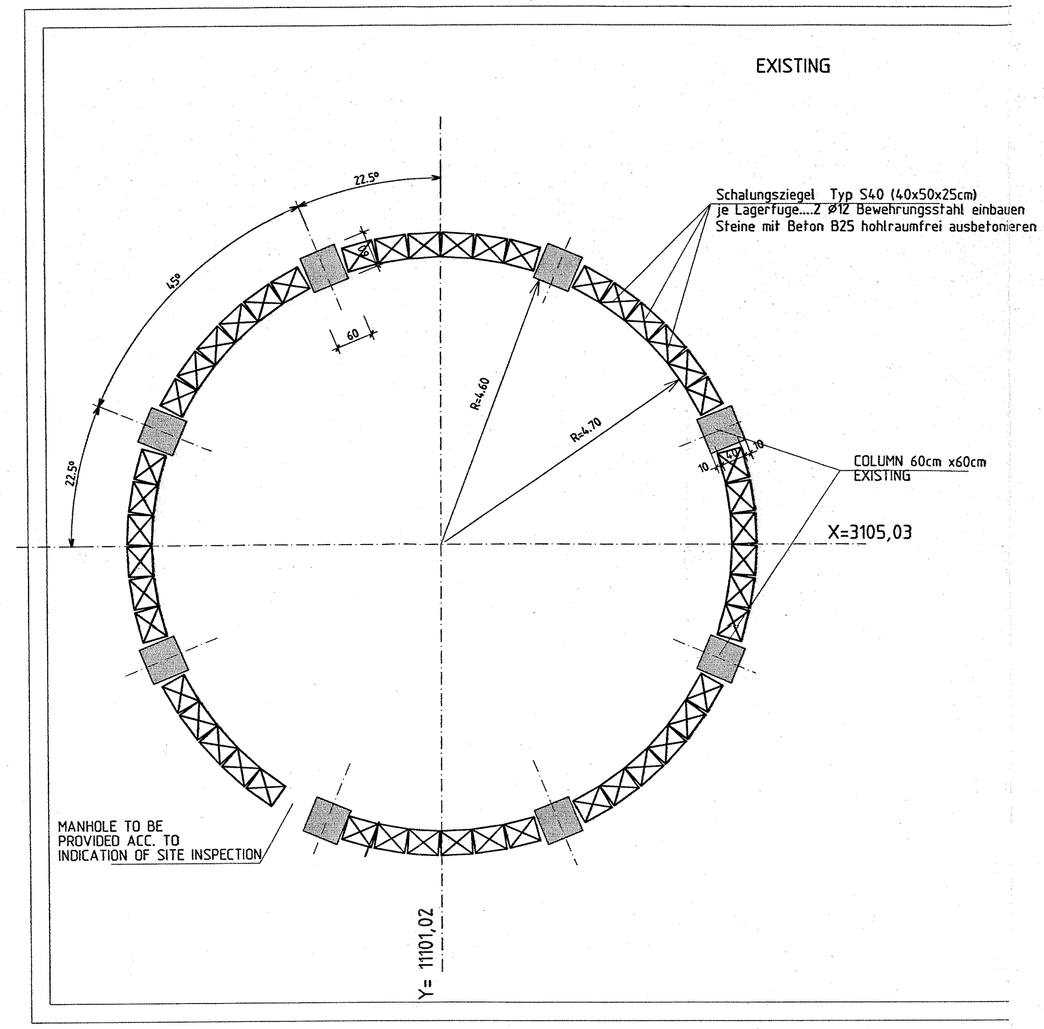

DETAIL X

SCALE 1/10

for 32 anchor straps

TOP VIEW

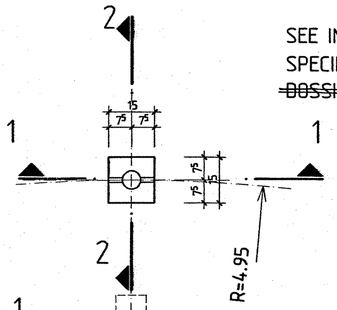

SECTION 1-1

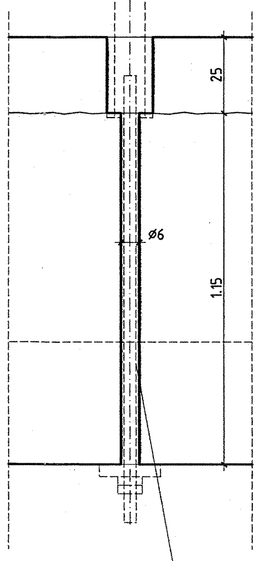

SECTION 2-2

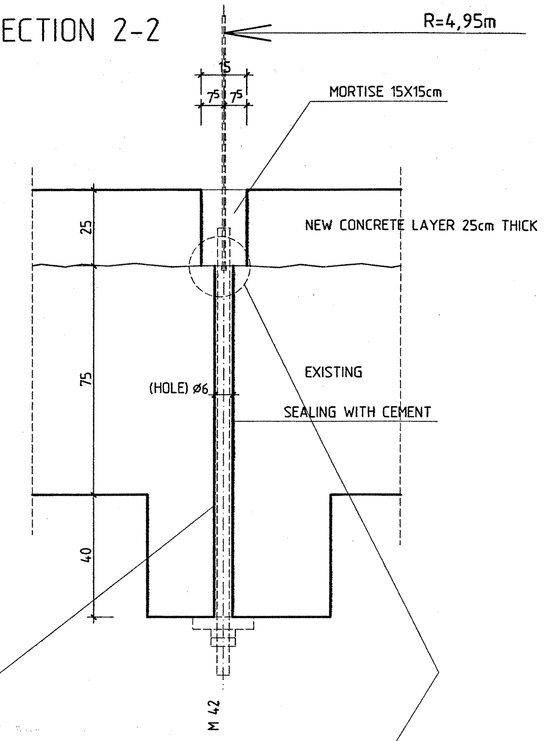

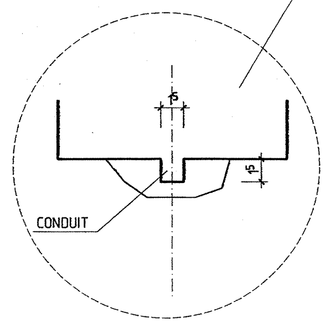

CORE DRILLING Ø6cm;LENGTH APPROX 115 cm
SEE TOP VIEW EXISTING SLAB

SEE INSTALLATION OF LIN INNER TANK EMBEDDED PARTS
SPECIFICATION NO. ~~783-SPANC101 AND~~ 783-10A / REV. 2 17/11/04
~~DOSSIER NO. 783 - SKETCH ANC 101~~ Ra 19.11.04

SECTION A-A

SCALE 1/25

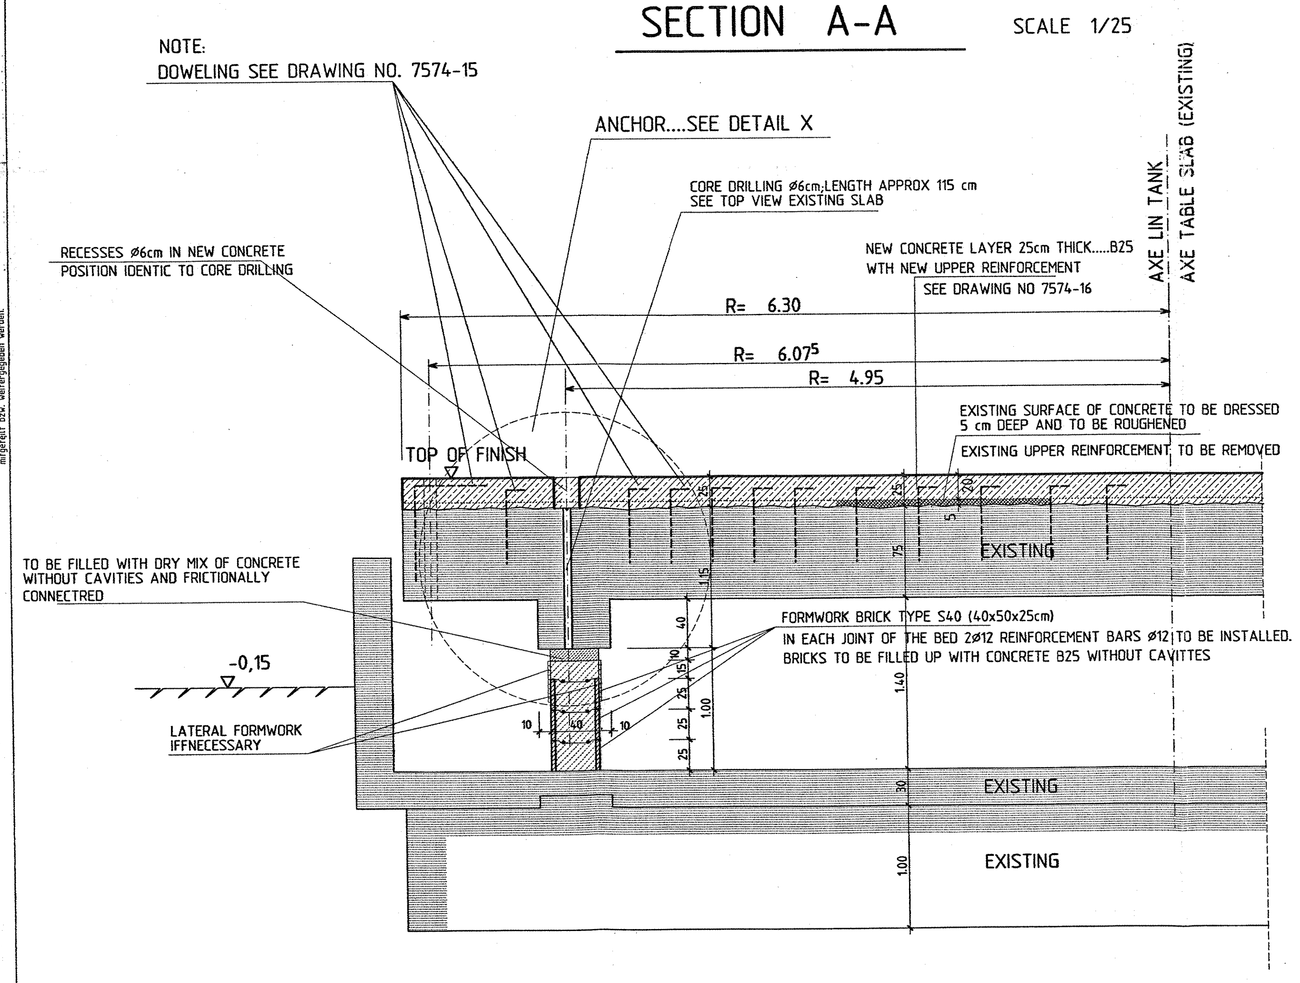

KEY PLAN

SCALE 1/250

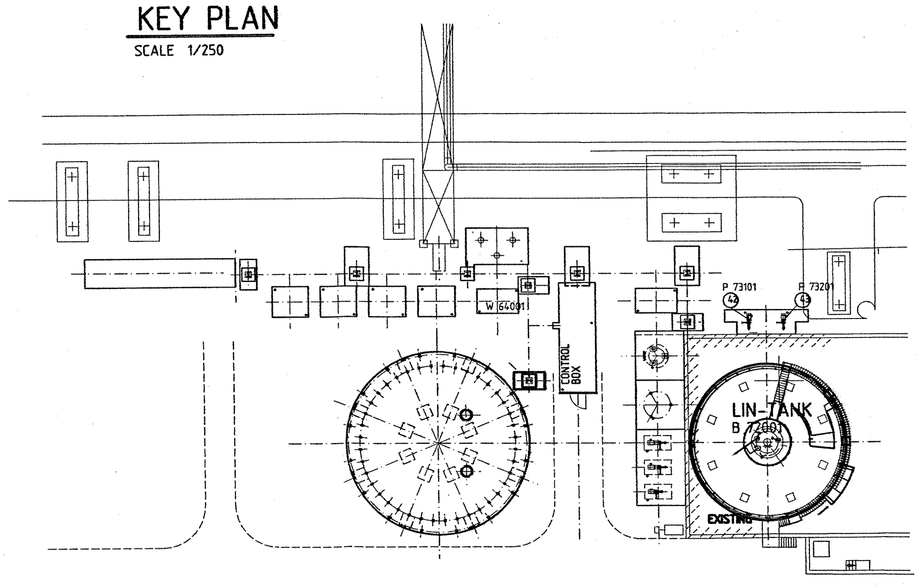

CURING AFTER CASTING OF CONCRETE ACC. TO
THE RESPECTIVE DIRECTIONS.
(FREE SURFACES OF CONCRETE TO BE COVERED AND
MOISTENED DURING TWO WEEKS)

MATERIAL:

CONCRETE GRADE: B 25

BSt 500 (BSt IV)

CONCRETE COVER
FOR REINFORCEMENT : 4CM

PRO: [illegible] VINOTOVENA

FREIGABE
FOR CONSTRUCTION
Ra 19.11.04
HS HSV s.r.o. KOŠICE
Technický úsek

Rev.	Revisions	Date	Name	checked
A	ANCHOR M42	18.11.04	SP	M.Orth
0	FirstDeliveri	15.11.04	SP	M. Orth

Plan-No.: 7574-14

SUBJECT: LIN TANK B72001
TABLE SLAB FORMWORK PLAN

Dipl.-Ing. Mühlhäusler
Dipl.-Ing. Veilsang
KMW
Saarbrücker Strasse 9 - 10
66130 SAARBRÜCKEN-BRIEBACH
Tel.:0681/8813-0 Fax:0681/8831388

AIR LIQUIDE
Air Liquide AGS GmbH

Date :	Name :	Checked :	History file :
15.11.2004	Speicher	M.Orth	792.87053-014.doc

Job code: K70101
Reference: ASU No. 9 KOSICE

Scale: 150 | Original format: A0
Sheet: | of | Sheets

Replaces: 79_------
Replaced by: 79_------

Title: LIN TANK B72001

Drawing No.: 792.87053 | Rev.: A

Diese Zeichnung ist urheberrechtlich geschützt. Sie darf weder vervielfältigt noch an Dritte weitergegeben noch in irgendeiner Weise verwertet oder Dritten mitgeteilt werden ohne ausdrückliche schriftliche Genehmigung.