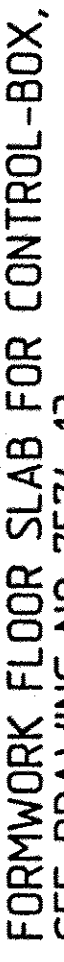


SCALE 1/100

SCALE 1/100

1111


SCALE 1/50

 $(x^7)$ 

(x7)


## SECTION B

\_\_\_\_\_

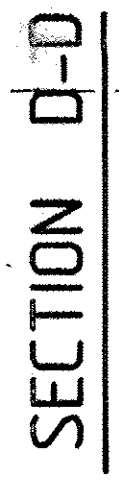



## R SLAB (4)

R SLAB (42)

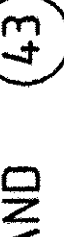

AB (42)

AB (42)

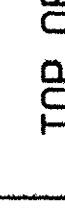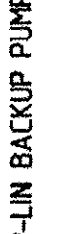

**BOTTOM OF STEEL STRUCTURE :**

 $225.15 \text{ mNm} = \pm 0.00 \text{ mNm}$ 

TOP OF INTERNAL ROADS: 275.00m NM. = -0.15m

SUBSEQUENT TREATMENT OF CONCRETE ACC. TO PARTICULAR SLOVAKIAN REGULATIONS.

REQUIRED FOUNDATION PRESSURE  
sigma APPROVAL = 250 KN/qm  
APPROVED MASS TOLERANCE ±0.5cm OF CONCRETE  
CONCRETE GRADE : B 25


LEVEL OF STRUCTURE  
WITHOUT FINISH

LEVEL OF STRUCTURE WITH FINISH

LEVEL OF STRUCTURE WITHOUT FINISH =  
 ▽ LEVEL OF STRUCTURE WITH FINISH

PROJEKT SKUTOČNOSTI

REFRIGABE  
FOR CONSTRUCTION

Plan-No.: 7574-8		SUBJECT: PIPE AND CABLE BRIDGE		FOUNDATIONS FOR WORK PLAN		KEY PLAN ASU NO. 9	
890					