




[illegible]

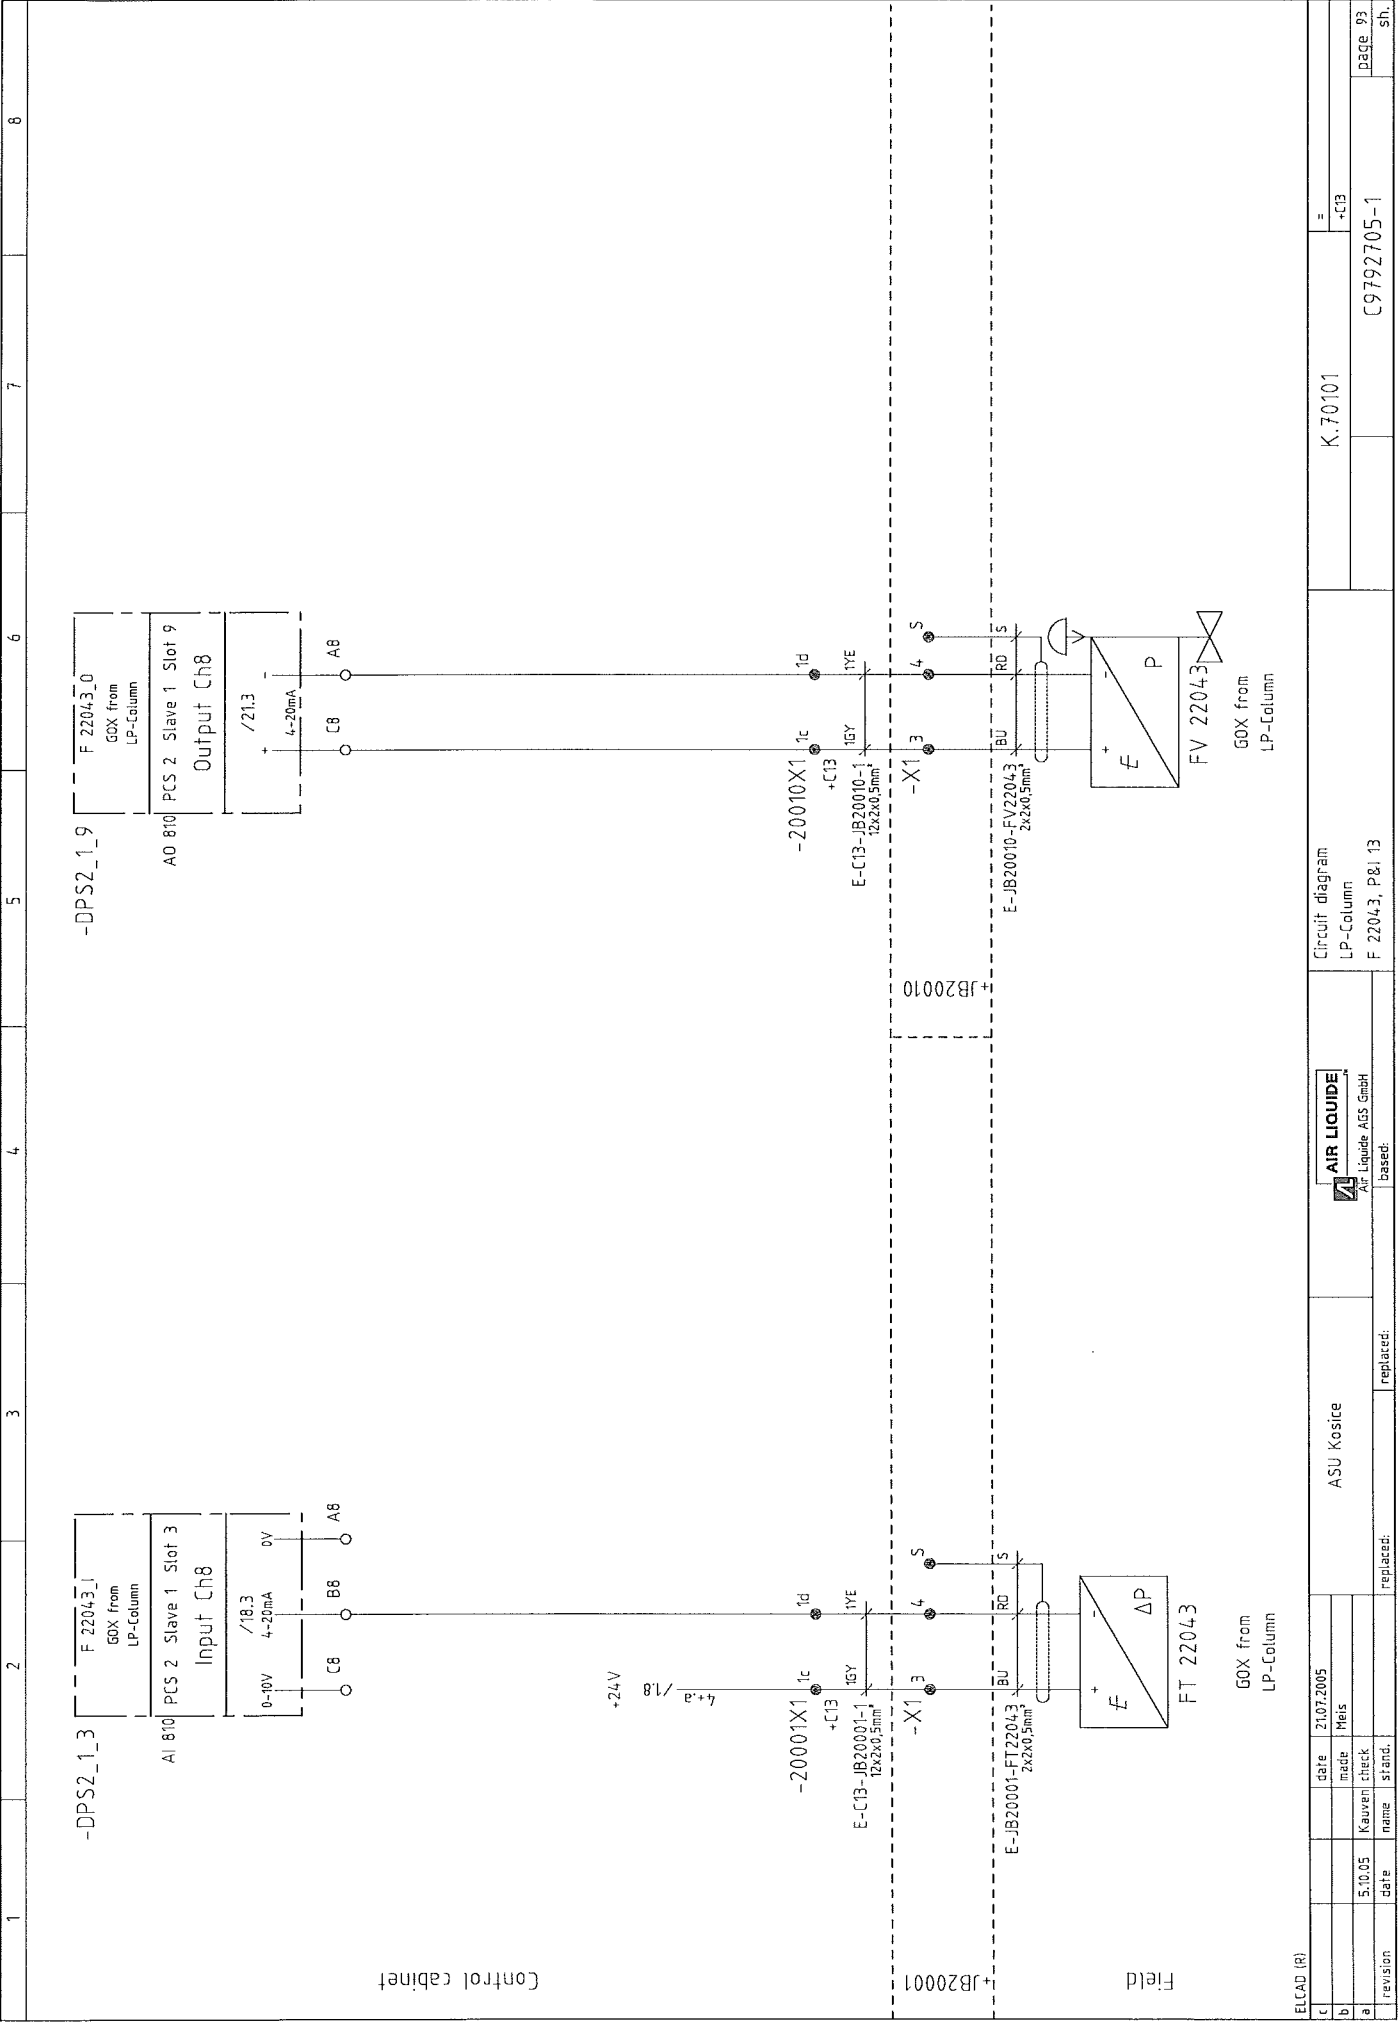


[illegible]

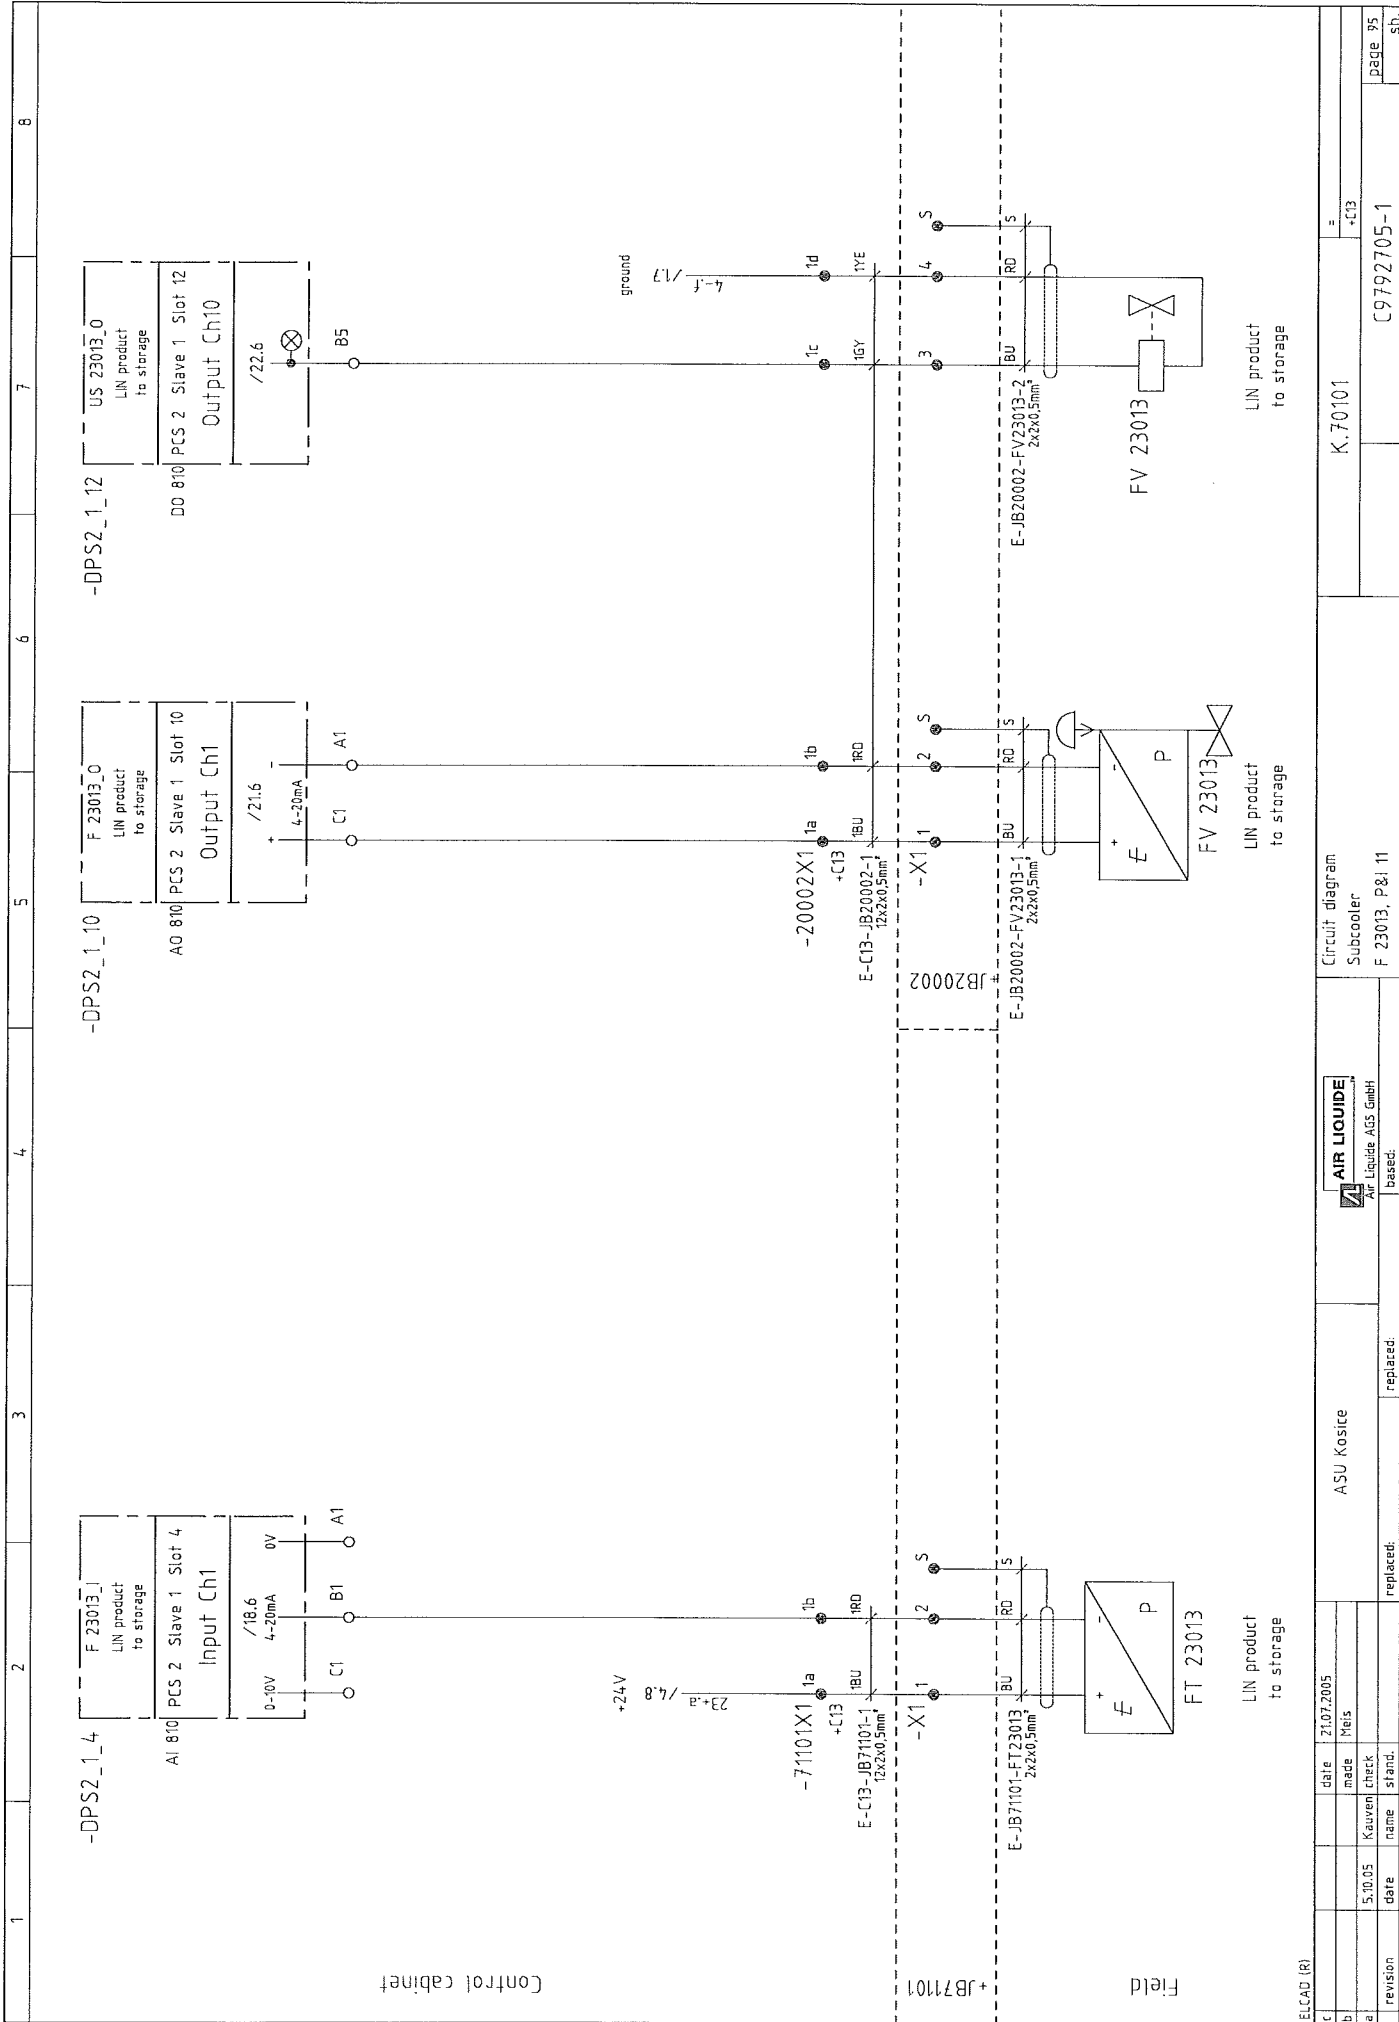

ELCAD (R)		ASU Kosice		AIR LIQUIDE		Circuit diagram		K.70101		LIN product to storage	
c		date	21.07.2005	made	Meis		Subcooler				
b		date	5.10.05	check	Kaumen		F 23013, P&I 11				
a		date		stand.							
revision		replaced:		replaced:		based:		C9792705-1		page 95	
										sh.	

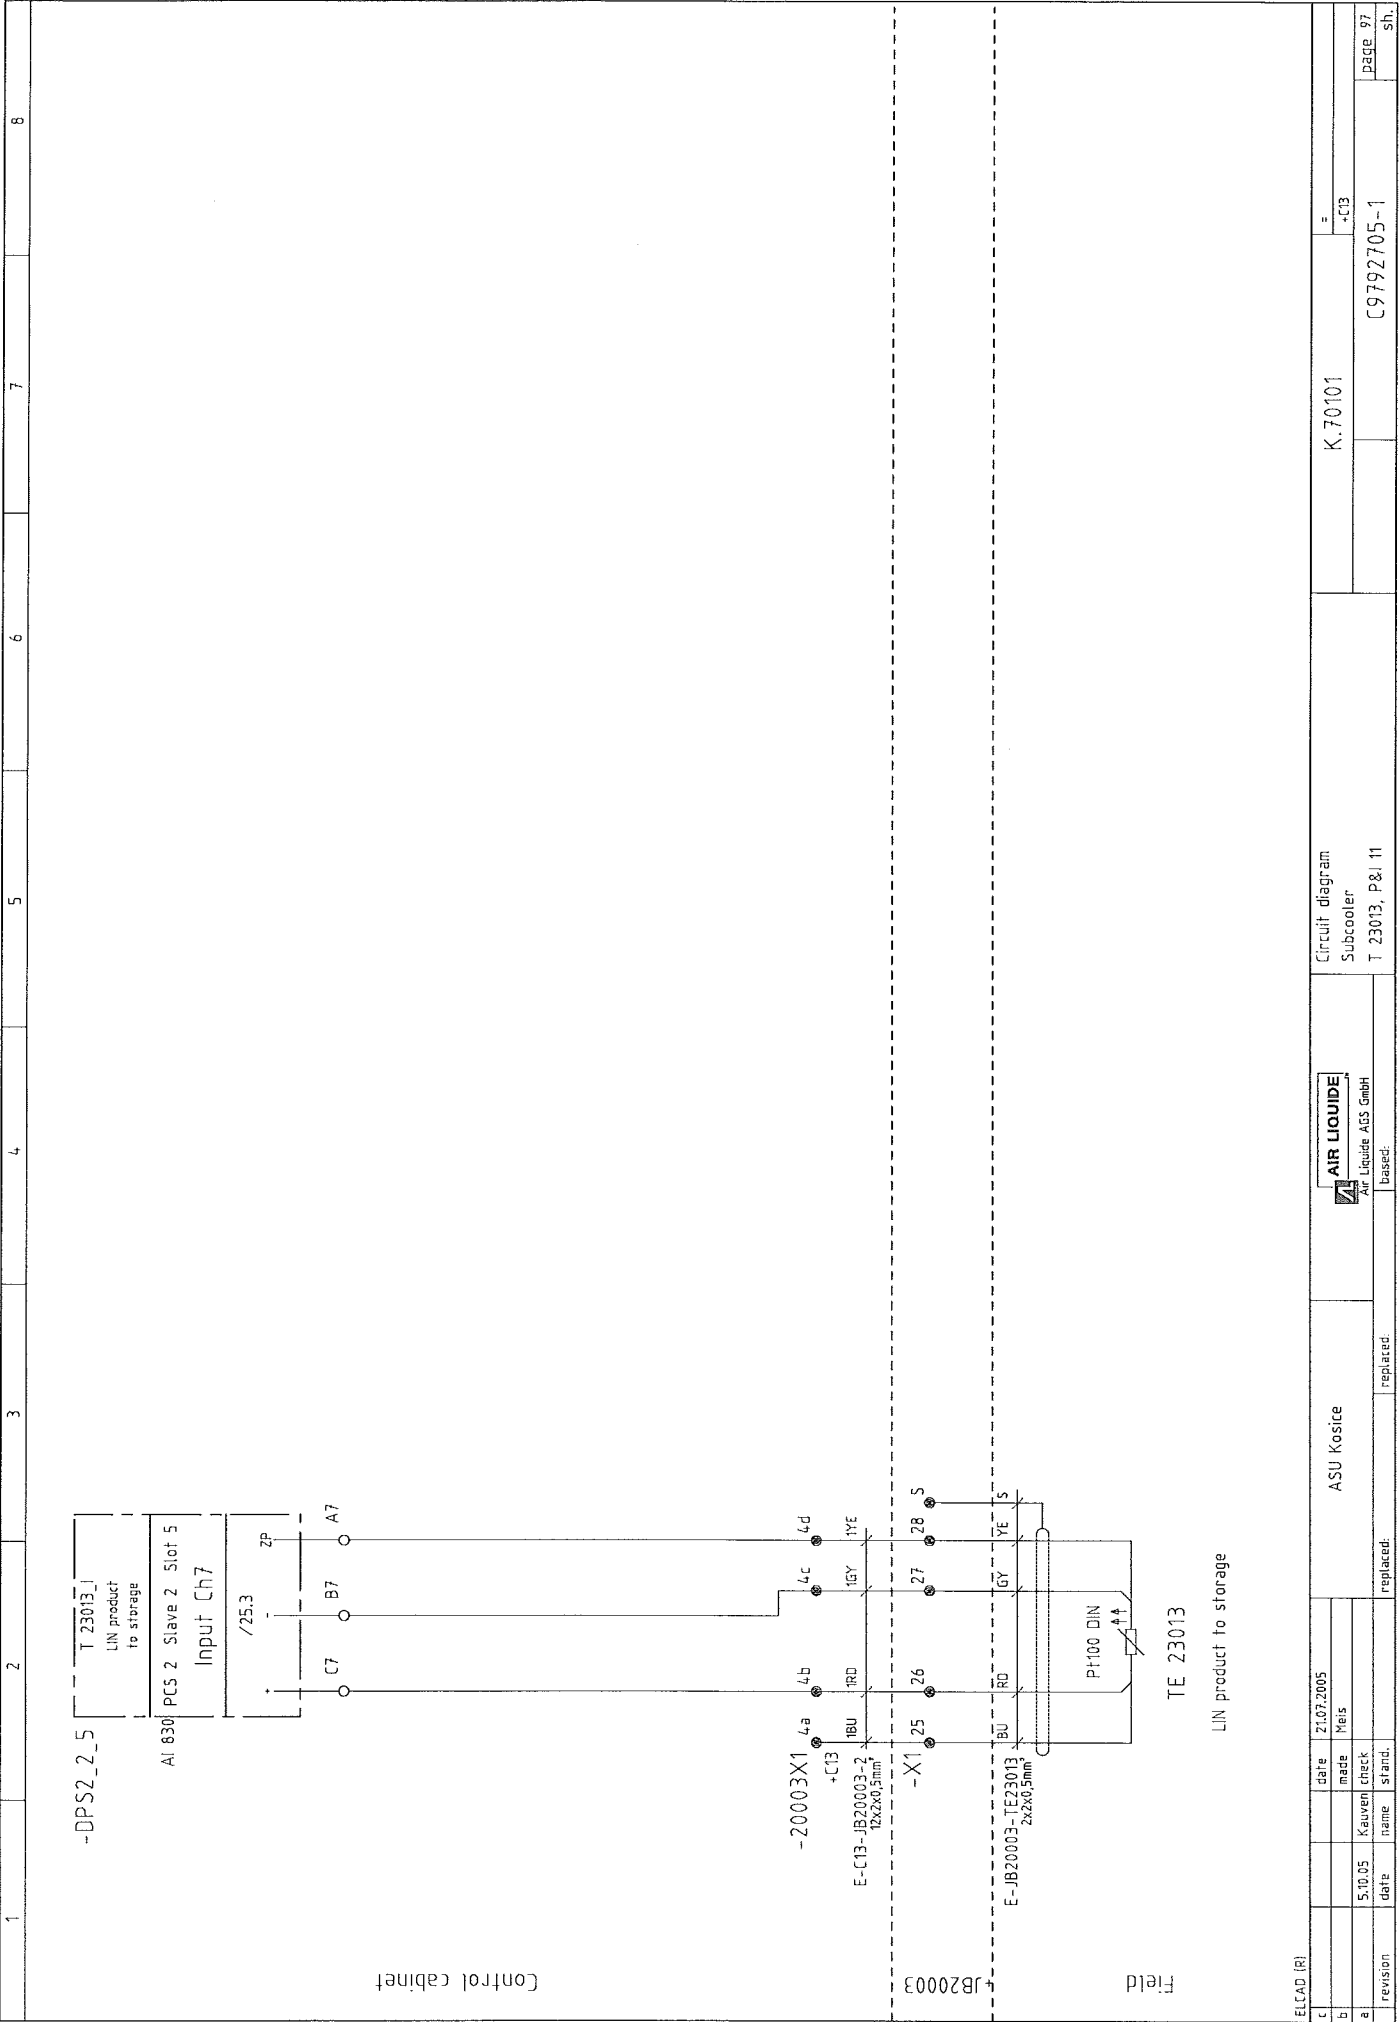

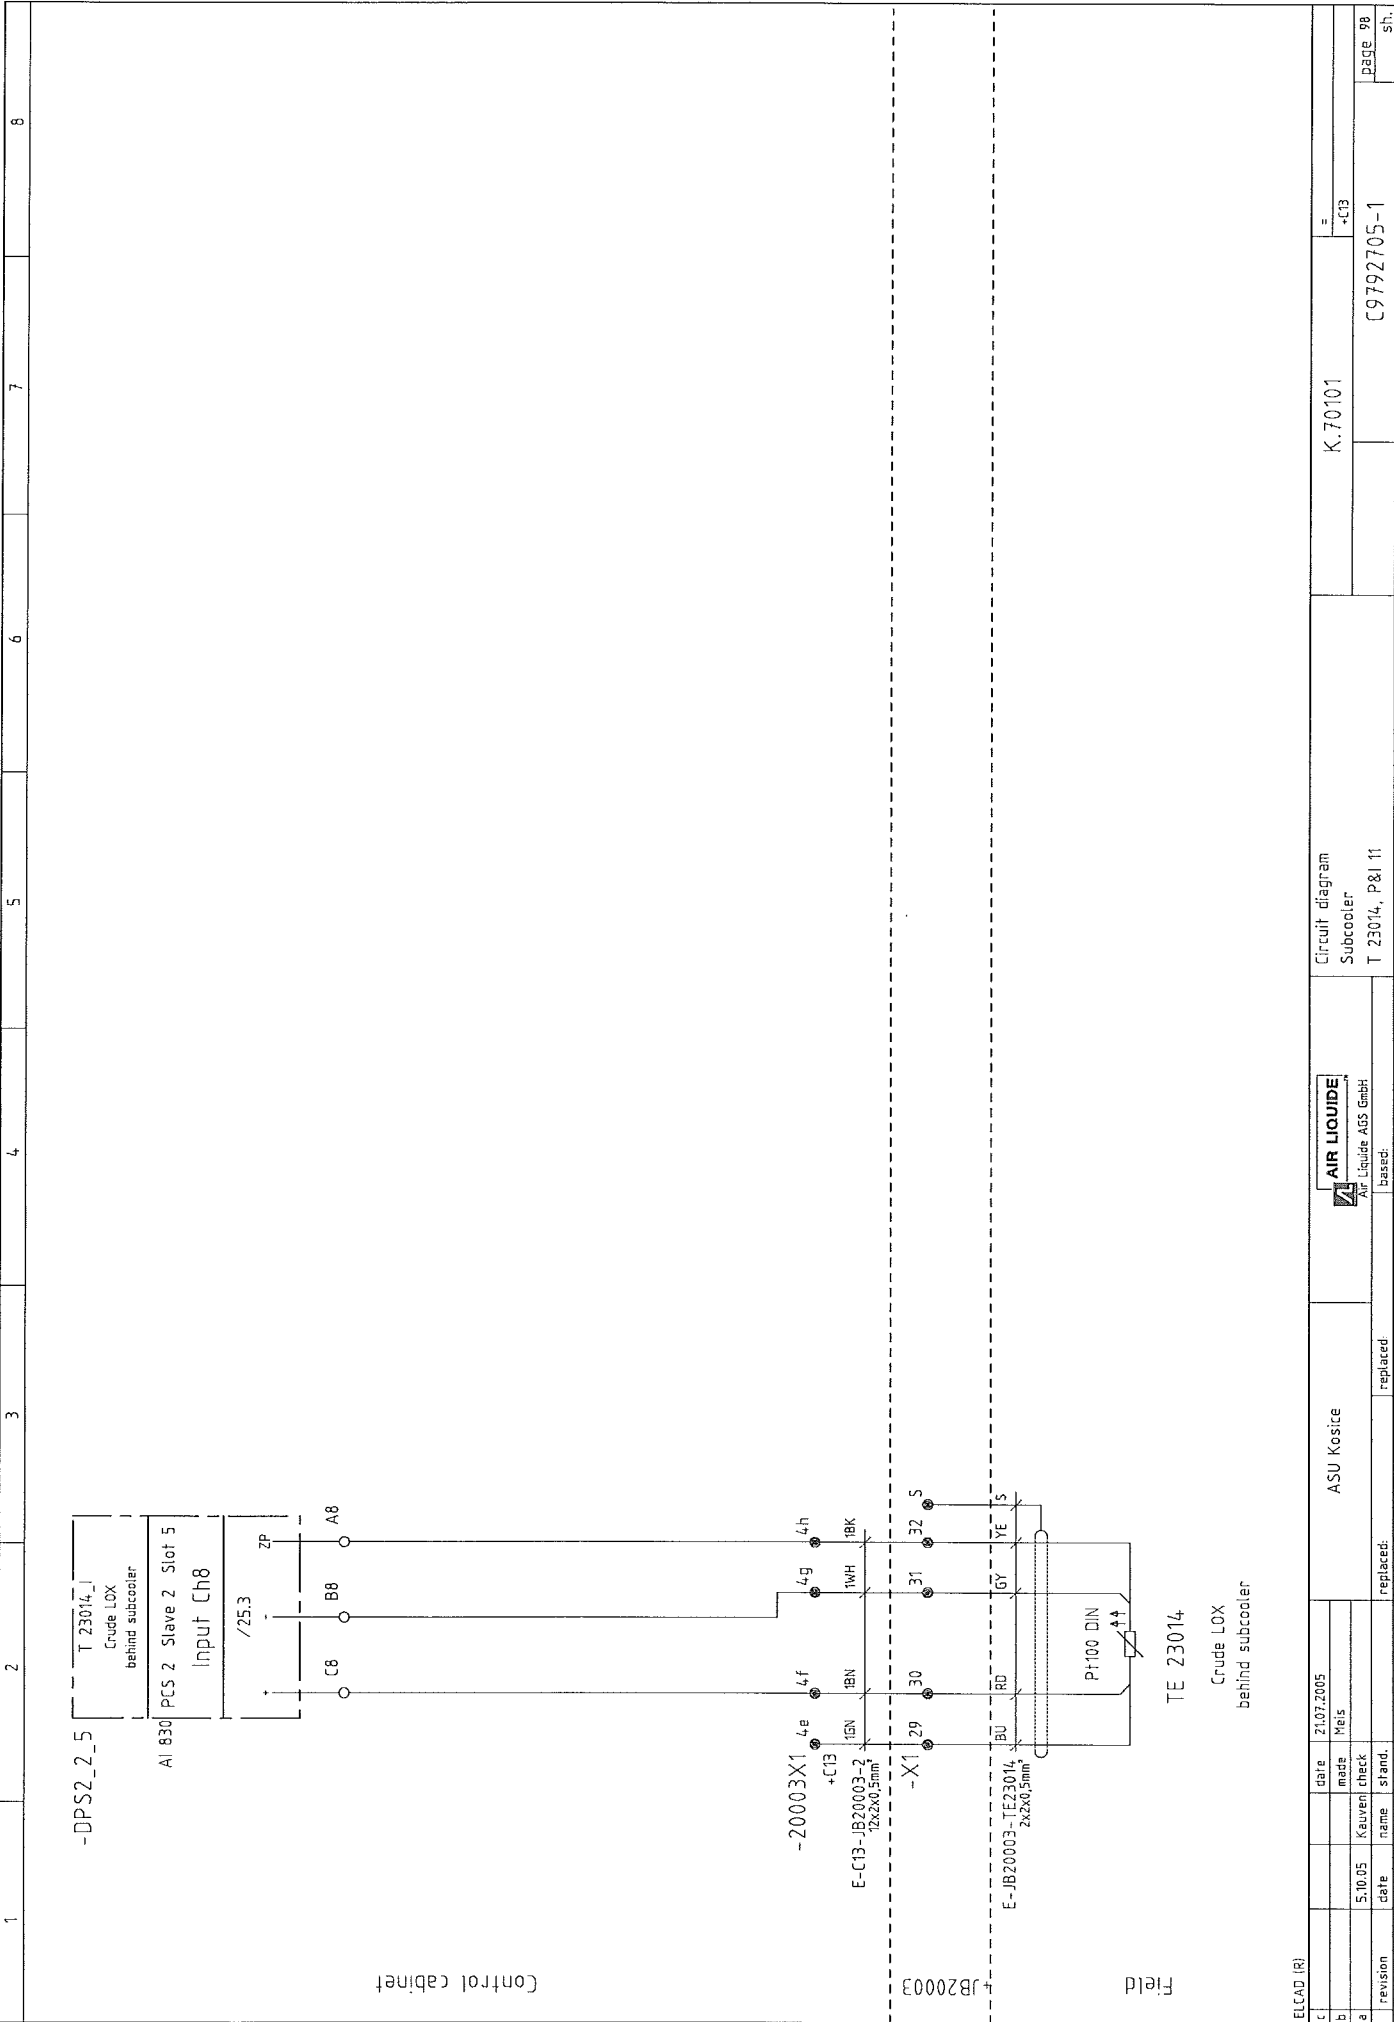




Liquid Air

ELCAD (R)

				ASU Kosice		 AIR LIQUIDE Air Liquide AGS GmbH		Circuit diagram Subcooler T 230'5, P&I 11		K.70101		=		+C13		page 99	
c			date	21.07.2005													
b			made	Mals													
a			Kauern check.	5.10.05													
	revision		name	date	replaced:												sh.
																	C9792705-1

1	2	3	4	5	6	7	8
---	---	---	---	---	---	---	---

-DPS2_1_4

LOX to storage

AI 810 PCS 2 Slave 1 Slot 4

Input Ch2

0-10V 4-20mA 0V

18.6

C2 B2 A2

Control cabinet

+24V

21+a / L4

-61101X1

1a 1b

+C13

E-C13-JB61101-1

12x2x0.5mm

1BU 1RD

-X1

1 2 S

E-JB61101-FT23016

2x2x0.5mm

BU RD S

FT 23016

E P

LOX to storage

Field

+JB61101

ELCAD (R)

c

b

a

date

21.07.2005

made

Preis

Kauert check

5.10.05

date

name

stand

ASU Koscice

replaced:

replaced:

Circuit diagram

Subcooler

F 23016, P&I 11

K.70101


=

+C13

page 00

sh.

C9792705-1

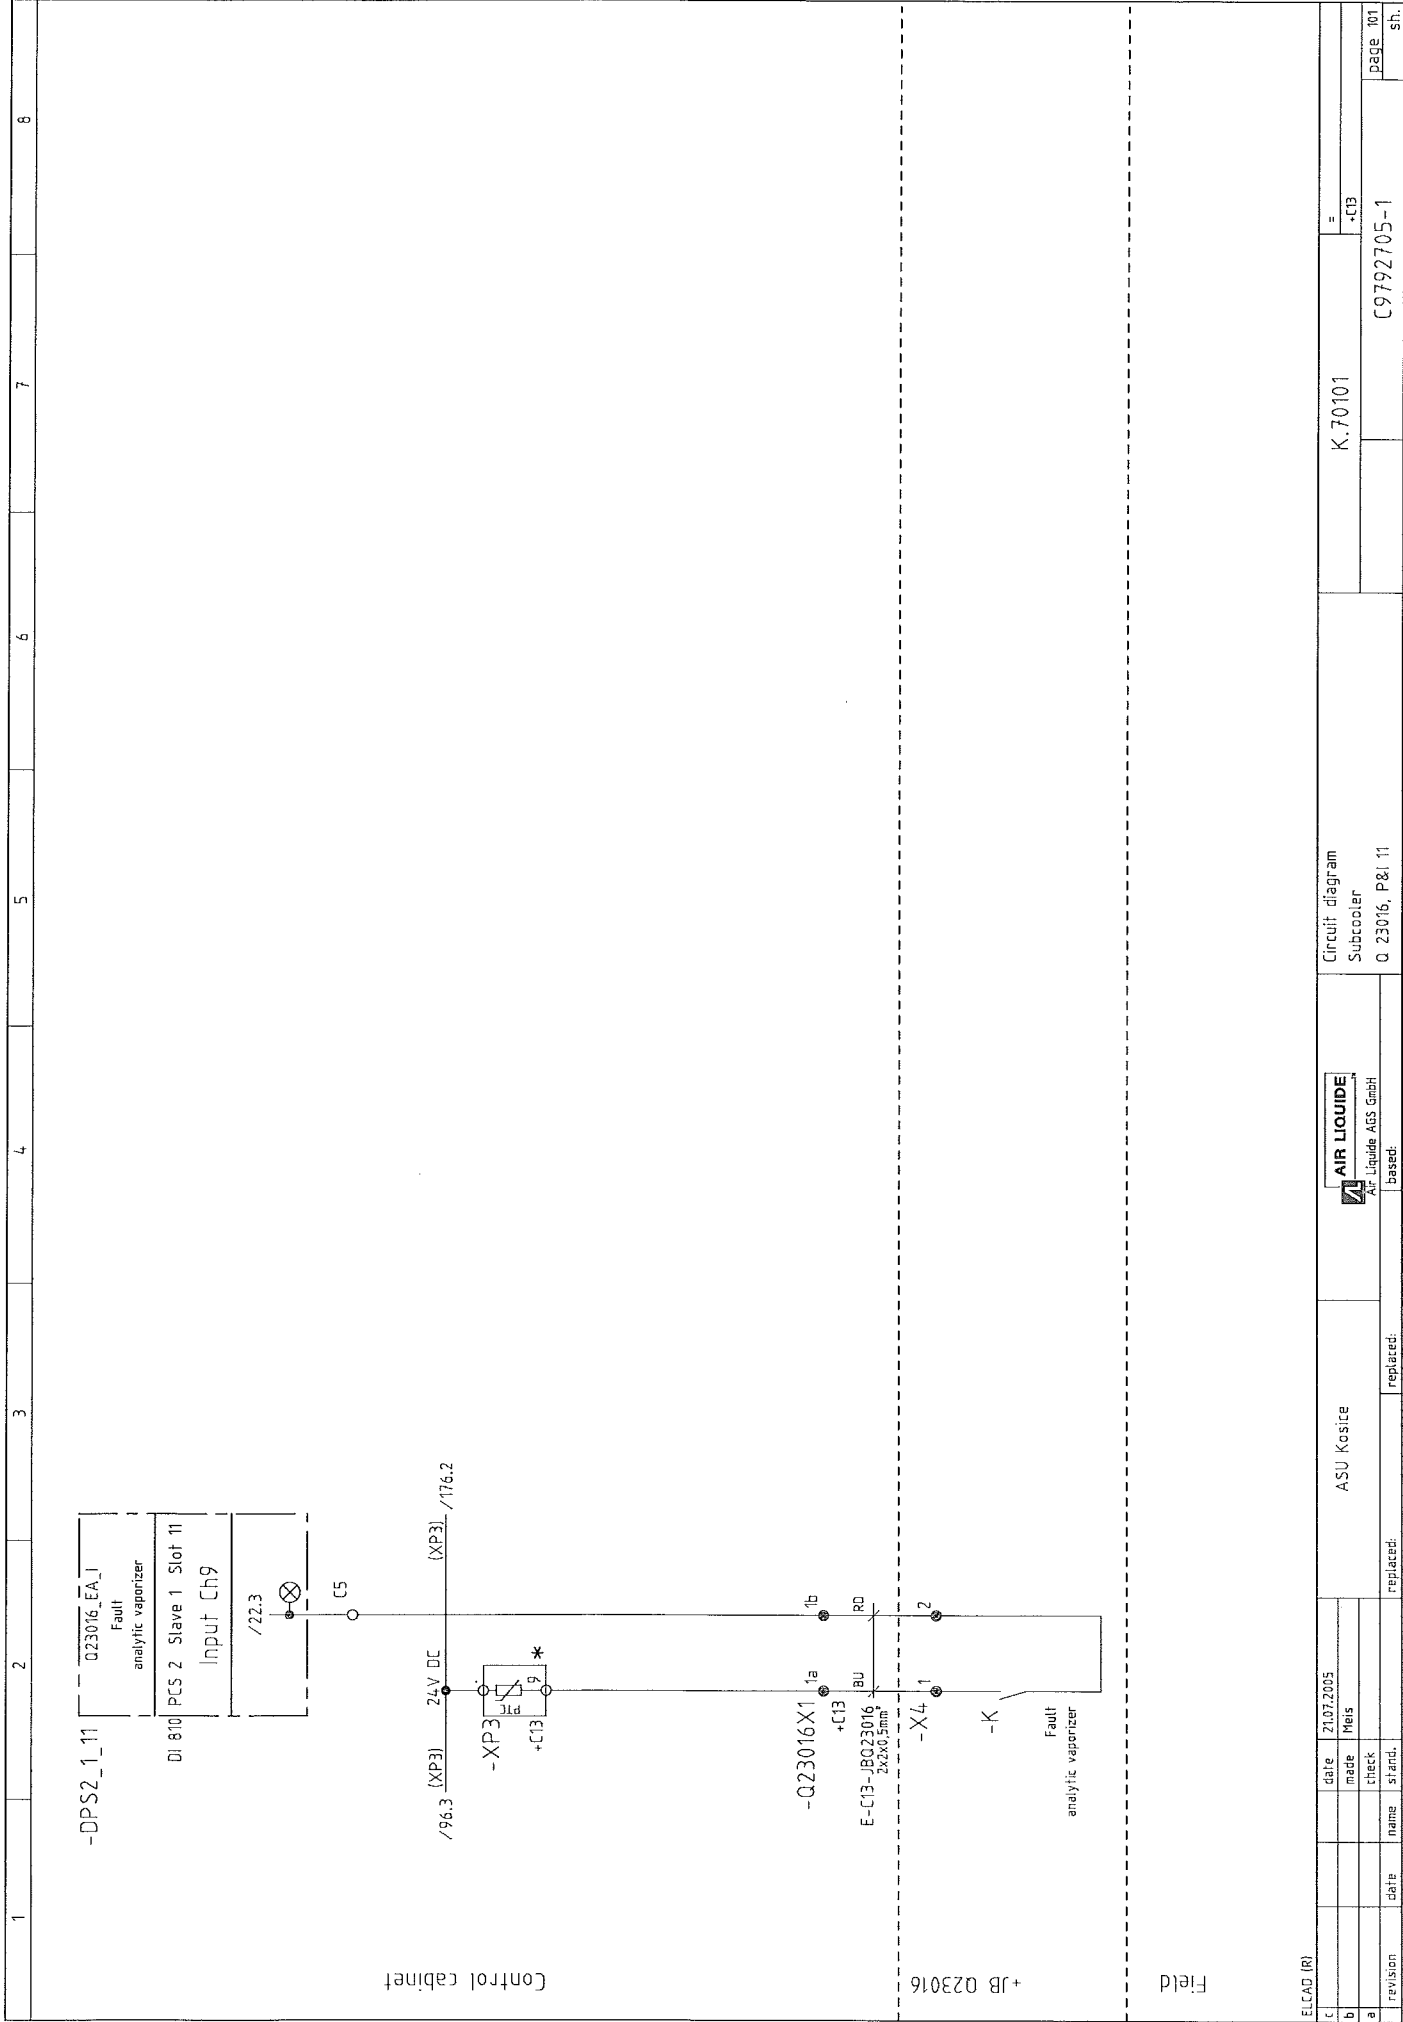










[illegible]




[illegible]

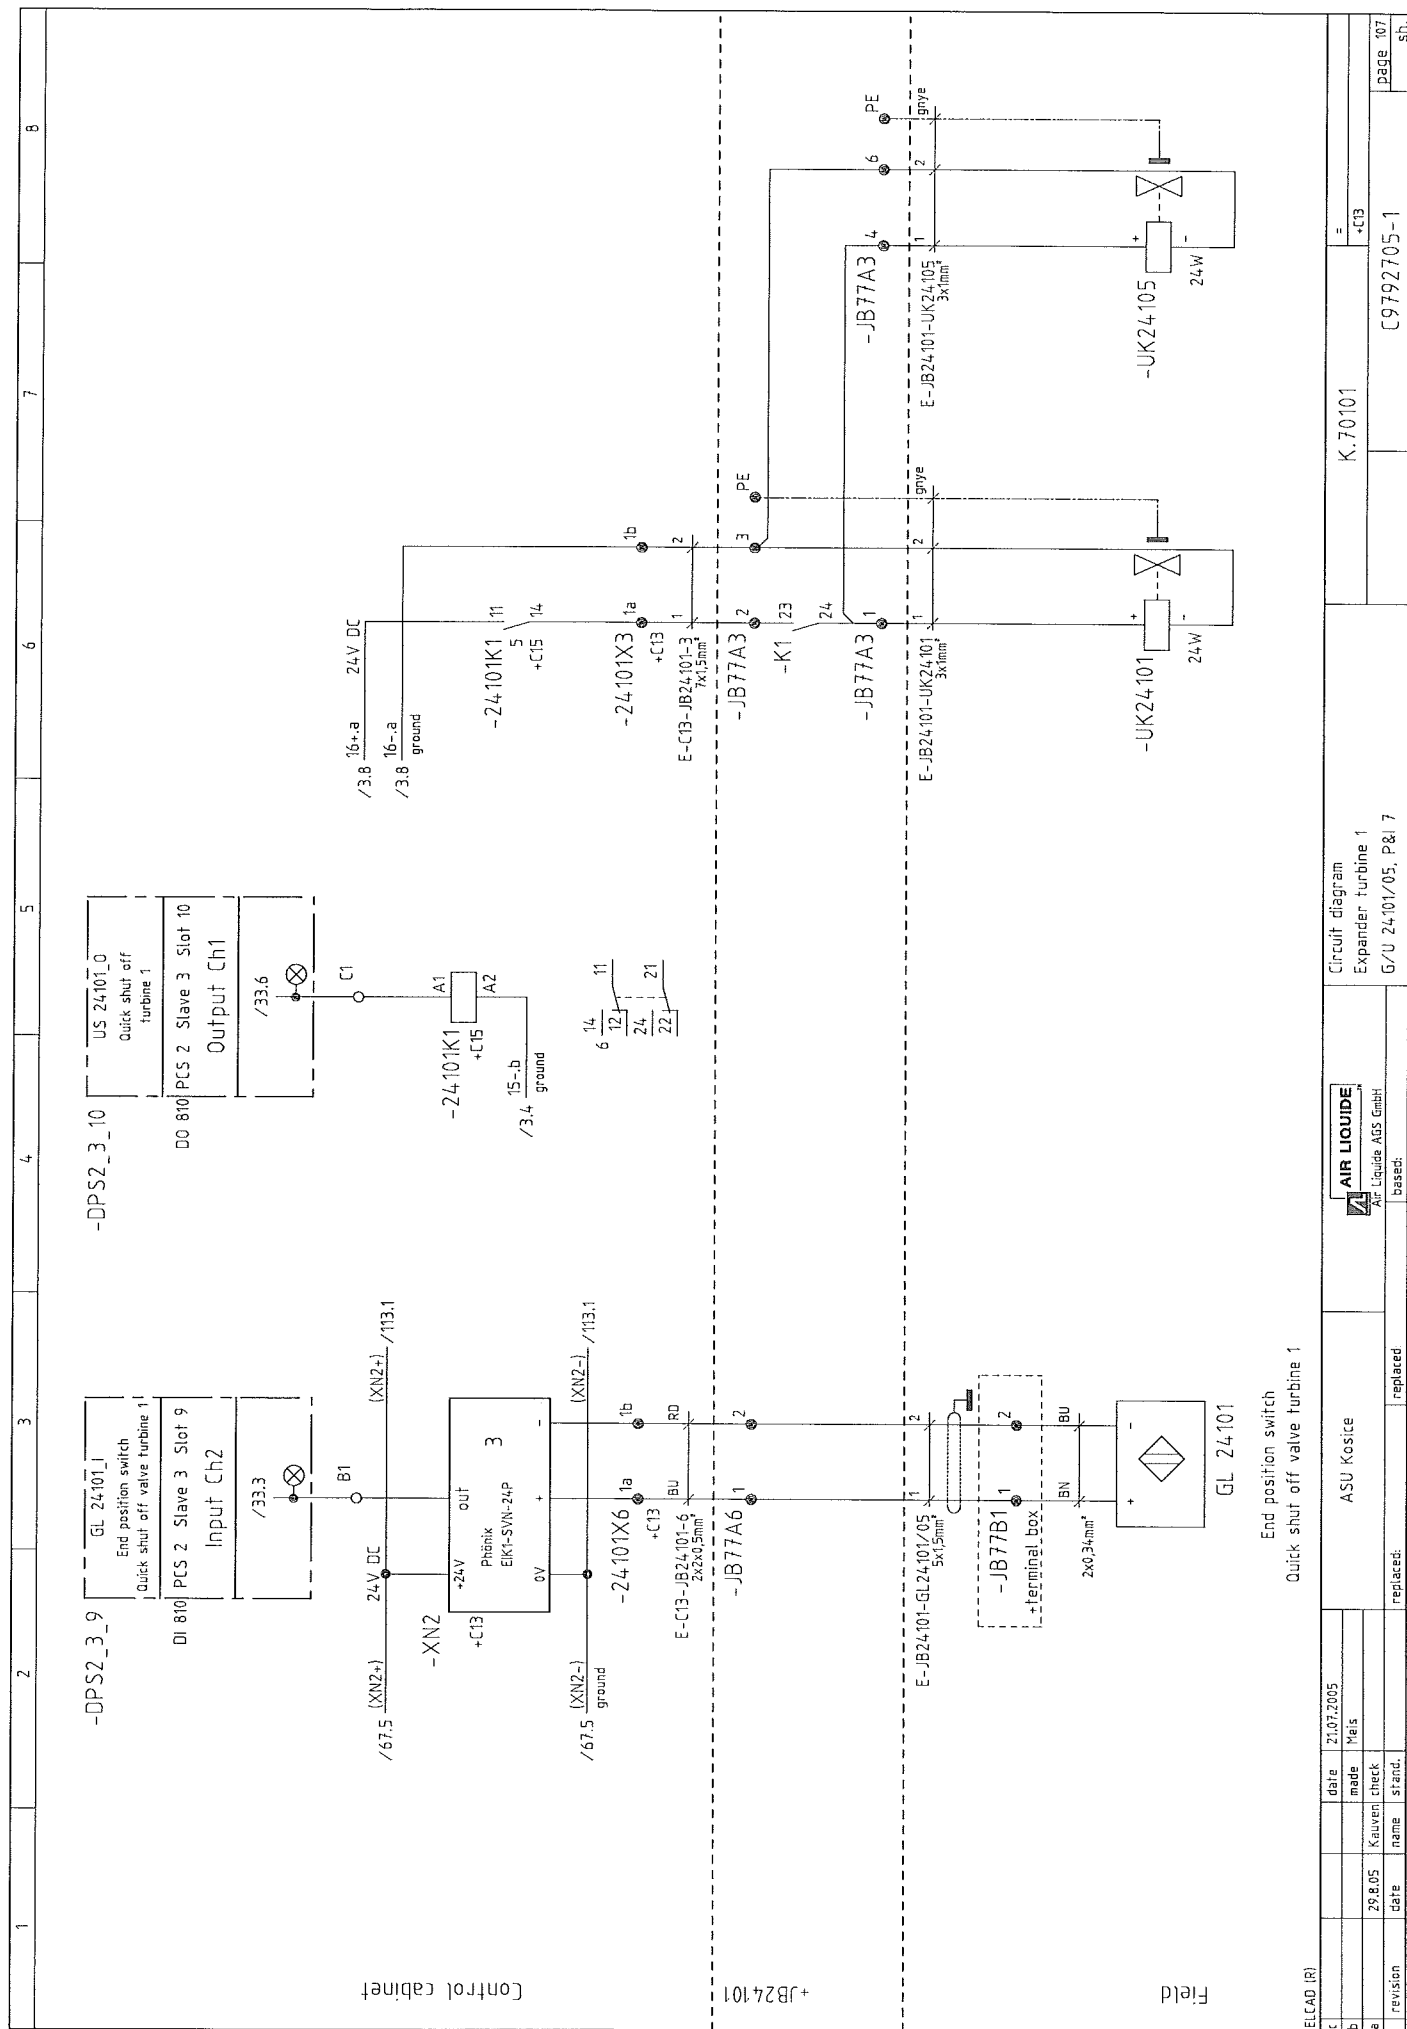

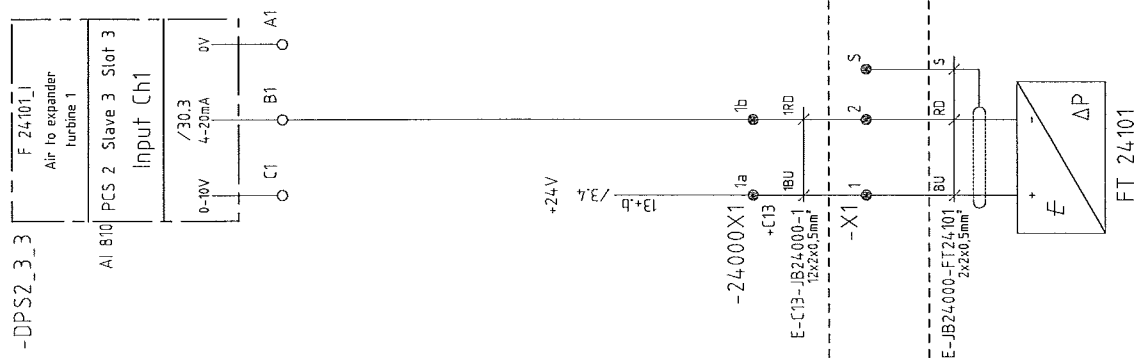

Air to expander turbine 1

ELCAD (R)

			ASU Kosice		<div> AIR LIQUIDE AGS GmbH</div>		Circuit diagram Expander turbine 1 F 24-101, P&I 7		K.70101		=		-C13		page 108		sh.	
c			date	21.07.2005														
b			made	Mels														
a			Kauern check															
			revision	5.10.05														
			name															
			replaced:															
			based:															
			replaced:															
			name															
			date	5.10.05														




1	2	3	4	5	6	7	8
---	---	---	---	---	---	---	---

-DPS2_3_6

T 24101_I
Air to expander turbine 1

AI 830 PCS 2 Slave 3 Slot 6
Input Ch1

/31.6 ZP

C1 B1 A1

-24000X1

+C13 1f 1g 1h

E-C13-JB24000-1 1BN 1WH 1BK
12x2x0.5mm

-X1 5 6 7 8 9

E-JB24000-TE24101 2x2x0.5mm

BU RD GY VE 1S

P100 DIN

TE 24101
Air to expander turbine 1

Control cabinet

Field

ELCAD (R)

revision	5.10.05	Kauven	date	21.07.2005
made	Meis			

ASU Koste

AIR LIQUIDE
Air Liquide AGS GmbH
based:

replaced:

Circuit diagram
Expander turbine 1
T 24101, P&I 7


K.70101

+C13


C9792705-1


page 110

sh

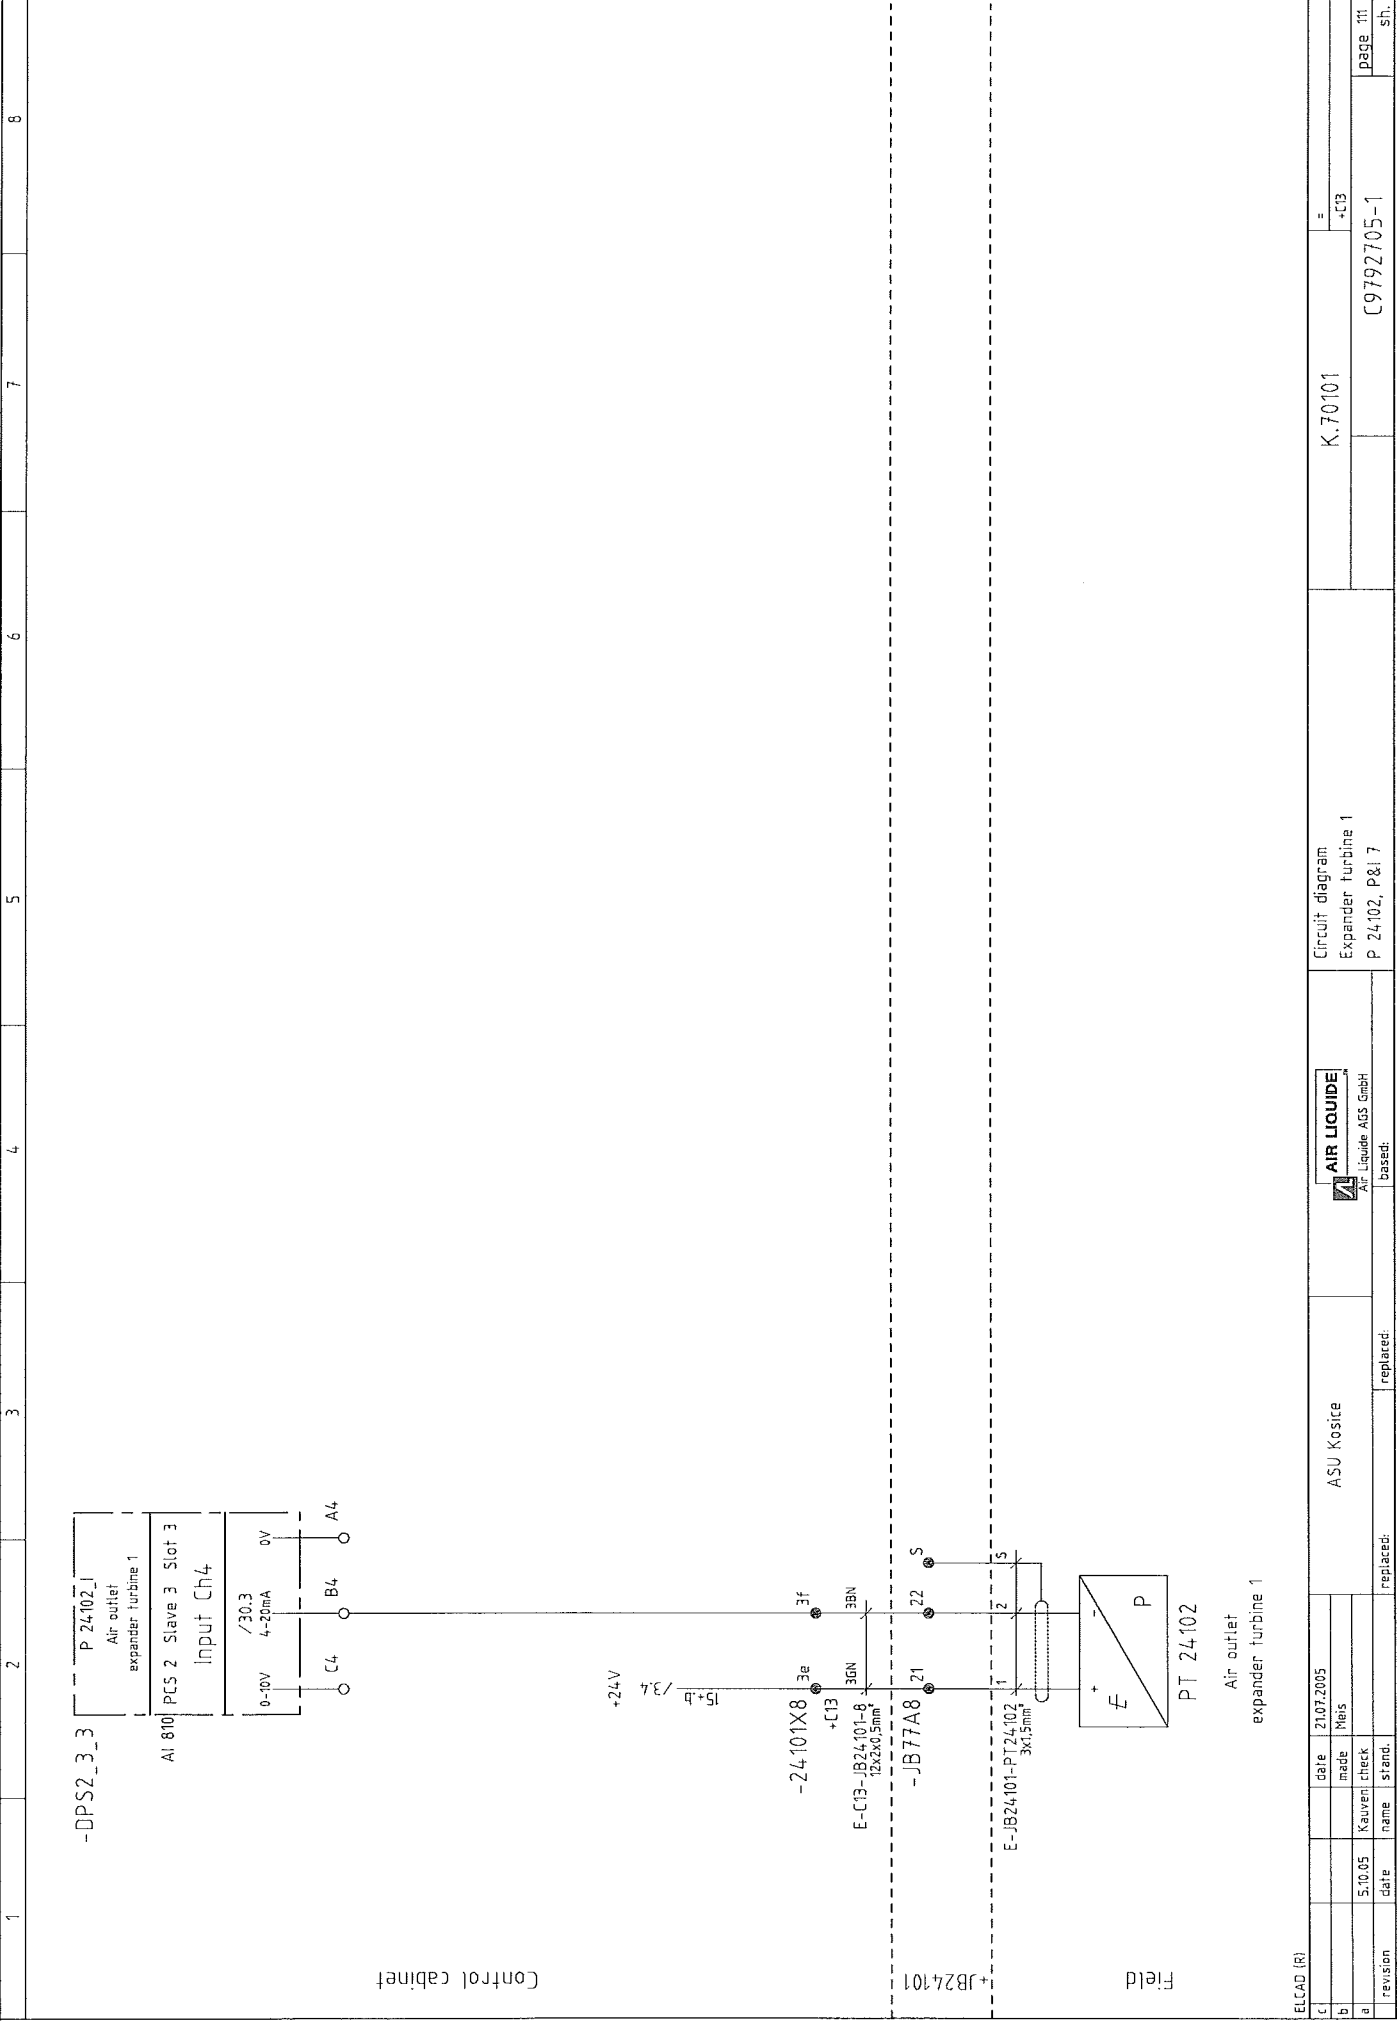


[illegible]

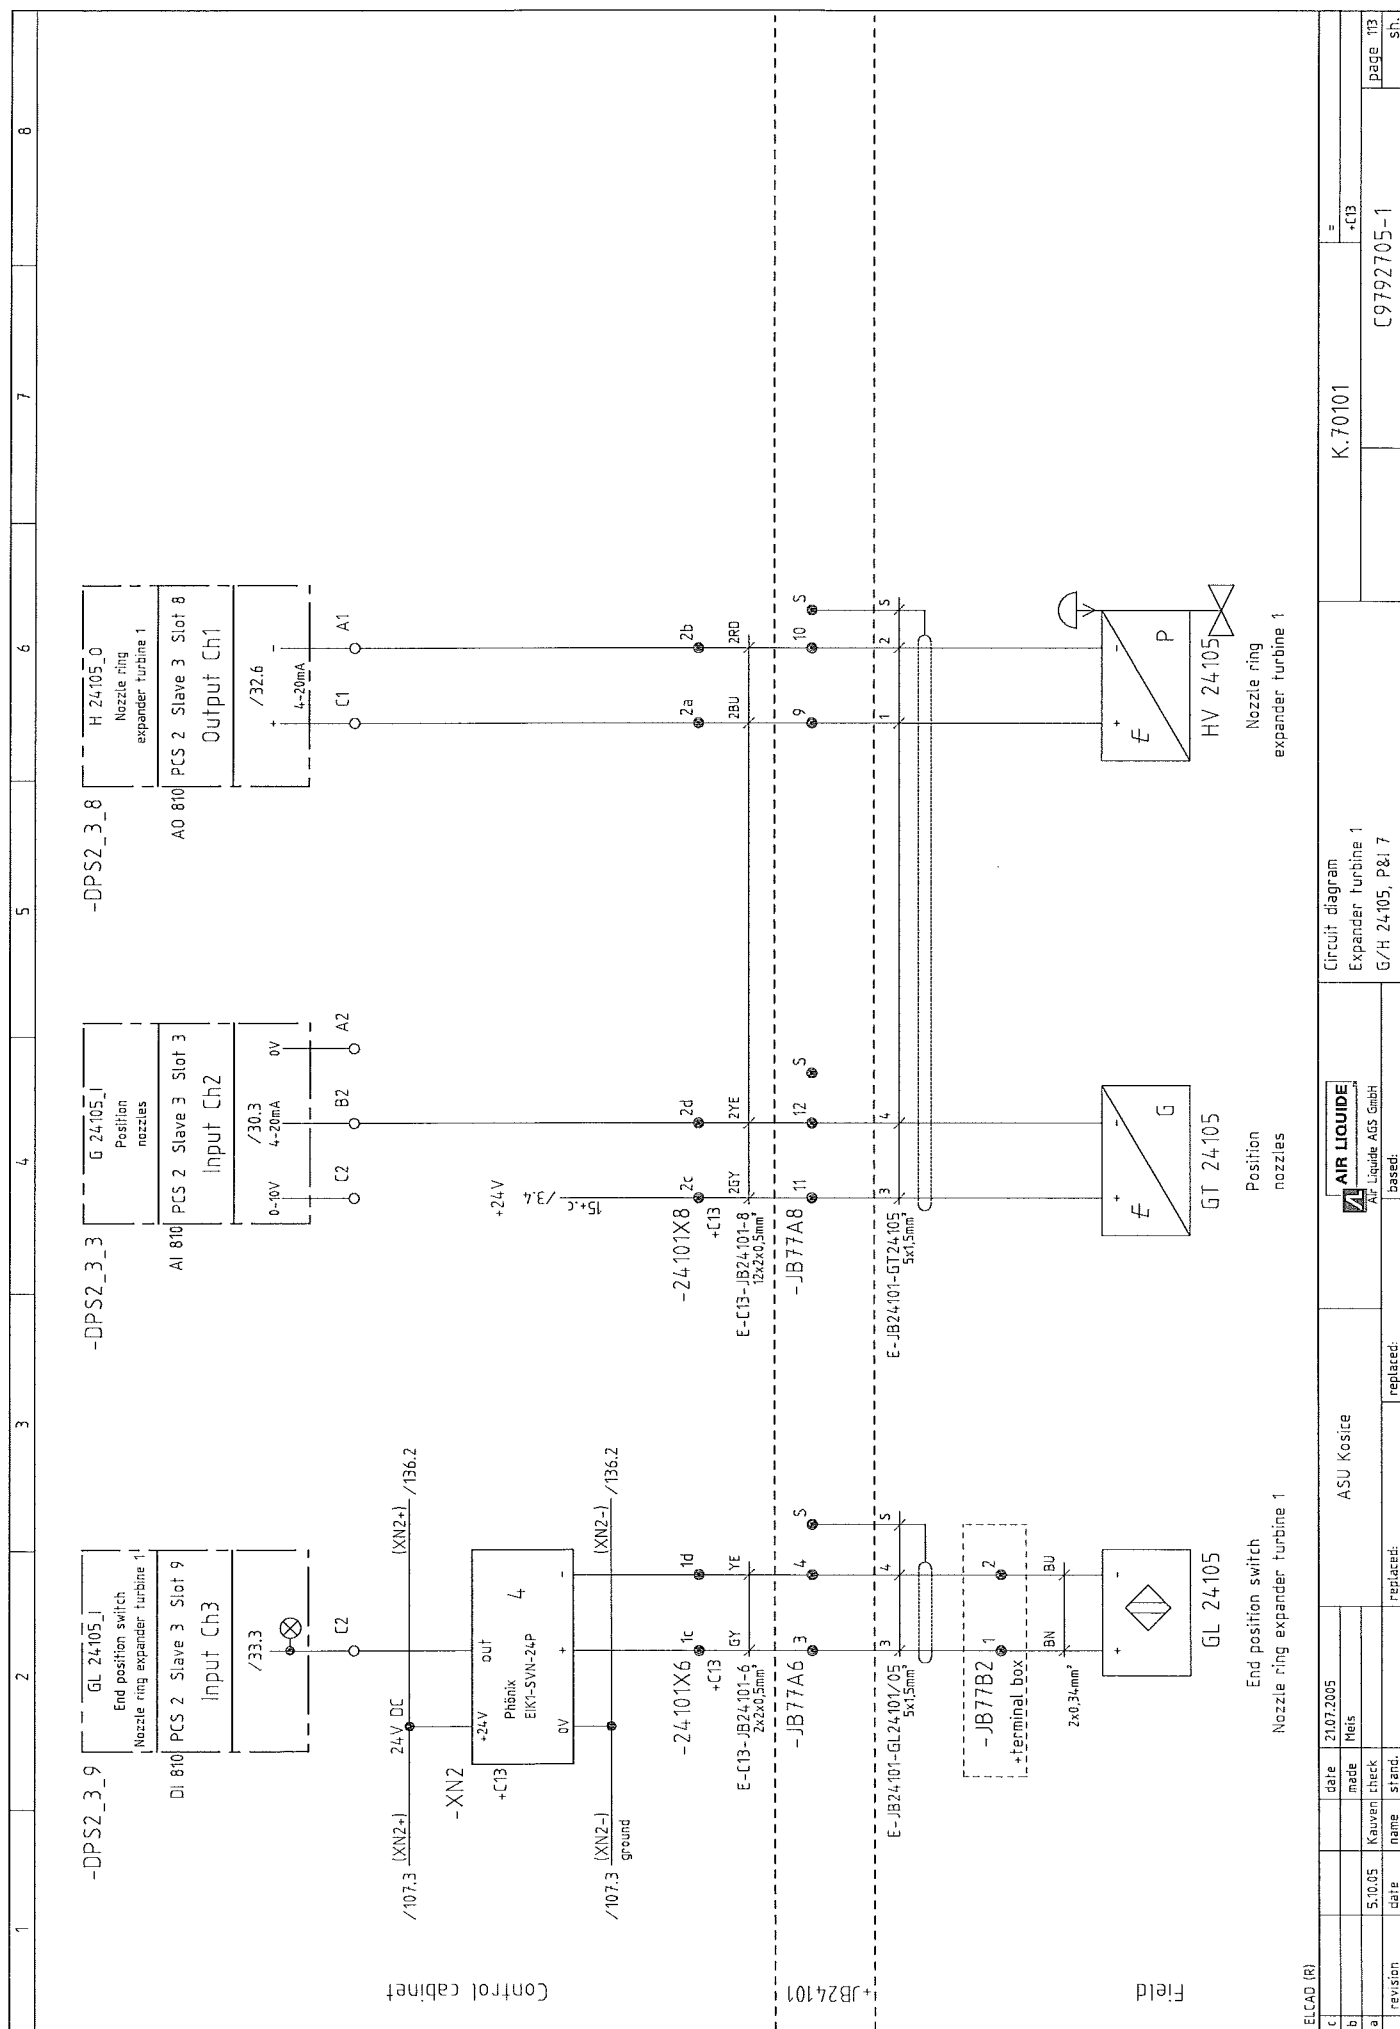


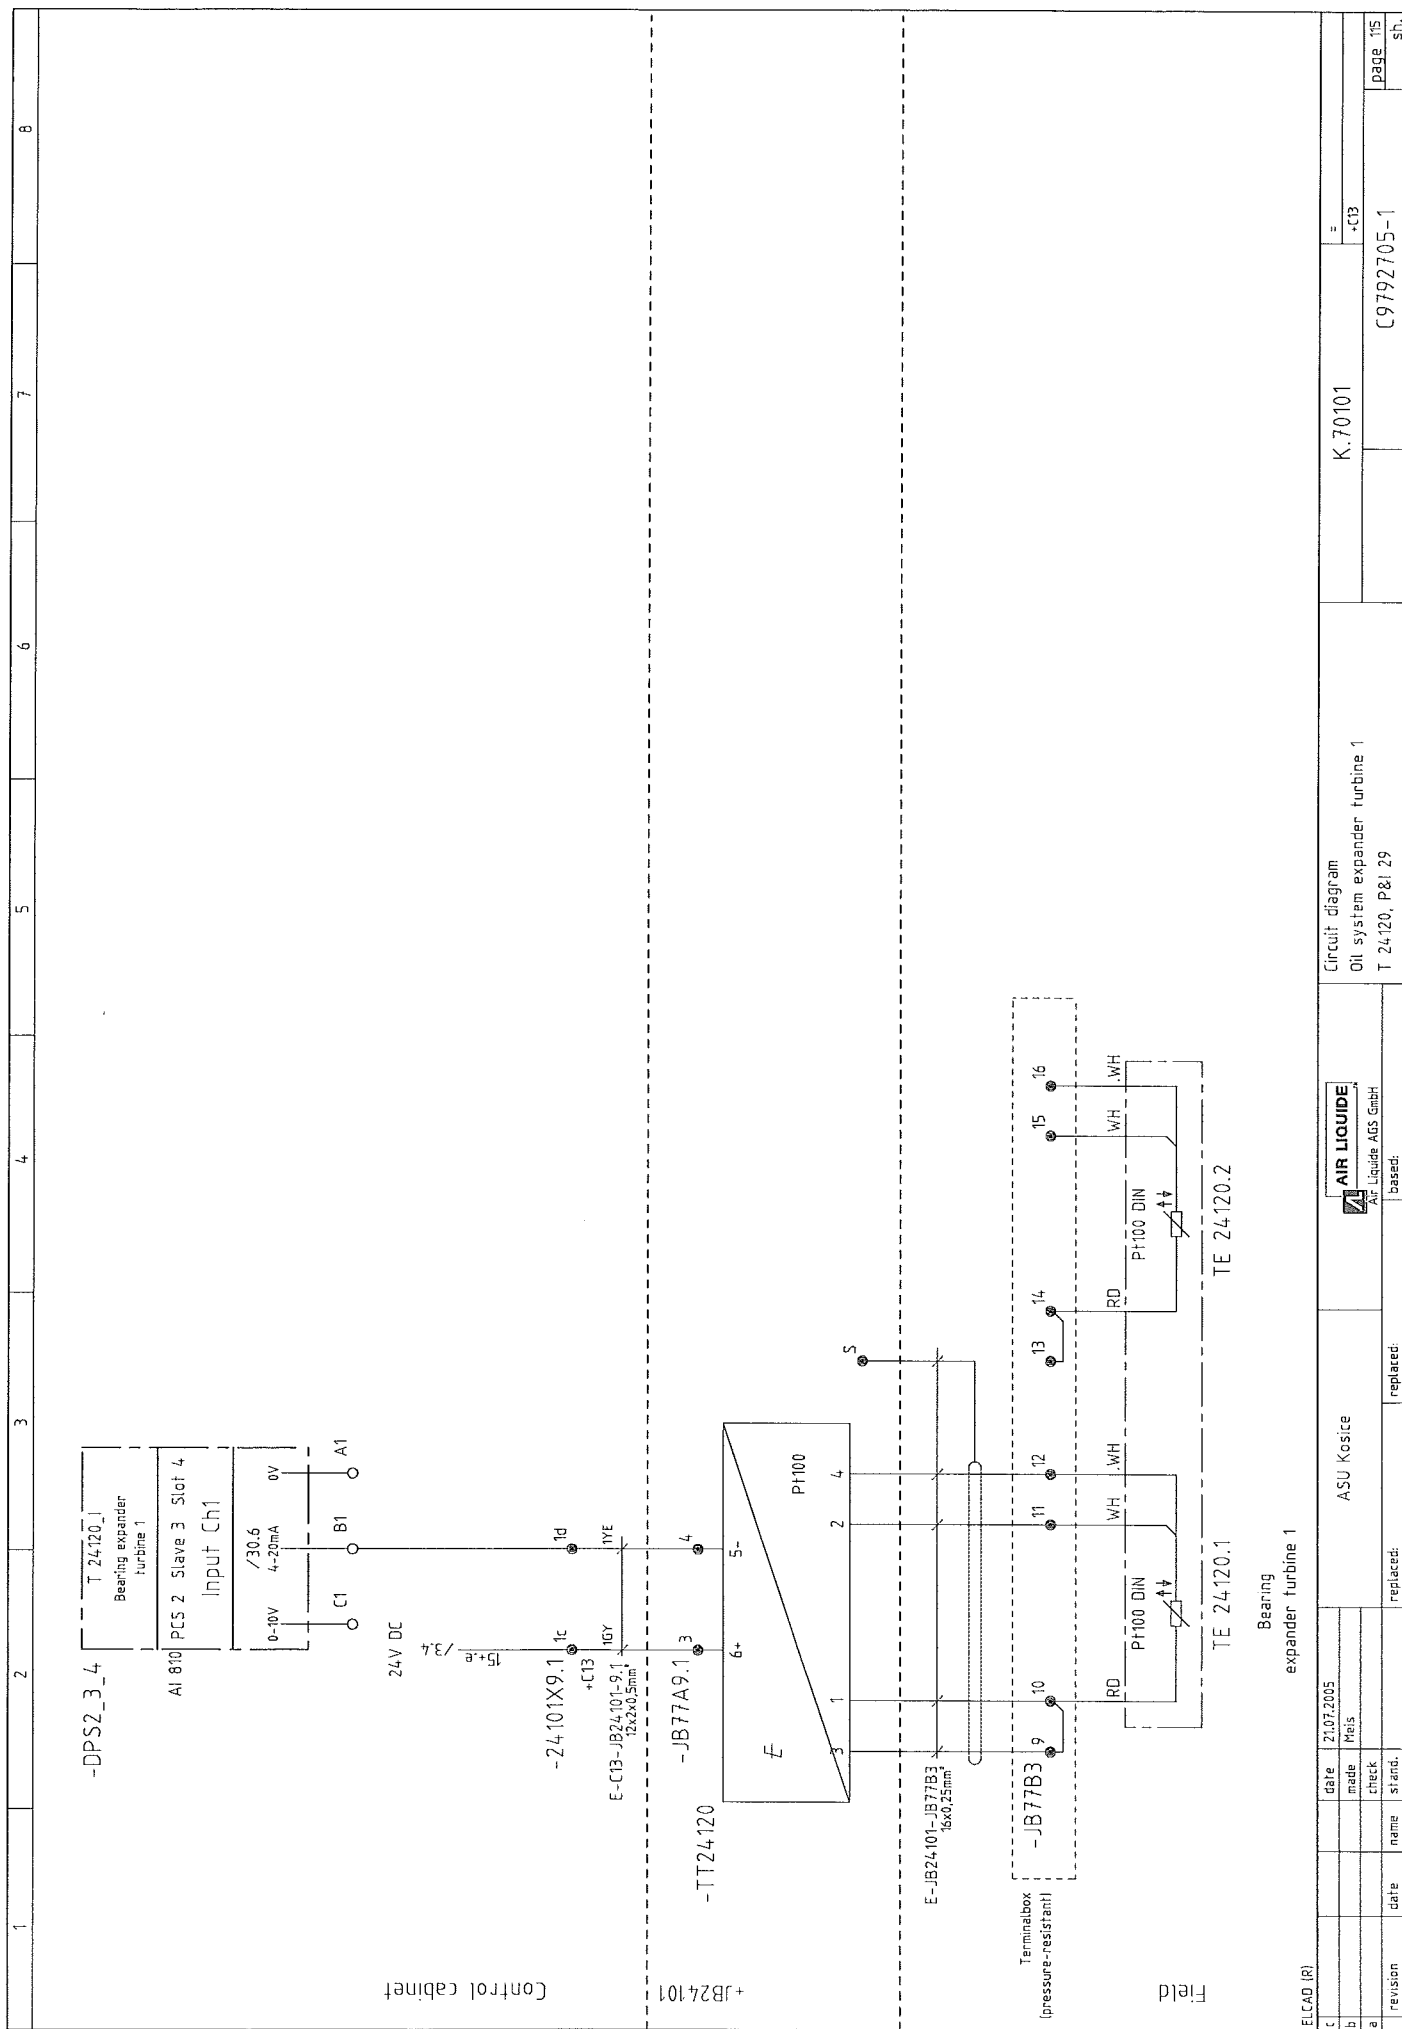

1	2	3	4	5	6	7	8																
<div style="display: flex; justify-content: space-between;"> <div> <p>-DPS2_3_4</p> <p>Control cabinet</p> </div> <div> <p>T 24121.1 Bearing expander turbine 1</p> <p>AI 810 PCS 2 Slave 3 Slot 4 Input Ch2</p> <p>0-10V 4-20mA 0V</p> <p>24V DC</p> <p>-24101X9.1</p> <p>E-C13-JB24101-9.1 12x2x0.5mm</p> <p>-JB77A9.1</p> <p>-TT24121</p> <p>+JB24101</p> </div> <div> <p>Field</p> <p>TE 24121.1</p> <p>TE 24121.2</p> <p>Bearing expander turbine 1</p> </div> </div>																							
<p>ELCAD (R)</p> <table border="1"> <tr> <td>c</td> <td>date</td> <td>21.07.2005</td> <td>made</td> <td>Yelis</td> <td>check</td> <td>stand.</td> <td>replaced:</td> </tr> <tr> <td>b</td> <td>revision</td> <td></td> <td>name</td> <td></td> <td>date</td> <td></td> <td></td> </tr> </table> <p>ASU Kostice</p> <p>AIR LIQUIDE Air Liquide AGS GmbH based:</p> <p>Circuit diagram Oil system expander turbine 1 T 24121, P&I 29</p> <p>K.70101</p> <p>= +C13</p> <p>C9792705-1</p> <p>page 1/6</p> <p>sh</p>								c	date	21.07.2005	made	Yelis	check	stand.	replaced:	b	revision		name		date		
c	date	21.07.2005	made	Yelis	check	stand.	replaced:																
b	revision		name		date																		

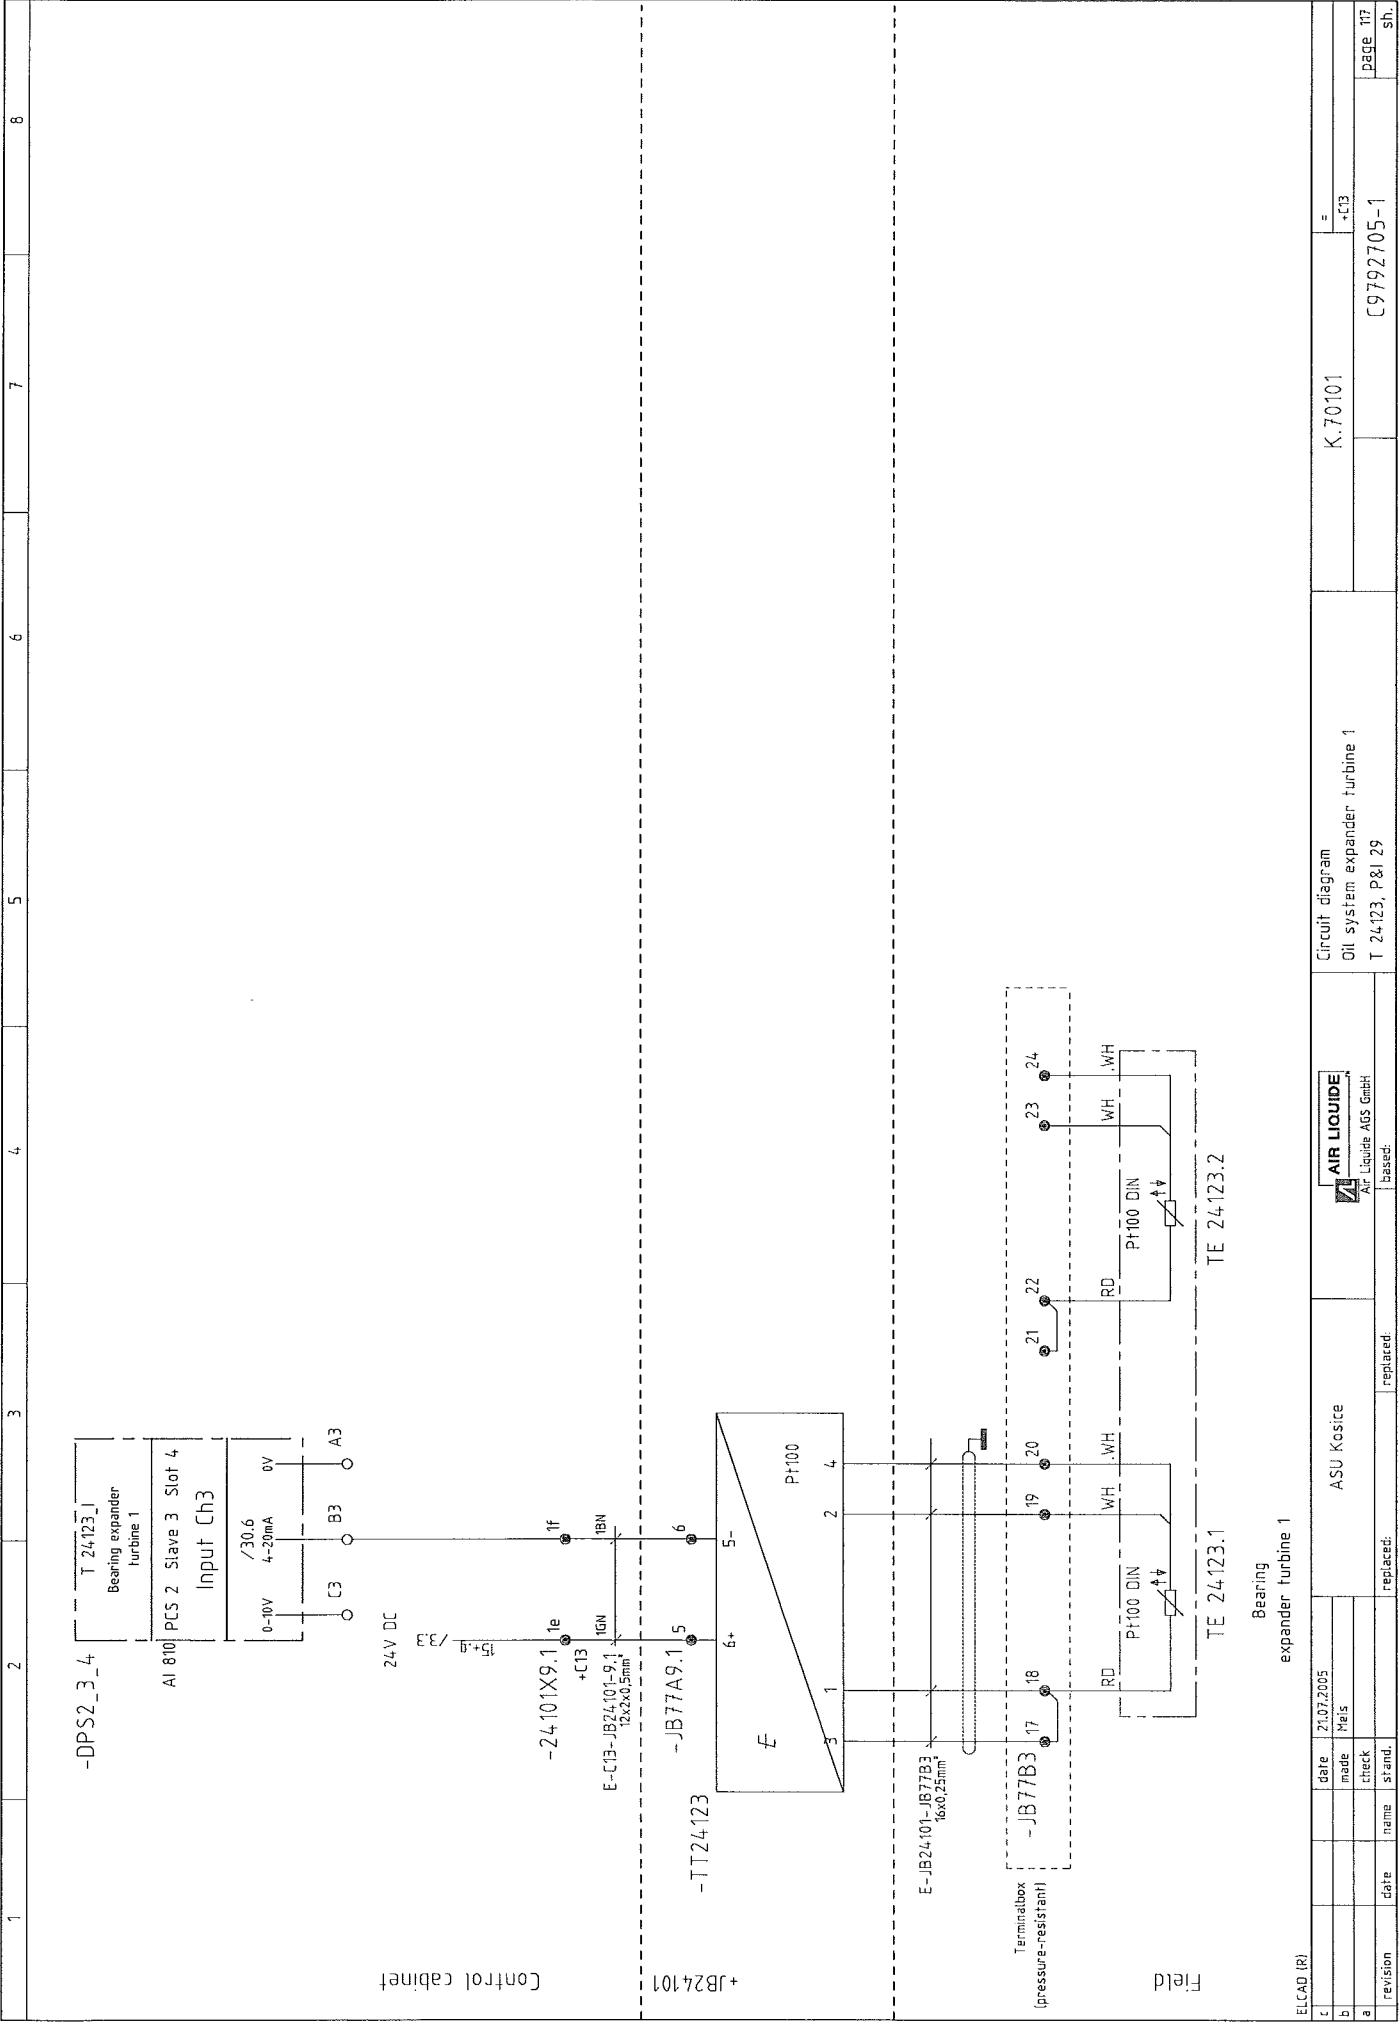

[illegible]

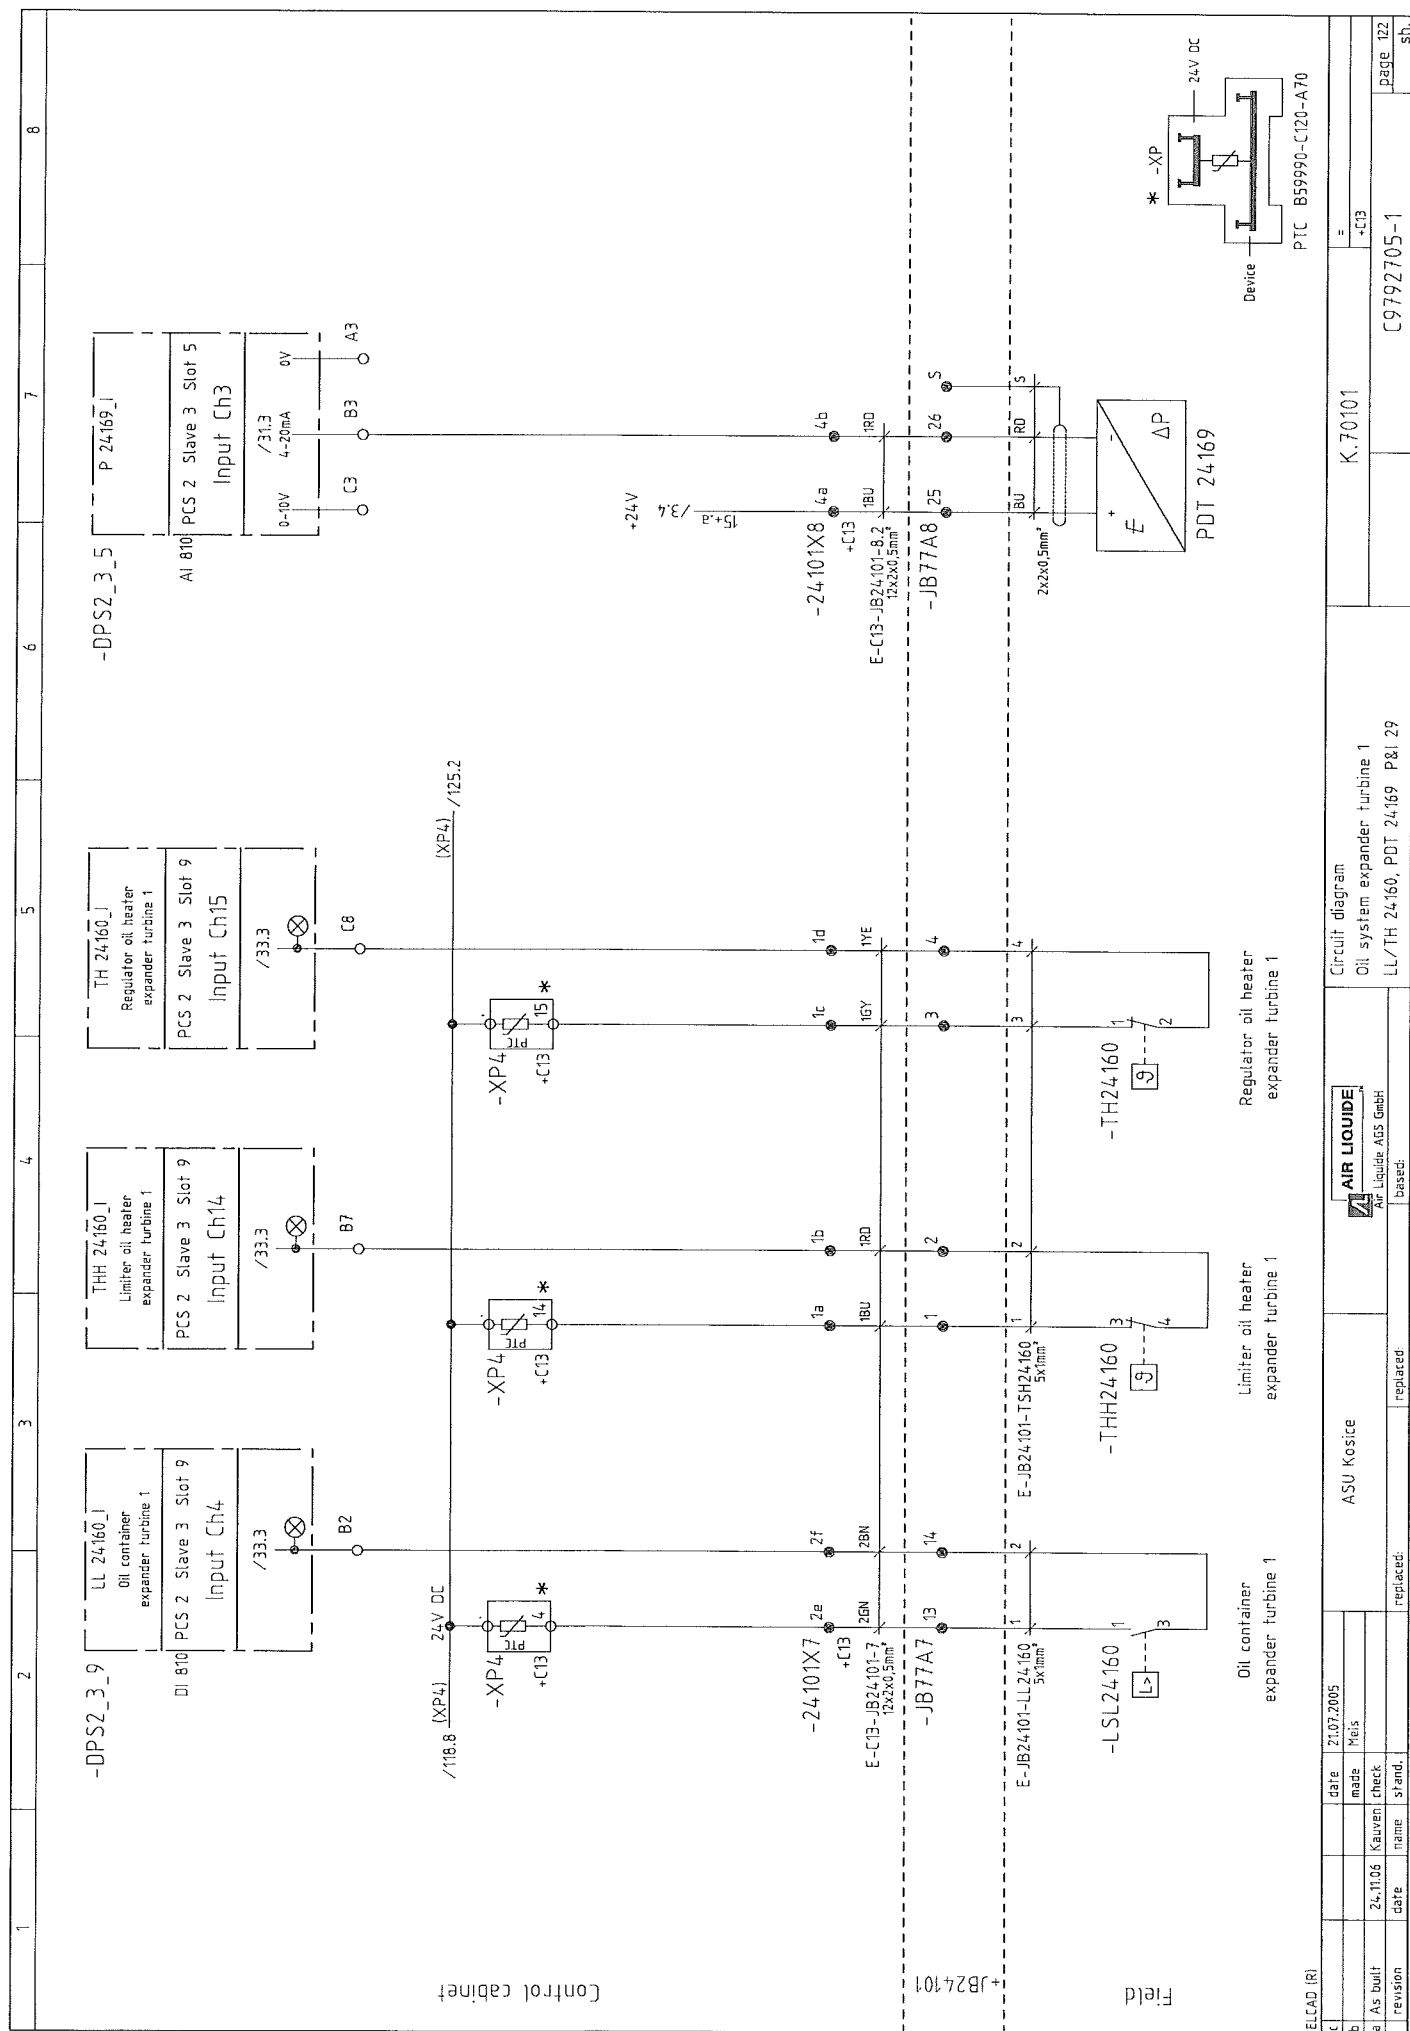









1	2	3	4	5	6	7	8
Control cabinet							
+JB24701							
Field							
ELCAD (R)							
c				date	21.07.2005		
b				made	Mels		
a	As built	24.11.06	Kauven	check			
revision		date	name	stand.			
				replaced:		replaced:	
ASU Kosice				AIR LIQUIDE		Circuit diagram	
				Air Liquide AGS GmbH		Oil system expander turbine 1	
				based:		Spare	
						K.70101	
						+C13	
						page 124	
						sh.	
						C9792705-1	

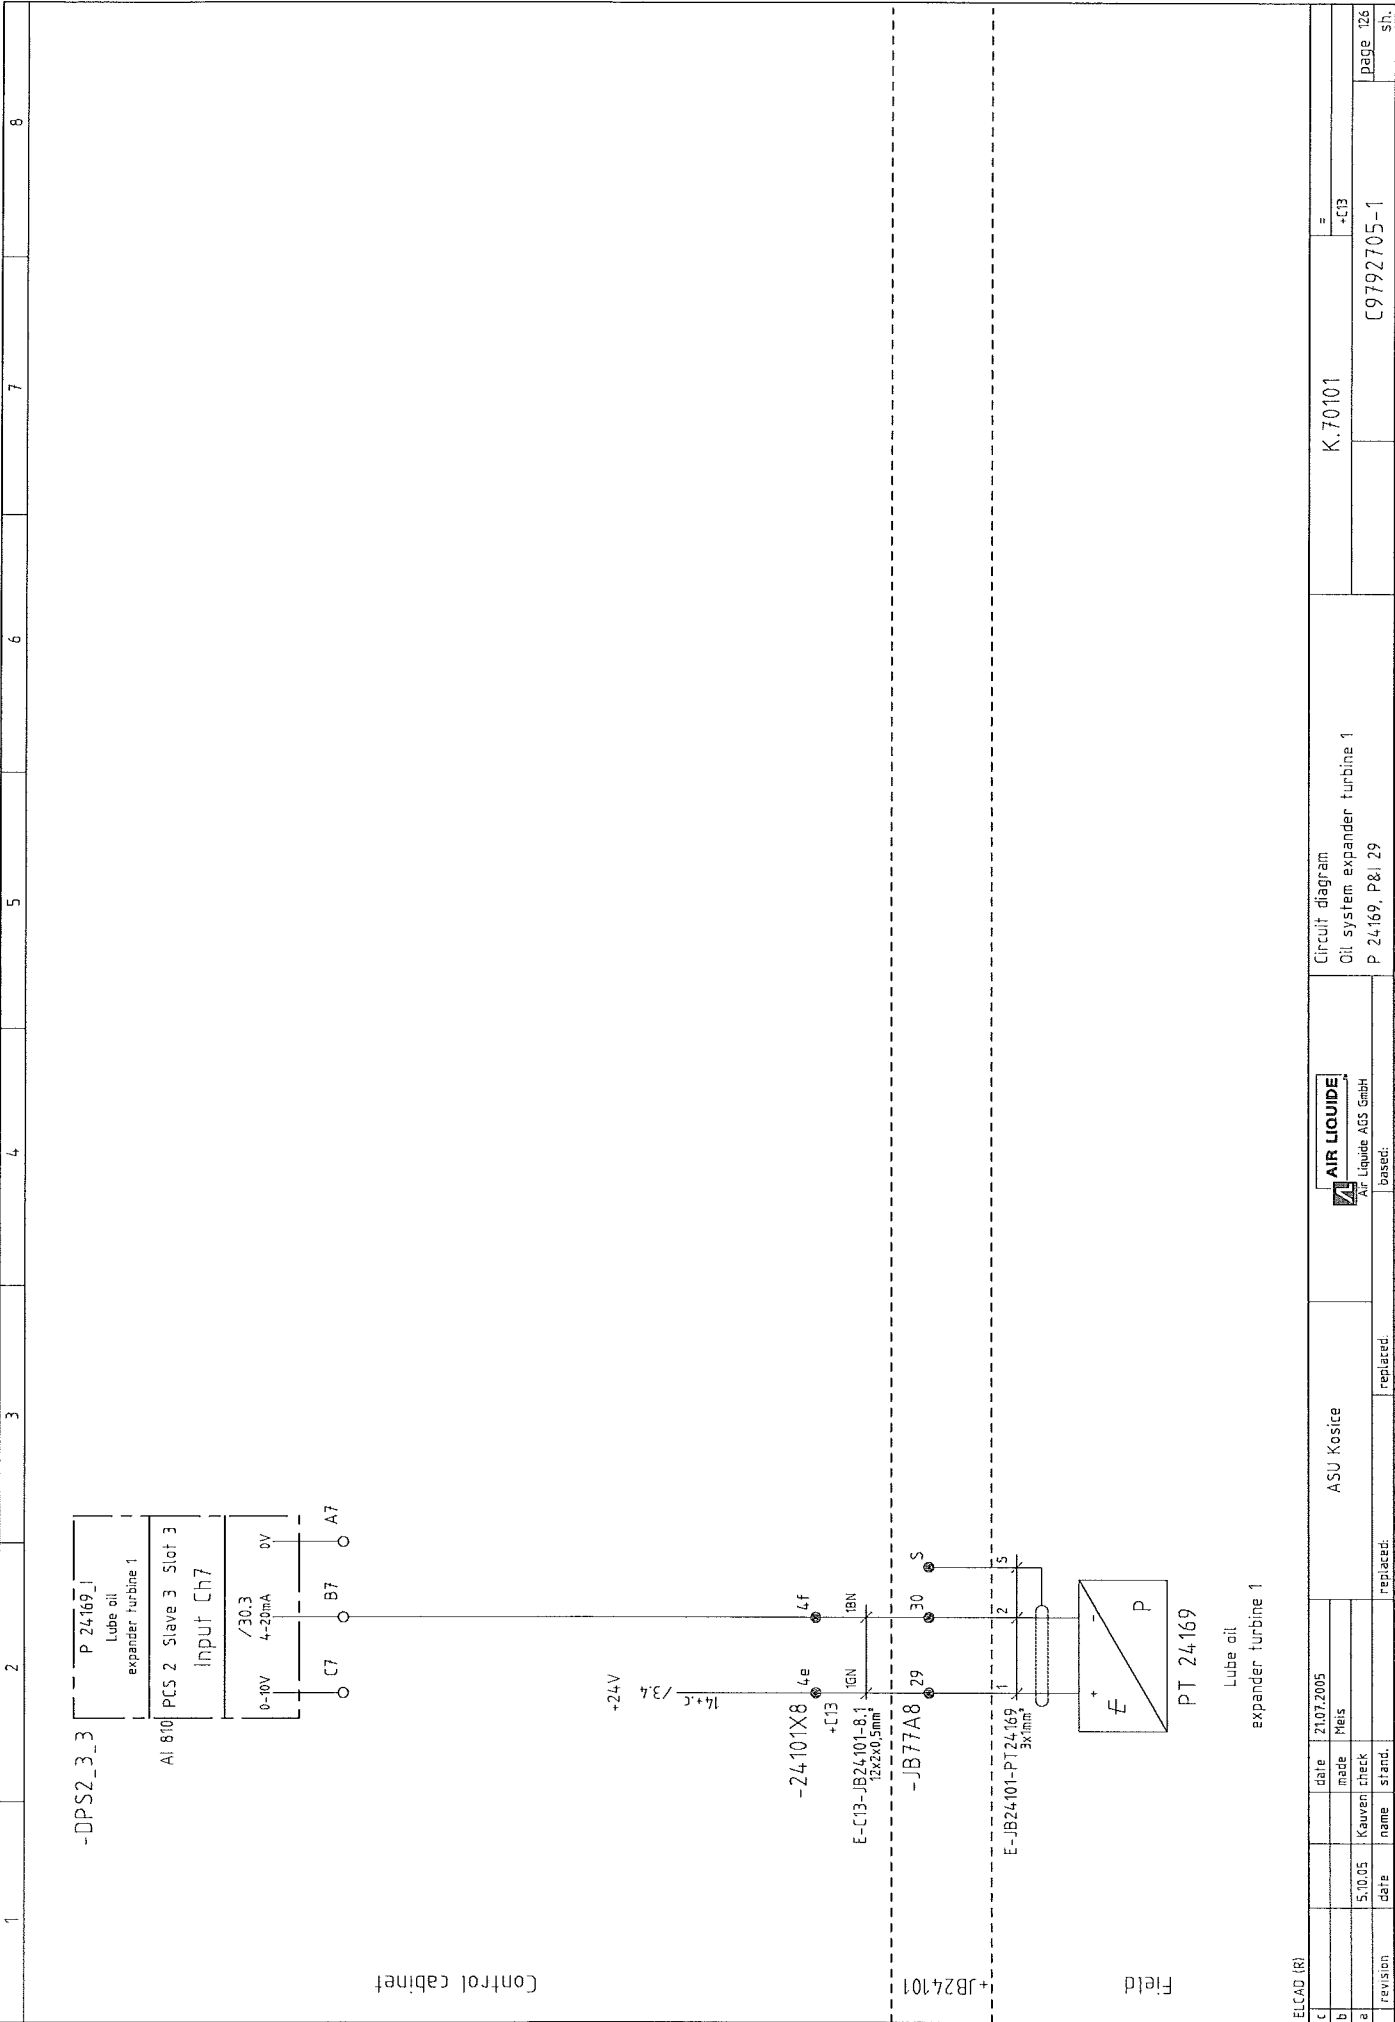

[illegible]

Control cabinet

Generator junction box

Oil system expander turbine 1

TE 24173

Bearing generator turbine 1

ASU Kostice

date 21.07.2005

made Meis

check

stand

revision

date

name

replaced:

replaced:

AIR LIQUIDE

Air Liquide AGS GmbH

based:

Circuit diagram

Oil system expander turbine 1

T 24173, P&I 29


K.70101

+CB

C9792705-1


sh

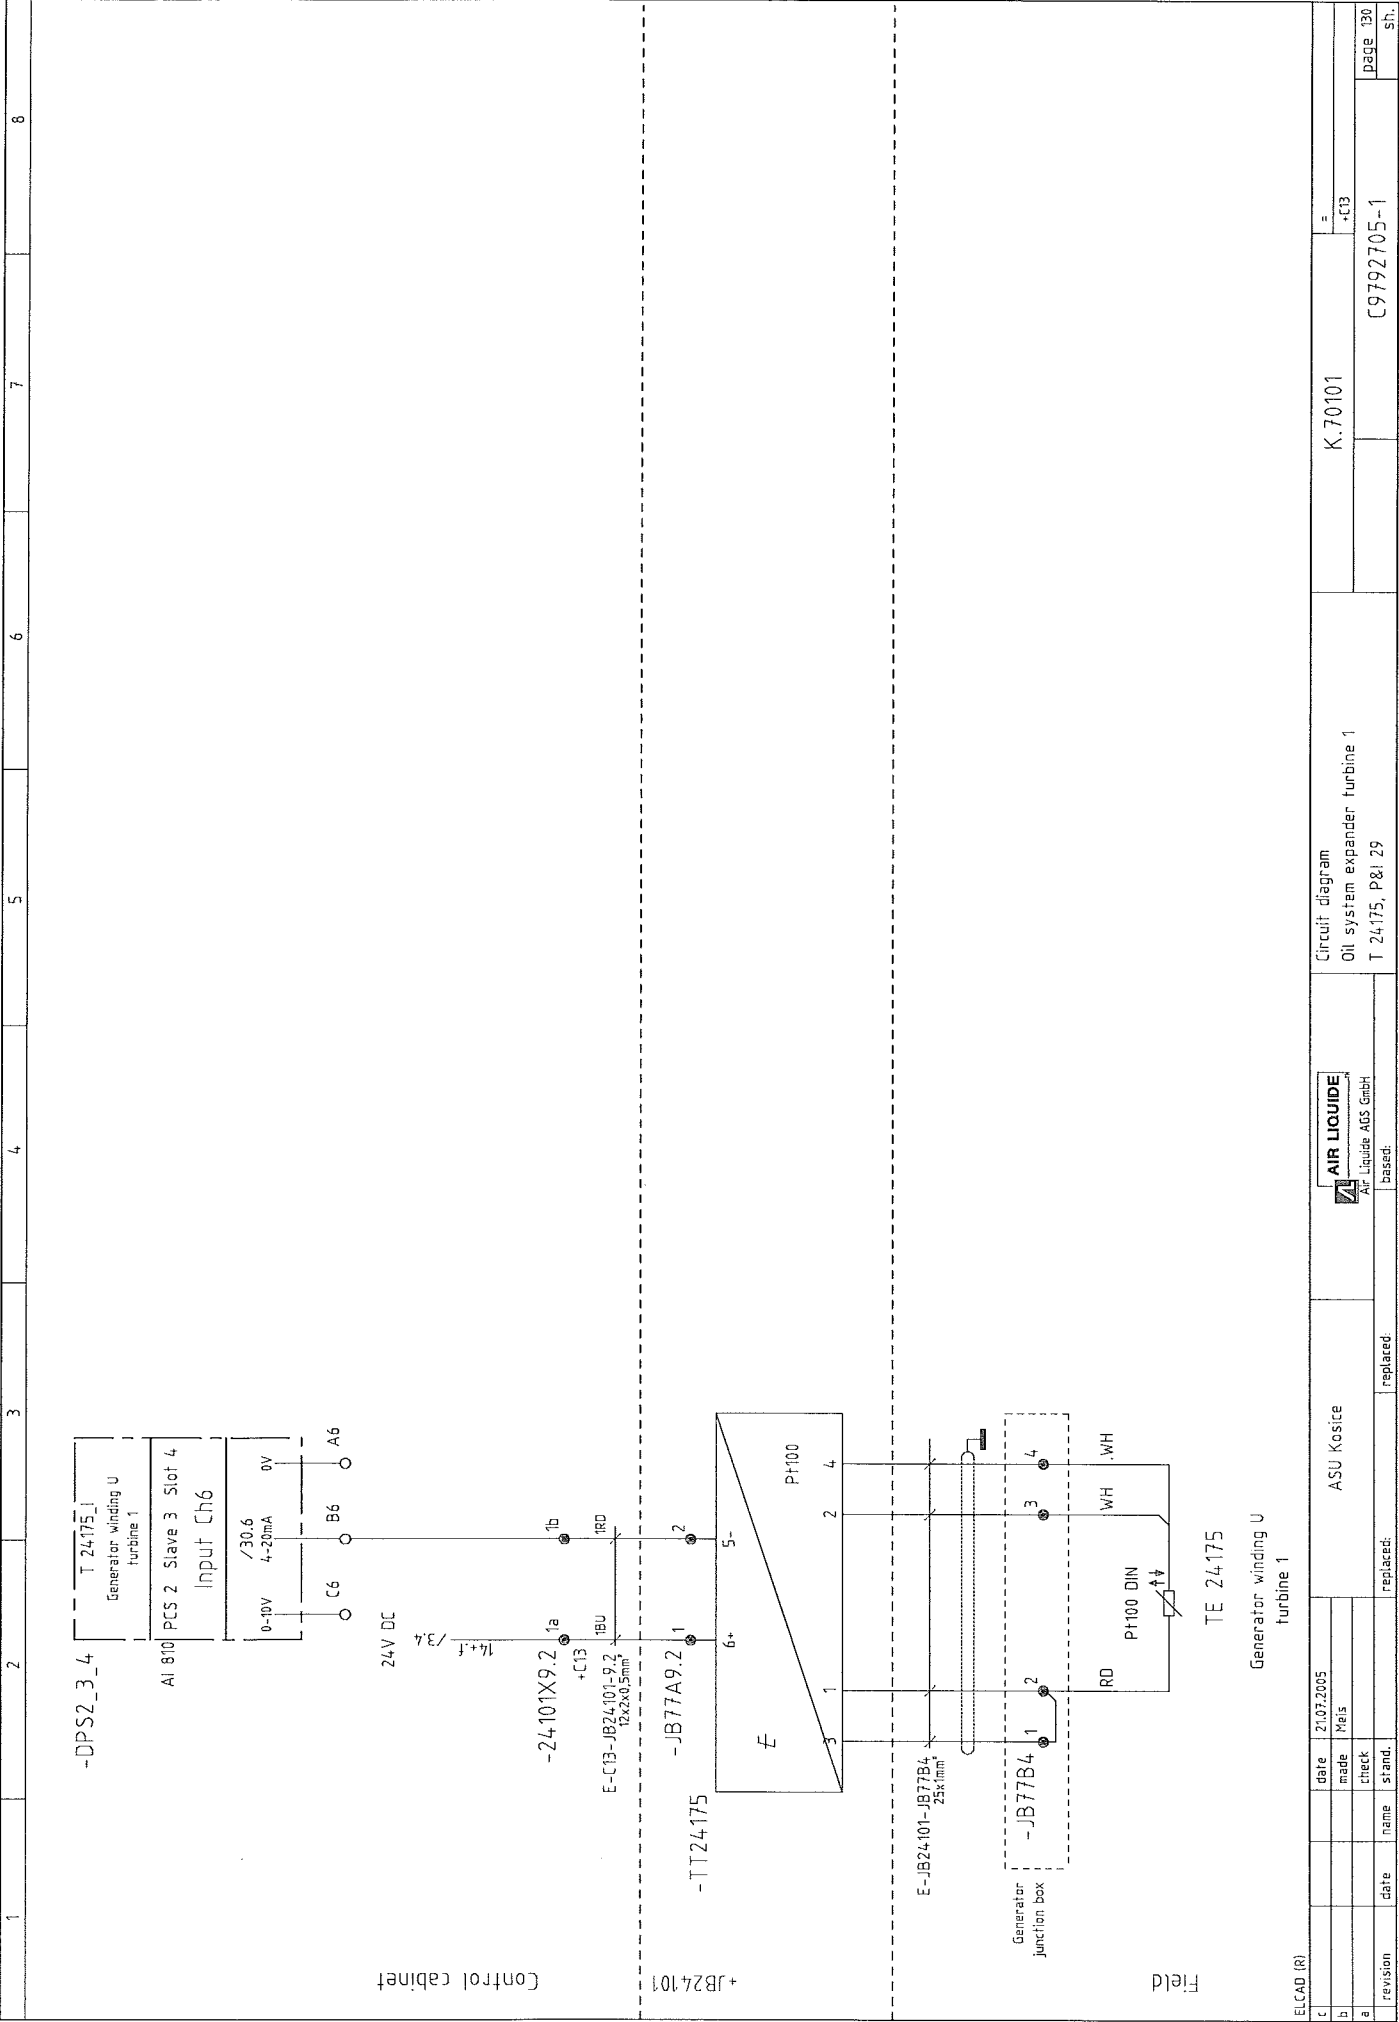











[illegible]


Gezeichnet mit ELCAD IR!		Datum: 21.07.2005		ASU Koste		Circuit diagram		Alle Leitungen ohne Querschnittsangabe sind mm²	
c		Datum:	21.07.2005			K.70101		=	
b		Bearb.	Mals					•C13	
a		Gepr.							
Änderung		Name		Ersatz durch:		Ersatz für:		C9792705-1	
		Datum				Spare		Blatt 83	
								Bl.	

[illegible]

The diagram illustrates the electrical control logic for the US 24200 interlocking generator MG 24201. It is divided into three horizontal sections by dashed lines, labeled 1, 2, and 3 at the bottom. The top section, labeled 'Control cabinet', contains the 'trip generator' and 'direct stop' logic. The 'trip generator' section includes components like -K1, -JB77A5, and -24201X5. The 'direct stop' section includes components like -JB77A3, -24201X3, and -92002K2. The bottom section, labeled 'US 24200 interlocking generator MG 24201', contains the generator's internal components and interlocking logic. The diagram shows the flow of electrical signals between these components, including trip signals, stop signals, and interlocking signals. The diagram is a schematic representation of the generator's control system, showing the electrical connections and components involved in its operation and safety.

ELCAD (R)

c	
b	As built
a	
	revision

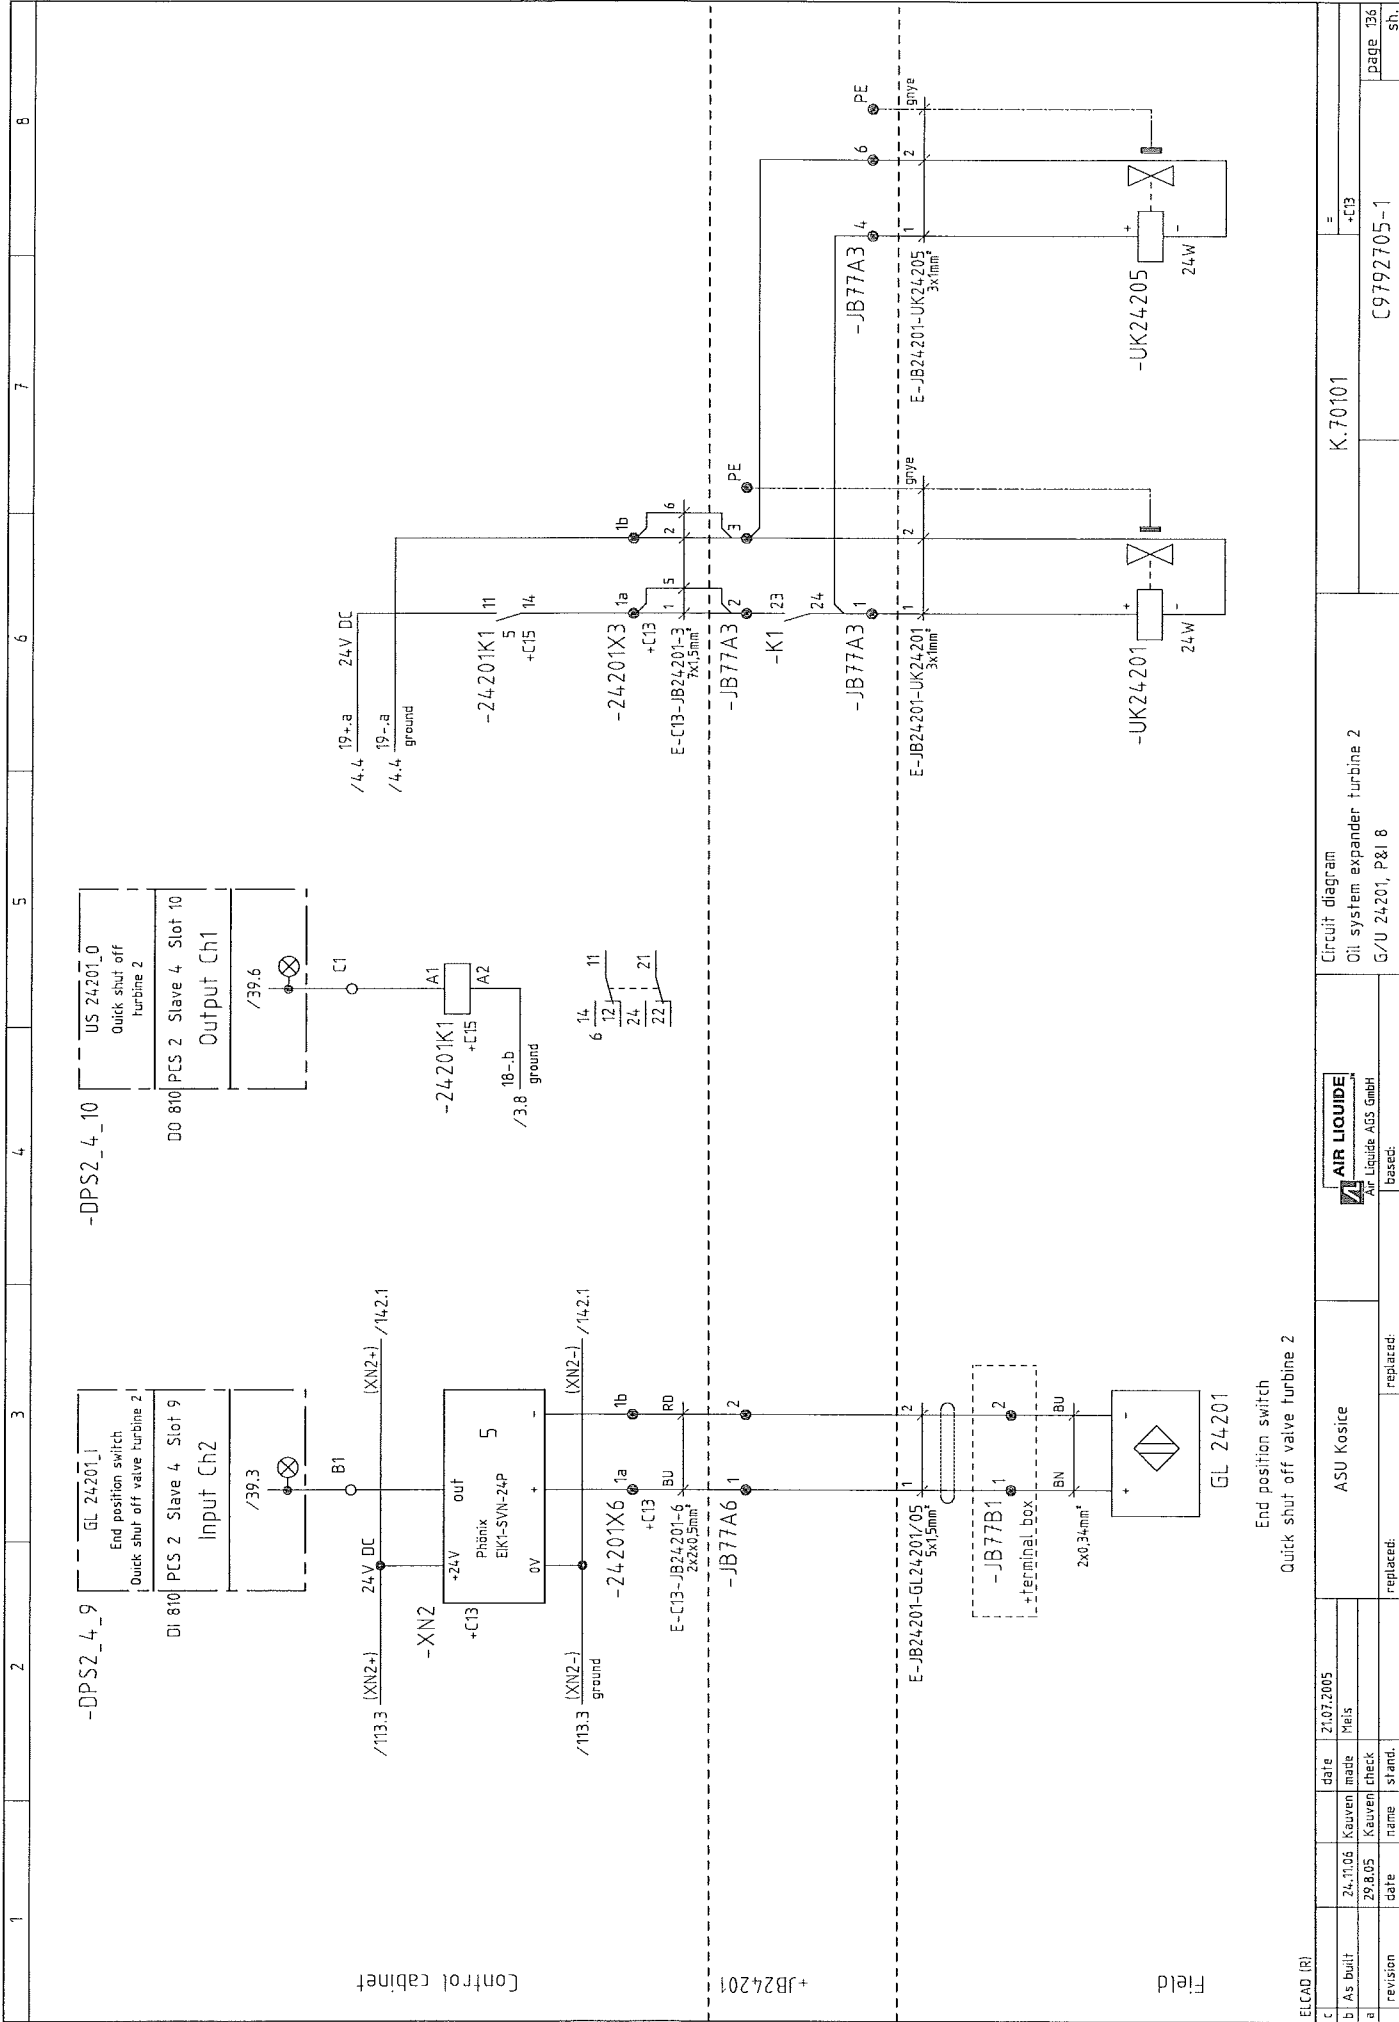

End position switch
Quick shut off valve turbine 2

ELCAD (R)		ASU Kostice		Circuit diagram		K.70101	
c	date	21.07.2005		Oil system expander turbine 2		=	
b	As built	24.11.06	Kauven made	G/U 24201, P&I 8		-C13	
a	revision	29.8.05	Kauven check	replaced:		C9792705-1	
	date		name	replaced:		sh.	

[illegible]

[illegible]

[illegible]

[illegible]