

ELCAD (R)		date		21.07.2005		ASU Kosice		Circuit diagram		K.70101		=	
c		made		made	Pels			Oil system MAC				-C14	
b		date	24.11.05	check				X 11747, P&I 27					
a	As built	revision		name	stand.	replaced:	replaced:						
										D9792705-1		page 93	
												sh.	

1
2
3
4
5
6
7
8

Control cabinet
Field

-DPS3_1_3

P 11754_1
Seal gas MAC

AI 810 PCS 3 Slave 1 Slot 3
Input Ch8

/18.3
0-10V 4-20mA 0V
C8 B8 A8

+24V

3a 3b

-11002X1 2h 3RD

+C14

E-C14-JB11002-1 2BK 12x2x0.5mm²

-X1 16 17 18

E-JB11002-PT11754 2x15mm²

E-JB11002-PT11754 2x15mm²

PT 11754

Seal gas MAC

Seal chamber

ELCAD (R)

c	24.11.06	Kauwen	made	11/15
b	13.10.05	Kauwen	check	
a				

ASU Kosice

Seal gas MAC

Seal chamber











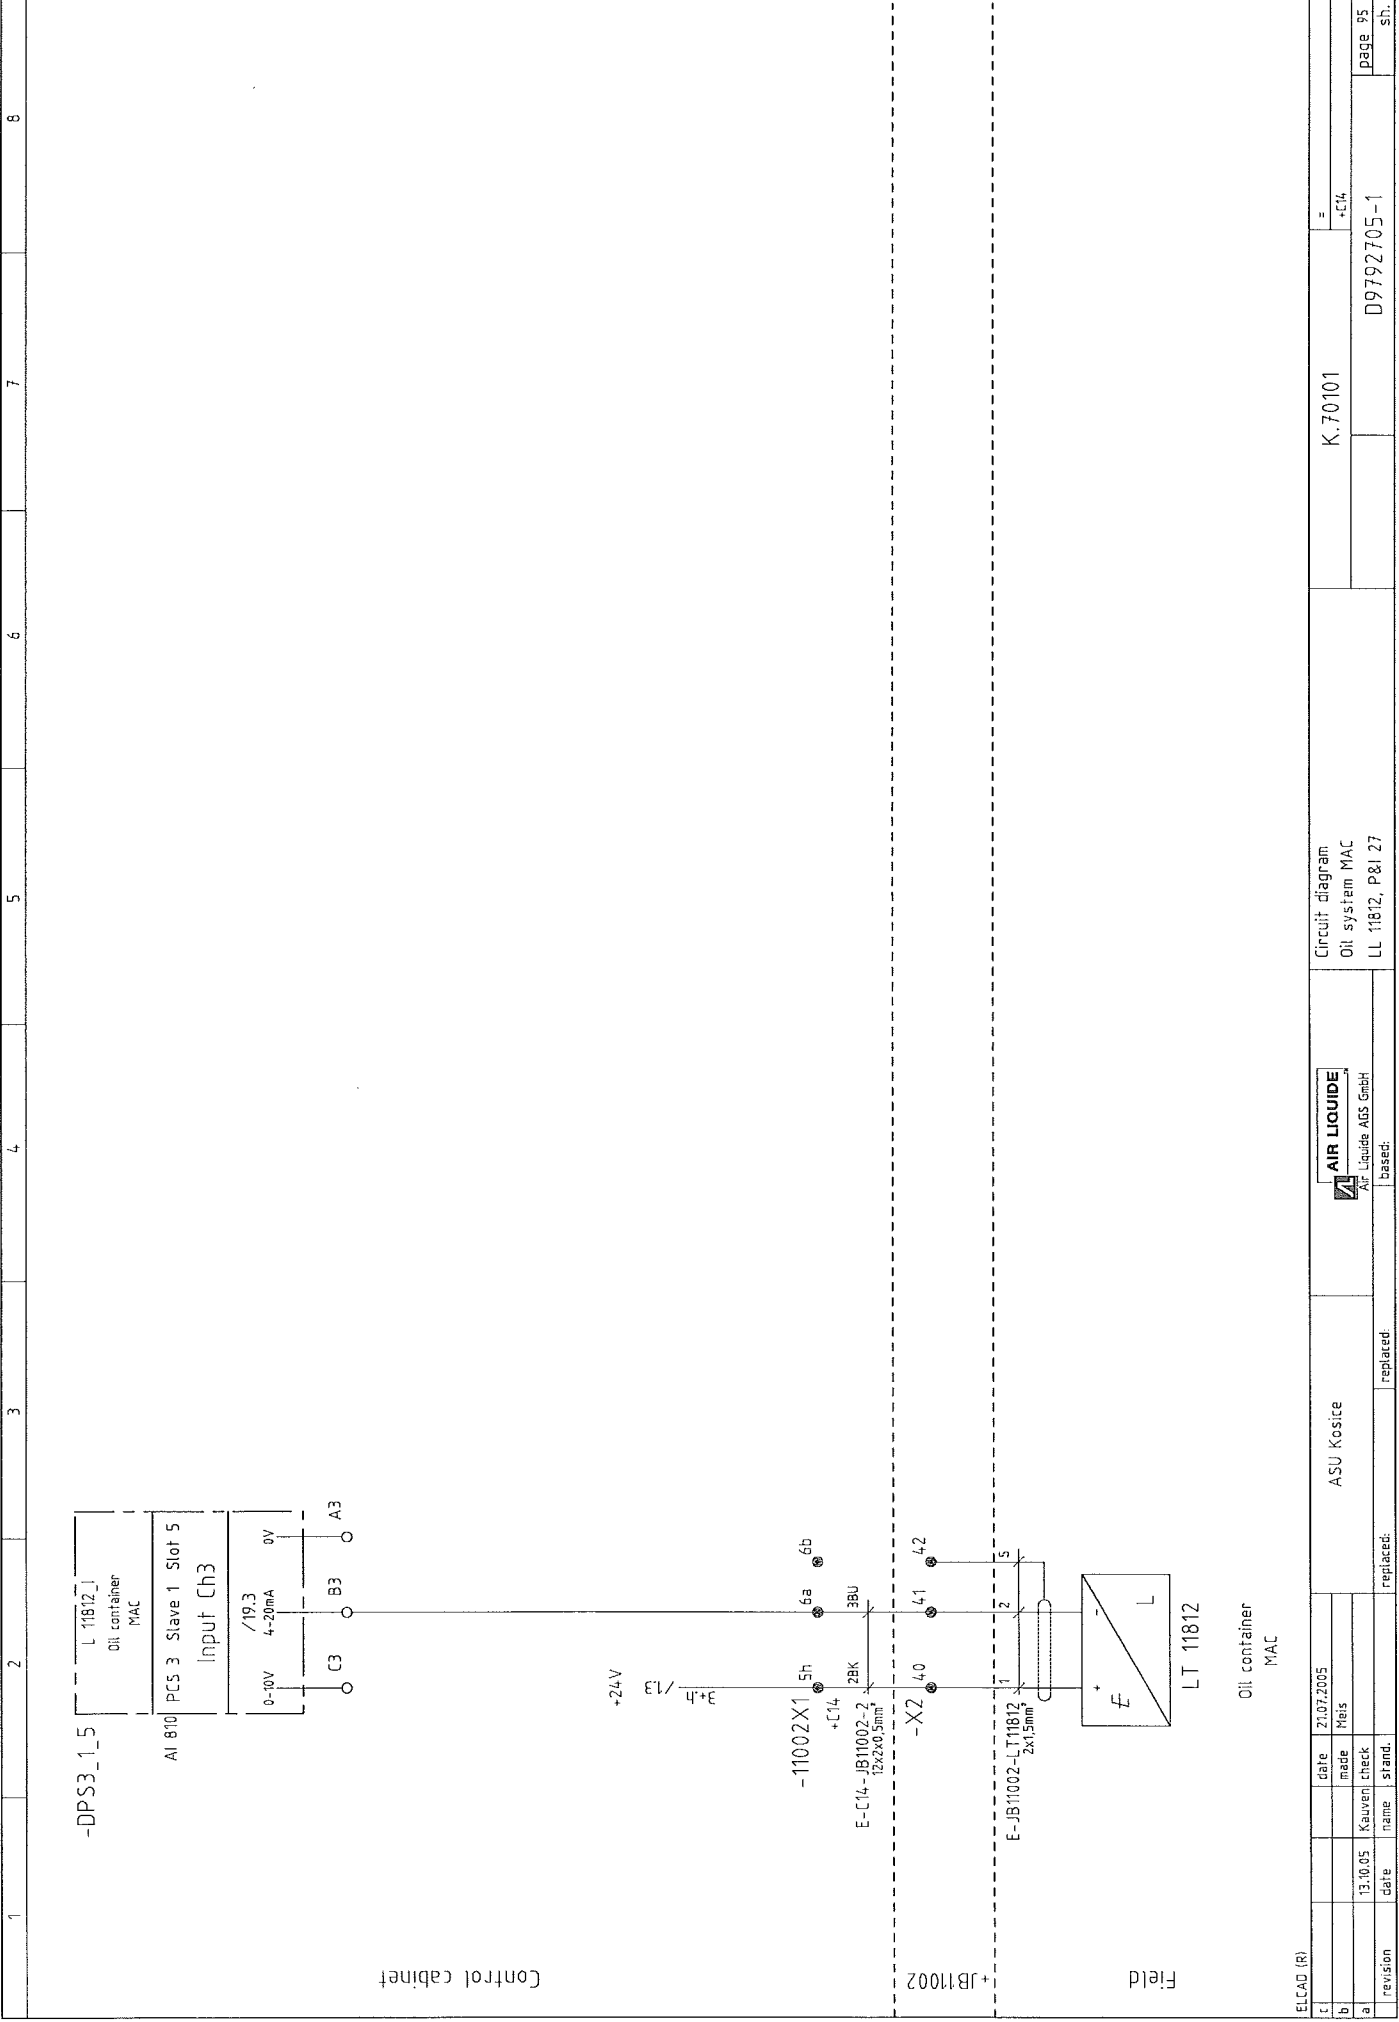

ELCAD (R)		ASU Kosite		AIR LIQUIDE		Circuit diagram	
t		date		21.07.2005		Oil system MAC	
b		made		Mis		LL 11812, P&I 27	
a		Kauven		check		based:	
revision		date		name		stand.	
						replaced:	

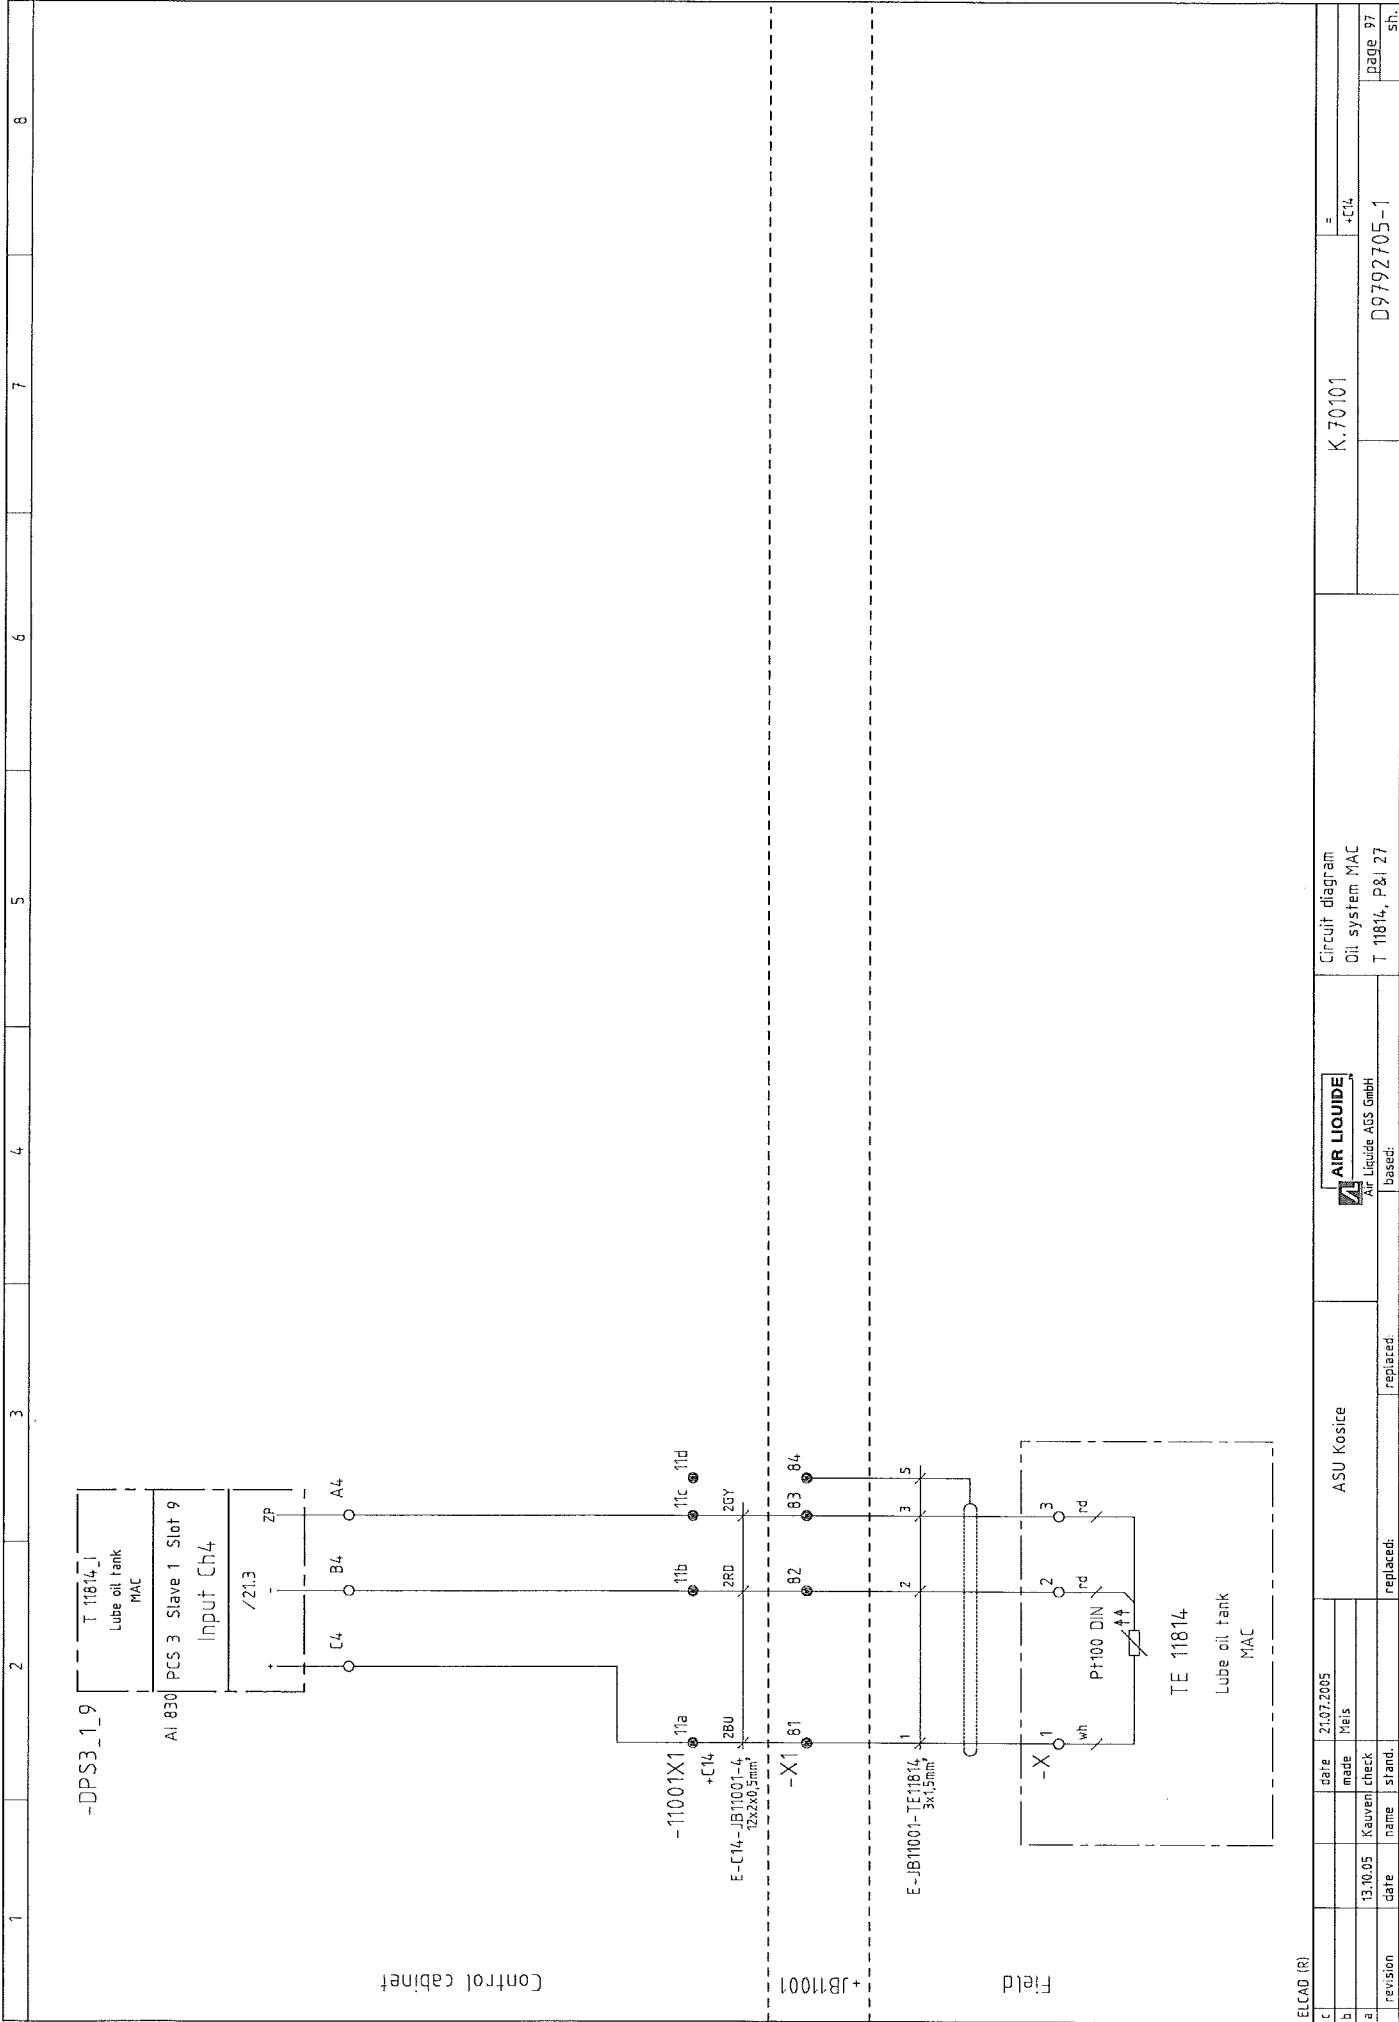













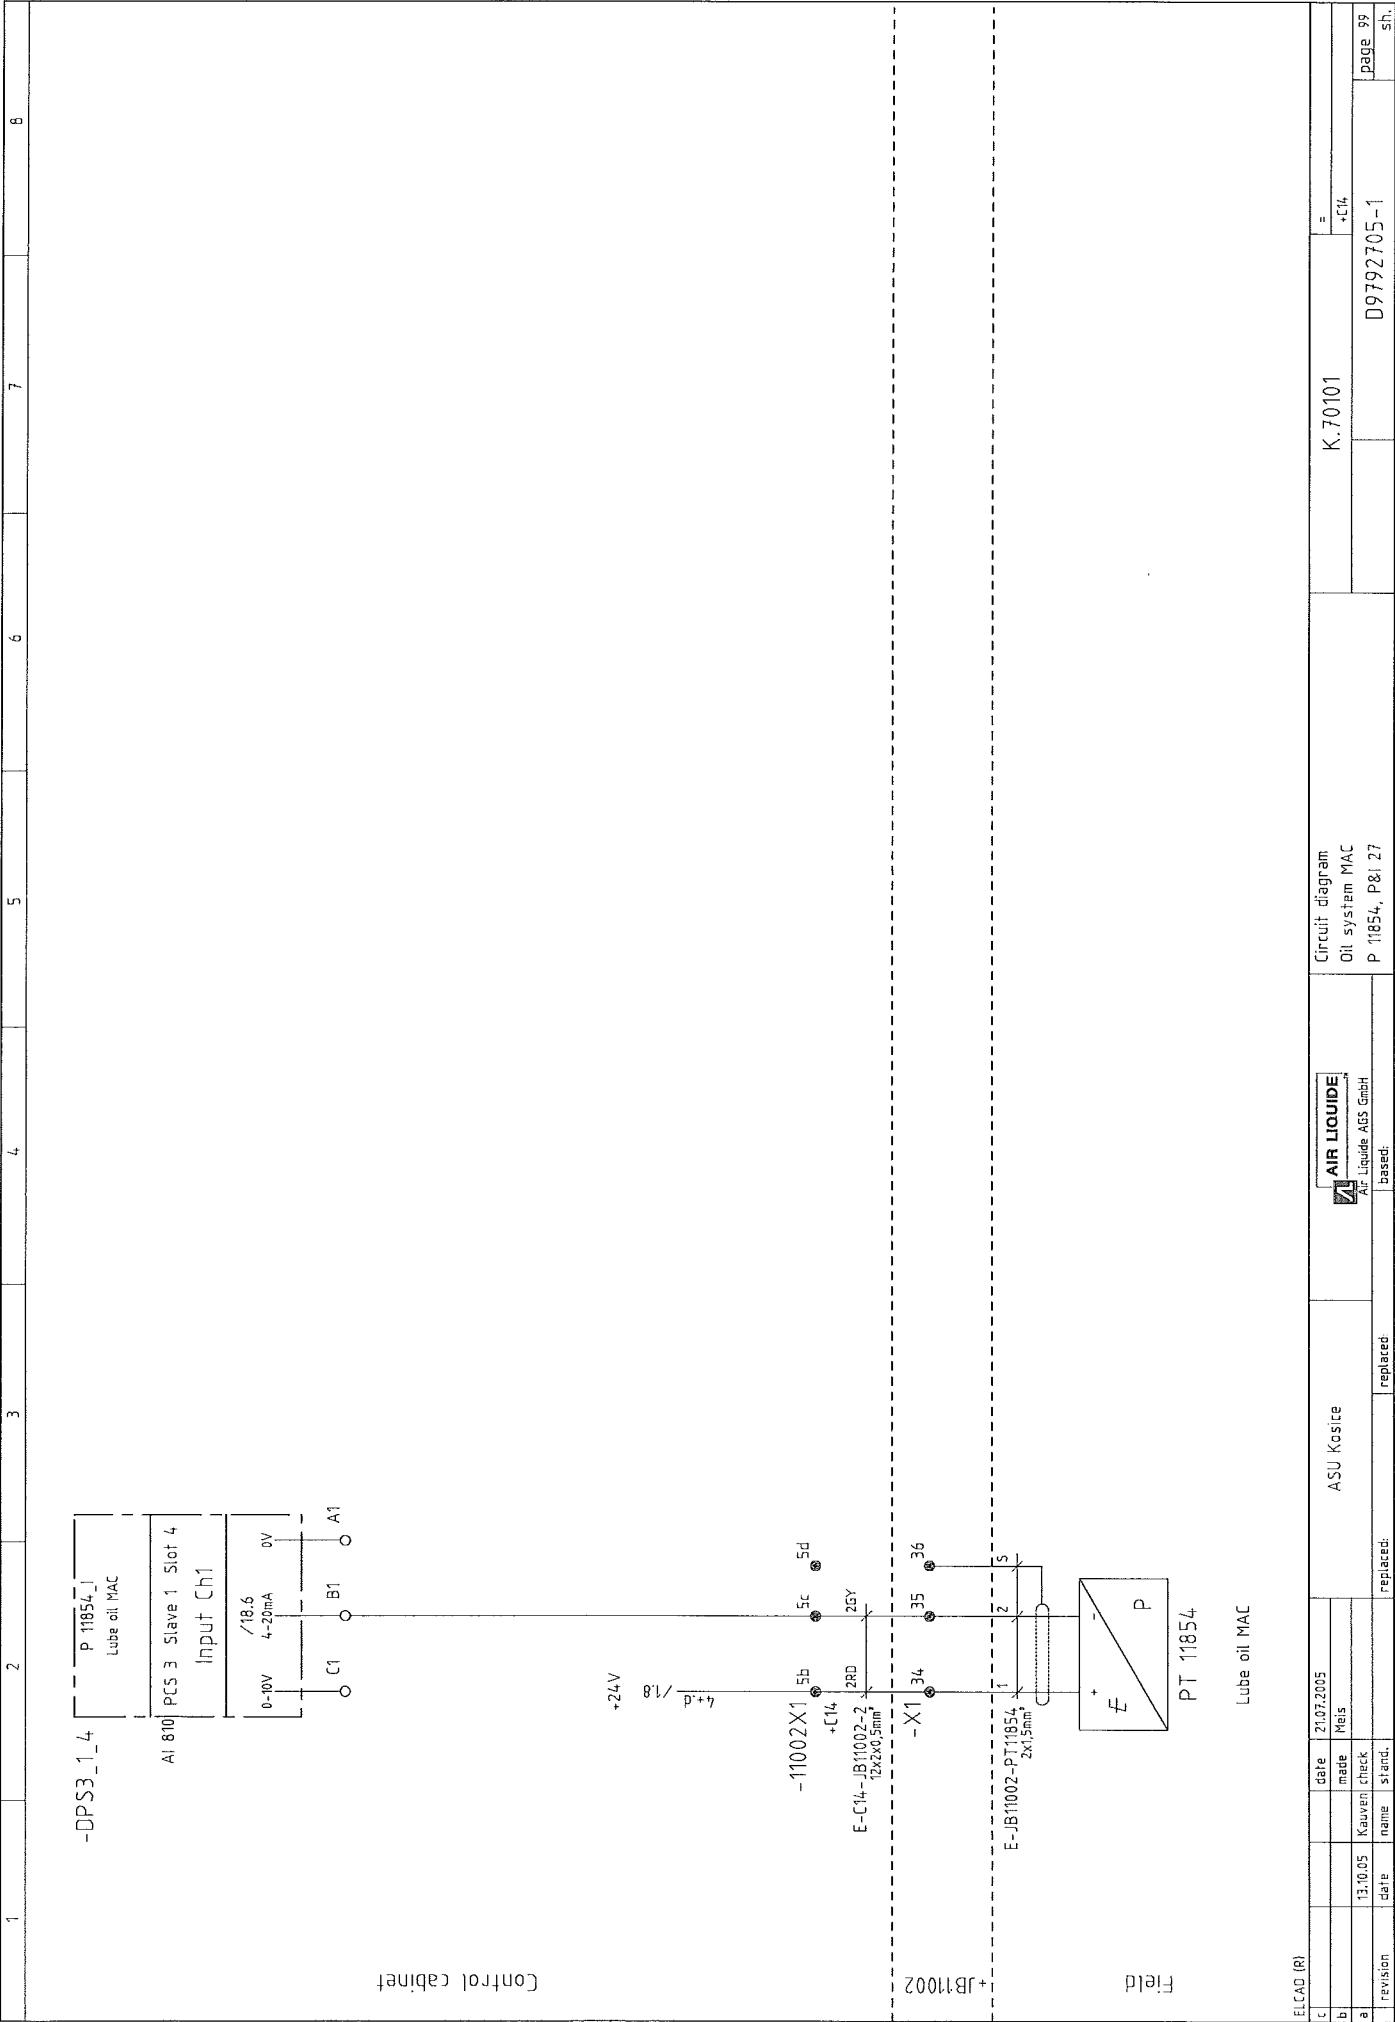

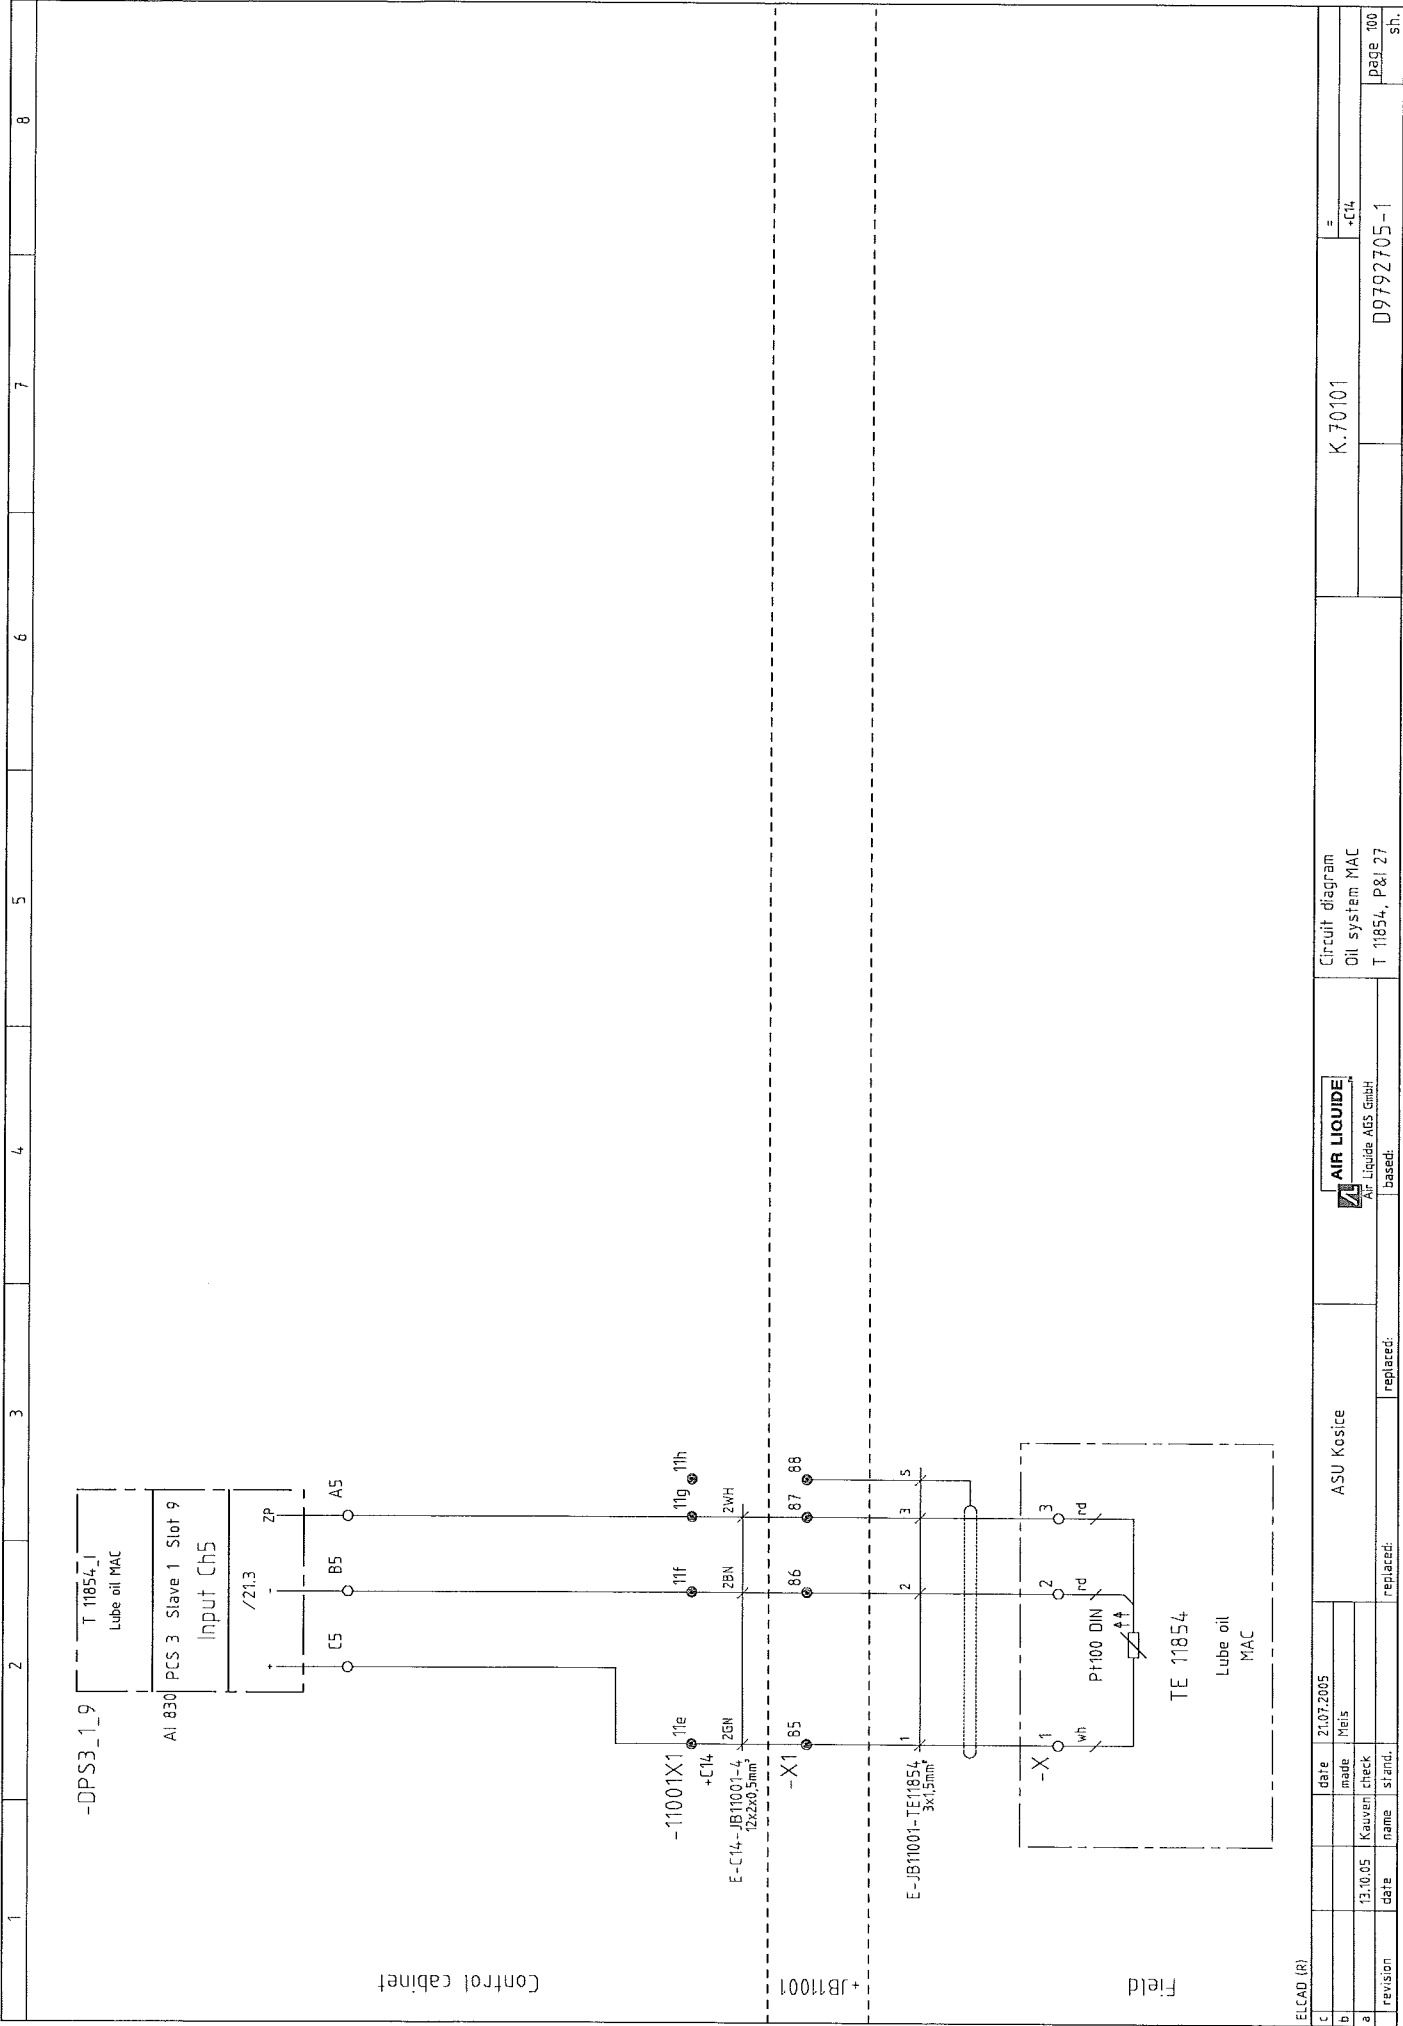

ELCAD (R)

c	date	21.07.2005	ASU Kosice		<div><div><div>AIR LIQUIDE</div><div>Air Liquide AGS GmbH</div></div>based:</div>	Circuit diagram Oil system MAC T 11854, P&I 27	K.70101	= +C14	page 100
	made	Mels							
	13.10.05	Kauvan							
a	revision	date	name	stand.	replaced:				sh.

1	2	3	4	5	6	7	8																																
<div style="display: flex; justify-content: space-between;"> <div> <p>ELCAD (R)</p> <table border="1"> <tr> <td>c</td><td></td><td></td><td></td><td>date</td><td>21.07.2005</td><td></td><td></td></tr> <tr> <td>b</td><td></td><td></td><td></td><td>made</td><td>Meis</td><td></td><td></td></tr> <tr> <td>a</td><td></td><td></td><td></td><td>check</td><td></td><td></td><td></td></tr> <tr> <td></td><td>revision</td><td>date</td><td>name</td><td>stand.</td><td></td><td></td><td></td></tr> </table> </div> <div> <p>ASU Kositce</p> </div> <div> <p>AIR LIQUIDE  Air Liquide AGS GmbH <small>based:</small></p> </div> <div> <p>Circuit diagram</p> </div> <div> <p>K.70101</p> </div> <div> <p>= +C14</p> </div> <div> <p>page 101 sh.</p> </div> </div>								c				date	21.07.2005			b				made	Meis			a				check					revision	date	name	stand.			
c				date	21.07.2005																																		
b				made	Meis																																		
a				check																																			
	revision	date	name	stand.																																			

1		2		3		4		5		6		7		8	

Control cabinet

-DPS3_2_10

P 16007_0
Charge BAC

A0 810 PCS 3 Slave 2 Slot 10
Output Ch3

/27.6
4-20mA
C3 A3

Field

JB20004

-20004X1 1c 1d
+C13
E-C13-JB20004-1
12x2x0.5mm²
16Y

-X1 3 4 S
E-JB20004-PK16007
2x2x0.5mm²

PK 16007
Charge BAC


JB16002

-16002X1 1a 1b 1c
+C14
E-C14-JB16002-1
12x2x0.5mm²
18U
-16074A1.7+ /127.6 (13)
-16074A1.8- /127.6 (14)
to regulator
FIC 16074


-X1 1 2 3 S
E-JB16002-PT16007
2x2x0.5mm²

PT 16007
Suction pressure
BAC


PK 16007
Booster Air Compressor

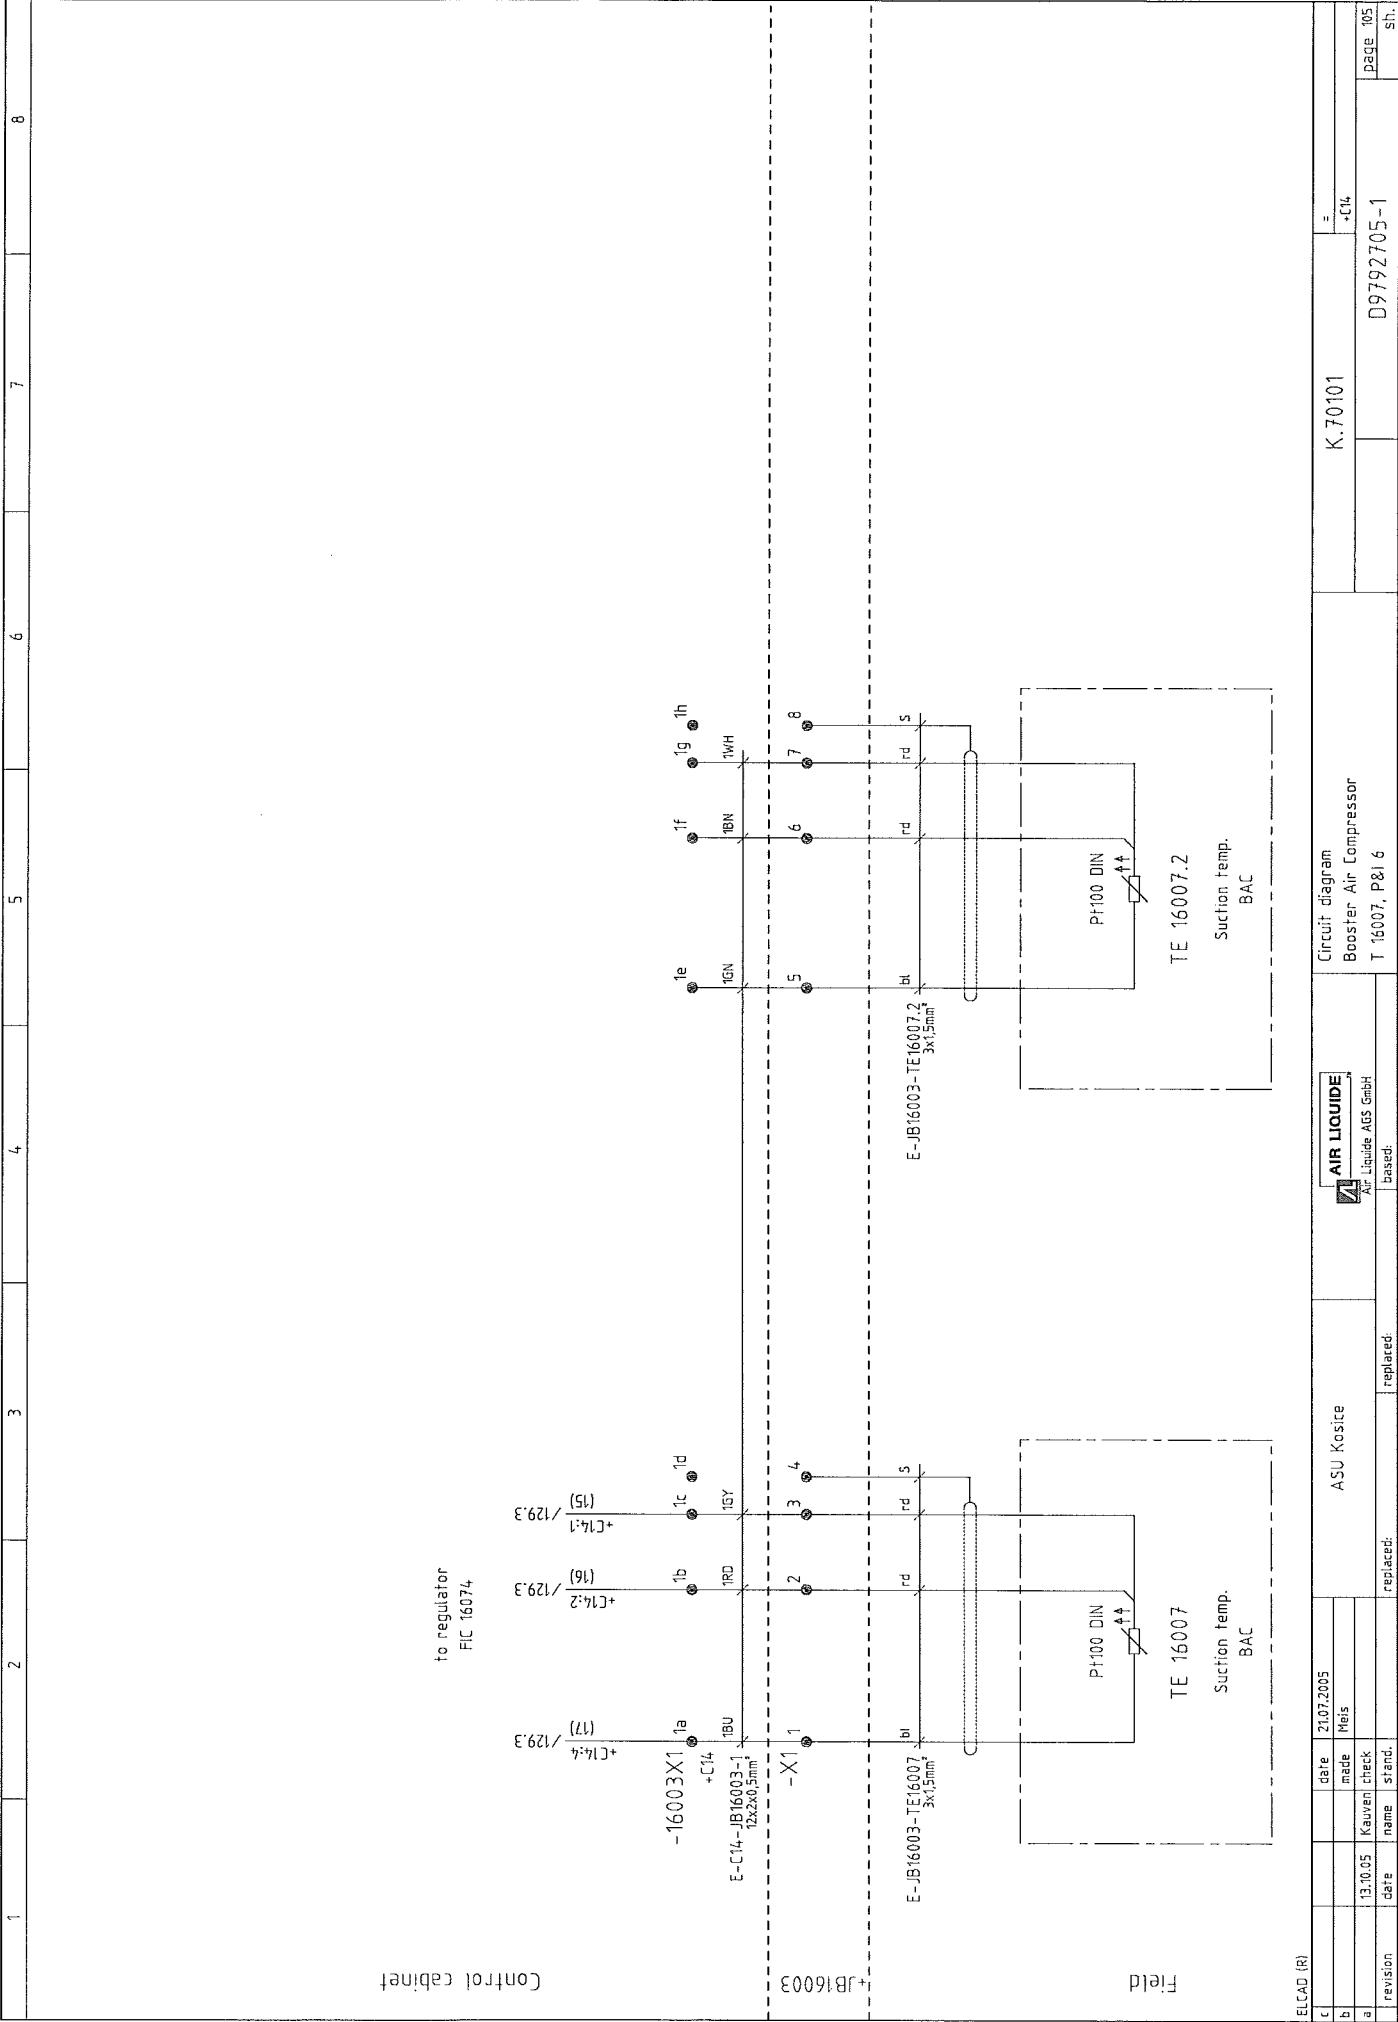

ELCAD (R)		ASU Kasice		AIR LIQUIDE		Circuit diagram		K.70101		=	
c	date	21.07.2005	Meis								+C14
b	made										
a	13.10.05	Kauven	check								
revision		date	name	replaced:	replaced:	T 16007, P&I 6		D9792705-1		page 05	
										sh.	

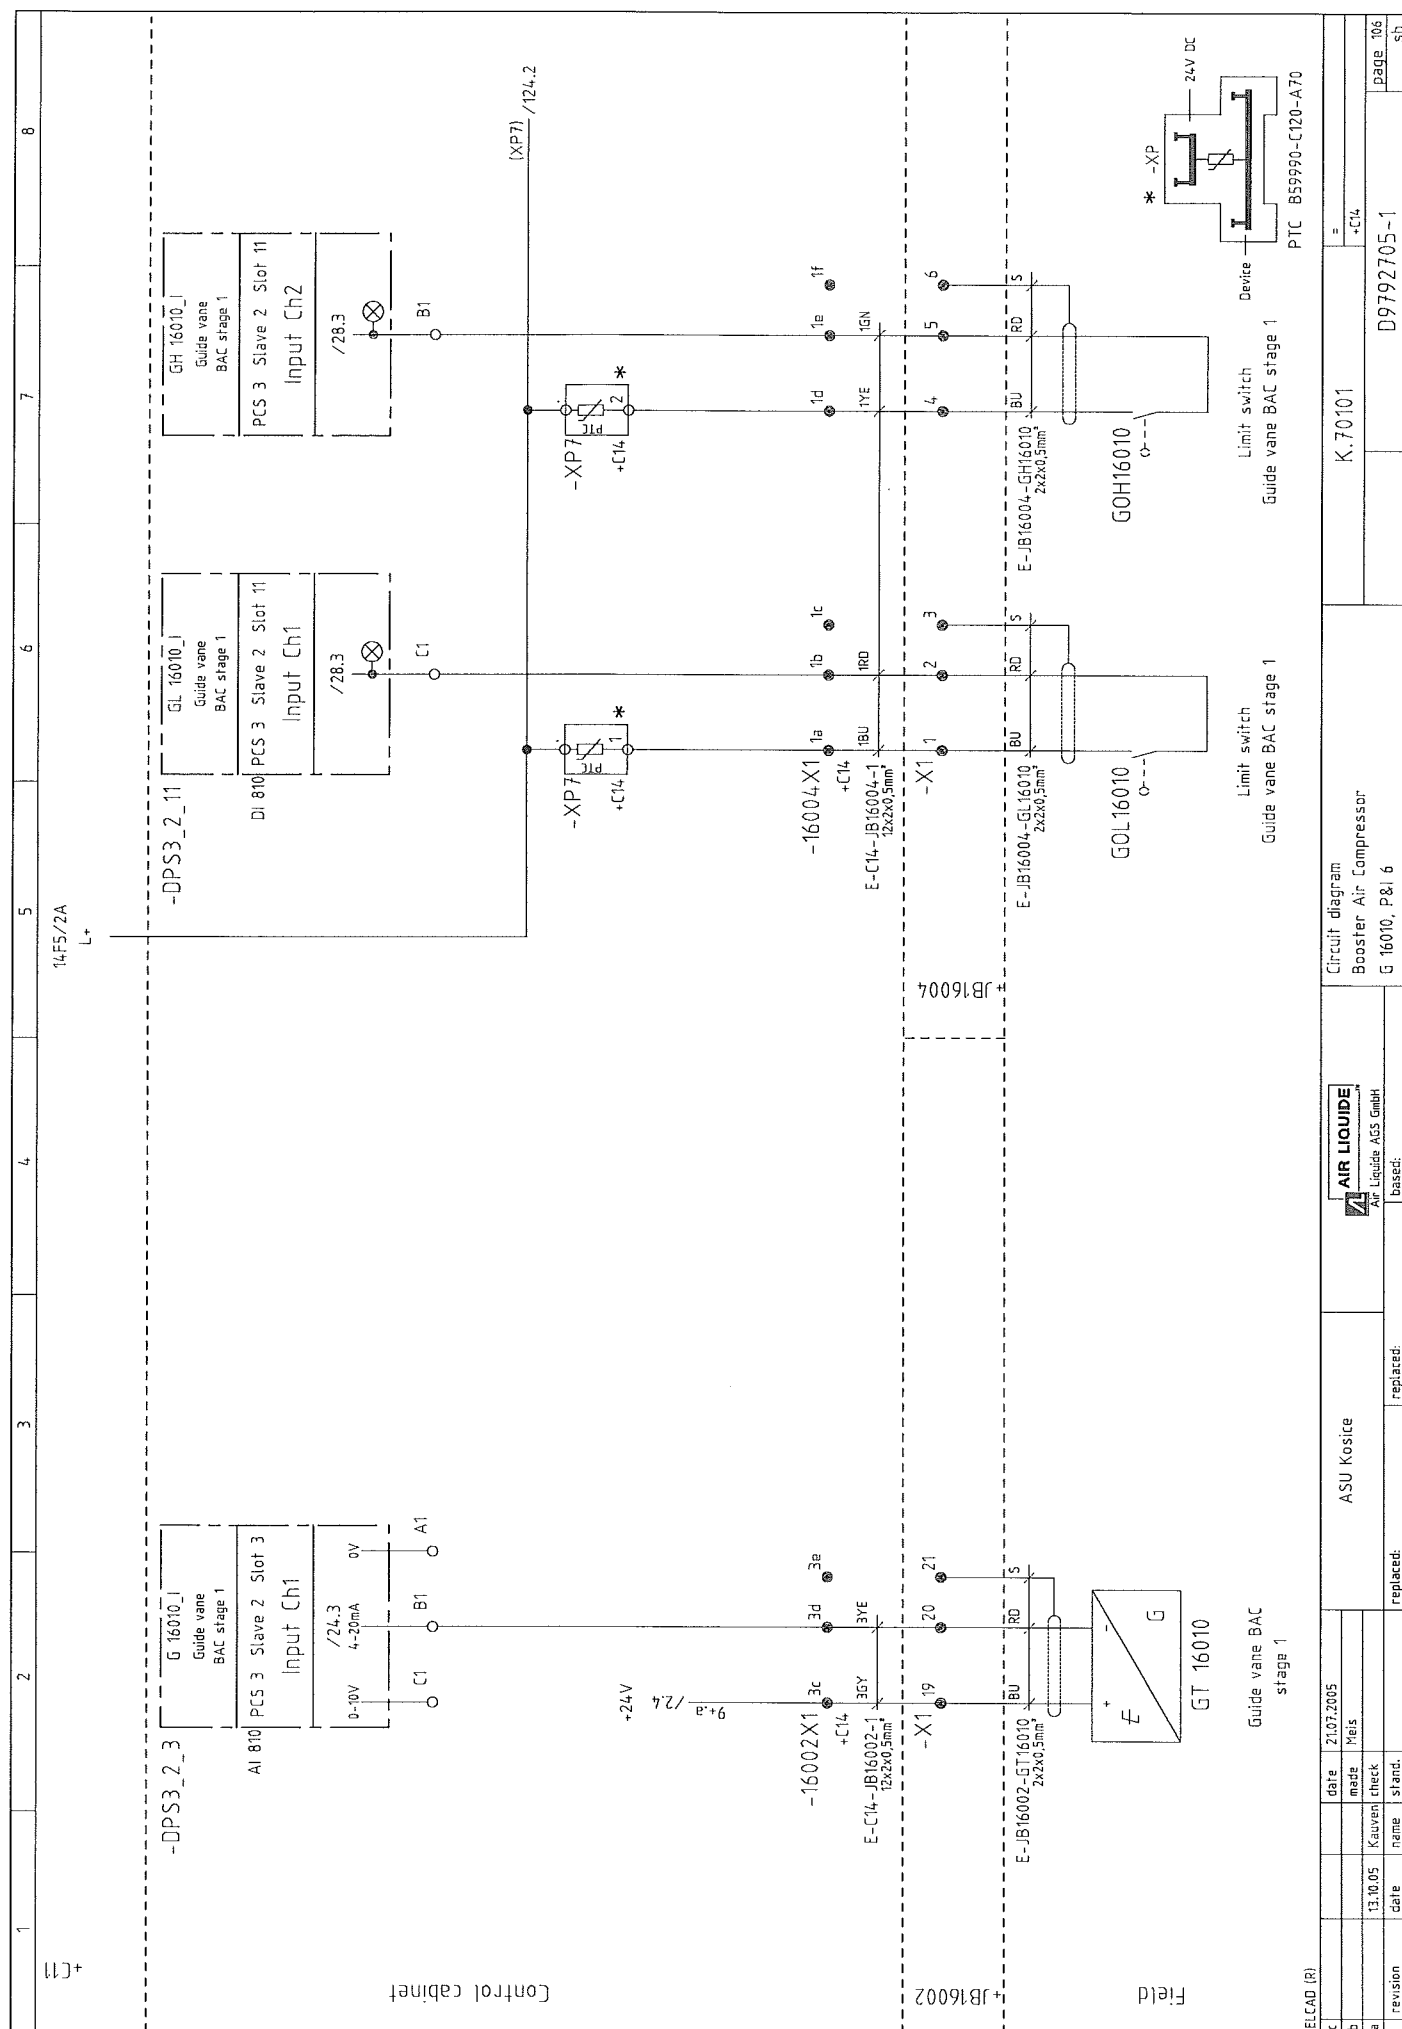

[illegible]

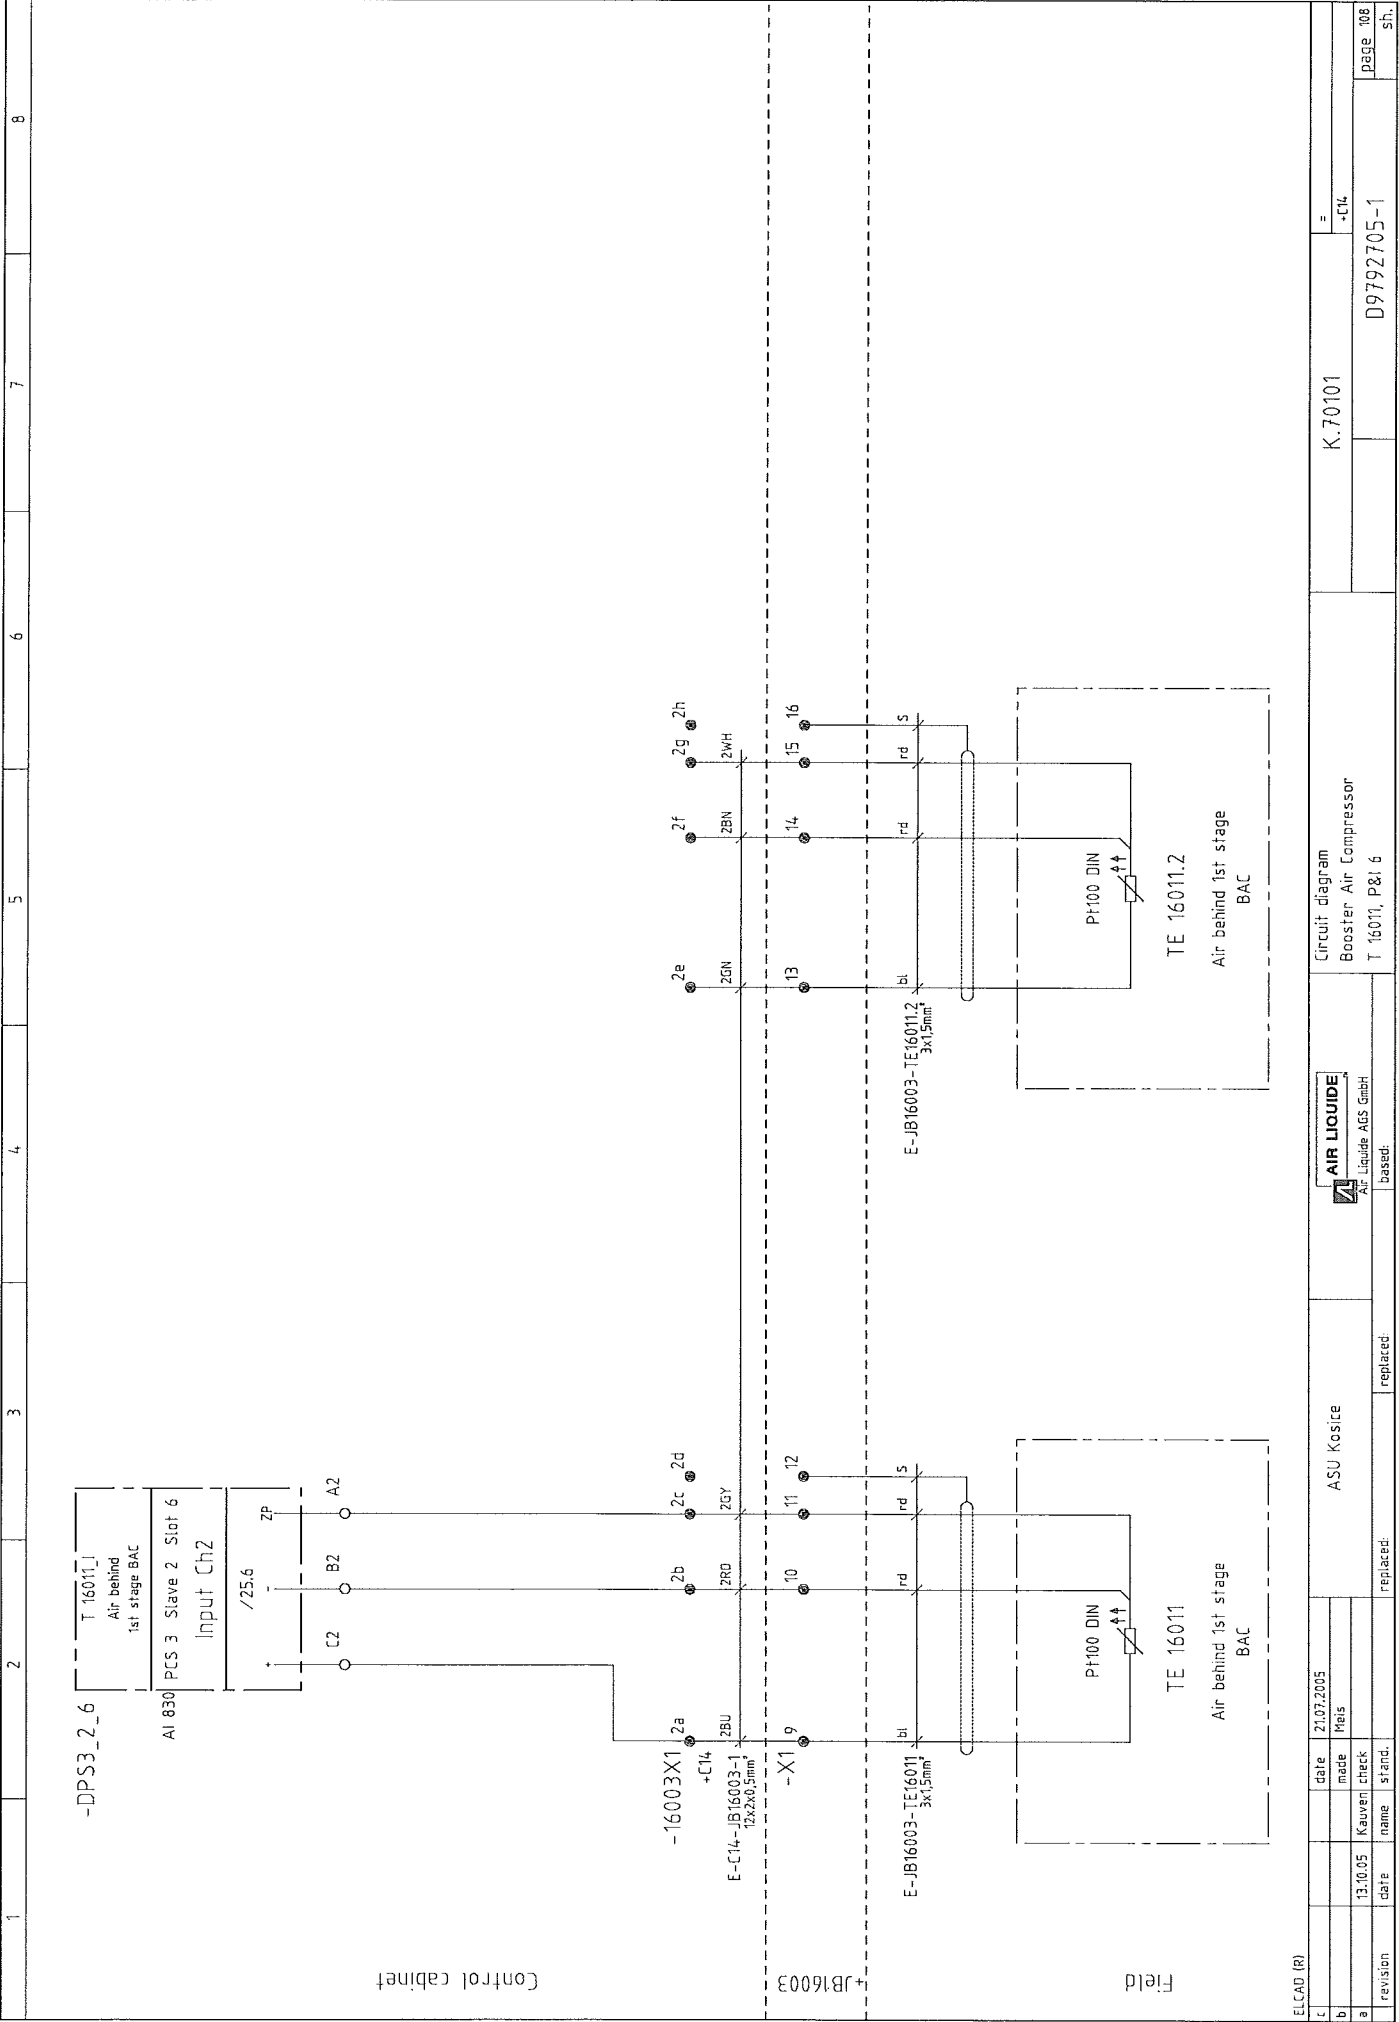

ELCAD (R)		ASU Kosice		Circuit diagram		K.70101		=	
z		date	21.07.2005						-CLC
b		made	Meis						
a		Kauveni	check						
	13.10.05	date							
revision		name		replaced:					
		stand.							
					D9792705-1		page 108		
							sh.		

[illegible]

1
2
3
4
5
6
7
8

-DPS3_2_6

T 16015.1
Air behind
1st stage VW16001

AI 830 PCS 3 Slave 2 Slot 6
Input Ch3

/25.6 ZP

C3 B3 A3

Control cabinet

-16003X1

3a 3b 3c 3d

3BU 3RD 3GY

+C14

E-C14-JB16003-1

12x2x0.5mm²

-X1 17 18 19 20

E-JB16003-TE16015

3x15mm²

bl rd S

Field

TE 16015

Air behind 1st stage
VW16001

PH100 DIN

JB16003

E-JB16003-TE16015.2

3x15mm²

bl rd S

TE 16015.2

Air behind 1st stage
VW16001

PH100 DIN

ELCAD (R)

revision	date	name	stand.	replaced
a	13.10.05	Kauven	check	
b		Meis	made	
c	21.07.2005			

ASU Kostre


Circuit diagram
Booster Air Compressor
T 16015, P&I 6


K.70101


D9792705-1


page 110
sh.


[illegible]

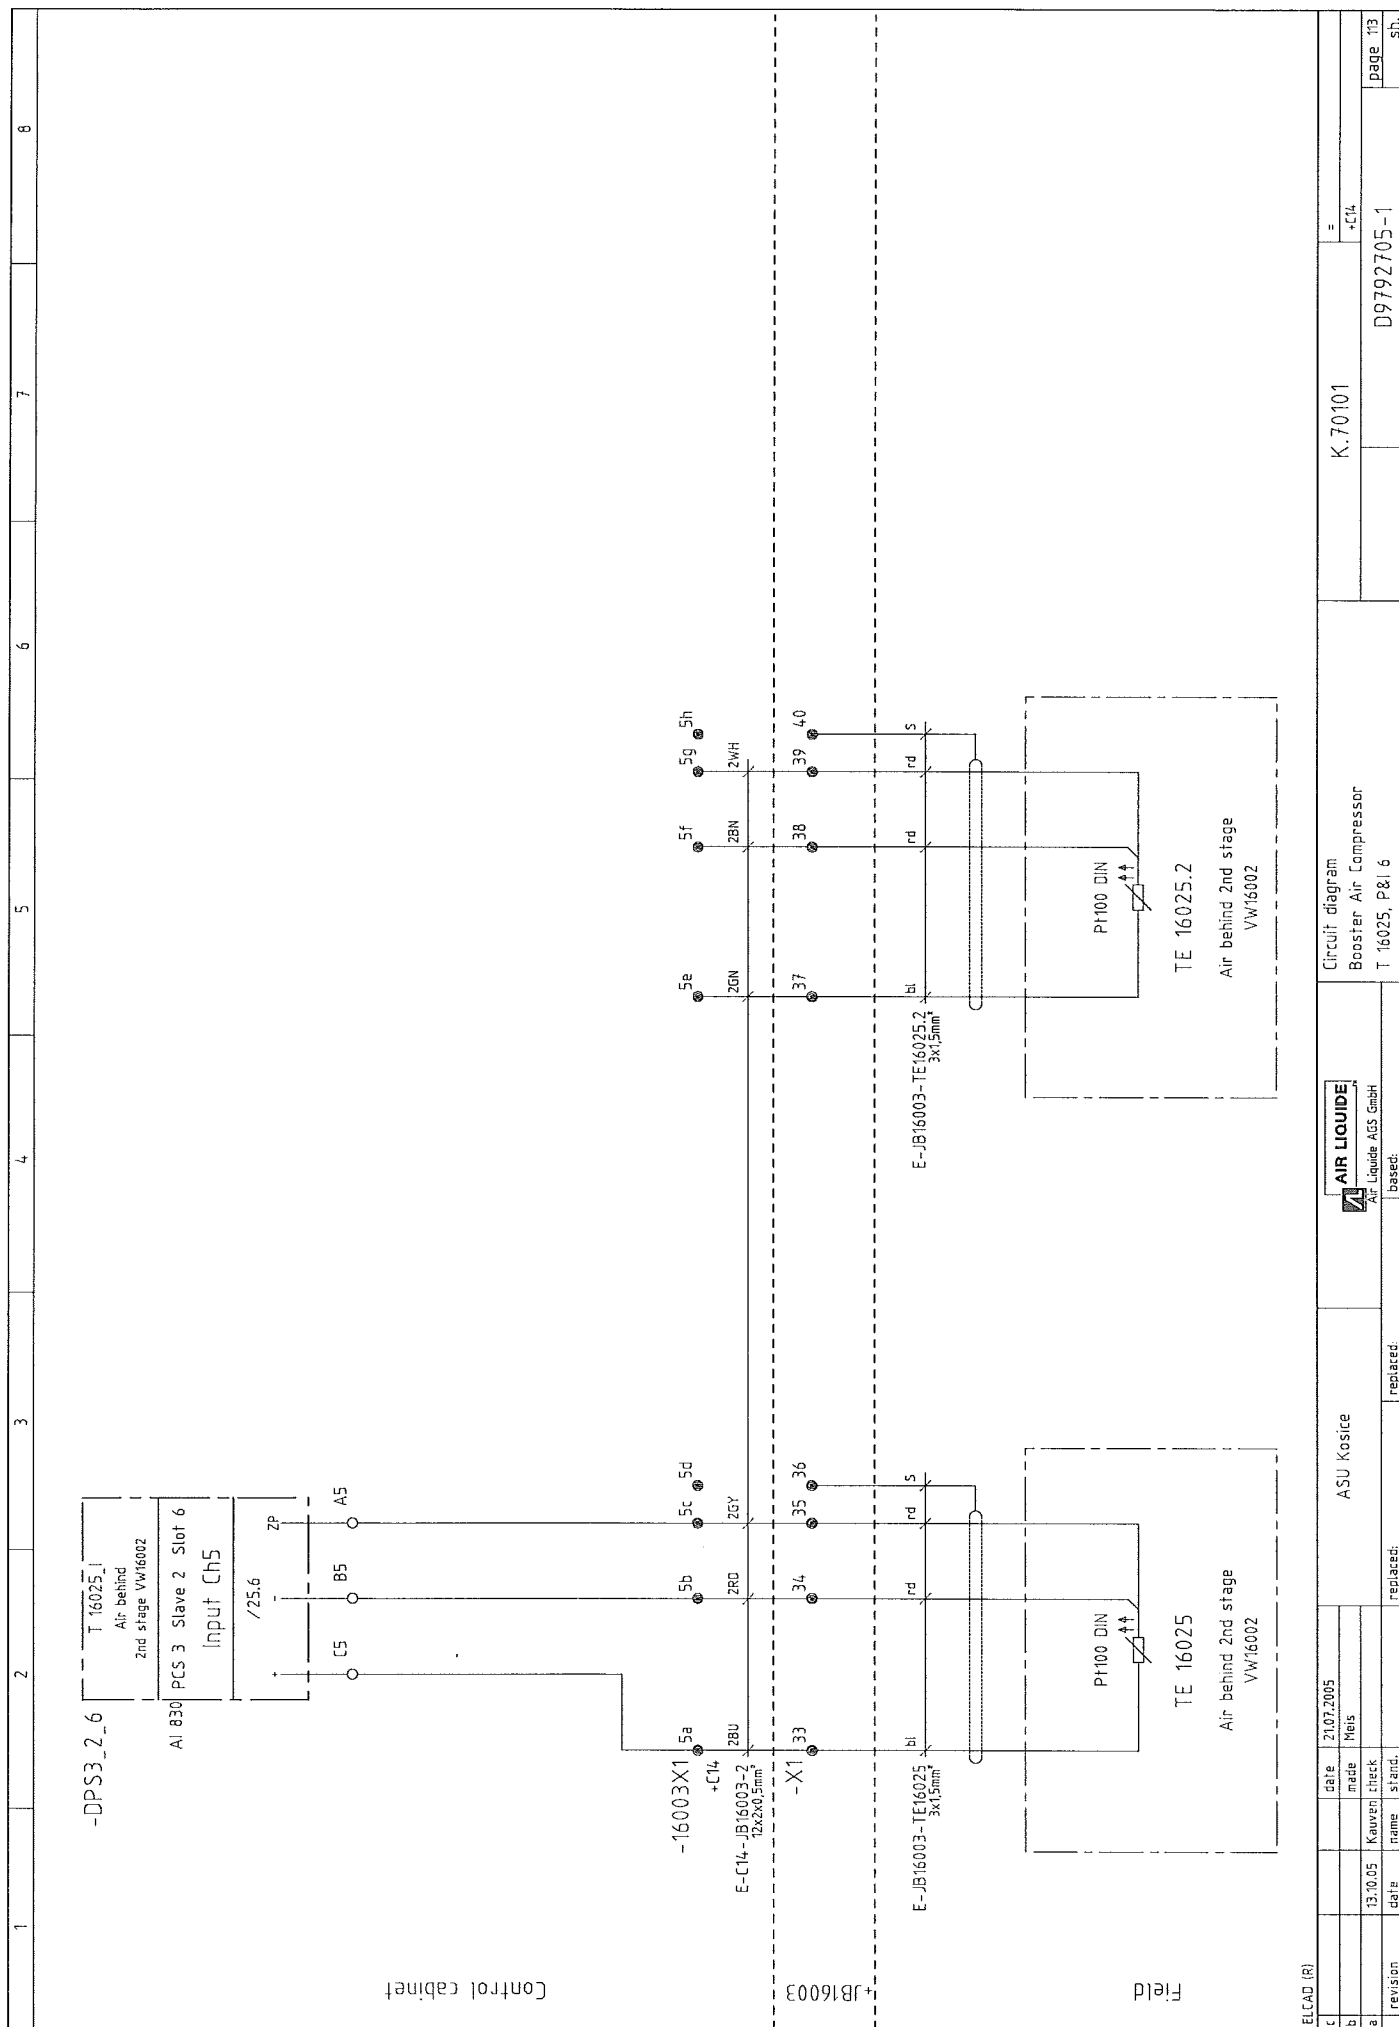

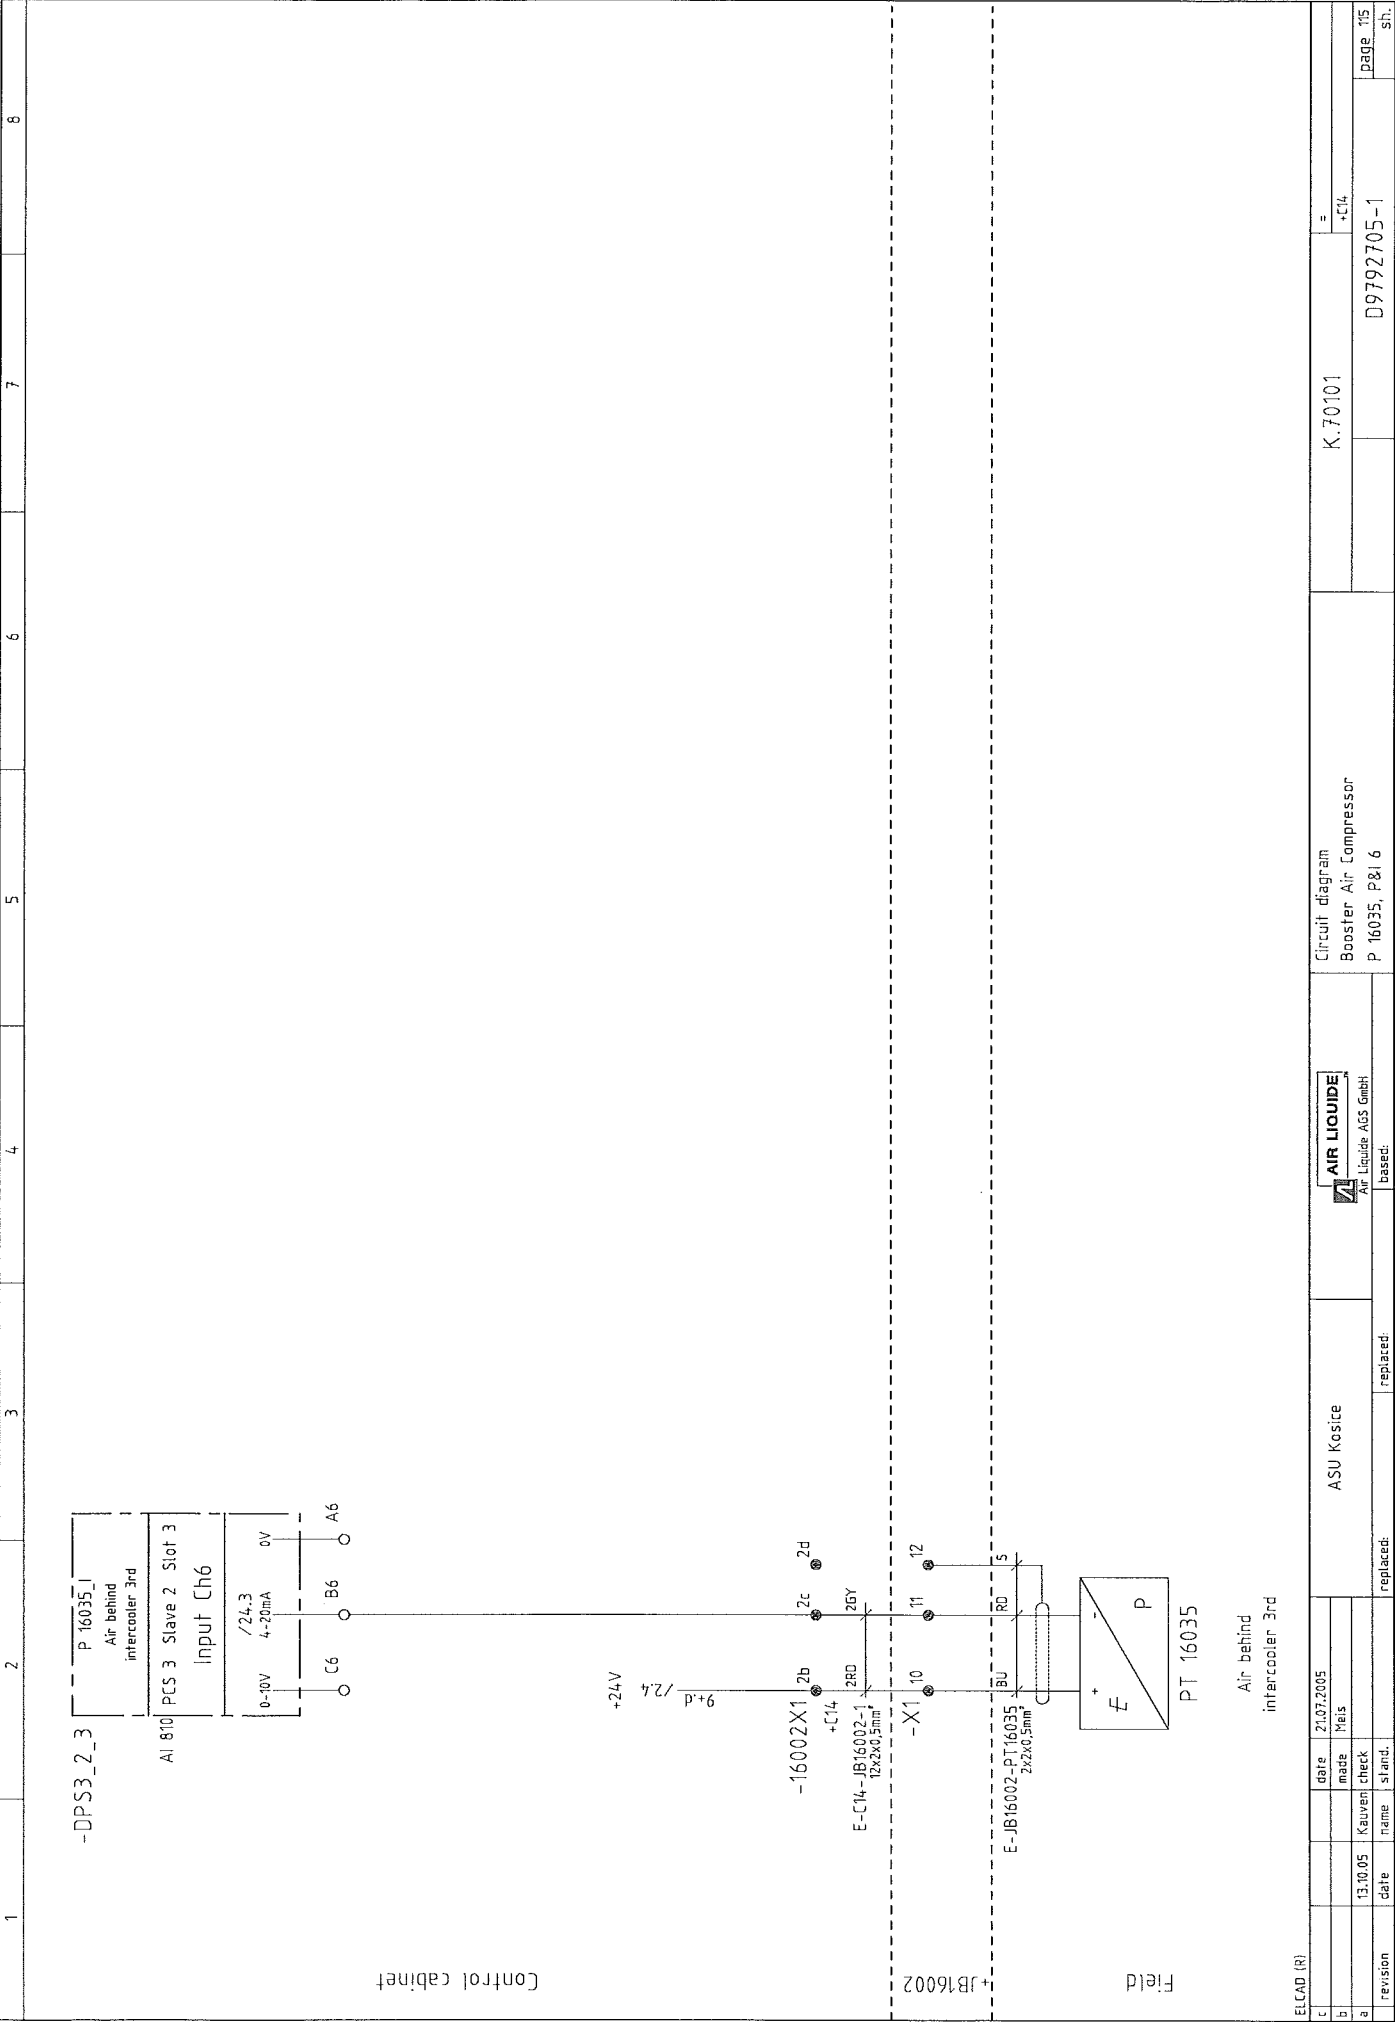

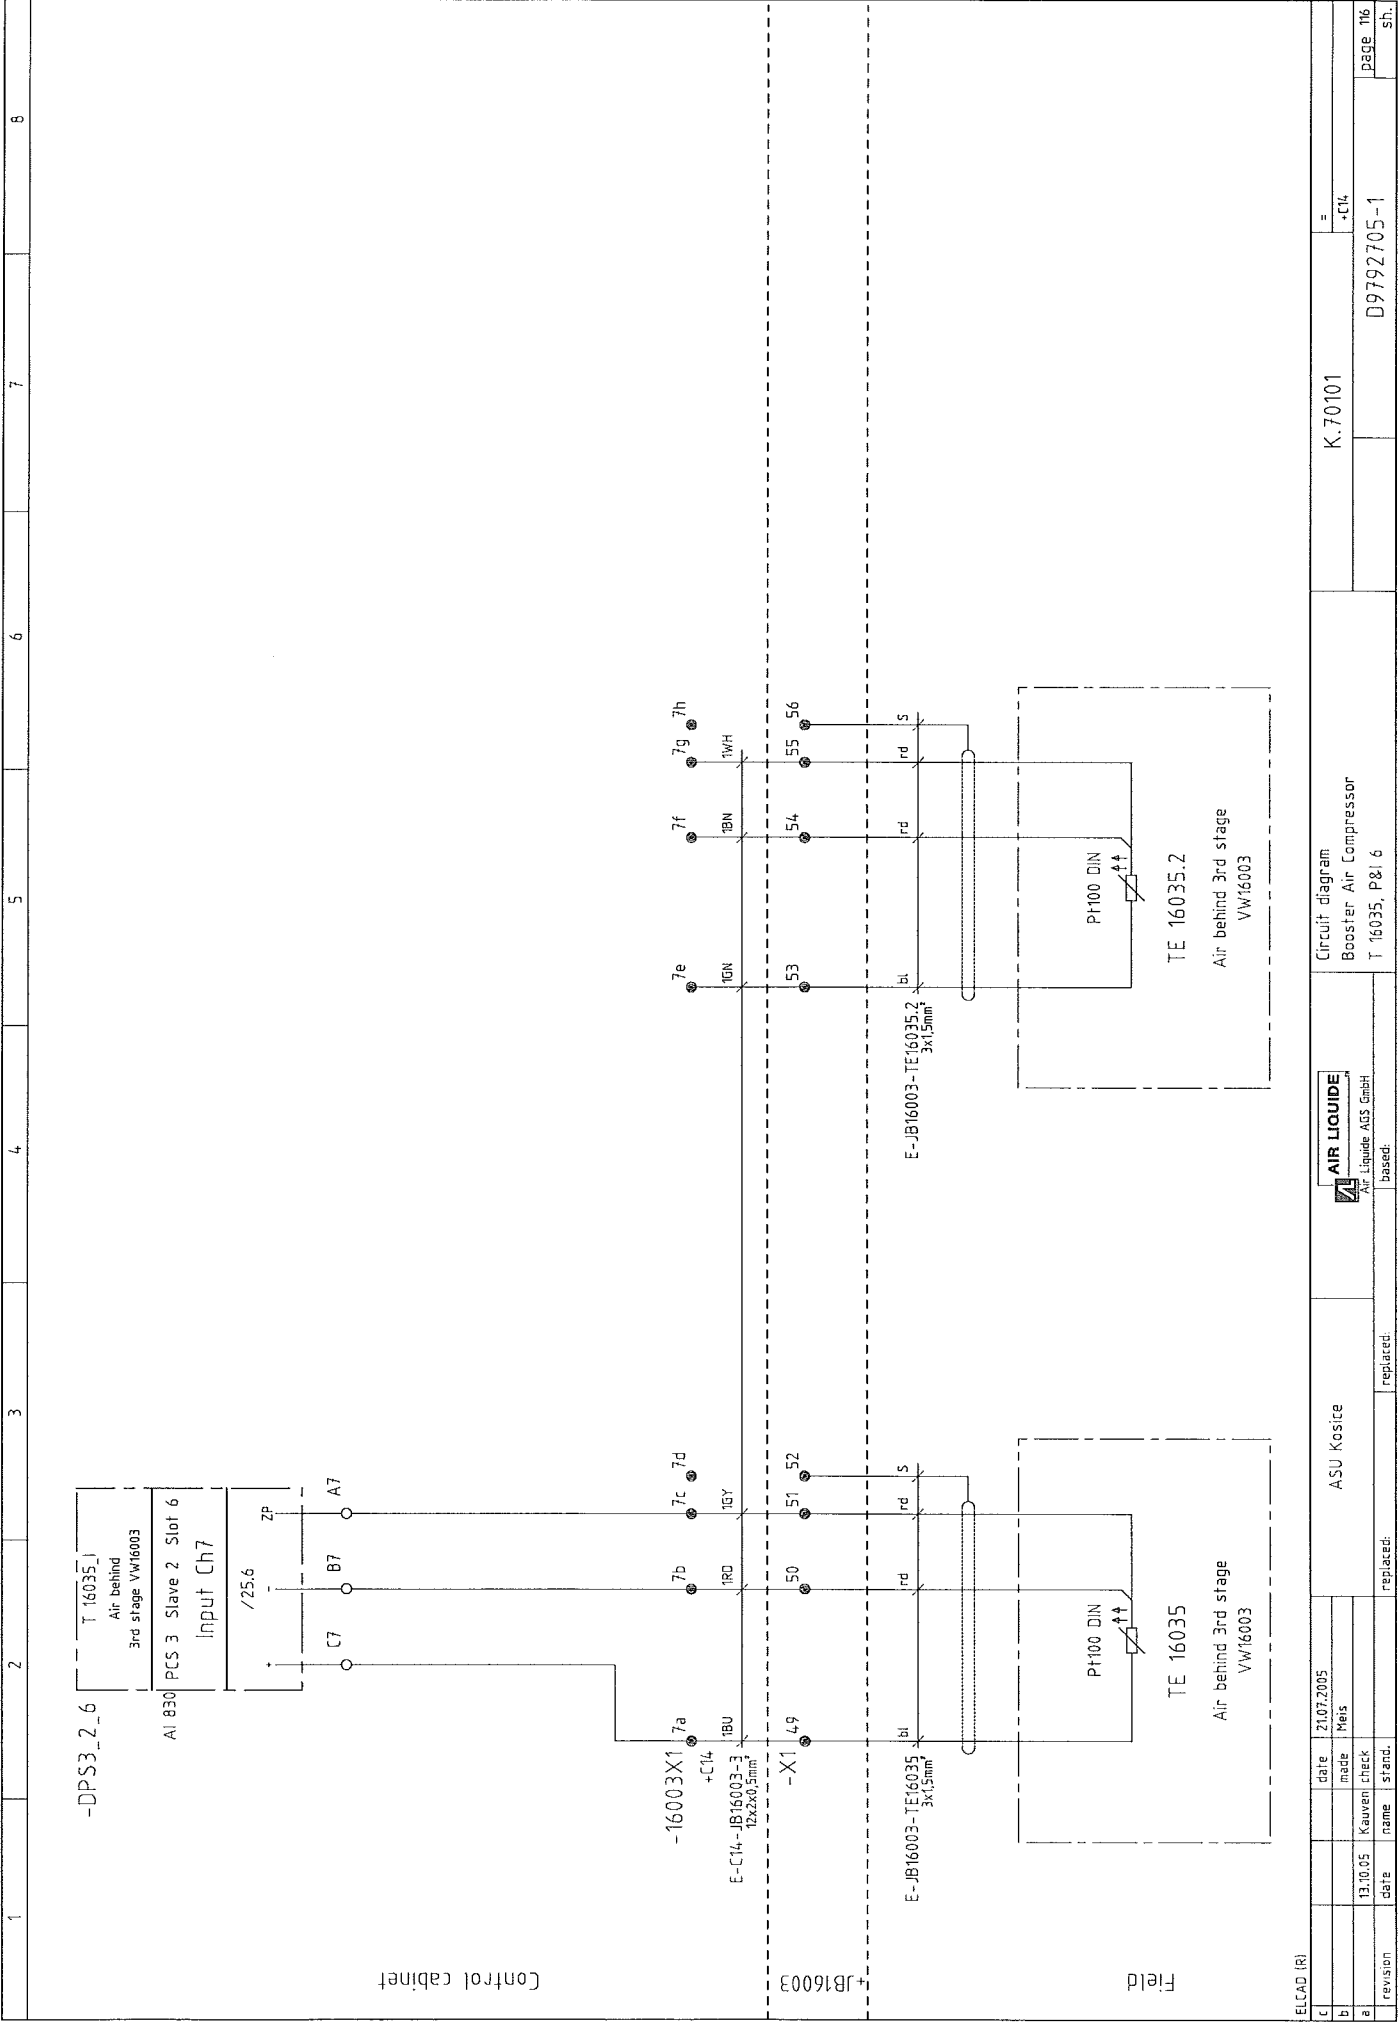
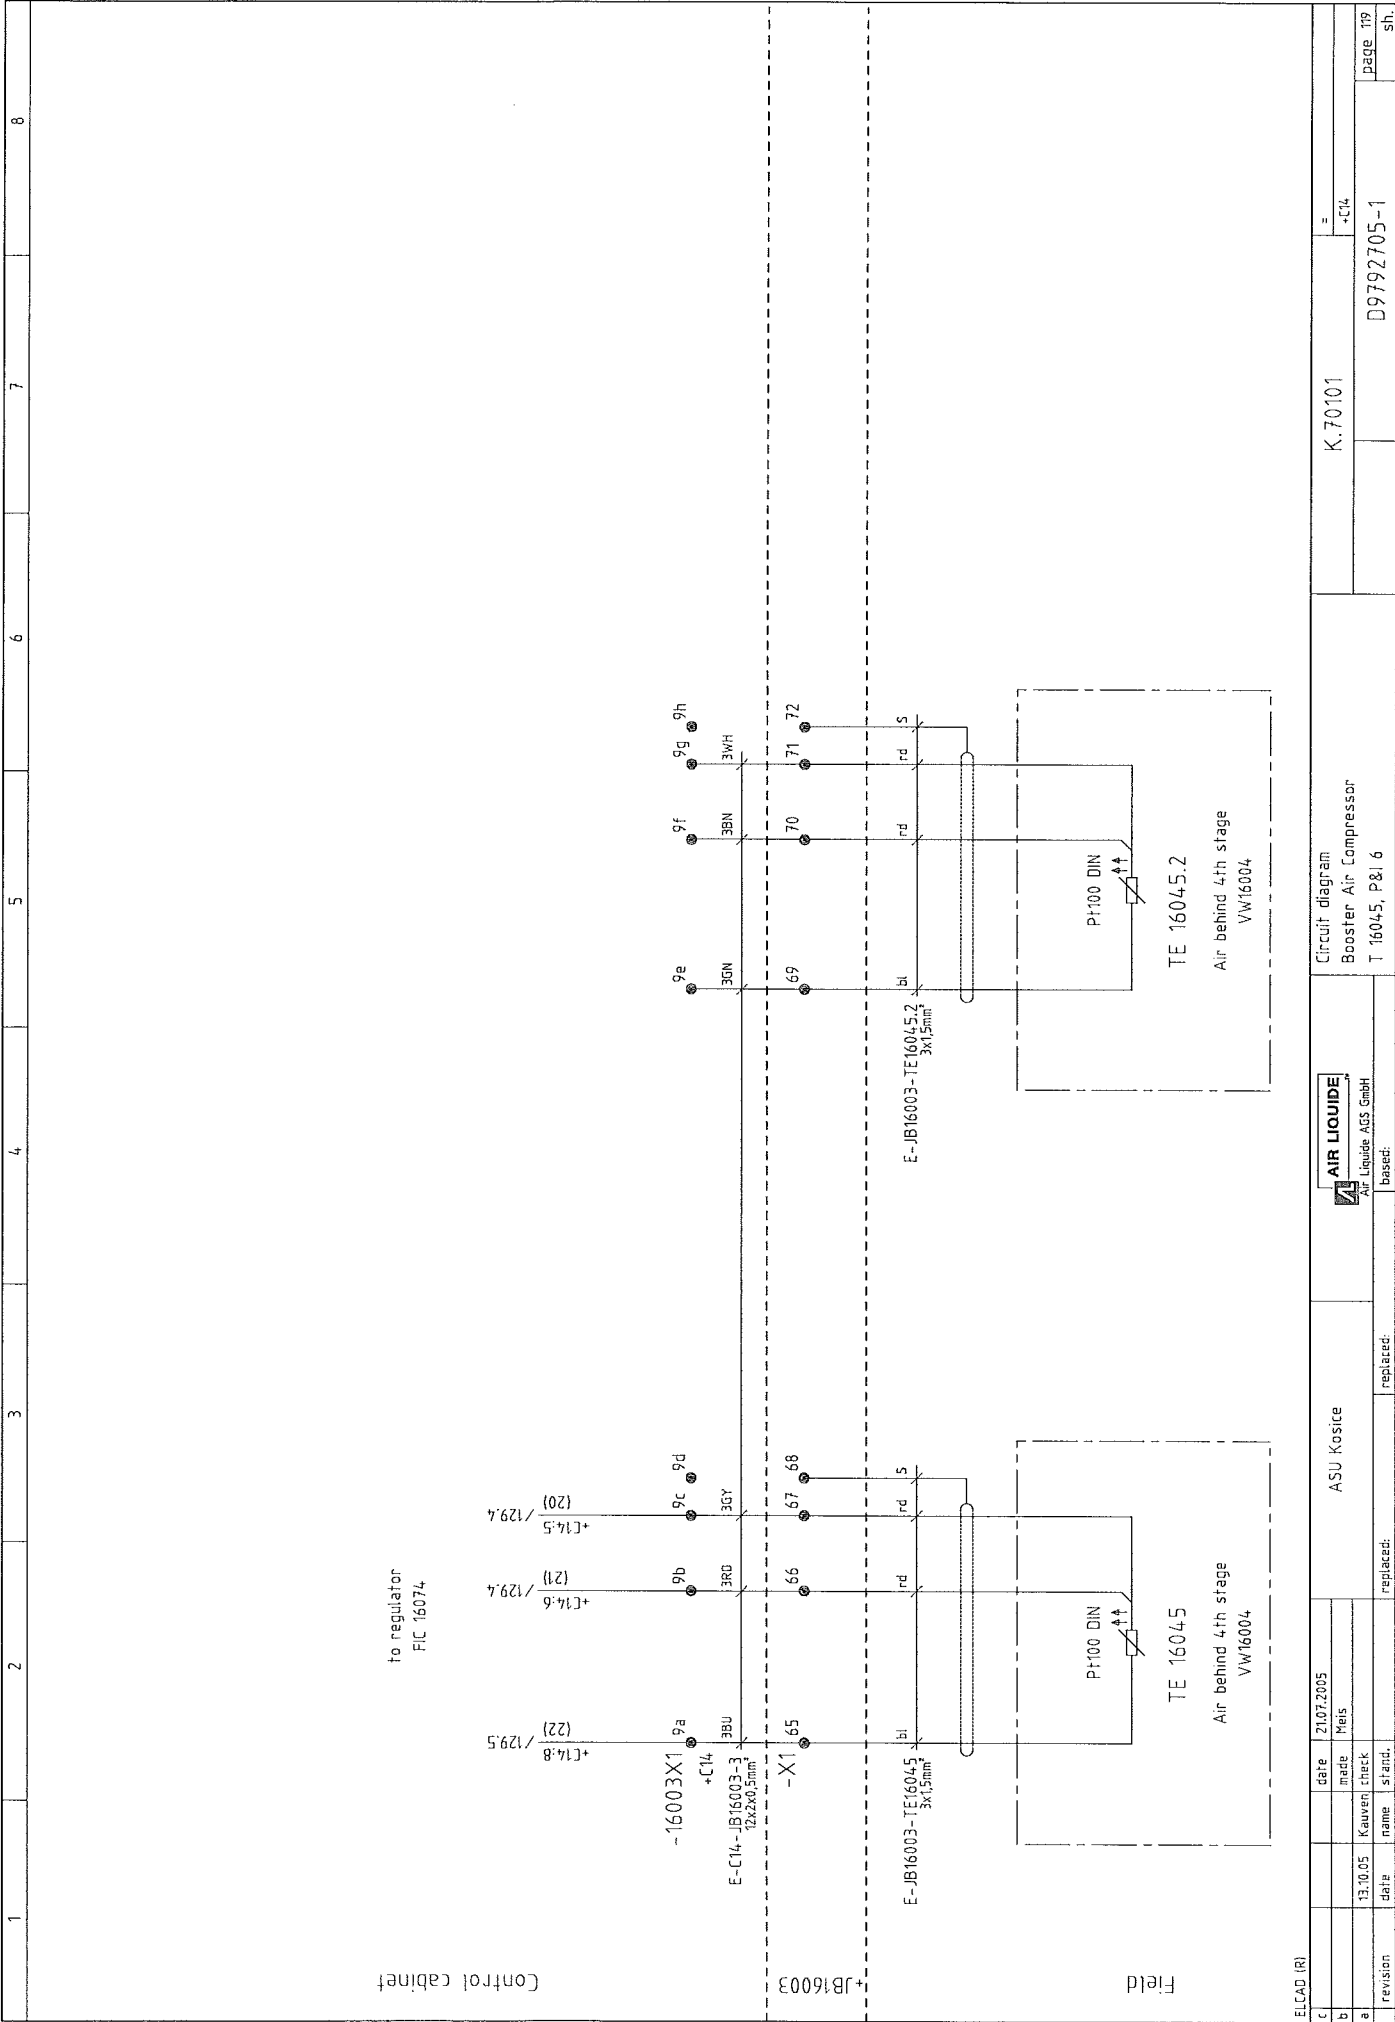


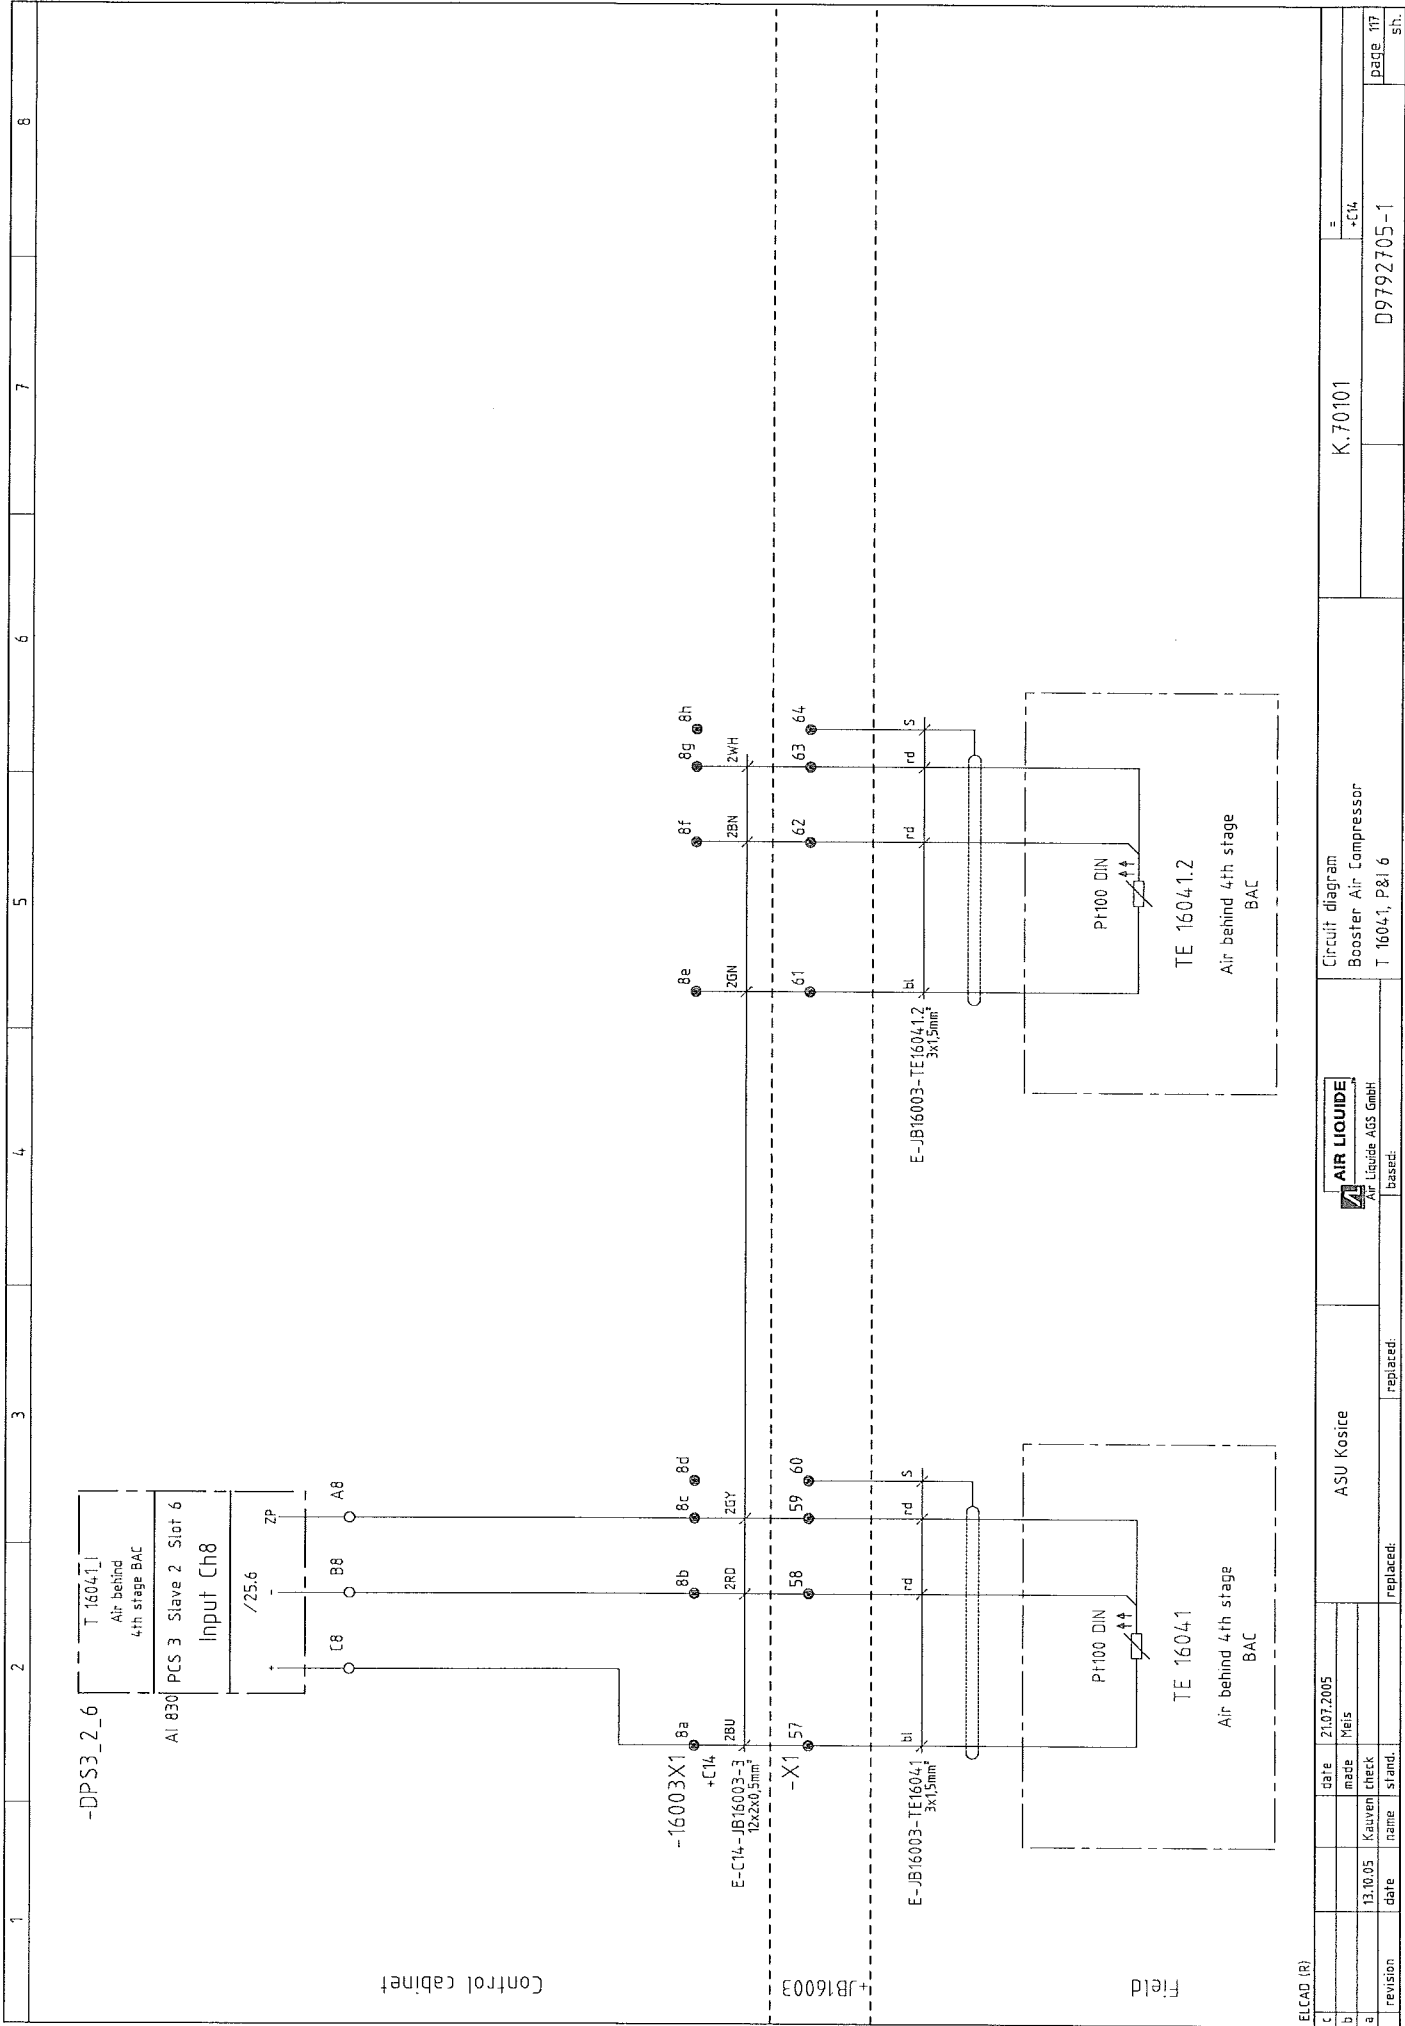


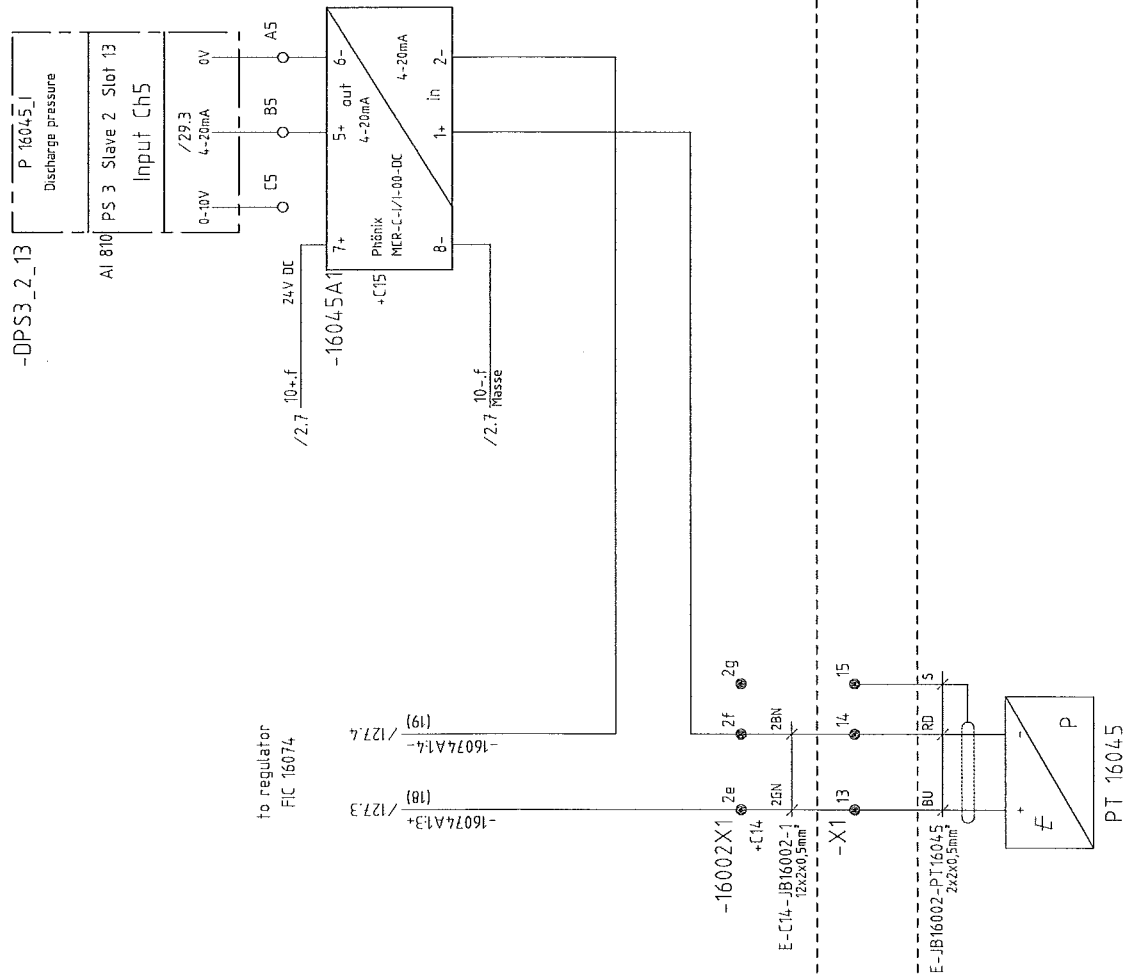Air discharge
intercooler 4th

ELCAD (R)


c		date	21.07.2015	ASU Kosice	 AIR LIQUIDE Air Liquide AGS GmbH	Circuit diagram Booster Air Compressor	K.70101	=	*C14	page 18 sh.
b		made	Mals							
a		revision	15.11.05							



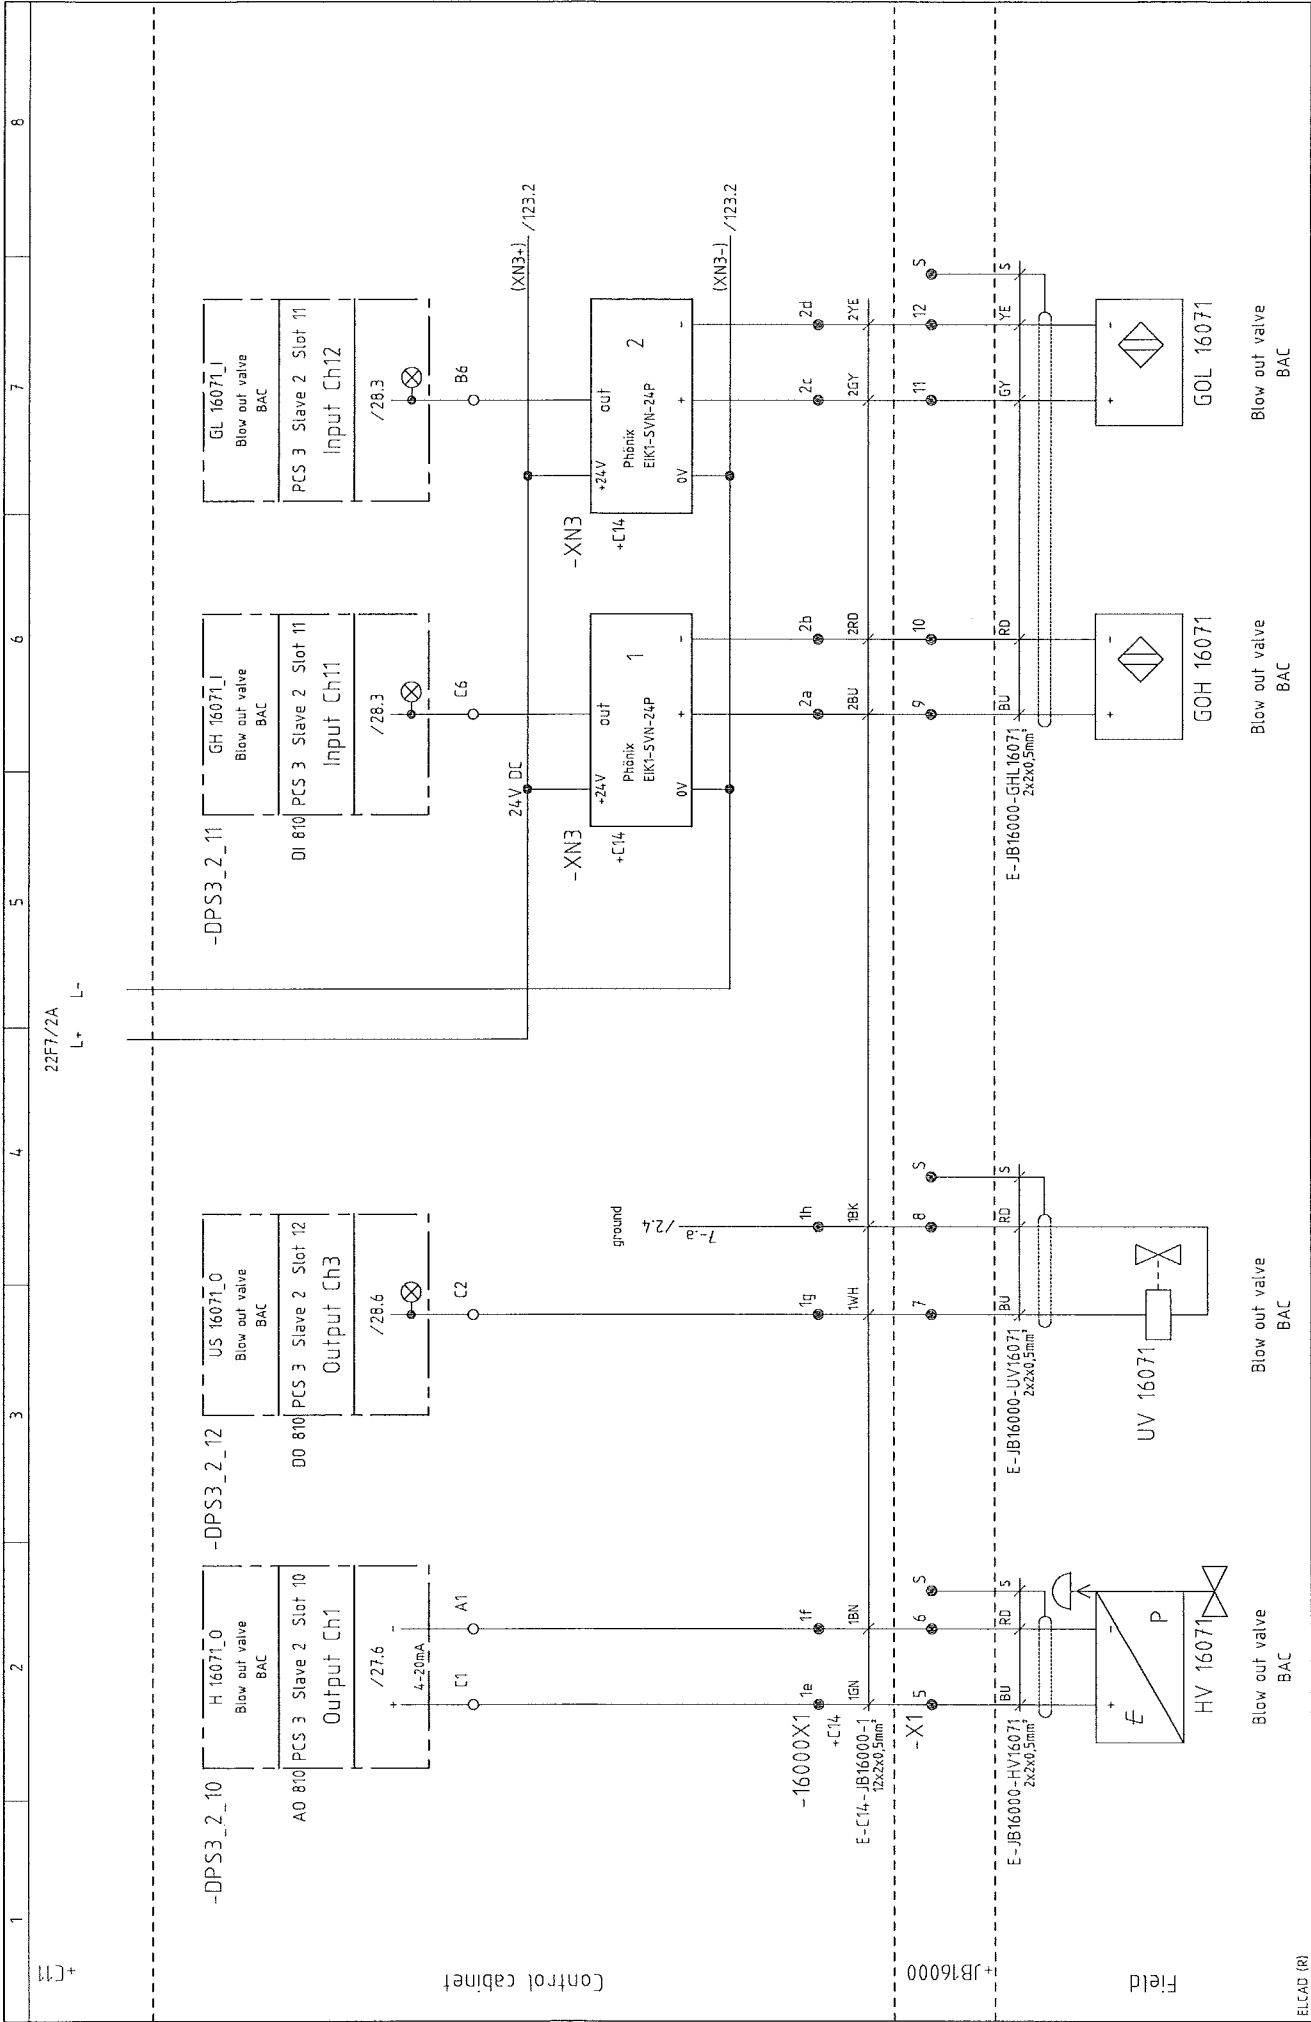

1	2	3	4	5	6	7	8
22F7/2A L+ L-							
Control cabinet							
Field							
+JB16000							
ELCAD (R)							
c	date	21.07.2005	ASU Kosice	Circuit diagram		K.70101	= +C14
b	made	Neis		Booster Air Compressor			
a	13.10.05	Kauven		H/U/G 16071, P&I 6			
revision	date	name	stand.	replaced:			
				replaced:			
						D9792705-1	
						page 120	
						sh.	

1	2	3	4	5	6	7	8	
<p>Control cabinet</p> <p>-DPS3_2_3</p> <p>F 16073_1 Hp-Air from BAC</p> <p>AI 810 PCS 3 Slave 2 Slot 3 Input Ch2</p> <p>0-10V 4-20mA 0V /24.3 C2 B2 A2</p> <p>+24V /2.4 1a 1b +C14 IBU E-C14-JB16000-1 12x2x0.5mm RD</p> <p>-16000X1 1 2 S -X1 BU RD S E-JB16000-FT16073 2x2x0.5mm S</p> <p>+JB16000</p> <p>Field</p> <p>FT 16073 ΔP E</p> <p>Hp-Air from BAC</p>	
<p>ELCAD (R)</p> <table border="1"> <tr> <td>c</td> <td>date</td> <td>21.07.2005</td> <td>ASU Kostice</td> <td>AIR LIQUIDE Air Liquide AGS GmbH</td> <td>Circuit diagram</td> <td>K.70101</td> <td>=</td> </tr> <tr> <td>b</td> <td>made</td> <td>Mels</td> <td></td> <td></td> <td>Booster Air Compressor</td> <td></td> <td>+C14</td> </tr> <tr> <td>a</td> <td>revision</td> <td>13.10.05</td> <td>Kauven</td> <td></td> <td>F 16073, P&I 6</td> <td></td> <td></td> </tr> <tr> <td></td> <td>date</td> <td></td> <td>name</td> <td>replaced:</td> <td></td> <td></td> <td></td> </tr> <tr> <td></td> <td></td> <td></td> <td>stand.</td> <td>replaced:</td> <td></td> <td></td> <td></td> </tr> </table> <p>D9792705-1</p> <p>page 121</p> <p>sh.</p>								c	date	21.07.2005	ASU Kostice	AIR LIQUIDE Air Liquide AGS GmbH	Circuit diagram	K.70101	=	b	made	Mels			Booster Air Compressor		+C14	a	revision	13.10.05	Kauven		F 16073, P&I 6				date		name	replaced:							stand.	replaced:			
c	date	21.07.2005	ASU Kostice	AIR LIQUIDE Air Liquide AGS GmbH	Circuit diagram	K.70101	=	
b	made	Mels			Booster Air Compressor		+C14	
a	revision	13.10.05	Kauven		F 16073, P&I 6	
	date		name	replaced:	
			stand.	replaced:	

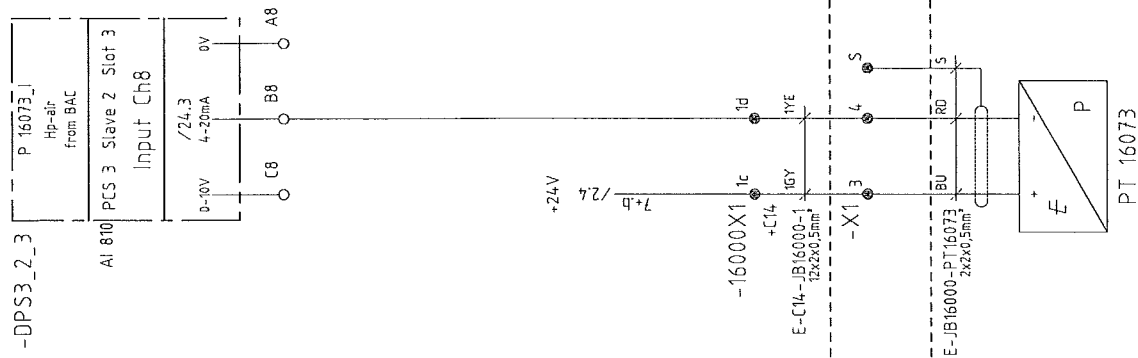


Control cabinet

1+JB16000

Field


Hp-Air
from BAC

 
ELCAD (R)									
c		date	21.07.2005	ASU Kosice		 AIR LIQUIDE Air Liquide AGS GmbH		Circuit diagram	
b		made	Meis					K.70101	
a		13.10.05	Kauveni	check				=	
revision	date	name	stand,	replaced:		based:		-ChL	
								D9792705-1	
								page 122	
								sh.	








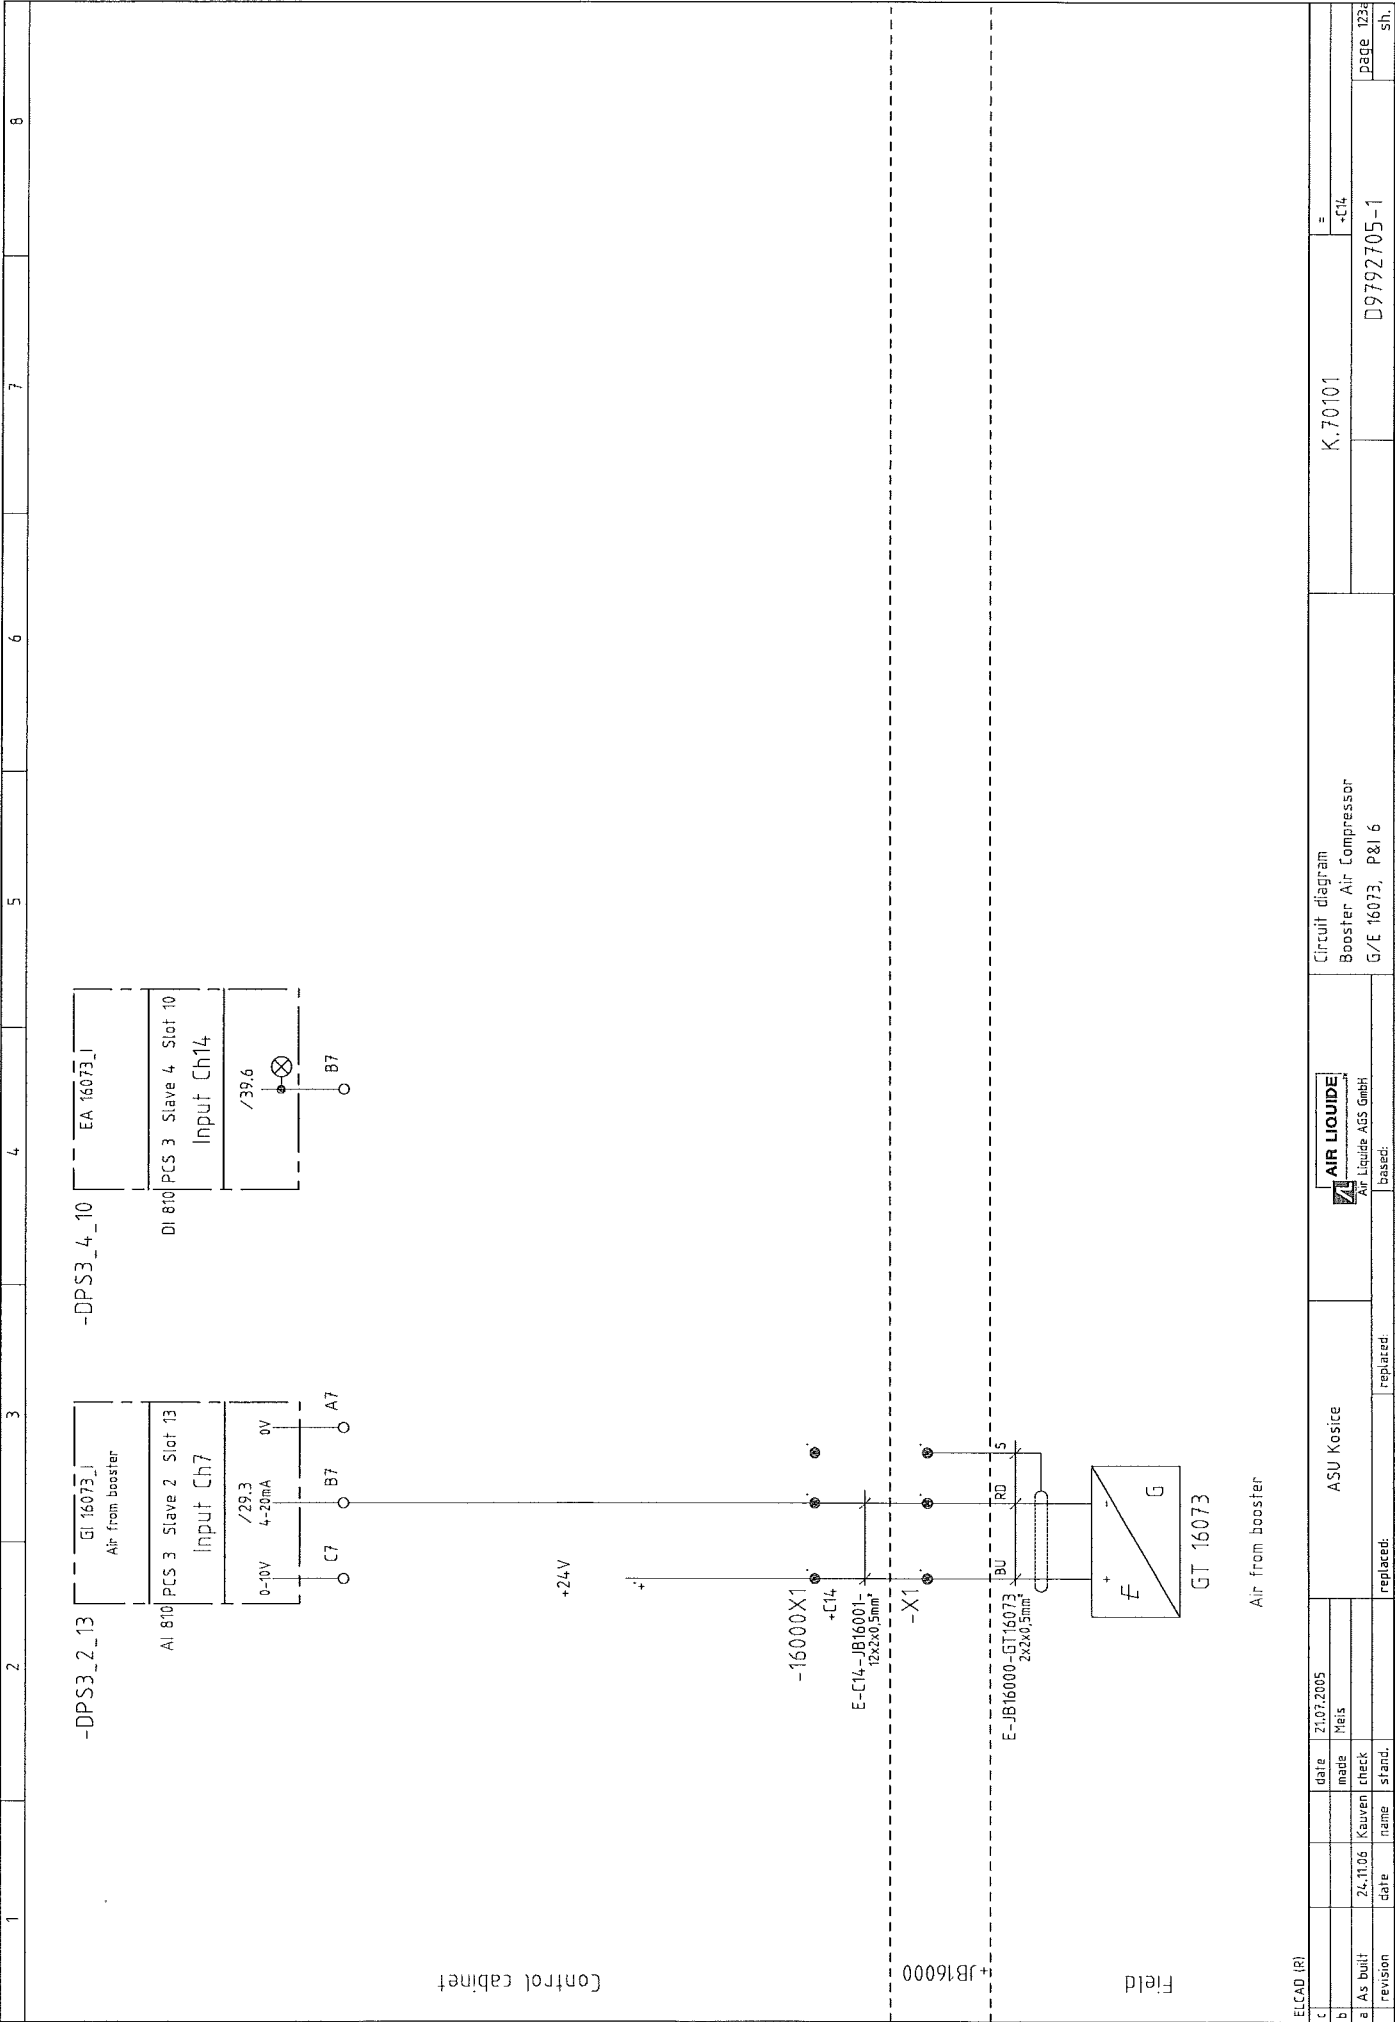

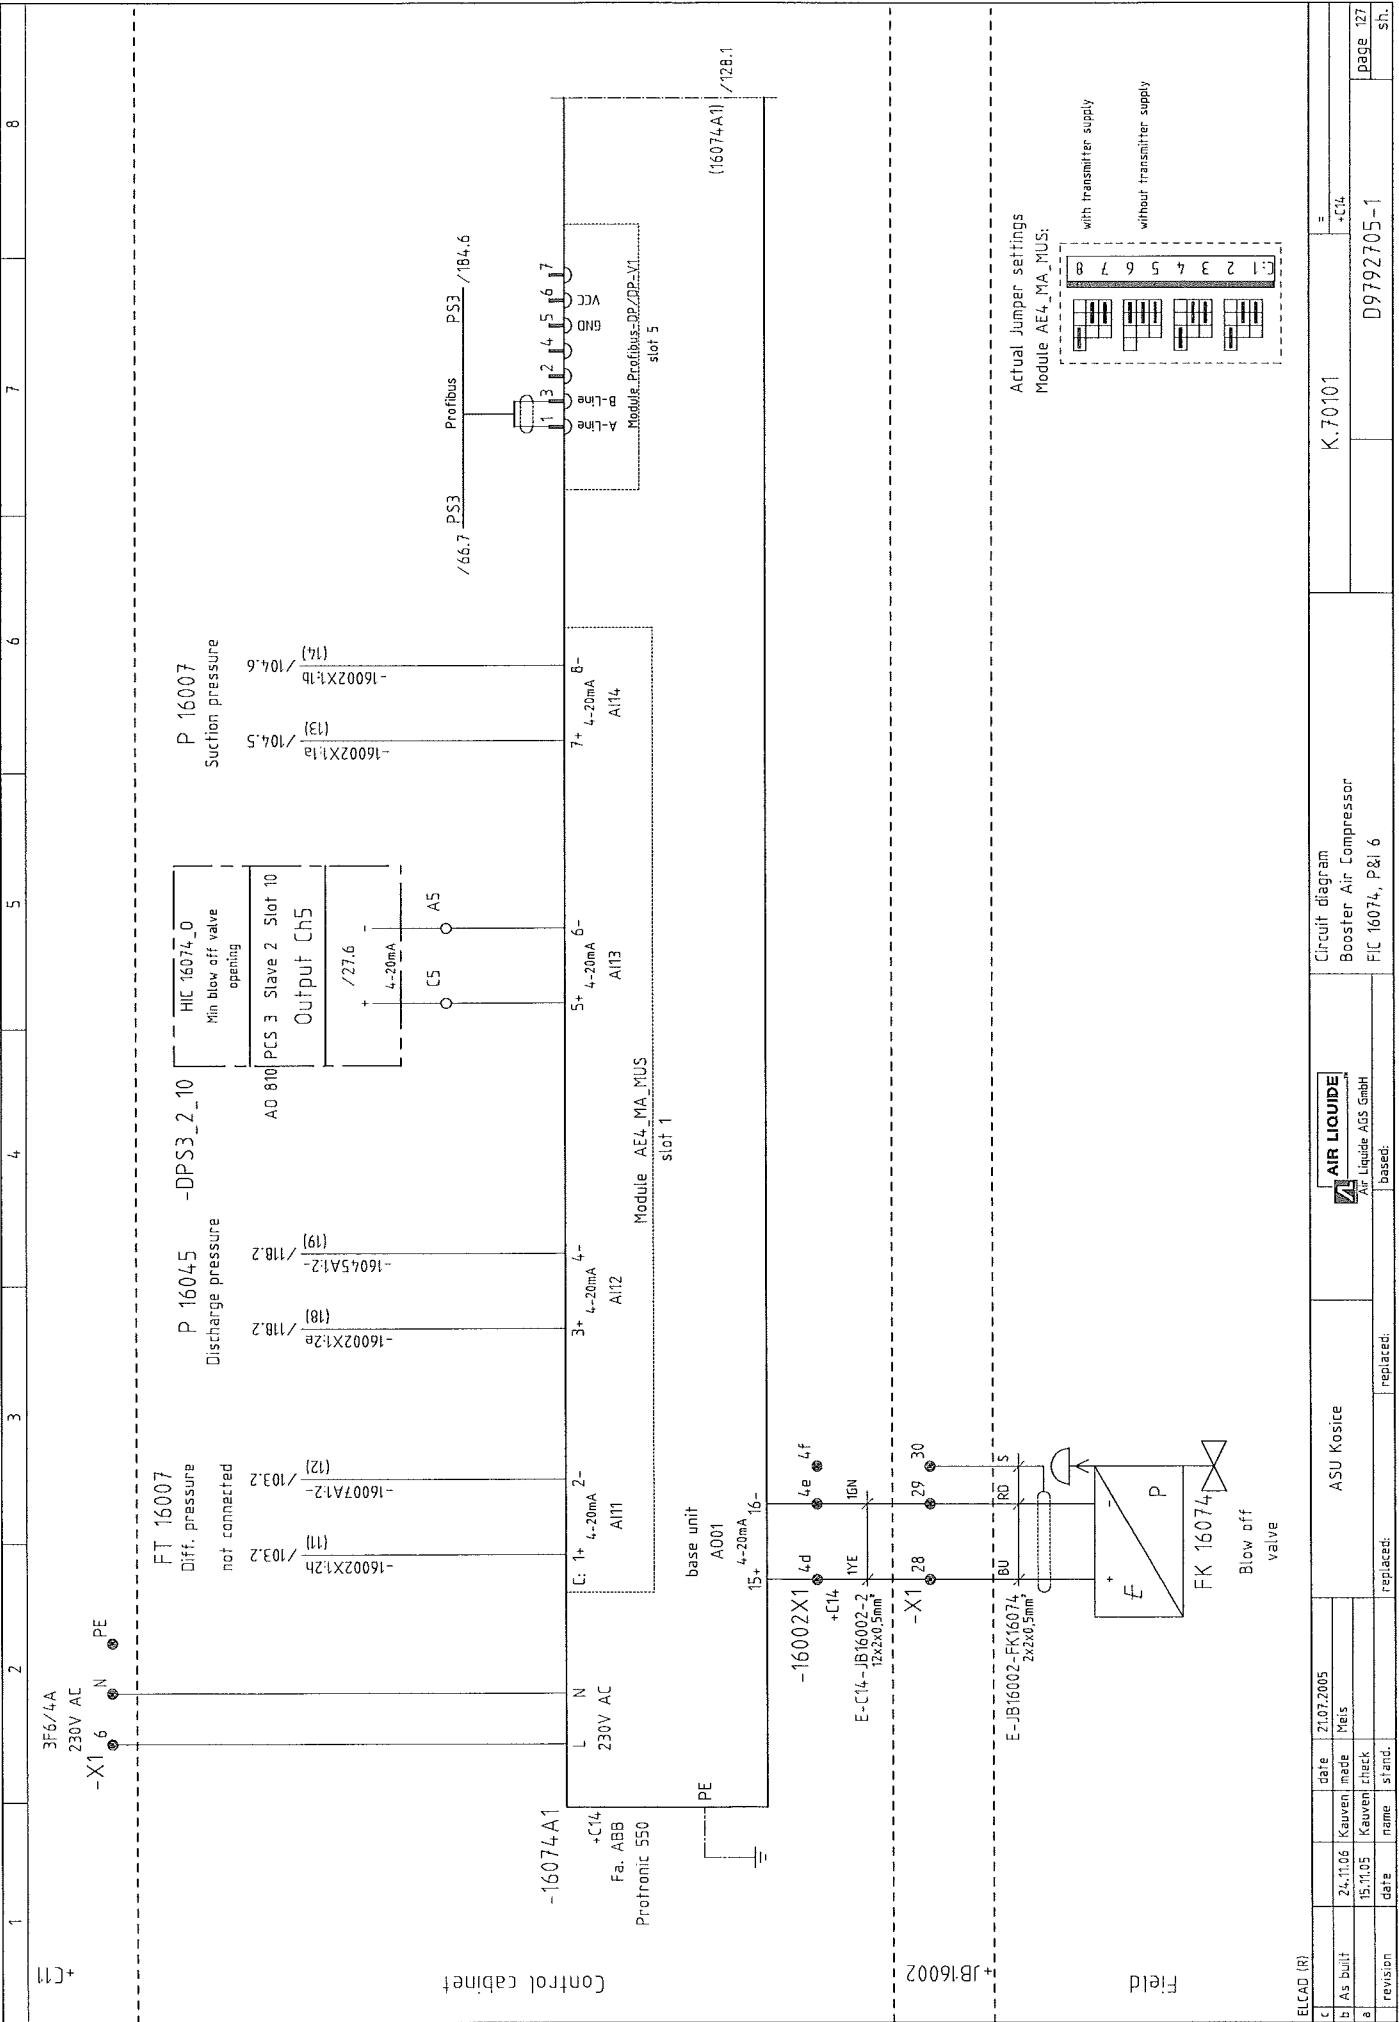

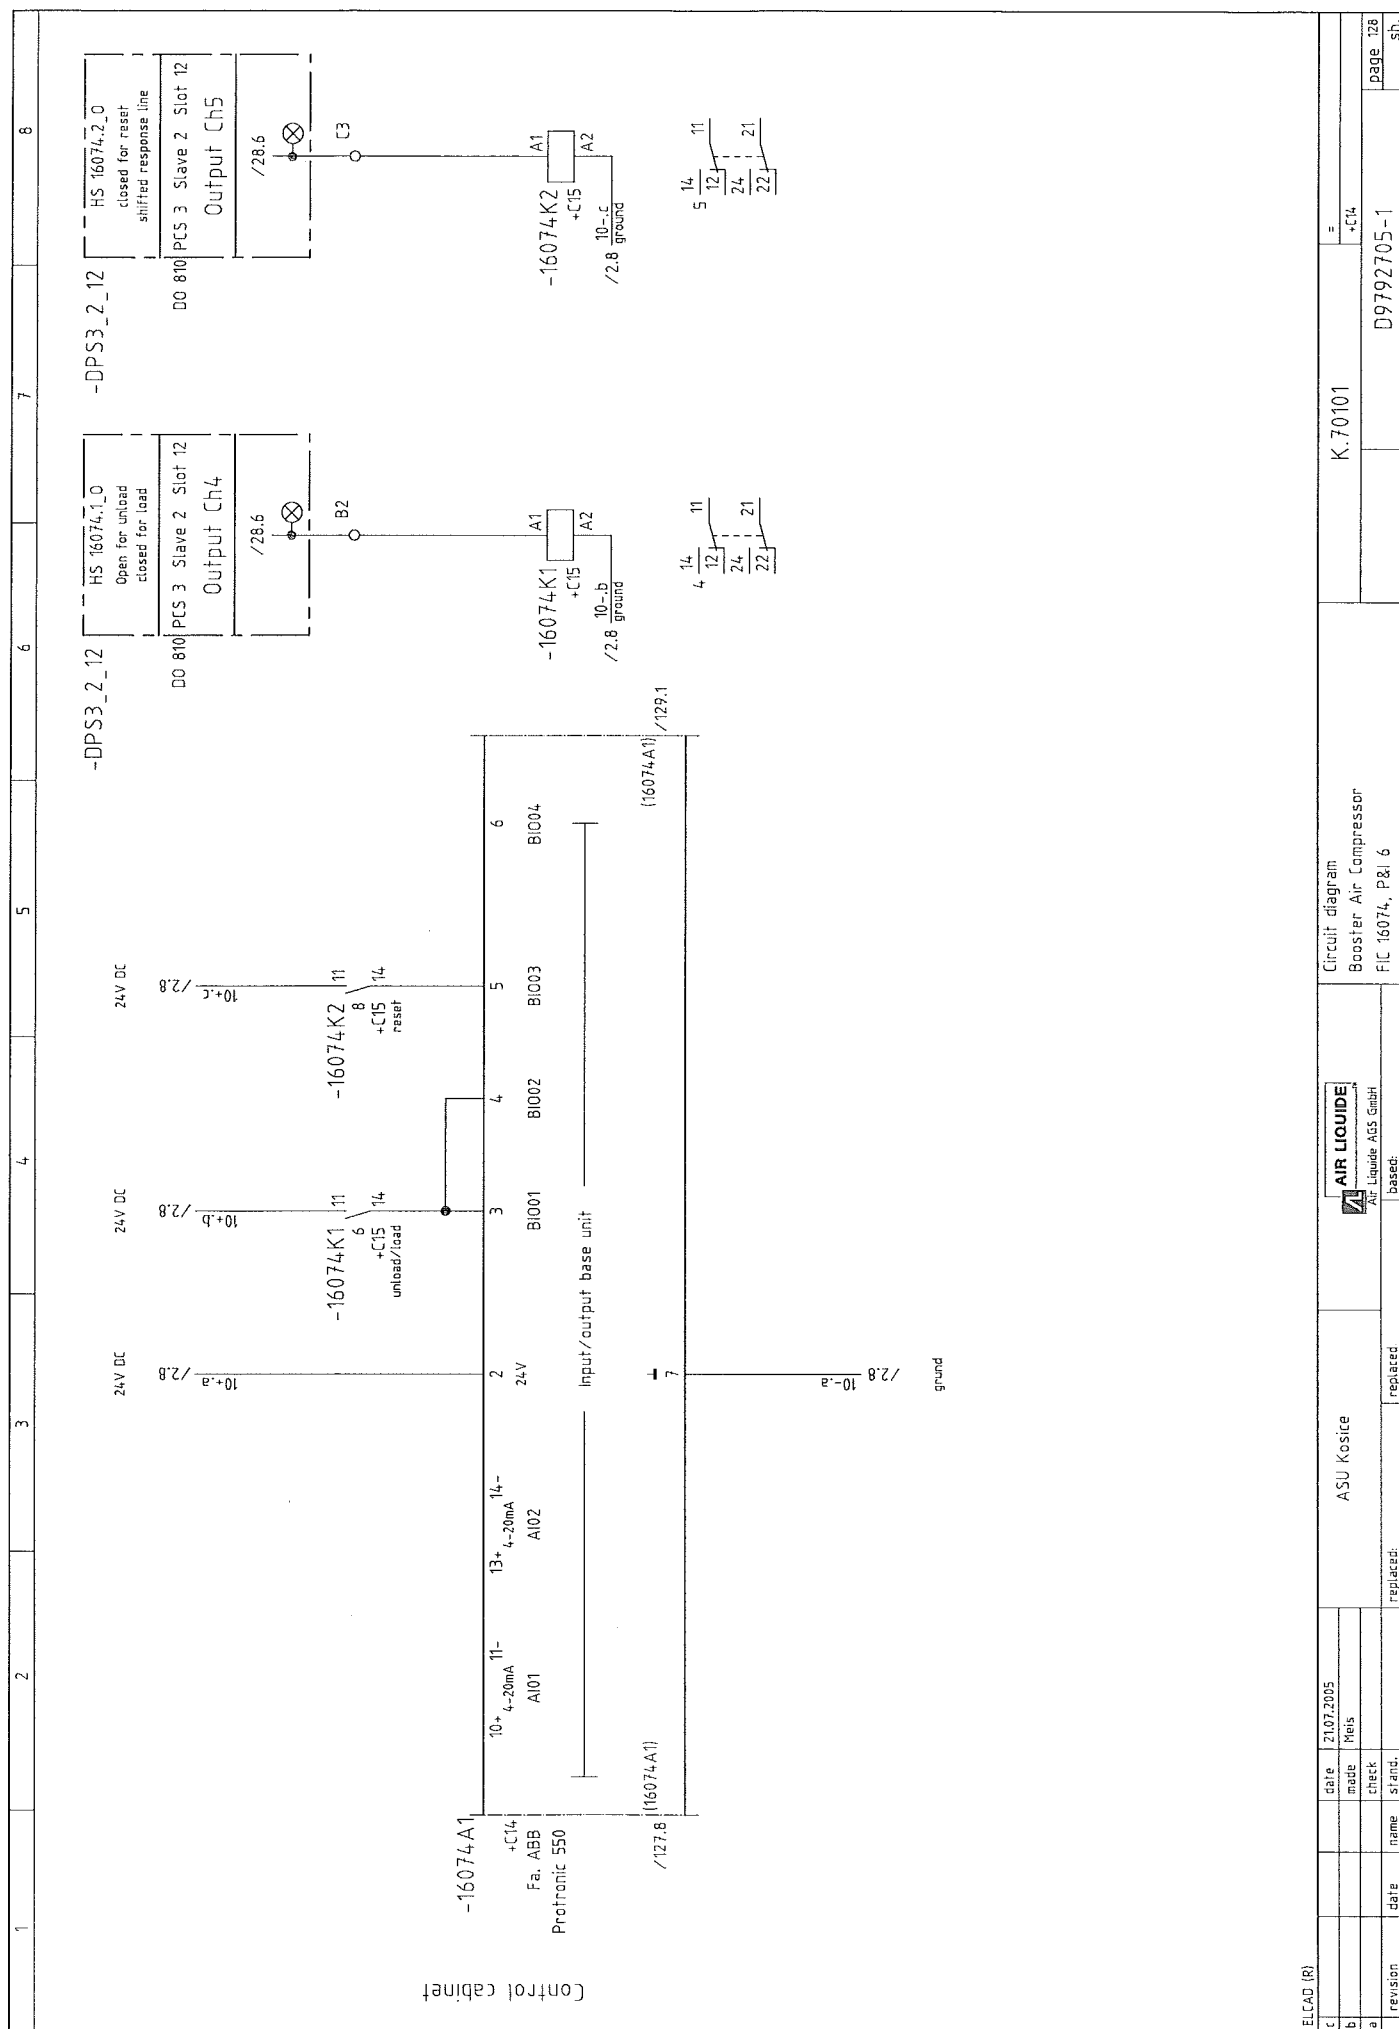

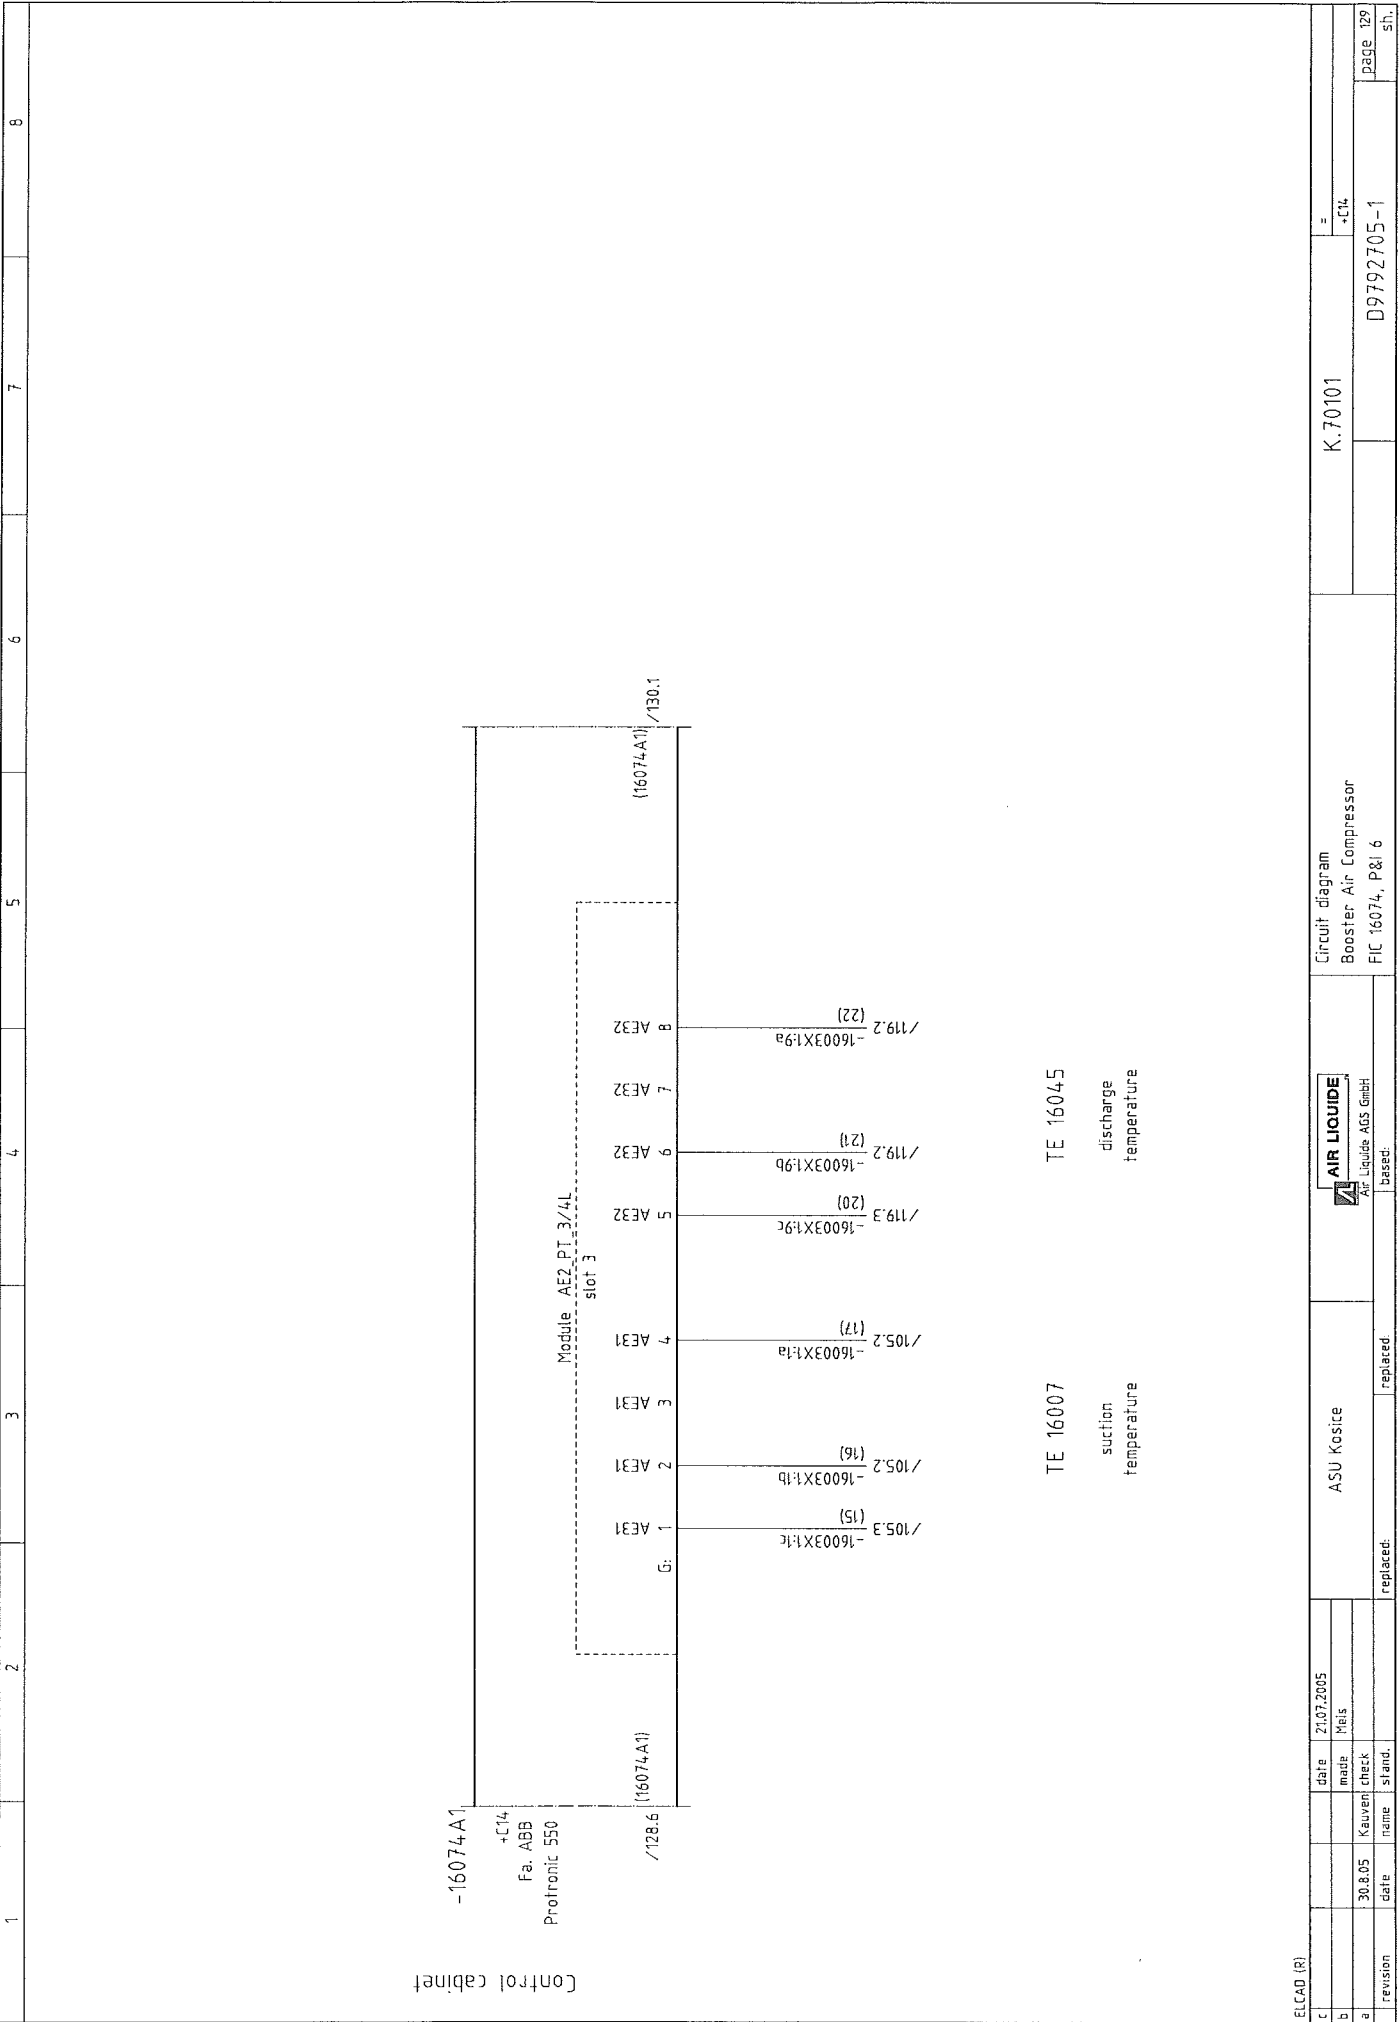

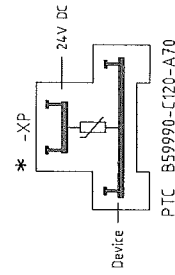[illegible]

12345678

-DPS3_2_7

T 16701
Bearing main
motor BAC

AI 830 PCS 3 Slave 2 Slot 7
Input Ch1

/26.3

ZP

C1 B1 A1

1a 1b 1c 1d

+C14

-M16001X1

E-C14-M16001-1

1BU 1RD 1GY 1YE

12x2x0.5mm
















[illegible]



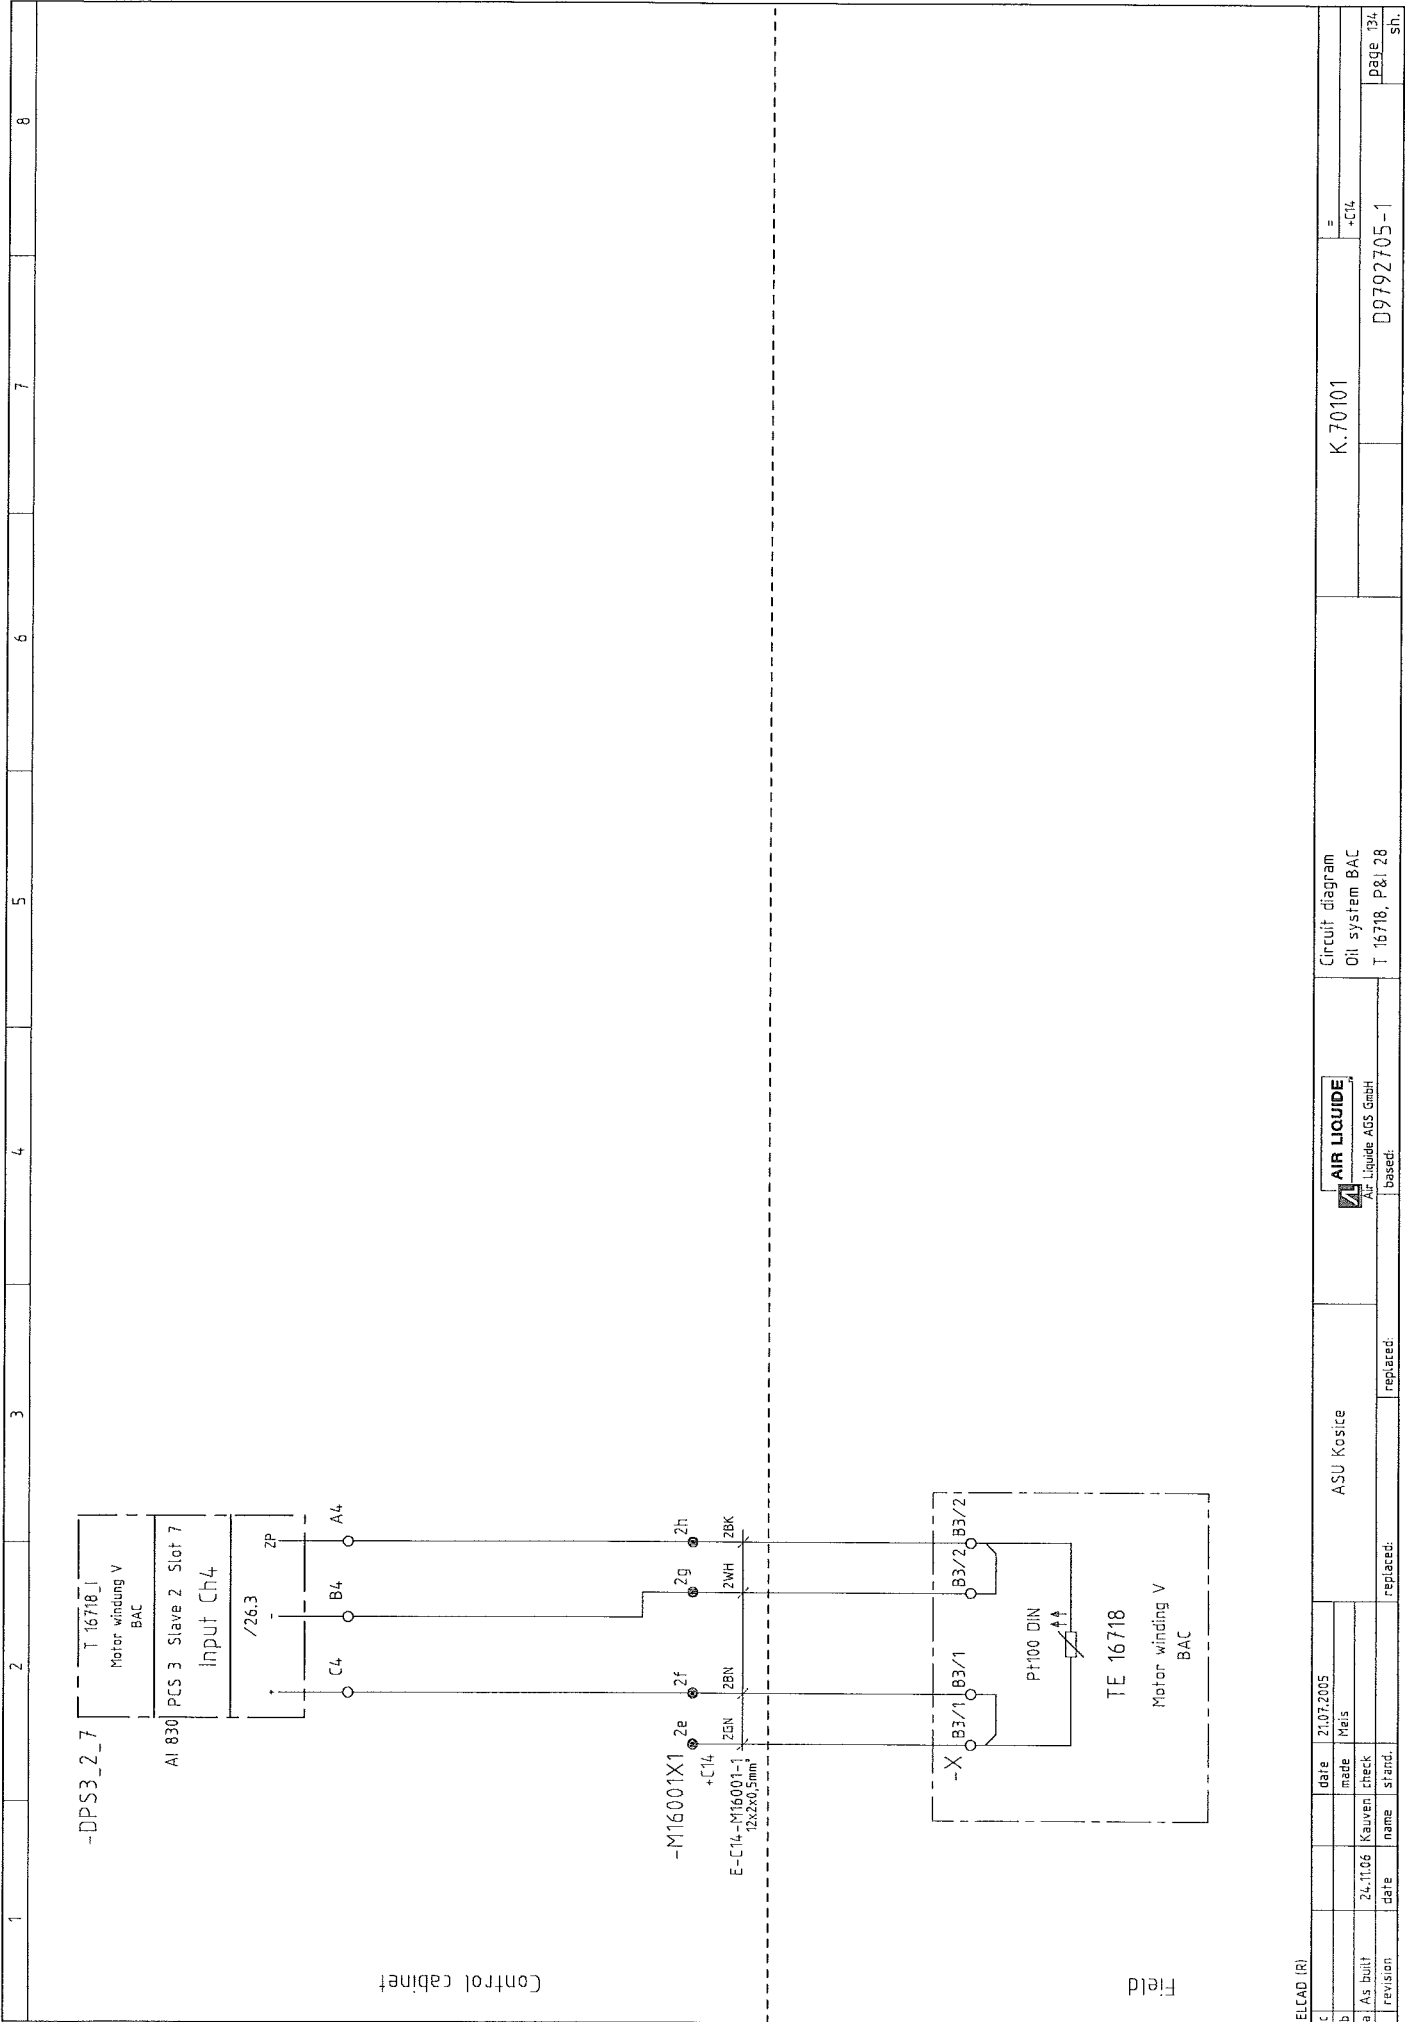


ELCAD (R)		date		21.07.2005		ASU Kostice		Circuit diagram		K.70101		=	
c		made		Meis				Oil system BAC				+C14	
b		check						T 16718, P&I 28					
a	As built	24.11.06	Kauven										
revision	name	date	stand.	replaced:	replaced:								
												D9792705-1	
												page 134	
												sh.	

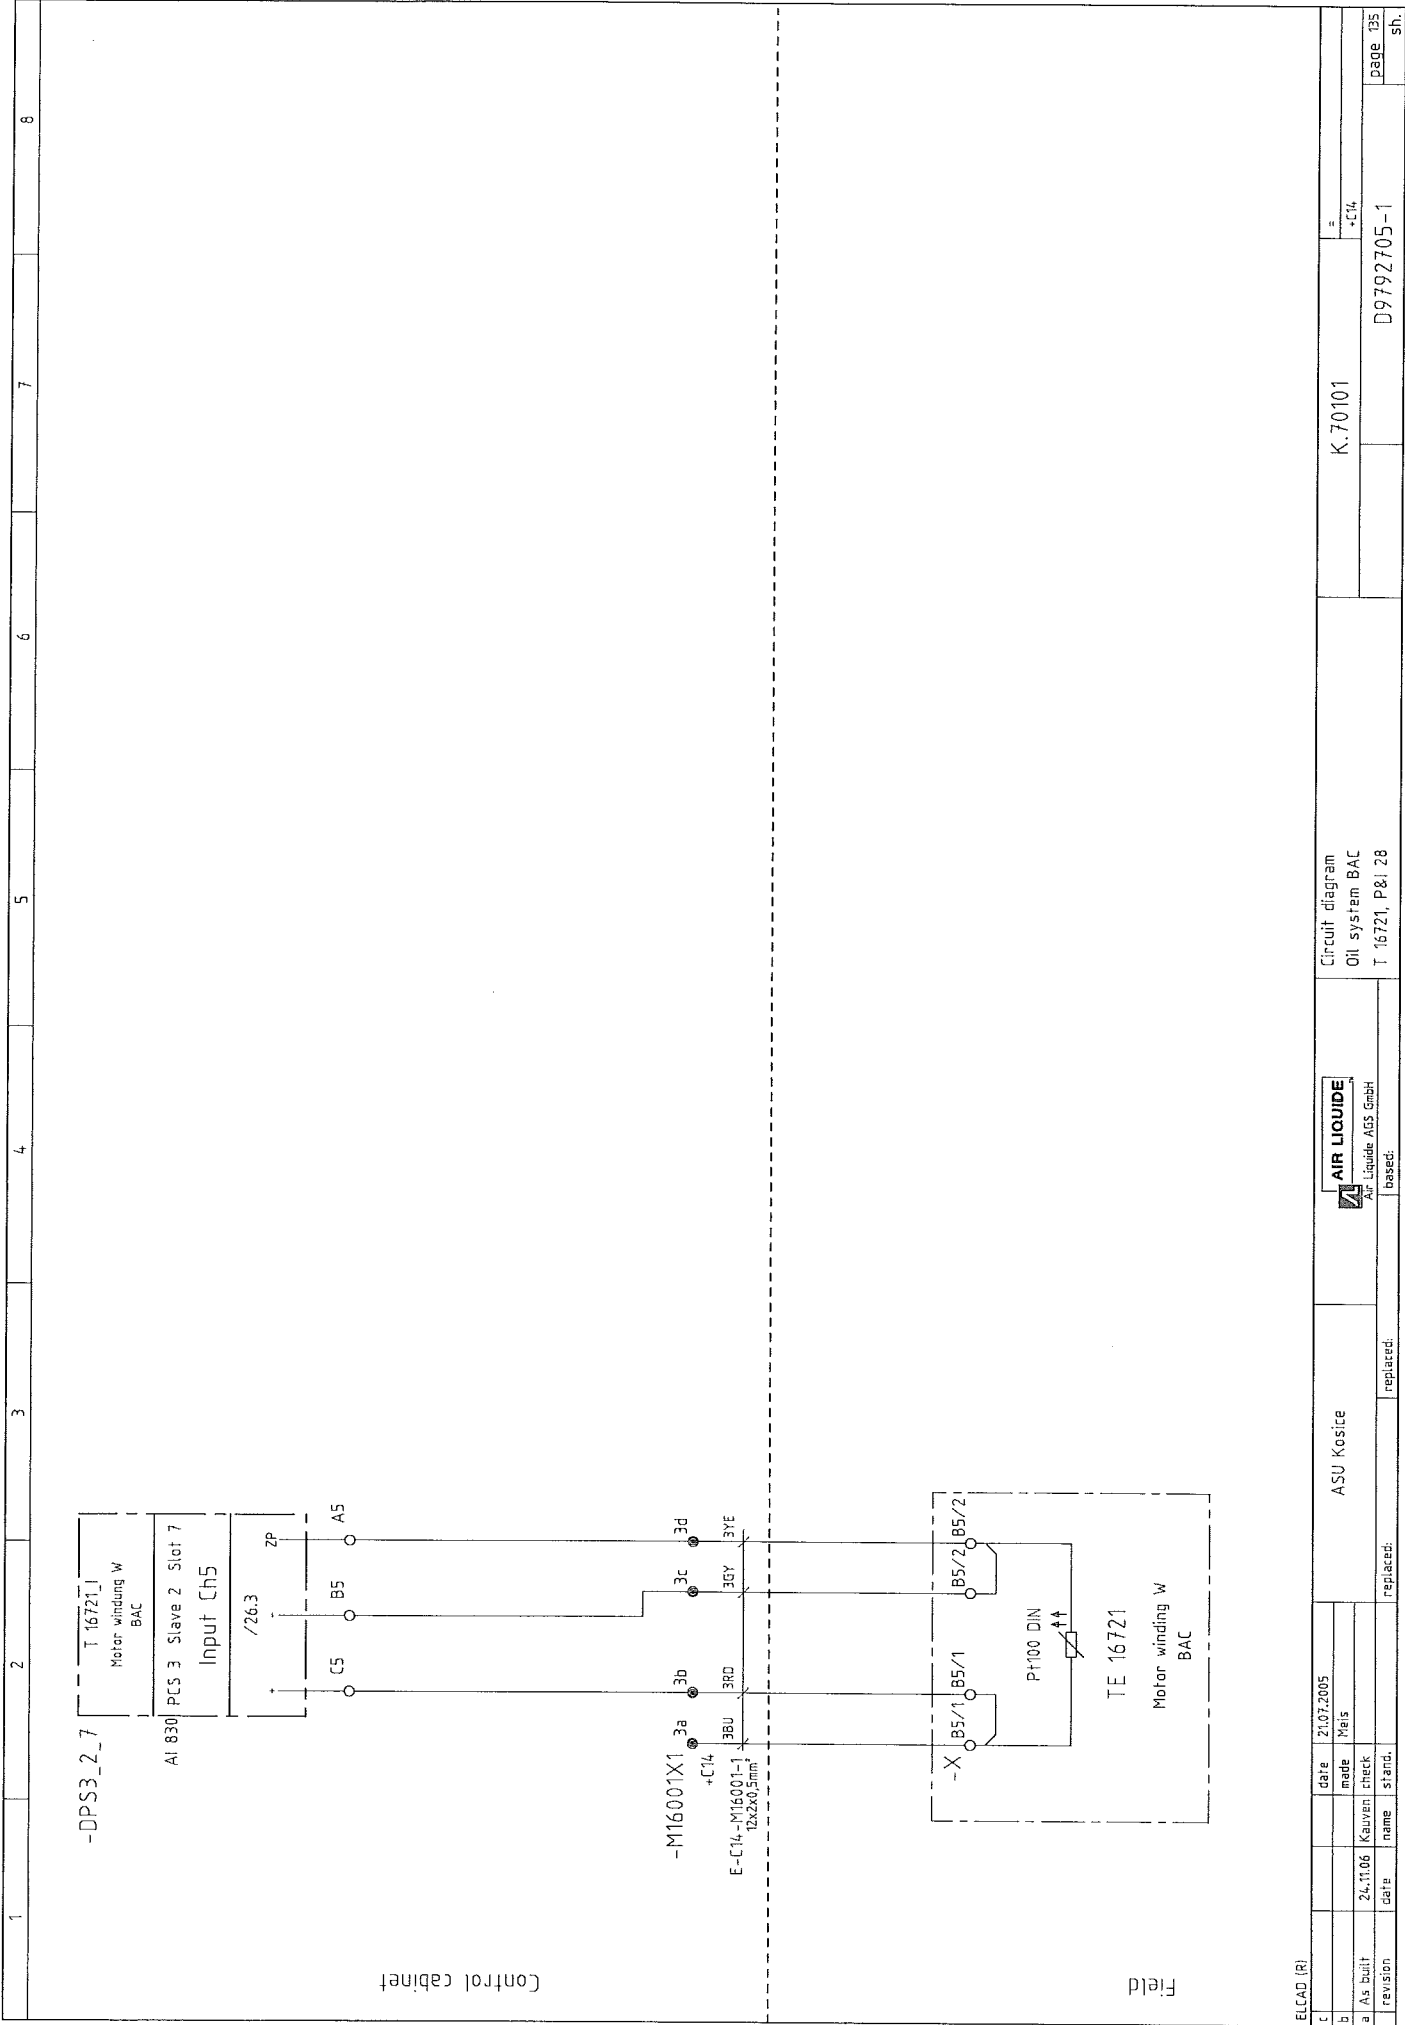


ELCAD (R)				date		21.07.2005		ASU Kosice		Circuit diagram		K.70101		S	
c				made	Meis					Oil system BAC				+C14	
b				check						T 16721, P&I 28					
a	As built	24.11.06	Kauveni												
revision	date	name	stand.	replaced:	replaced:							D9792705-1		page 135	
														sh.	

1	2	3	4	5	6	7	8	
+C11								
Schalttschrank								
+JB16005								
Feld								
ELCAD (R)								
c			date	21.07.2005	ASU Kositze			Circuit diagram
b	As built	24.11.06	Kauven	made	Meis	K.70101		Oil system BAC
a		13.10.05	Kauven	check				XE 14, Option
	revision	date	name	stand.	replaced:	replaced:		
					AIR LIQUIDE			
					Air Liquide AGS GmbH			
					based:			
							D9792705-1	
							page 137	
							sh.	

1	2	3	4	5	6	7	8	
Schaltschrank	
+JB16005	
Feld	
<div style="display: flex; justify-content: space-between;"> <div> <p>ELCAD (R)</p> <table border="1"> <tr> <td>c</td><td></td><td></td><td></td><td></td><td></td><td></td><td></td></tr> <tr> <td>b</td><td>As built</td><td>24.11.06</td><td>Kauven</td><td>date</td><td>21.07.2005</td><td></td><td></td></tr> <tr> <td>a</td><td>revision</td><td>13.10.05</td><td>Kauven</td><td>made</td><td>Mels</td><td></td><td></td></tr> <tr> <td></td><td></td><td></td><td></td><td>check</td><td></td><td></td><td></td></tr> <tr> <td></td><td></td><td></td><td></td><td>name</td><td>stand.</td><td></td><td></td></tr> </table> </div> <div> <p>ASU Kosice</p> </div> <div> <p>AIR LIQUIDE Air Liquide AGS GmbH based:</p> </div> <div> <p>Circuit diagram Oil system BAC XE 14, Option</p> </div> <div> <p>K.70101</p> </div> <div> <p>= +CLC</p> </div> </div>								c								b	As built	24.11.06	Kauven	date	21.07.2005			a	revision	13.10.05	Kauven	made	Mels							check								name	stand.		
c	
b	As built	24.11.06	Kauven	date	21.07.2005	
a	revision	13.10.05	Kauven	made	Mels	
				check	
				name	stand.	
						D9792705-1	
						page 138 sh.	

1	2	3	4	5	6	7	8
Schaltschrank							
+JB16005							
Feld							
ELCAD (R)							
c							
b	As built	24.11.05	Kauven	made	Meis		
a	revision	13.10.05	Kauven	check			
		date	name	stand.	replaced:	replaced:	
					based:		
					<div>  AIR LIQUIDE Air Liquide AGS GmbH </div>		
					ASU Kosice		
					Circuit diagram Oil system BAC XE 14, Option		
					K.70101		
					= -C14		
					D9792705-1		
					page 139 sh.		

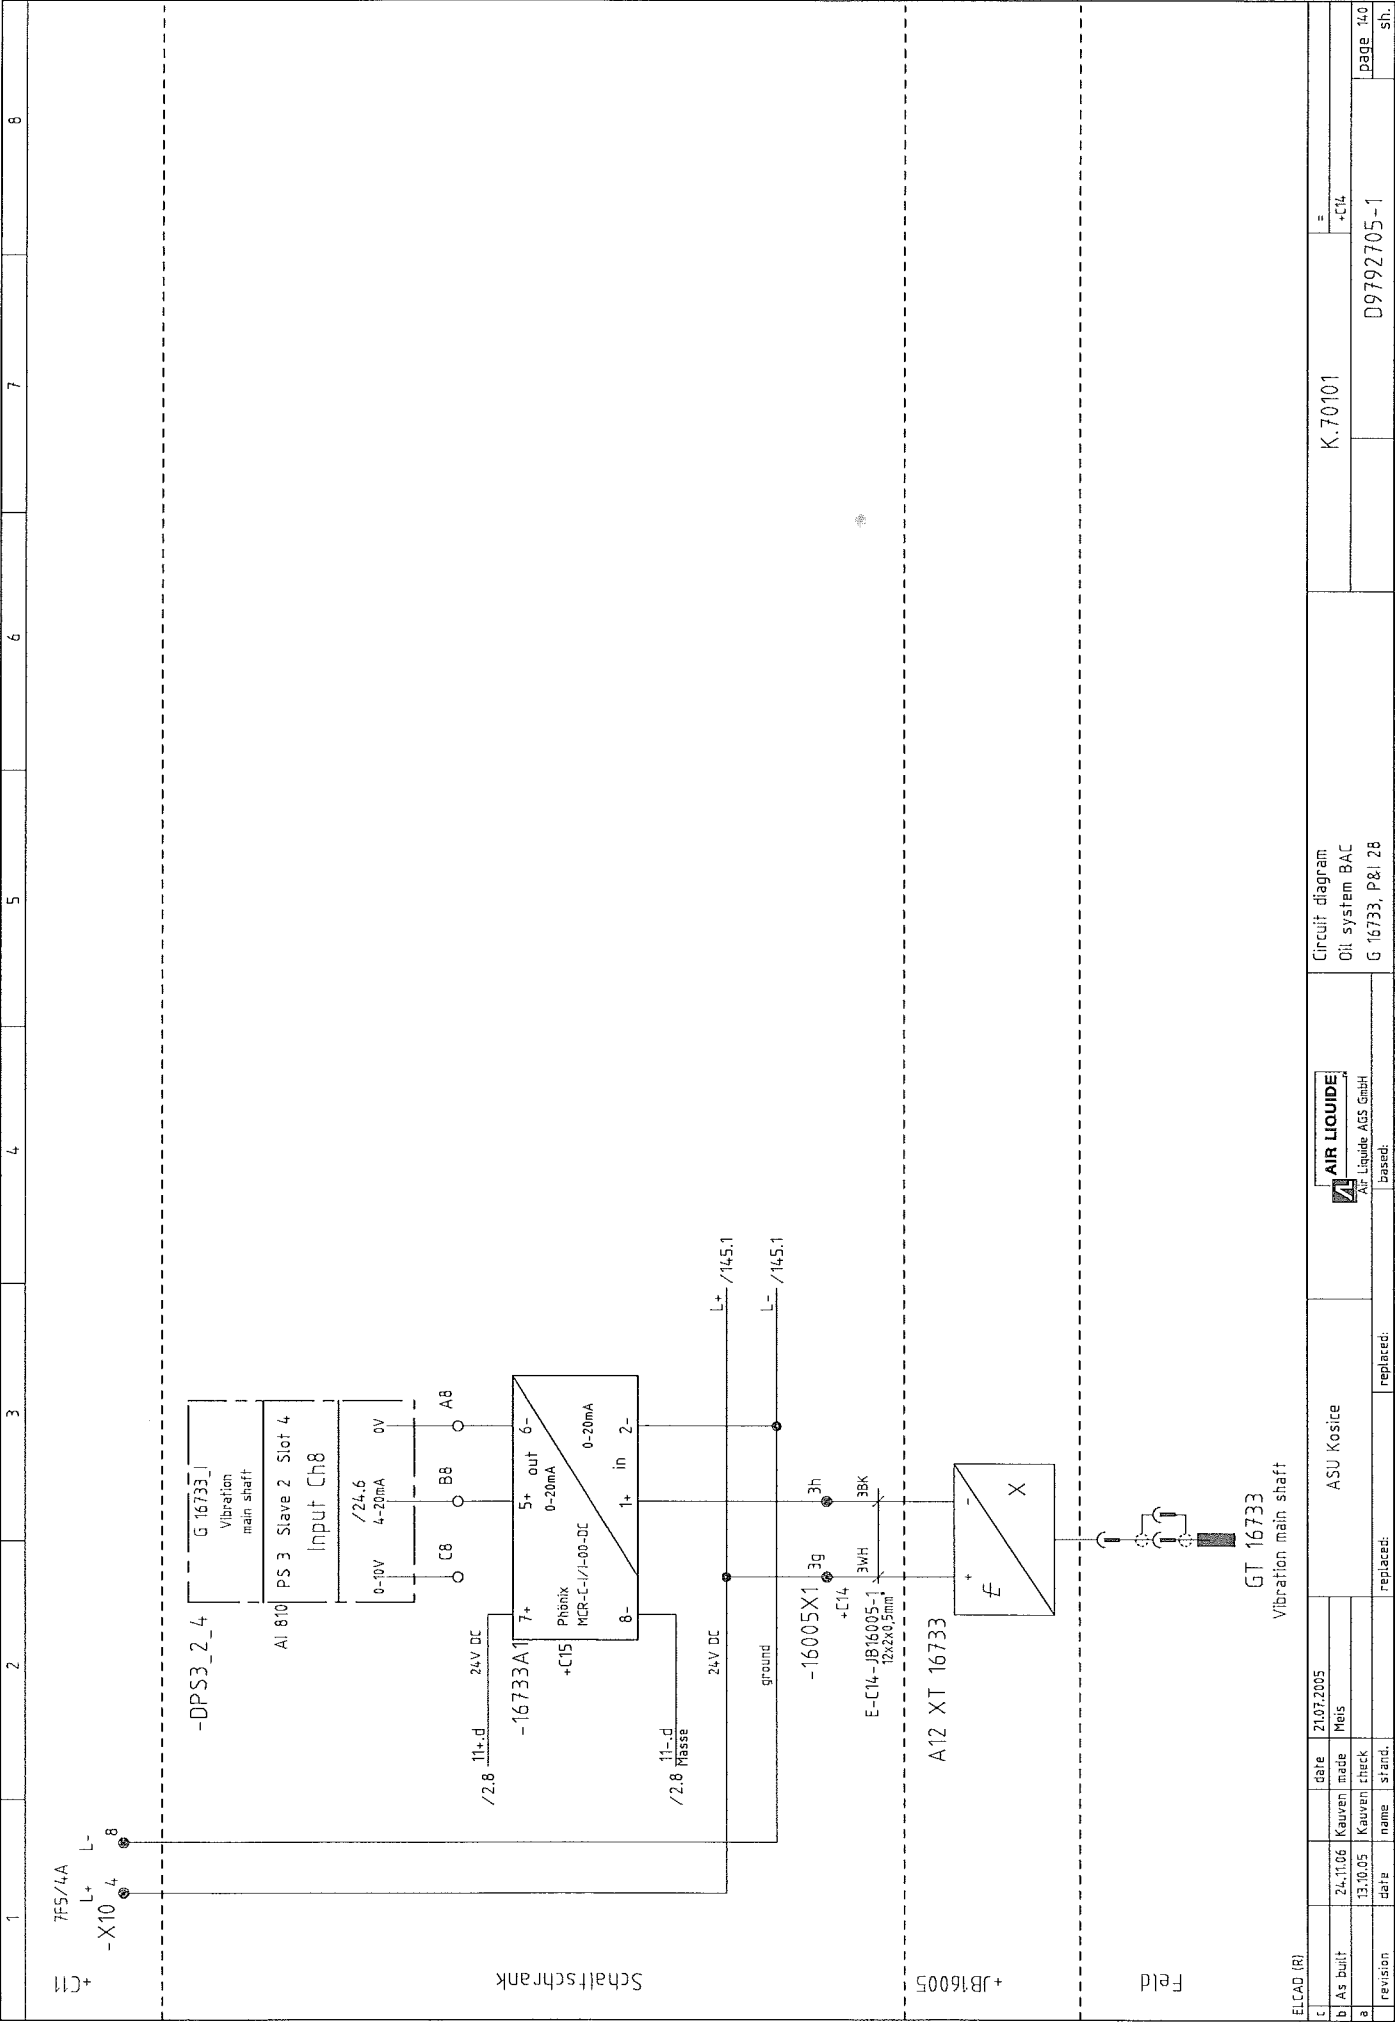

1	2	3	4	5	6	7	8
Control cabinet							
<div> <div>-DPS3_2_7</div> <div> <div>T 16733_1</div> <div>Bearing main shaft</div> <div>BAC</div> </div> <div> <div>AI 830</div> <div>PCS 3 Slave 2 Slot 7</div> <div>Input Ch7</div> </div> <div> <div>/26.3</div> <div>ZP</div> <div>C7</div> <div>B7</div> <div>A7</div> </div> </div>							
<div> <div>-16006X1</div> <div>+C14</div> <div>E-C14-JB16006-1</div> <div>12x2x0.5mm</div> <div>-X1</div> <div>9</div> <div>2a</div> <div>2b</div> <div>2c</div> </div>							

Field TE 16733_1 PH100 DIN TE 16733_2 PH100 DIN							
JB16006 E-JB16006-TE16733_1 3x15mm E-JB16006-TE16733_2 3x15mm							
Bearing main shaft BAC							
Circuit diagram Oil system BAC T 16733, p8, 28							
ASU Kosice replaced: replaced:							
AIR LIQUIDE Air Liquide AGS GmbH based:							
21.07.2005 date made Meis							
13.10.05 date checked Kauveni							
revision name stand. stand.							
ELCAD (R) page 141 D9792705-1 sh							