
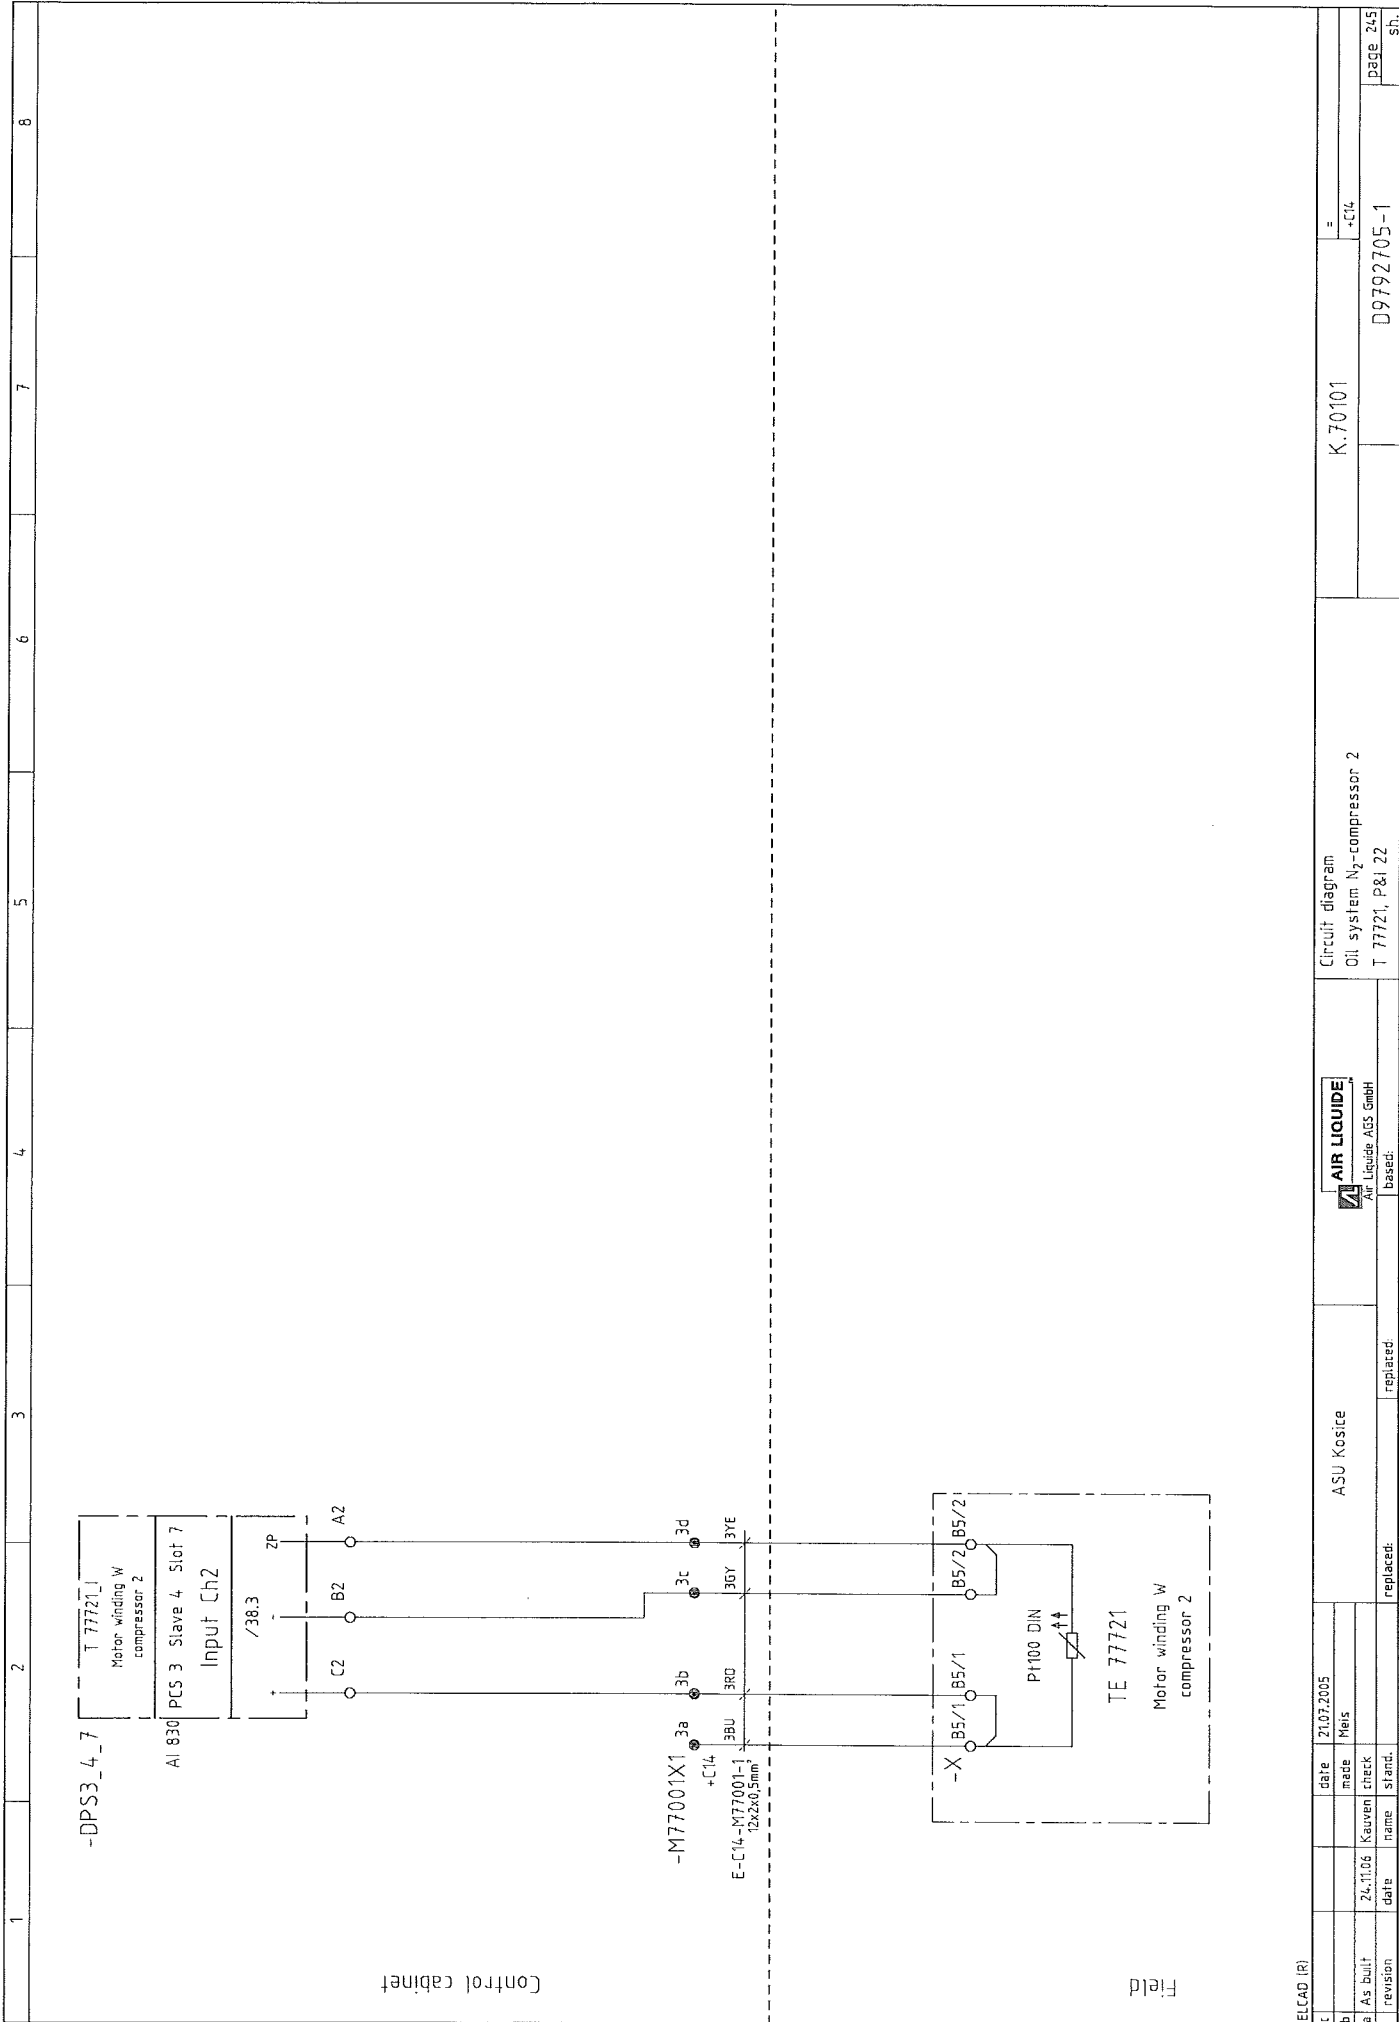
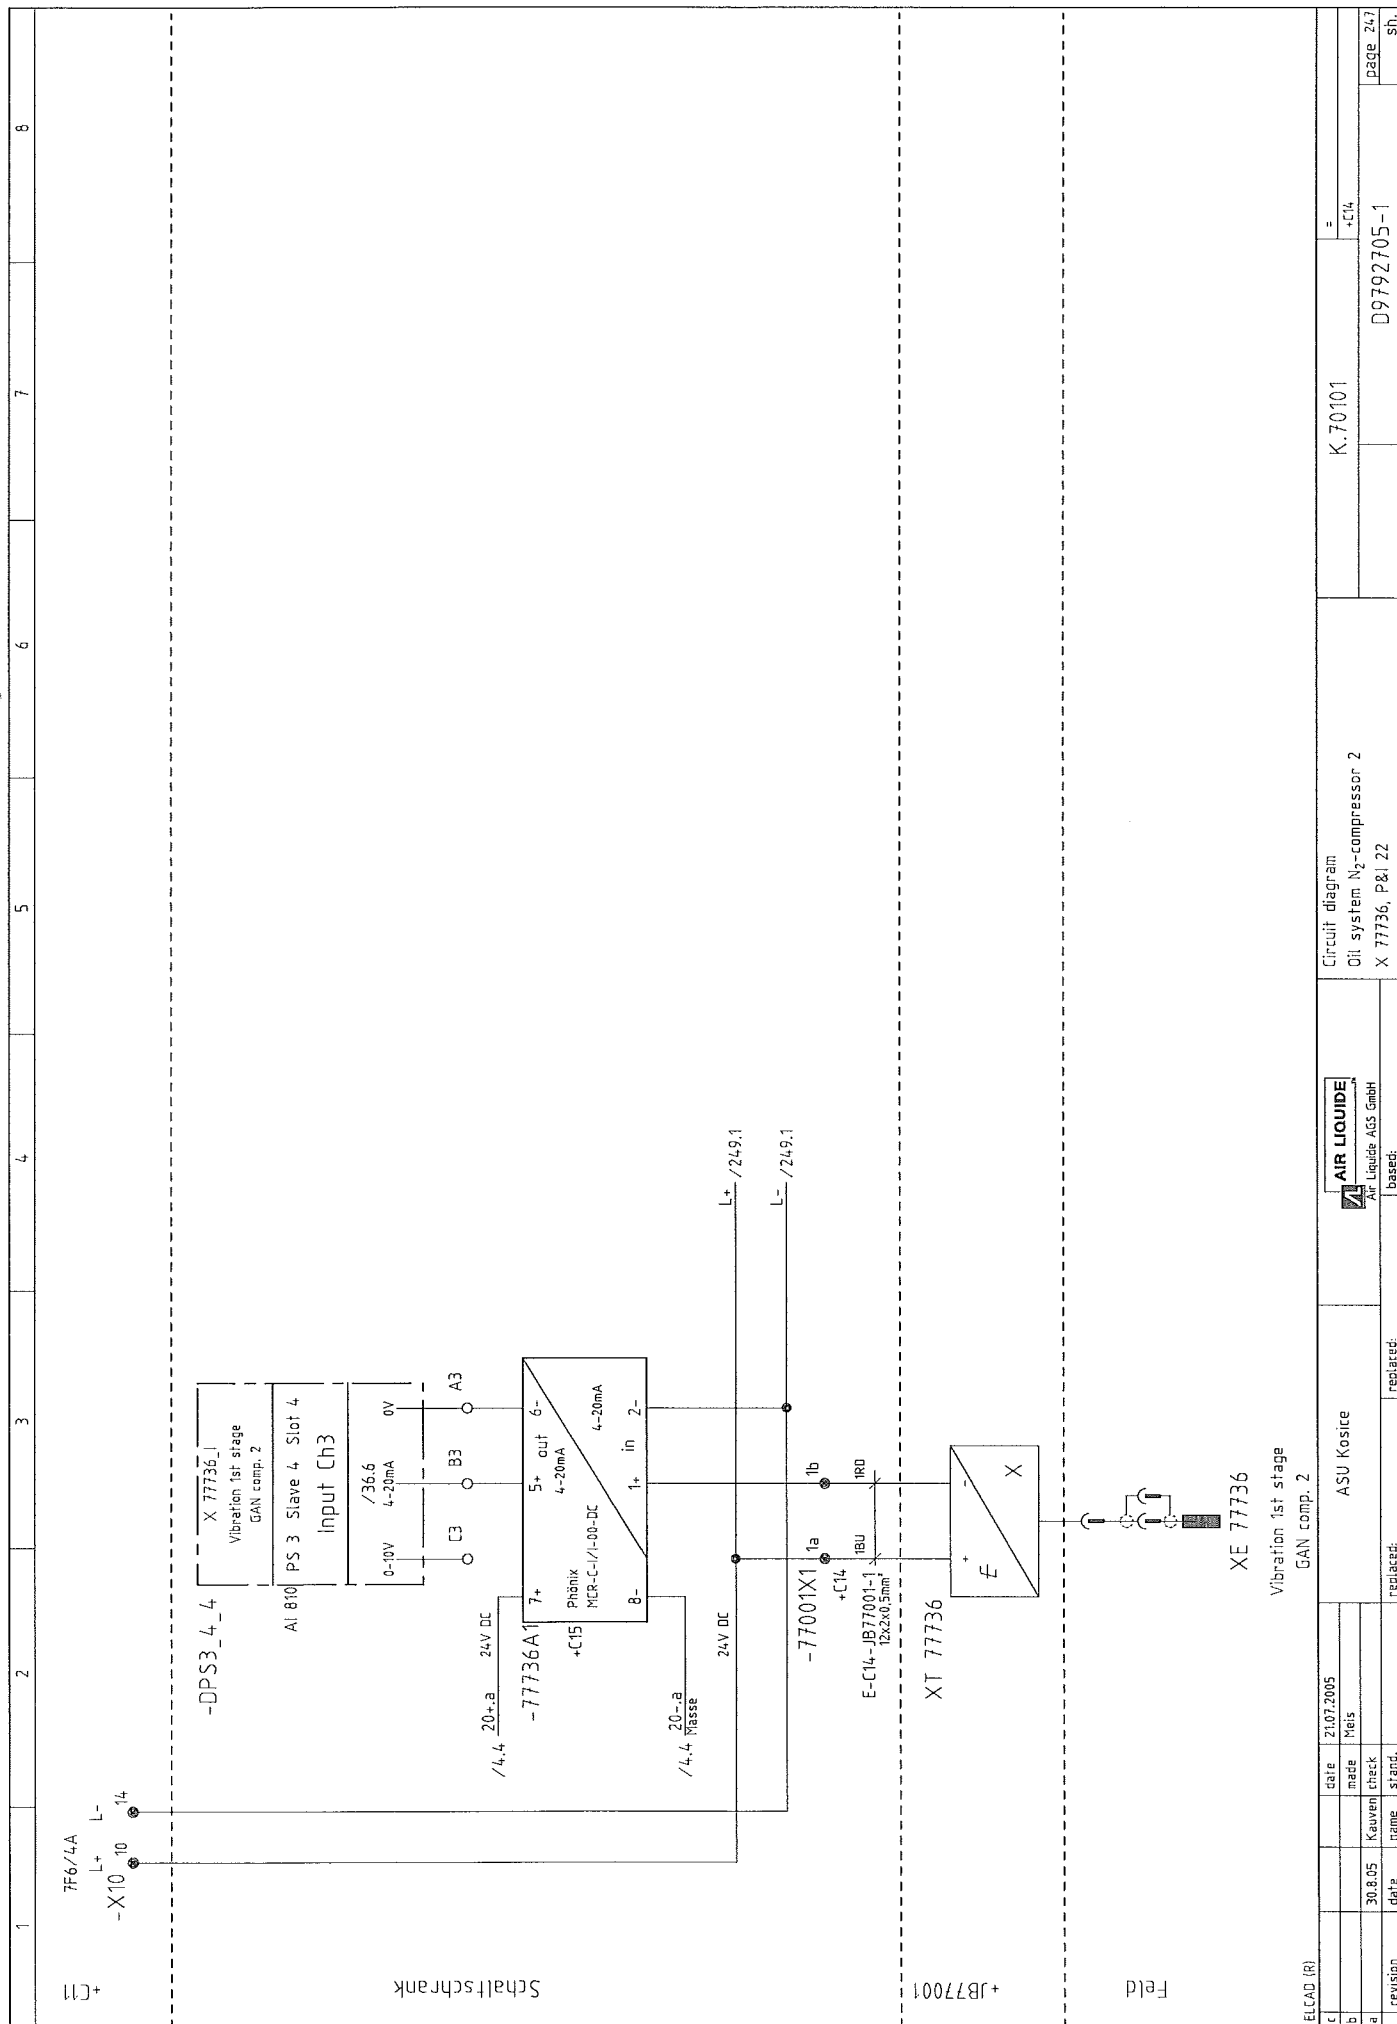
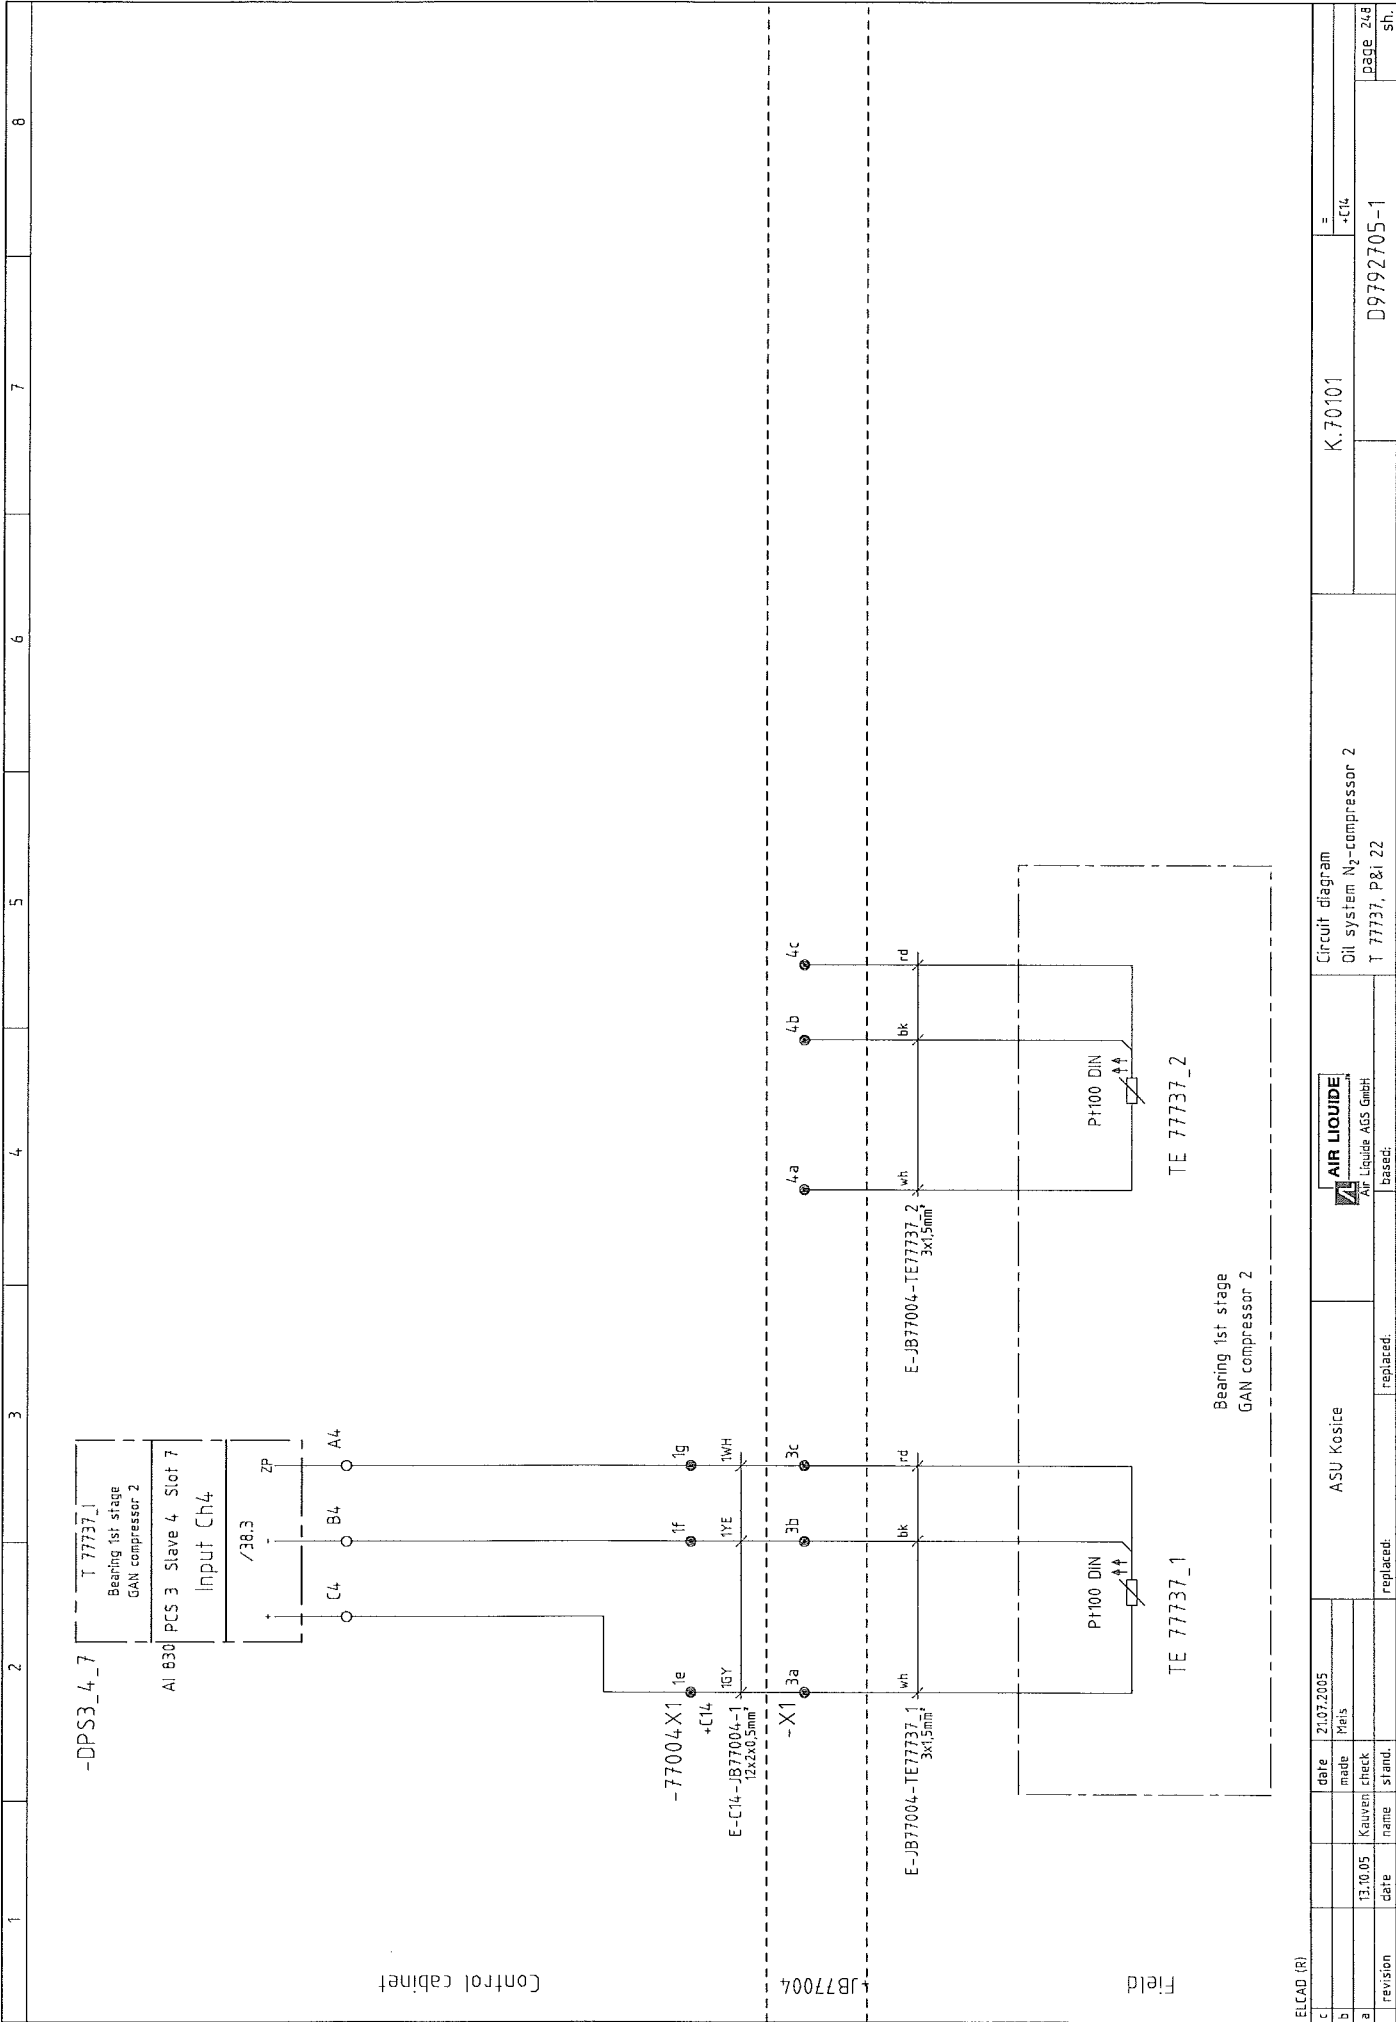


ELCAD (R)										date		21.07.2005		ASU Kosice		<div> AIR LIQUIDE Air Liquide AGS GmbH</div>		Circuit diagram		K.70101		=	
c	


[illegible]









ELCAD (R)	
c	

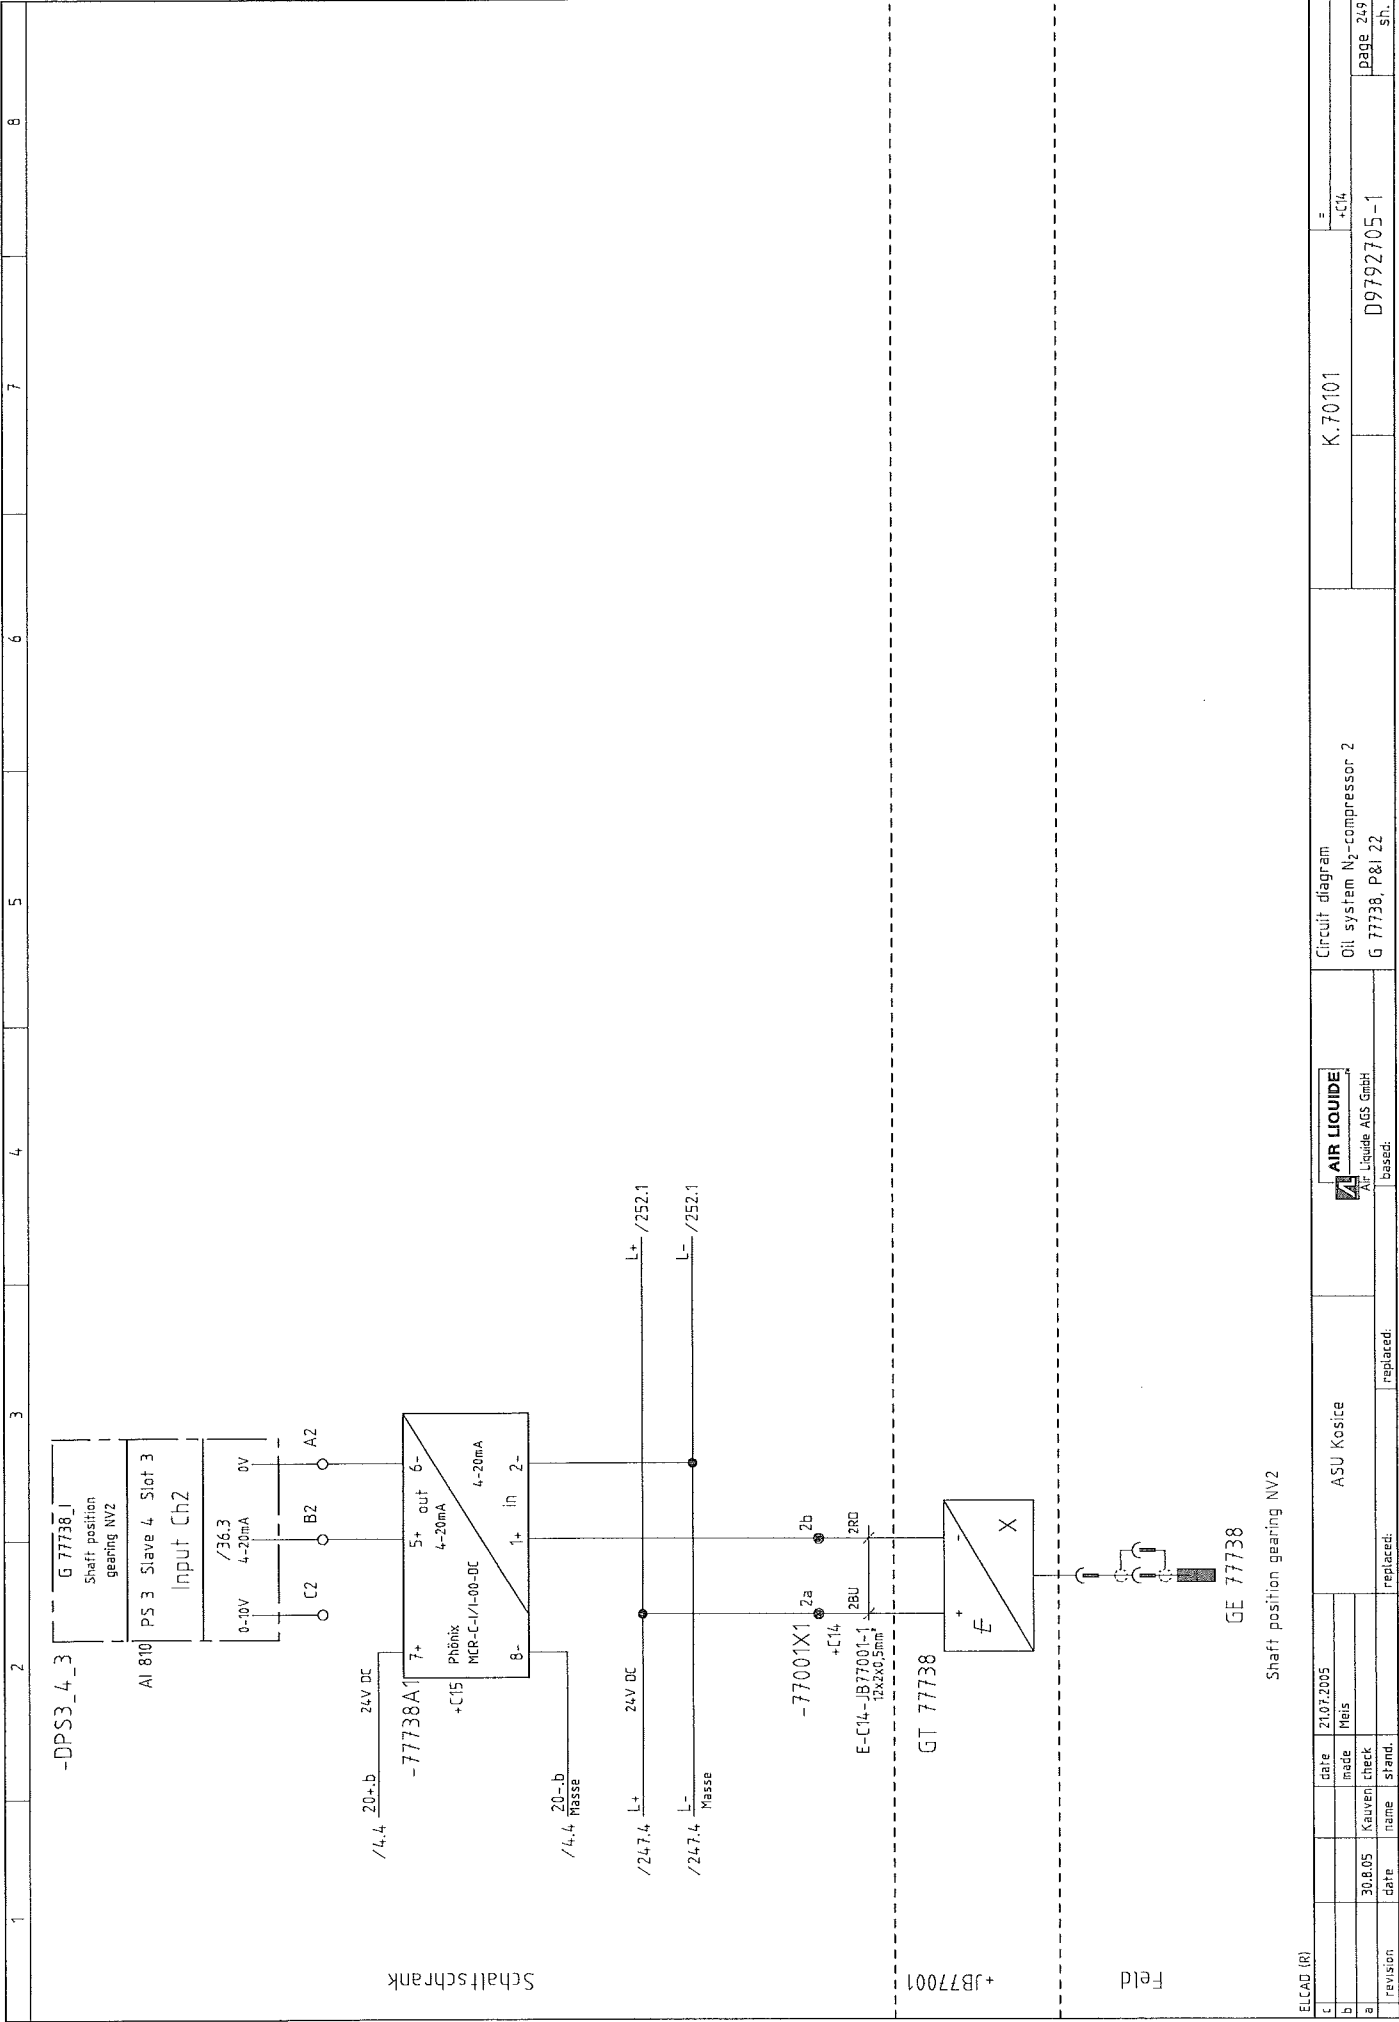


[illegible]

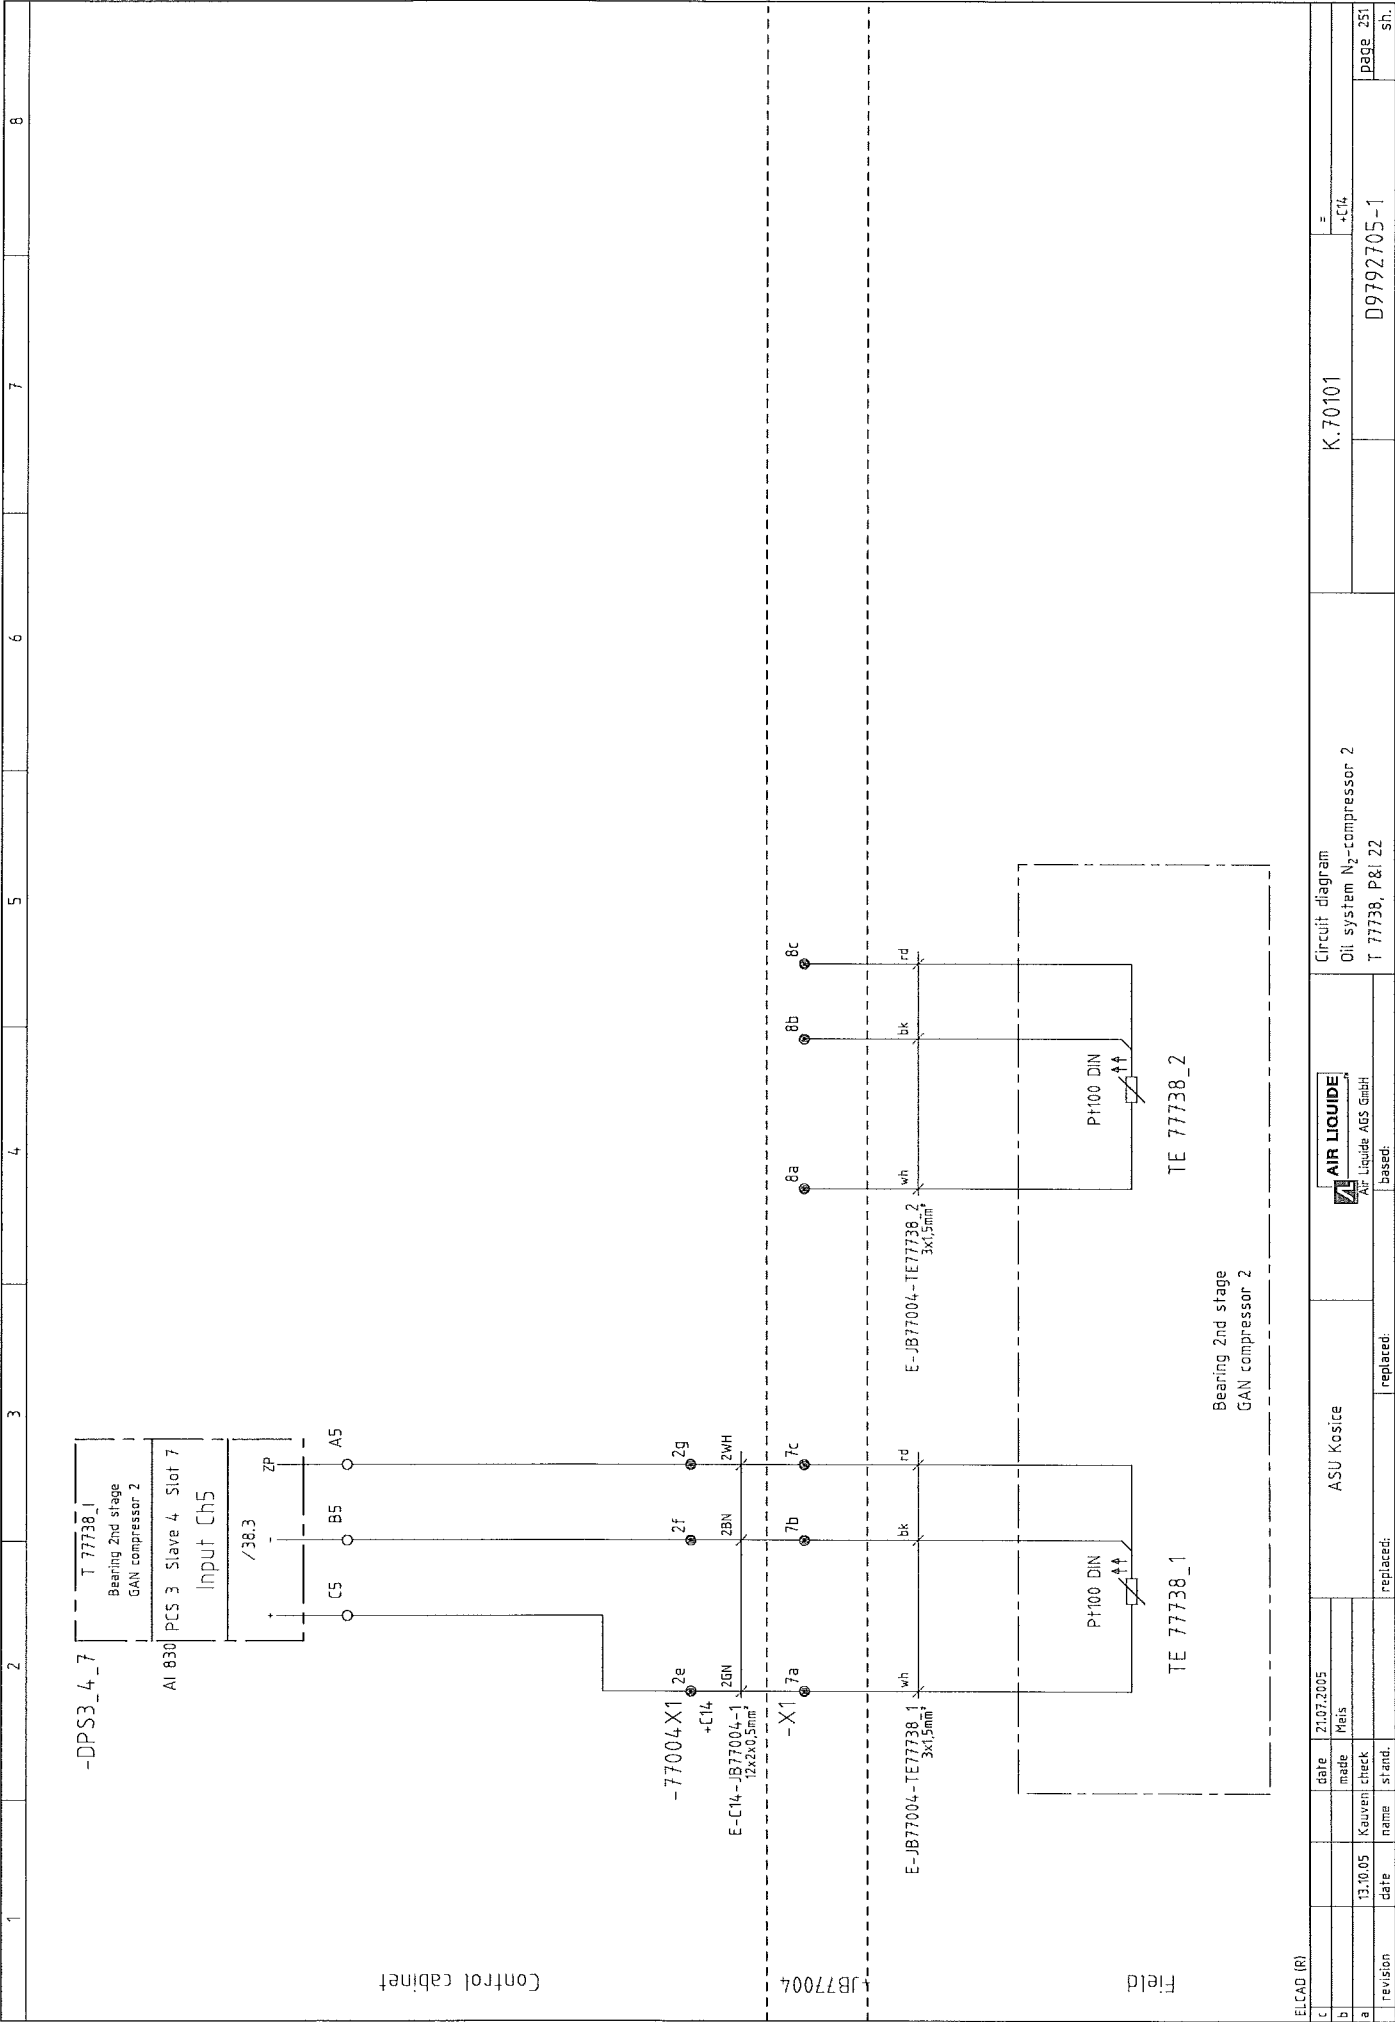



ELCAD (R)		date		21.07.2005	ASU Kosice		Circuit diagram		K.70101		=	
c		date		Mels			Oil system N ₂ -compressor 2				+C14	
b		made					T 77738, P&I 22					
a	13.10.05	Kauveni	check		replaced:		D9792705-1				page 251	
	revision	date	name	stand.	replaced:						sh.	

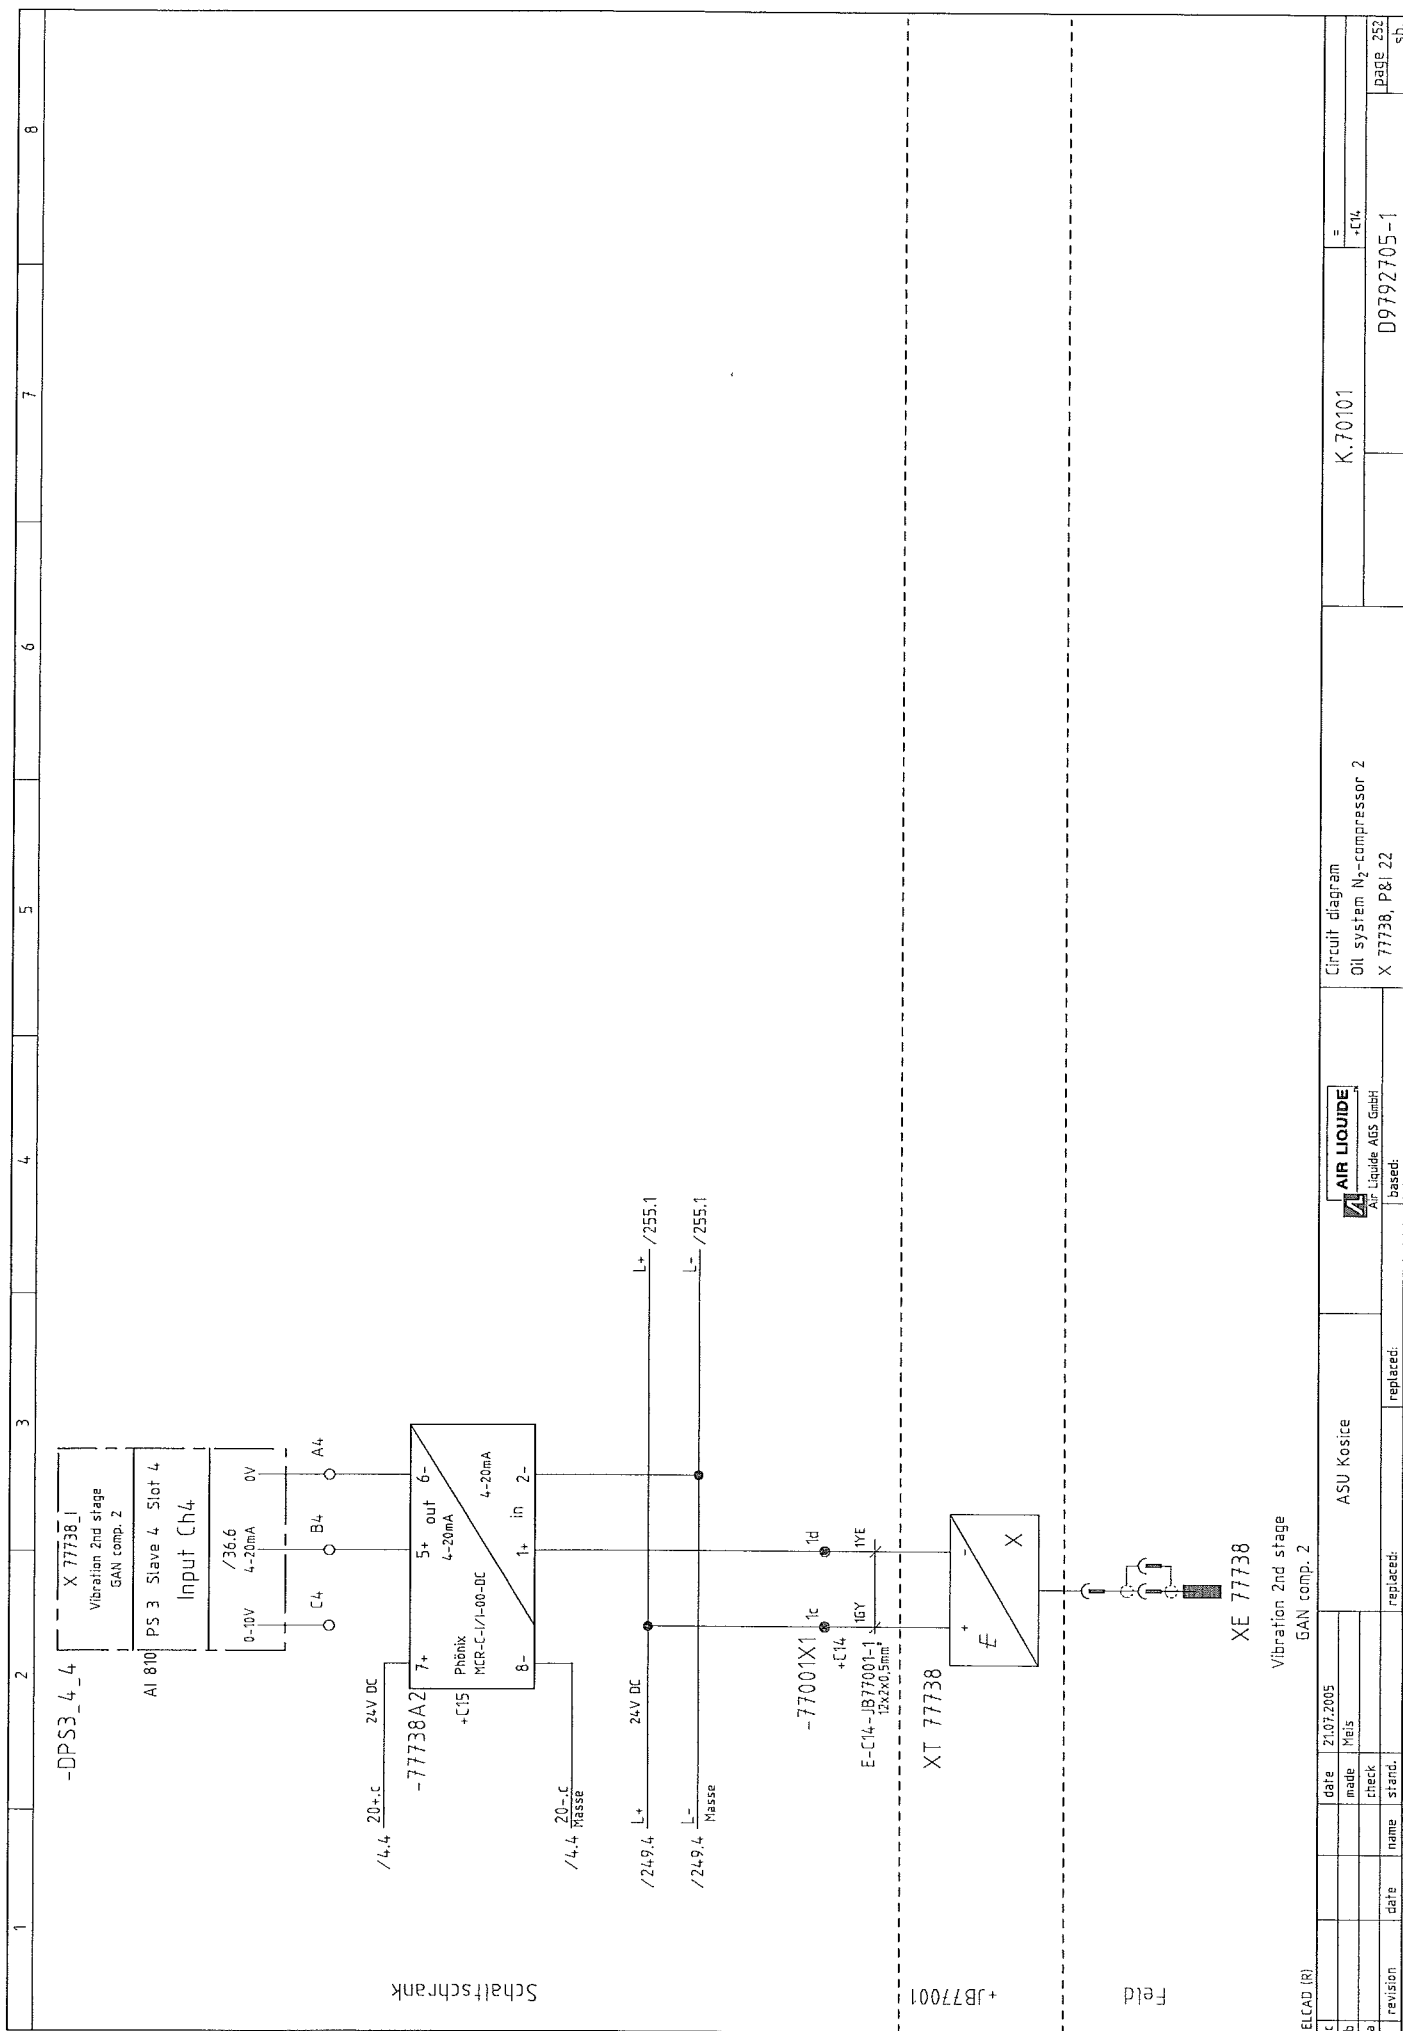

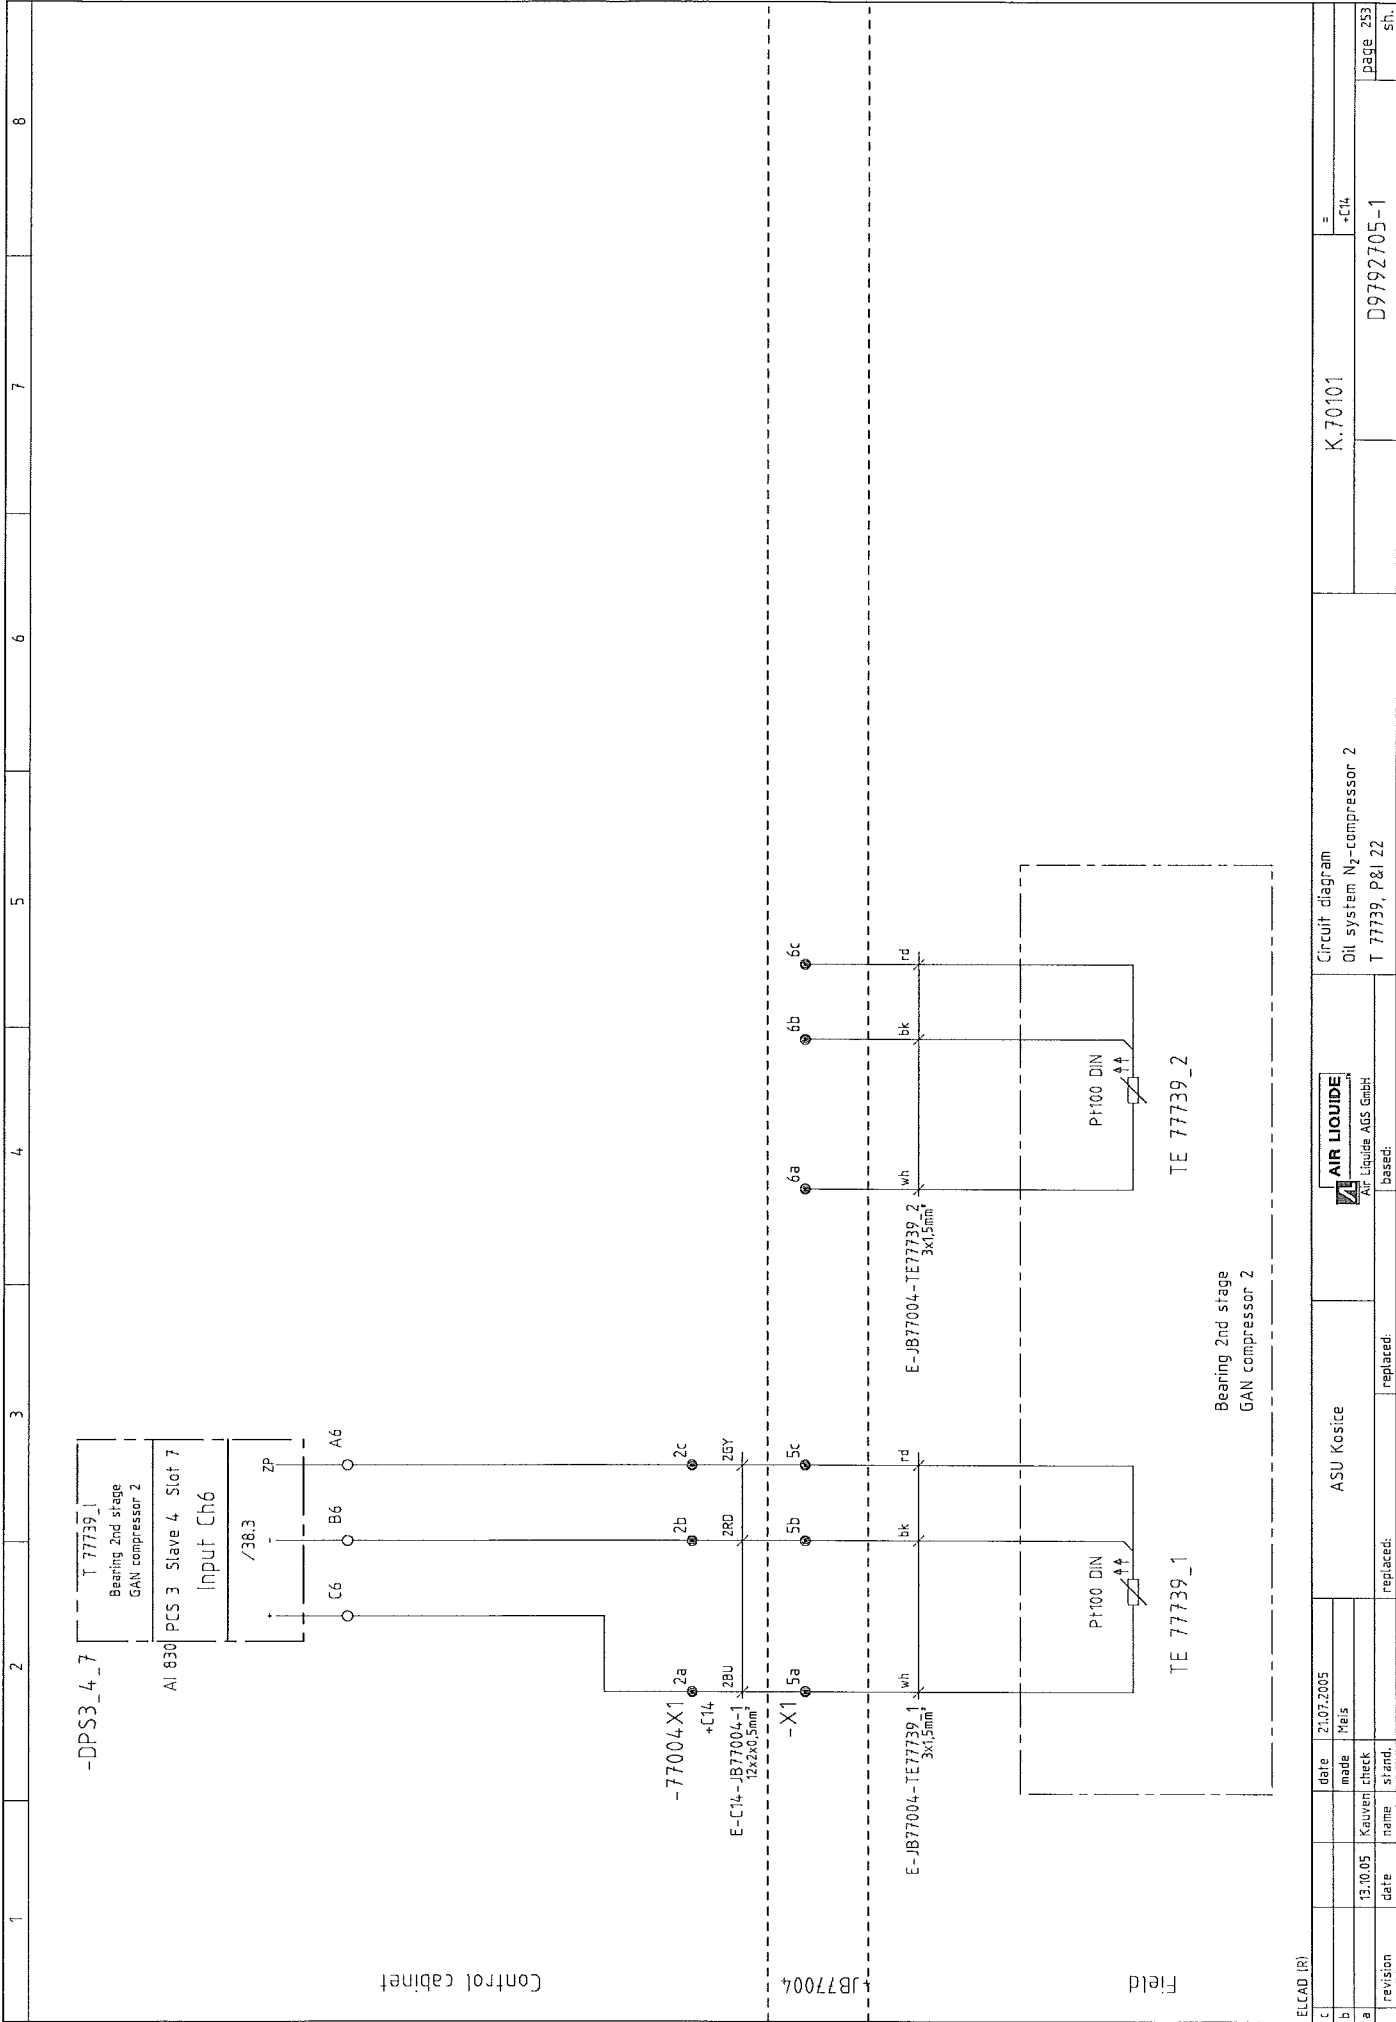


ELCAD (R)		ASU Kosice		Circuit diagram		=	
c	date	21.07.2005					
b	made	Mals					
a	Kauwen	check					
	date	stand.					
		replaced:					
		replaced:					
				K.70101		+C14	
				D9792705-1		page 233	
				sh.		sh.	

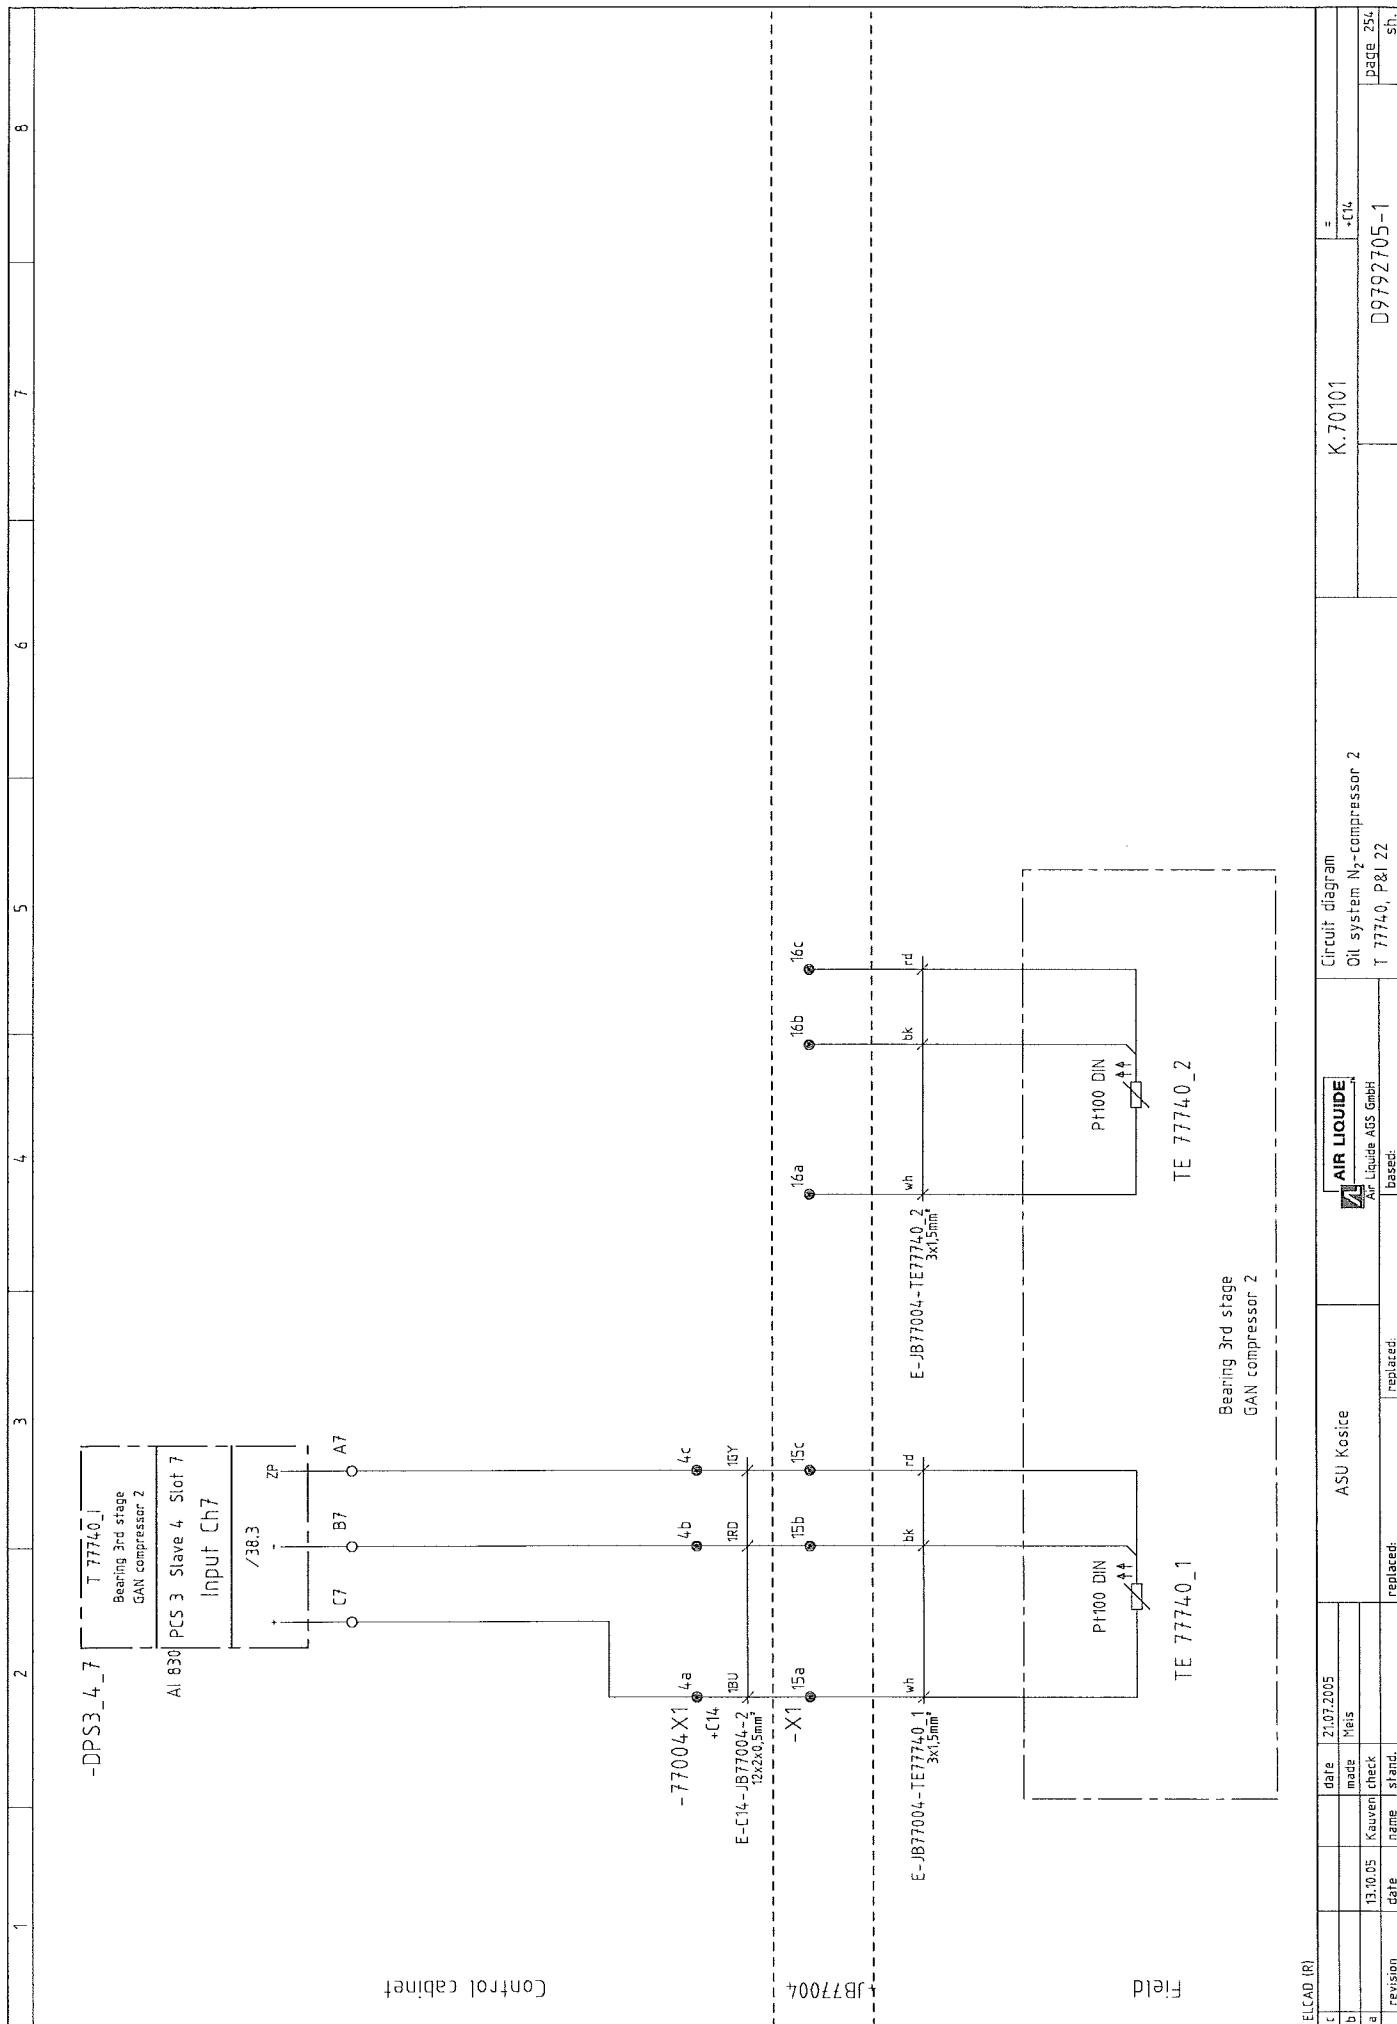

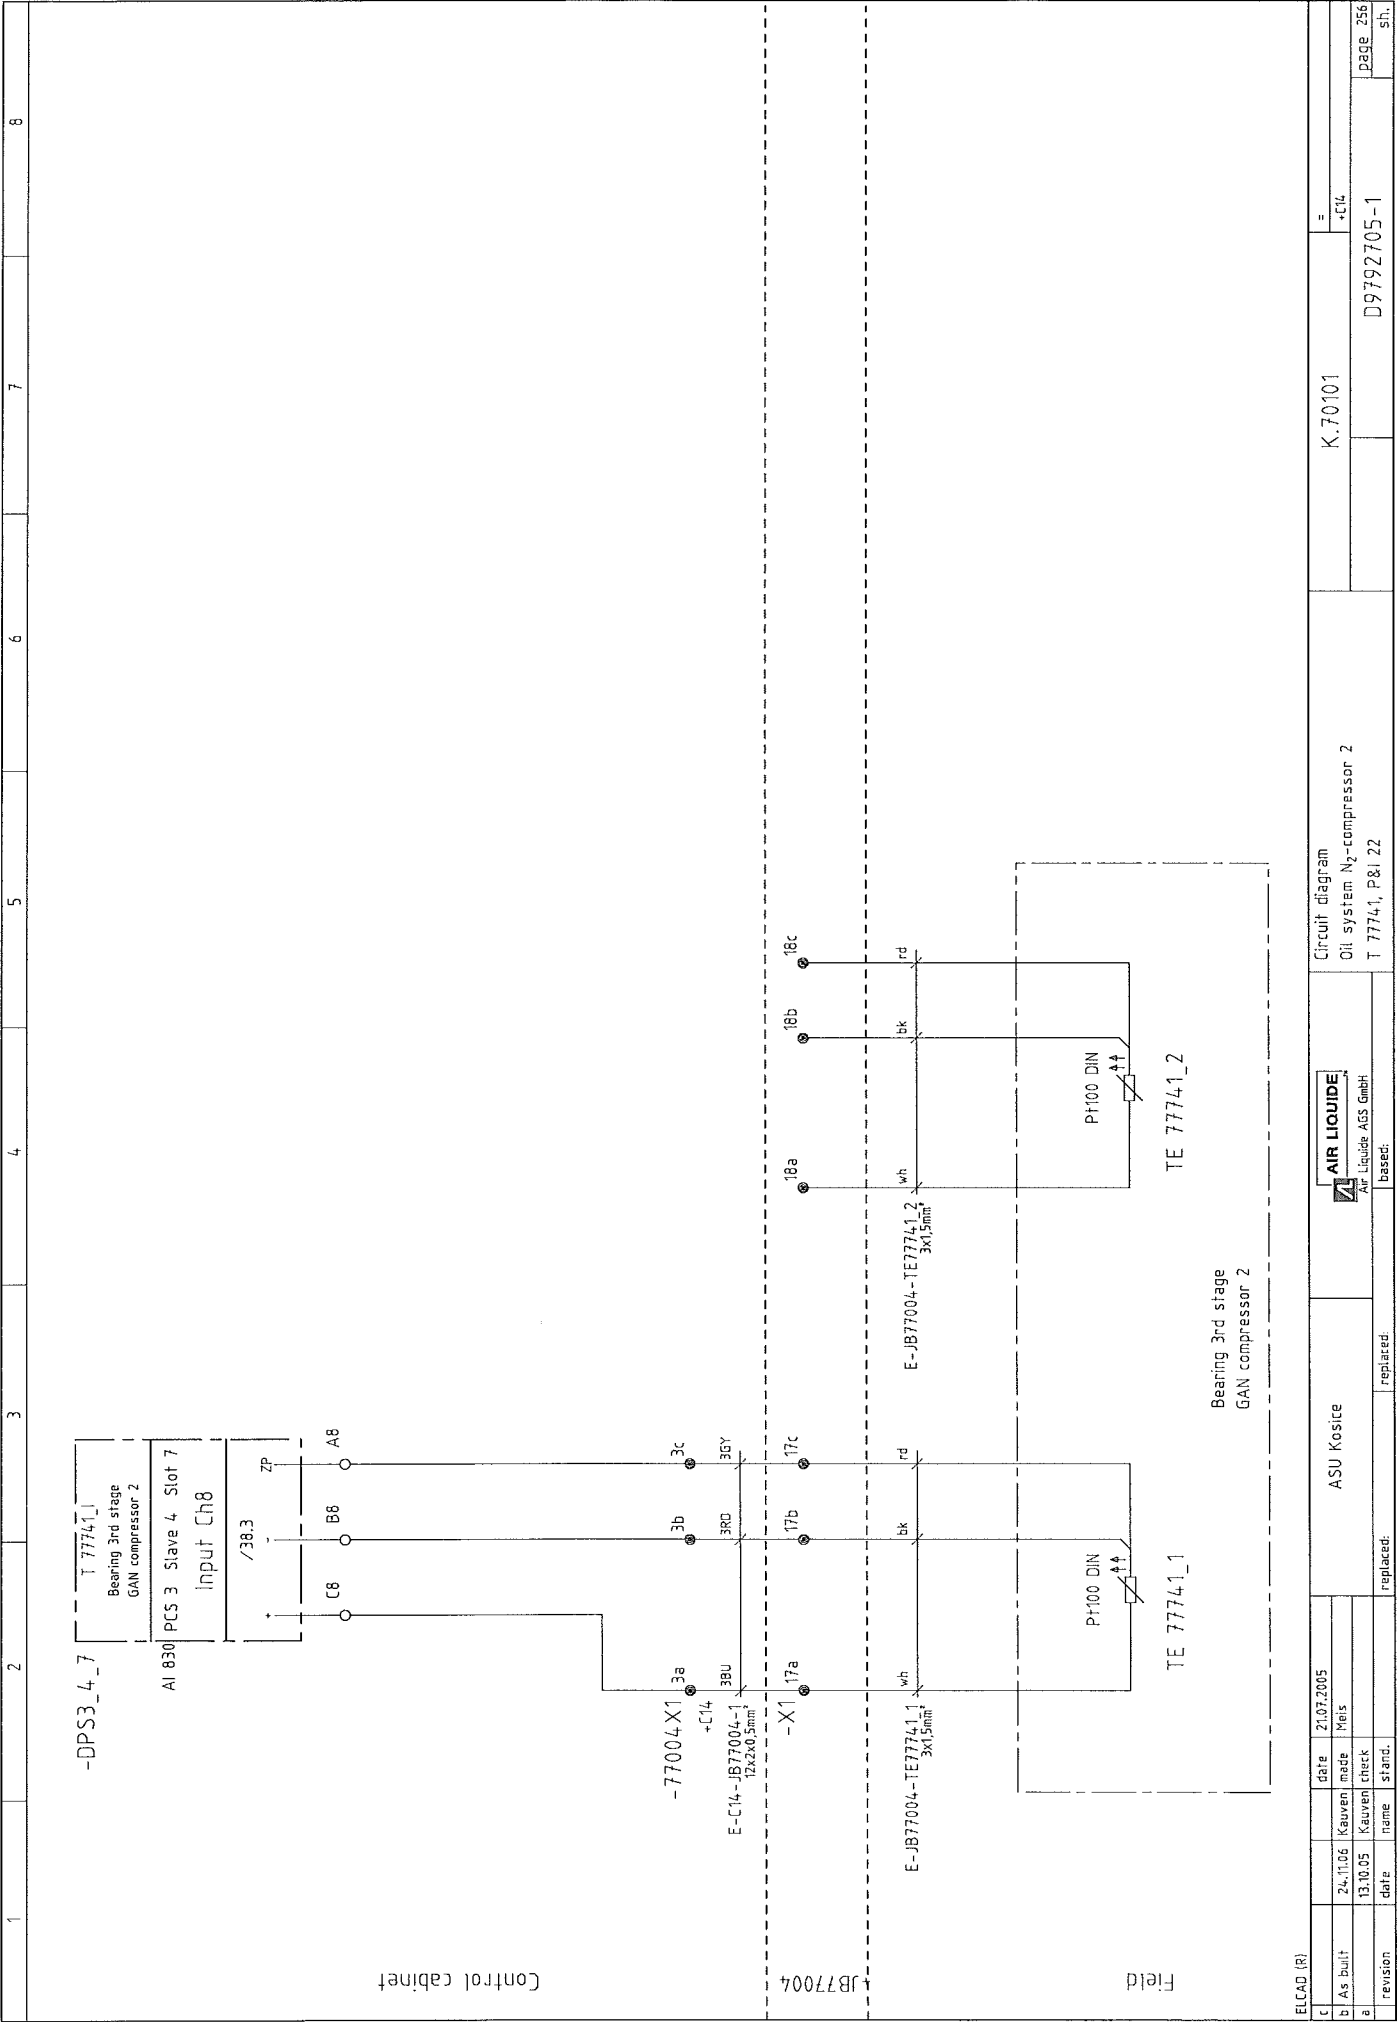

ELCAD (R)				ASU Kosice		<div><div>AIR LIQUIDE</div><div>Air Liquide AGS GmbH</div></div>		Circuit diagram		K.70101		=	
c				date	21.07.2005			Oil system N ₂ -compressor 2		+C14			
b	As built	24.11.06	Kauven	made	Mis			T 77741, P81 22					
a		13.10.05	Kauven	check								page 256	
revision				date	name	stand.	replaced:	replaced:	based:			sh.	
										D9792705-1			








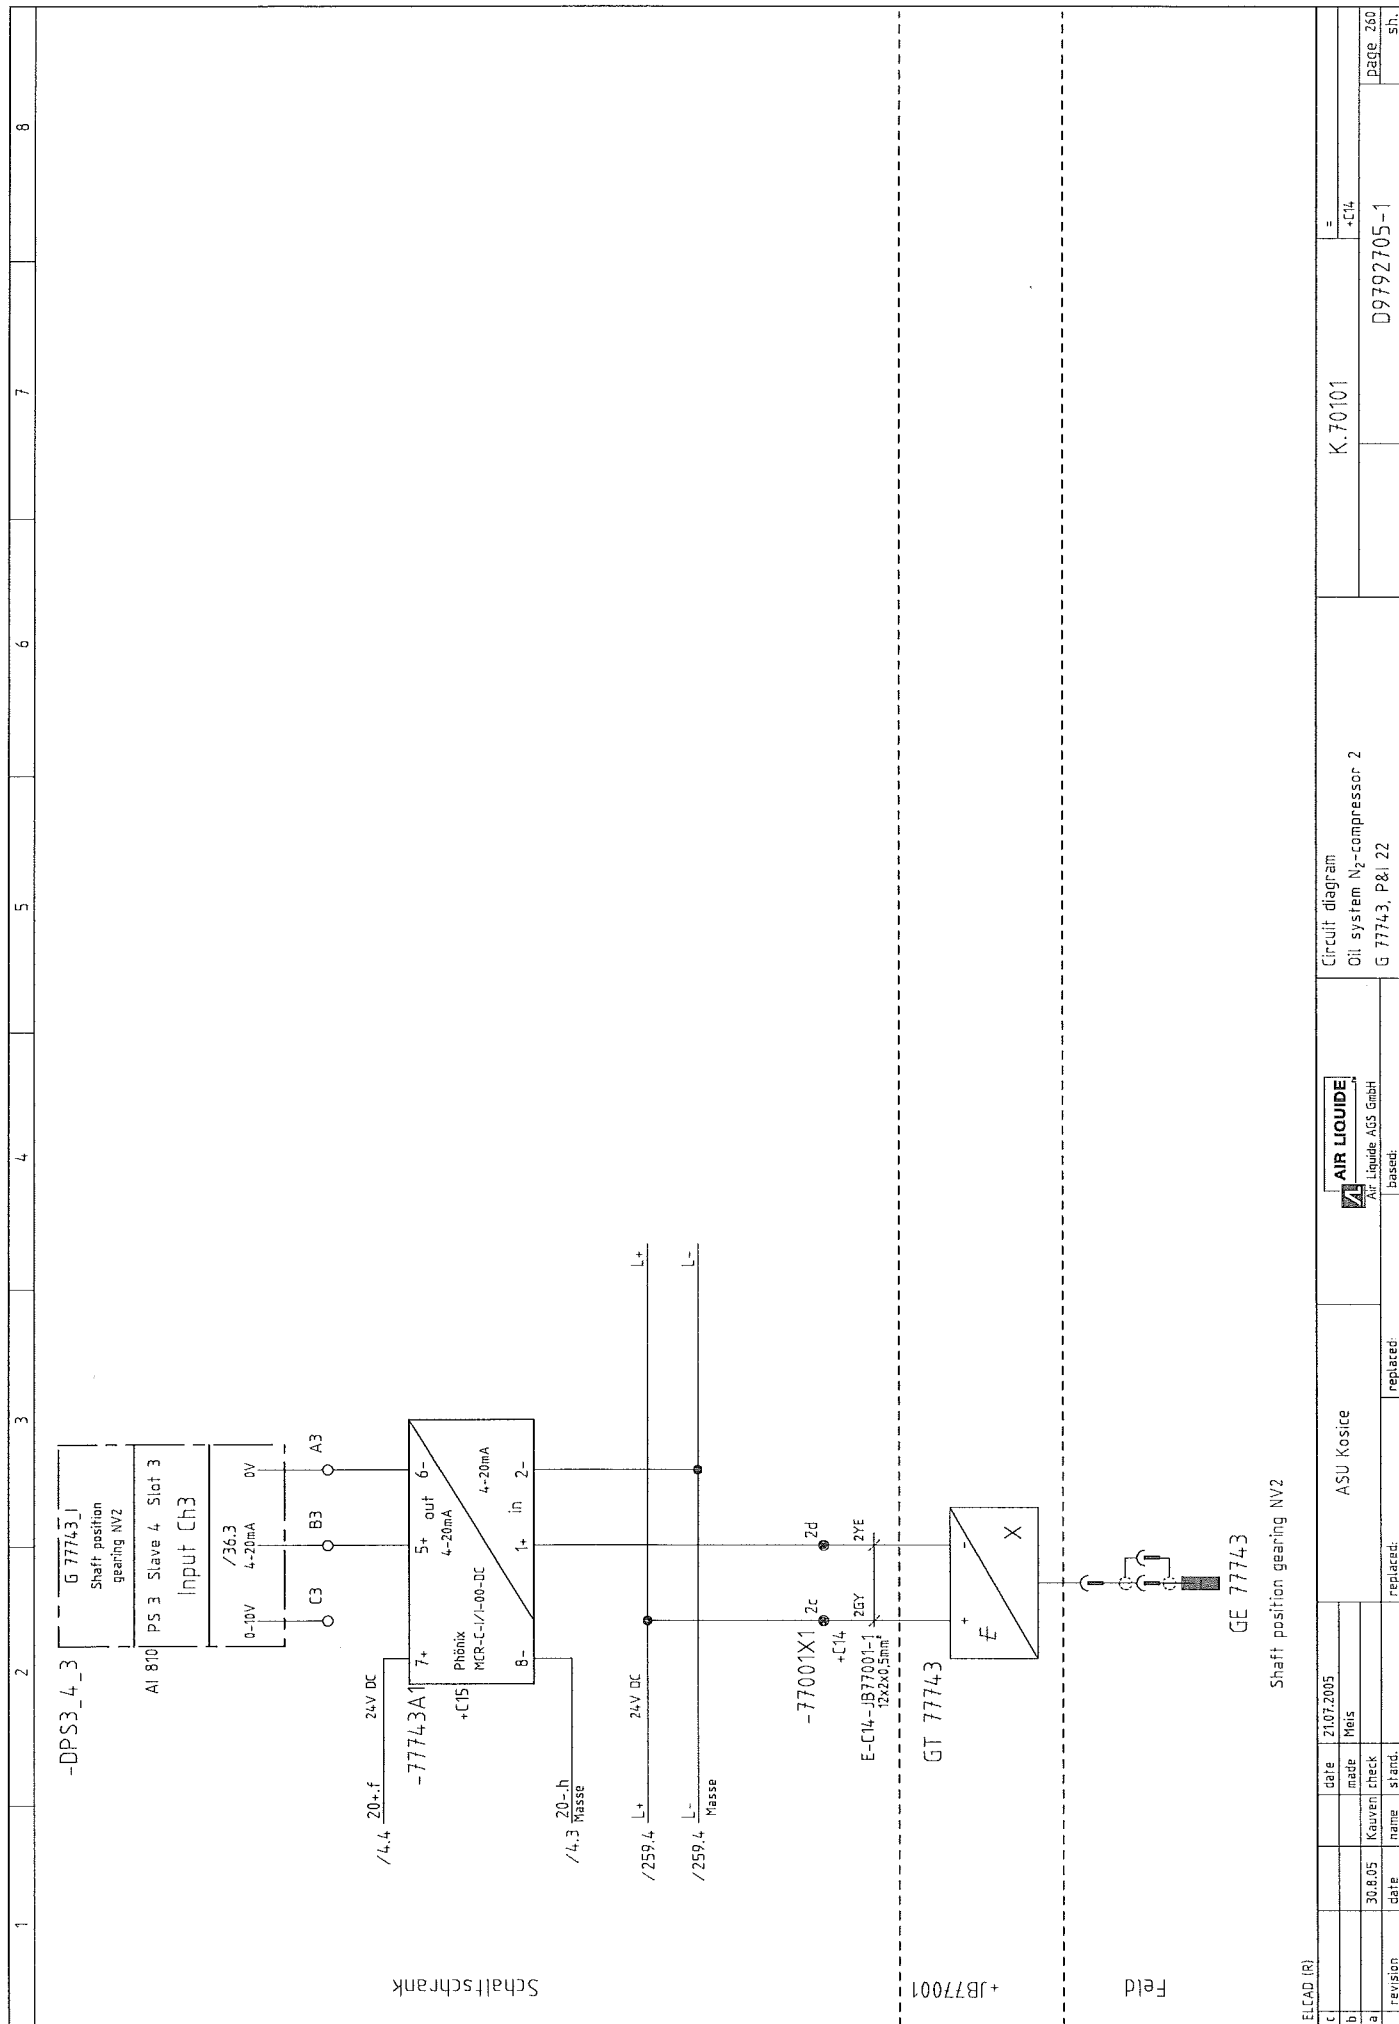







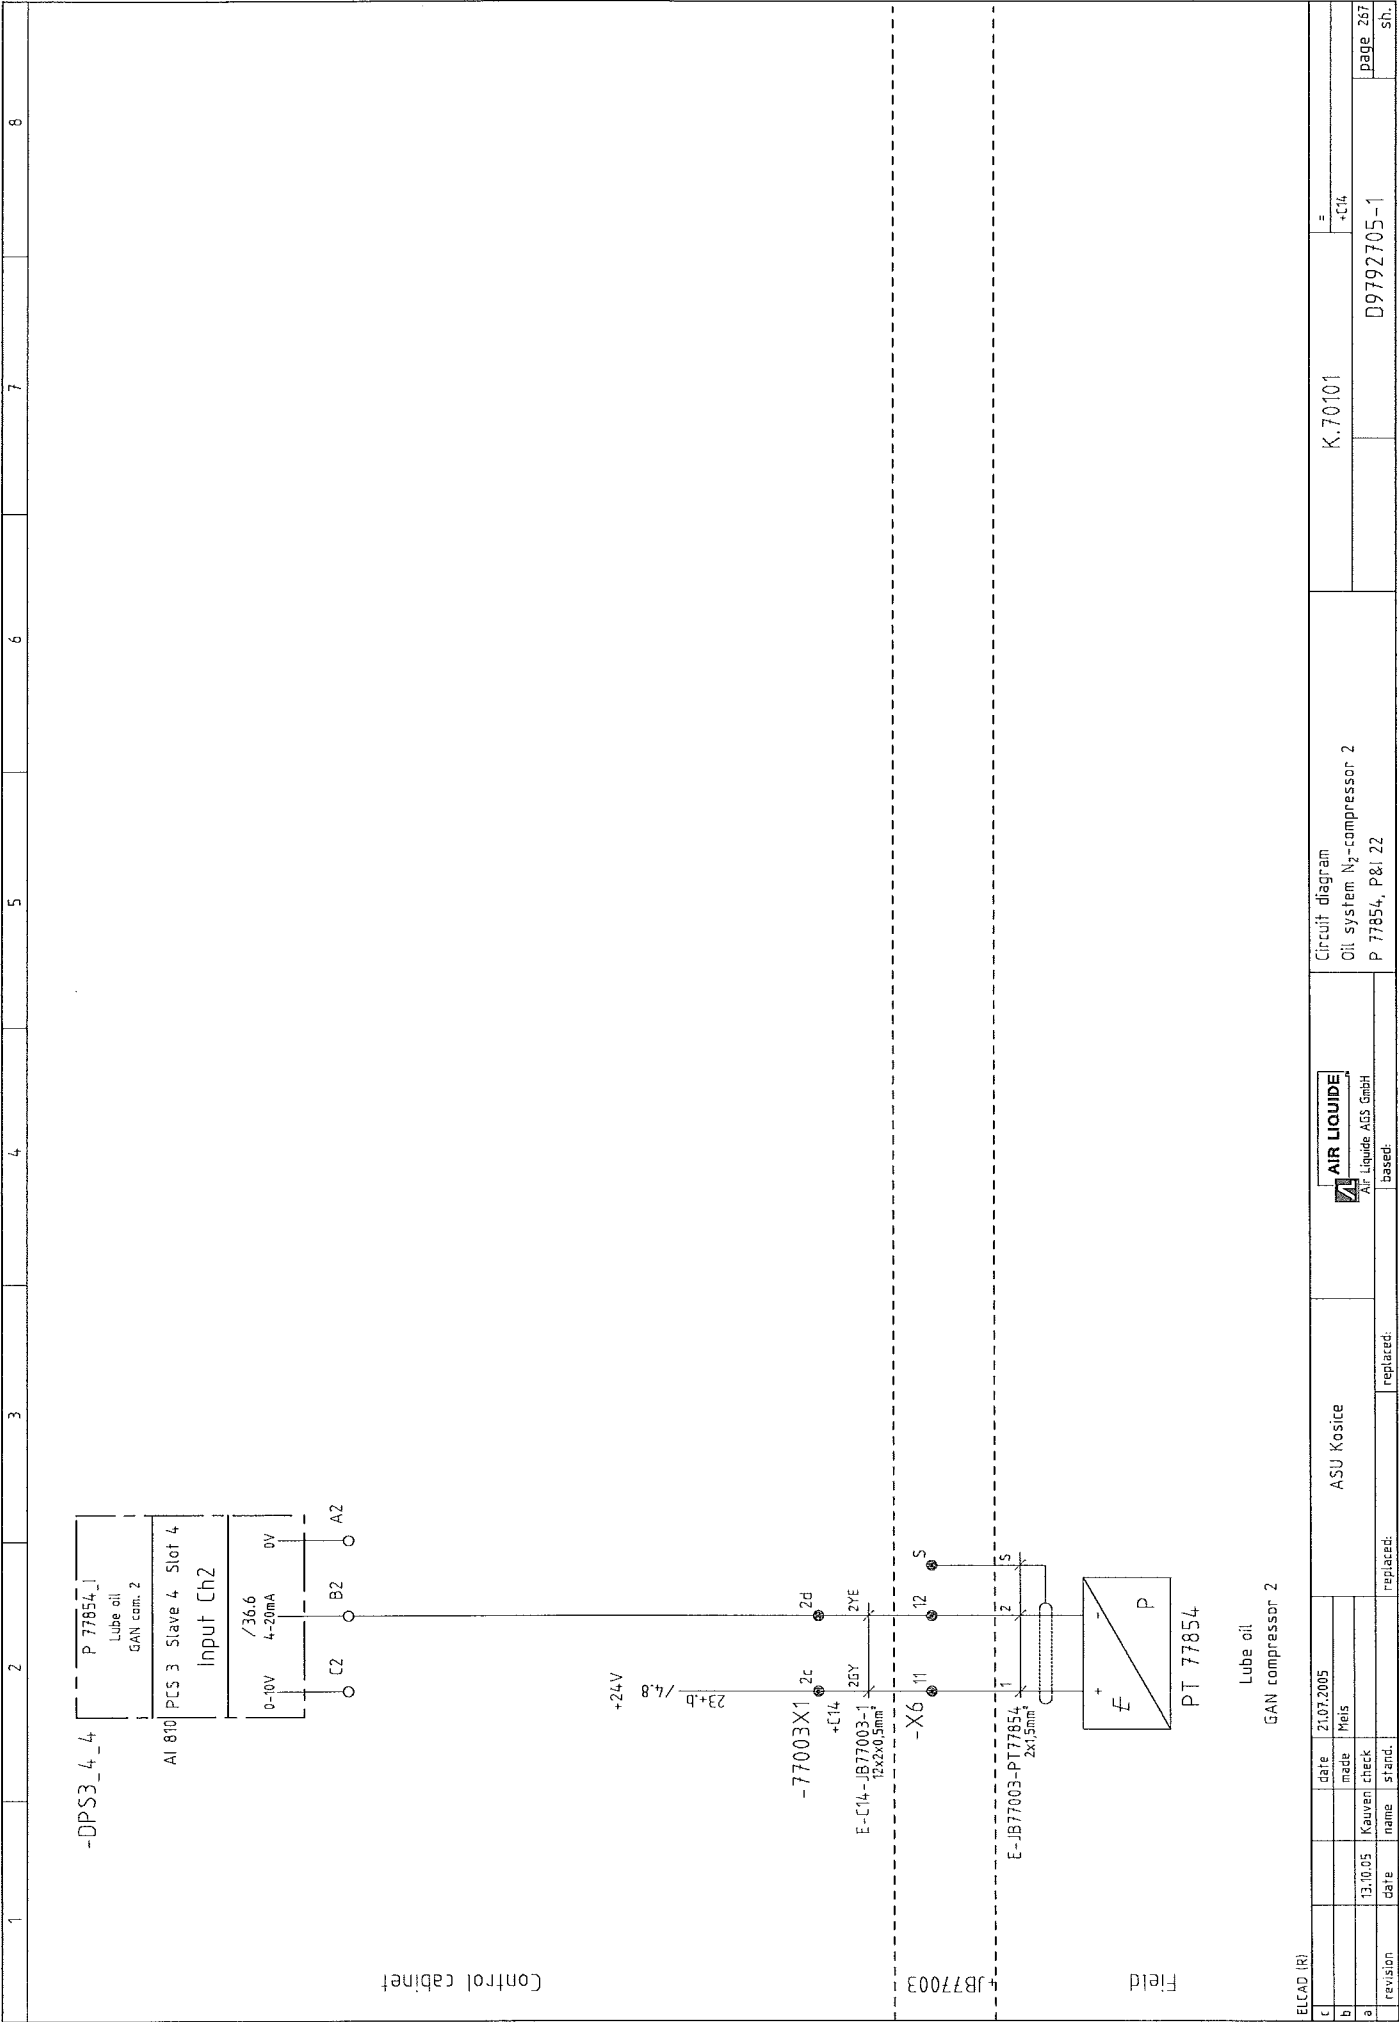

 


Field

ELCAD (R)					
c			date	21.07.2005	
b			made	MelS	
a			check		
			revision	name	stand.
			replaced:	revision	stand.
			replaced:	replaced:	
			ASU Kosice		
			 AIR LIQUIDE Air Liquide AGS GmbH		
			based:		
			Circuit diagram		
			Oil system N ₂ -compressor 2		
			K.70101	=	
				+Cl4	
					sh.

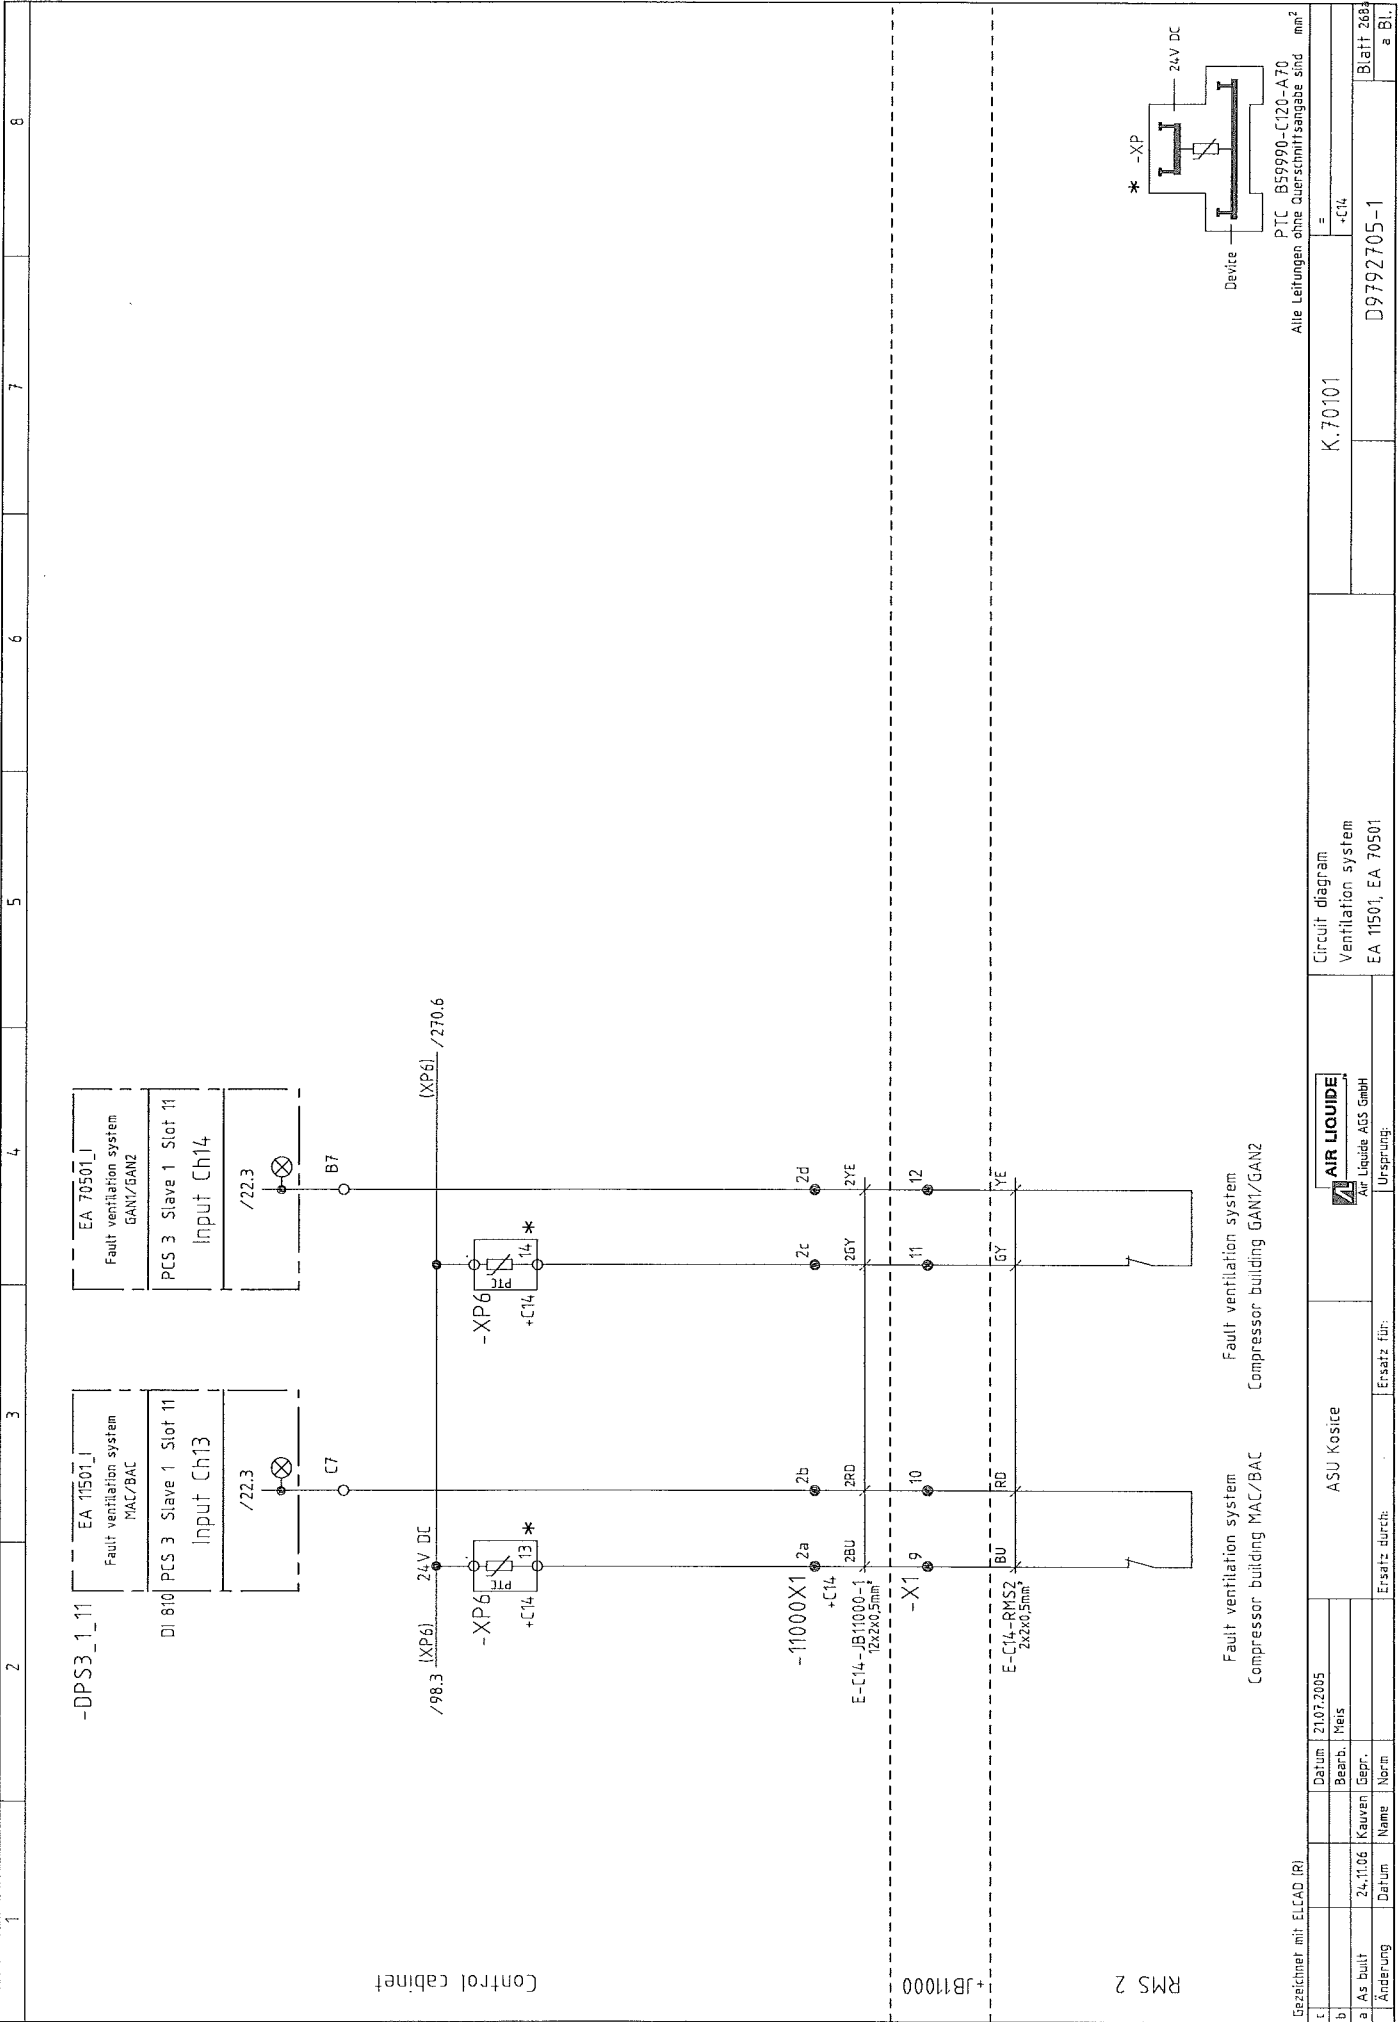

RMS 2

JB11000

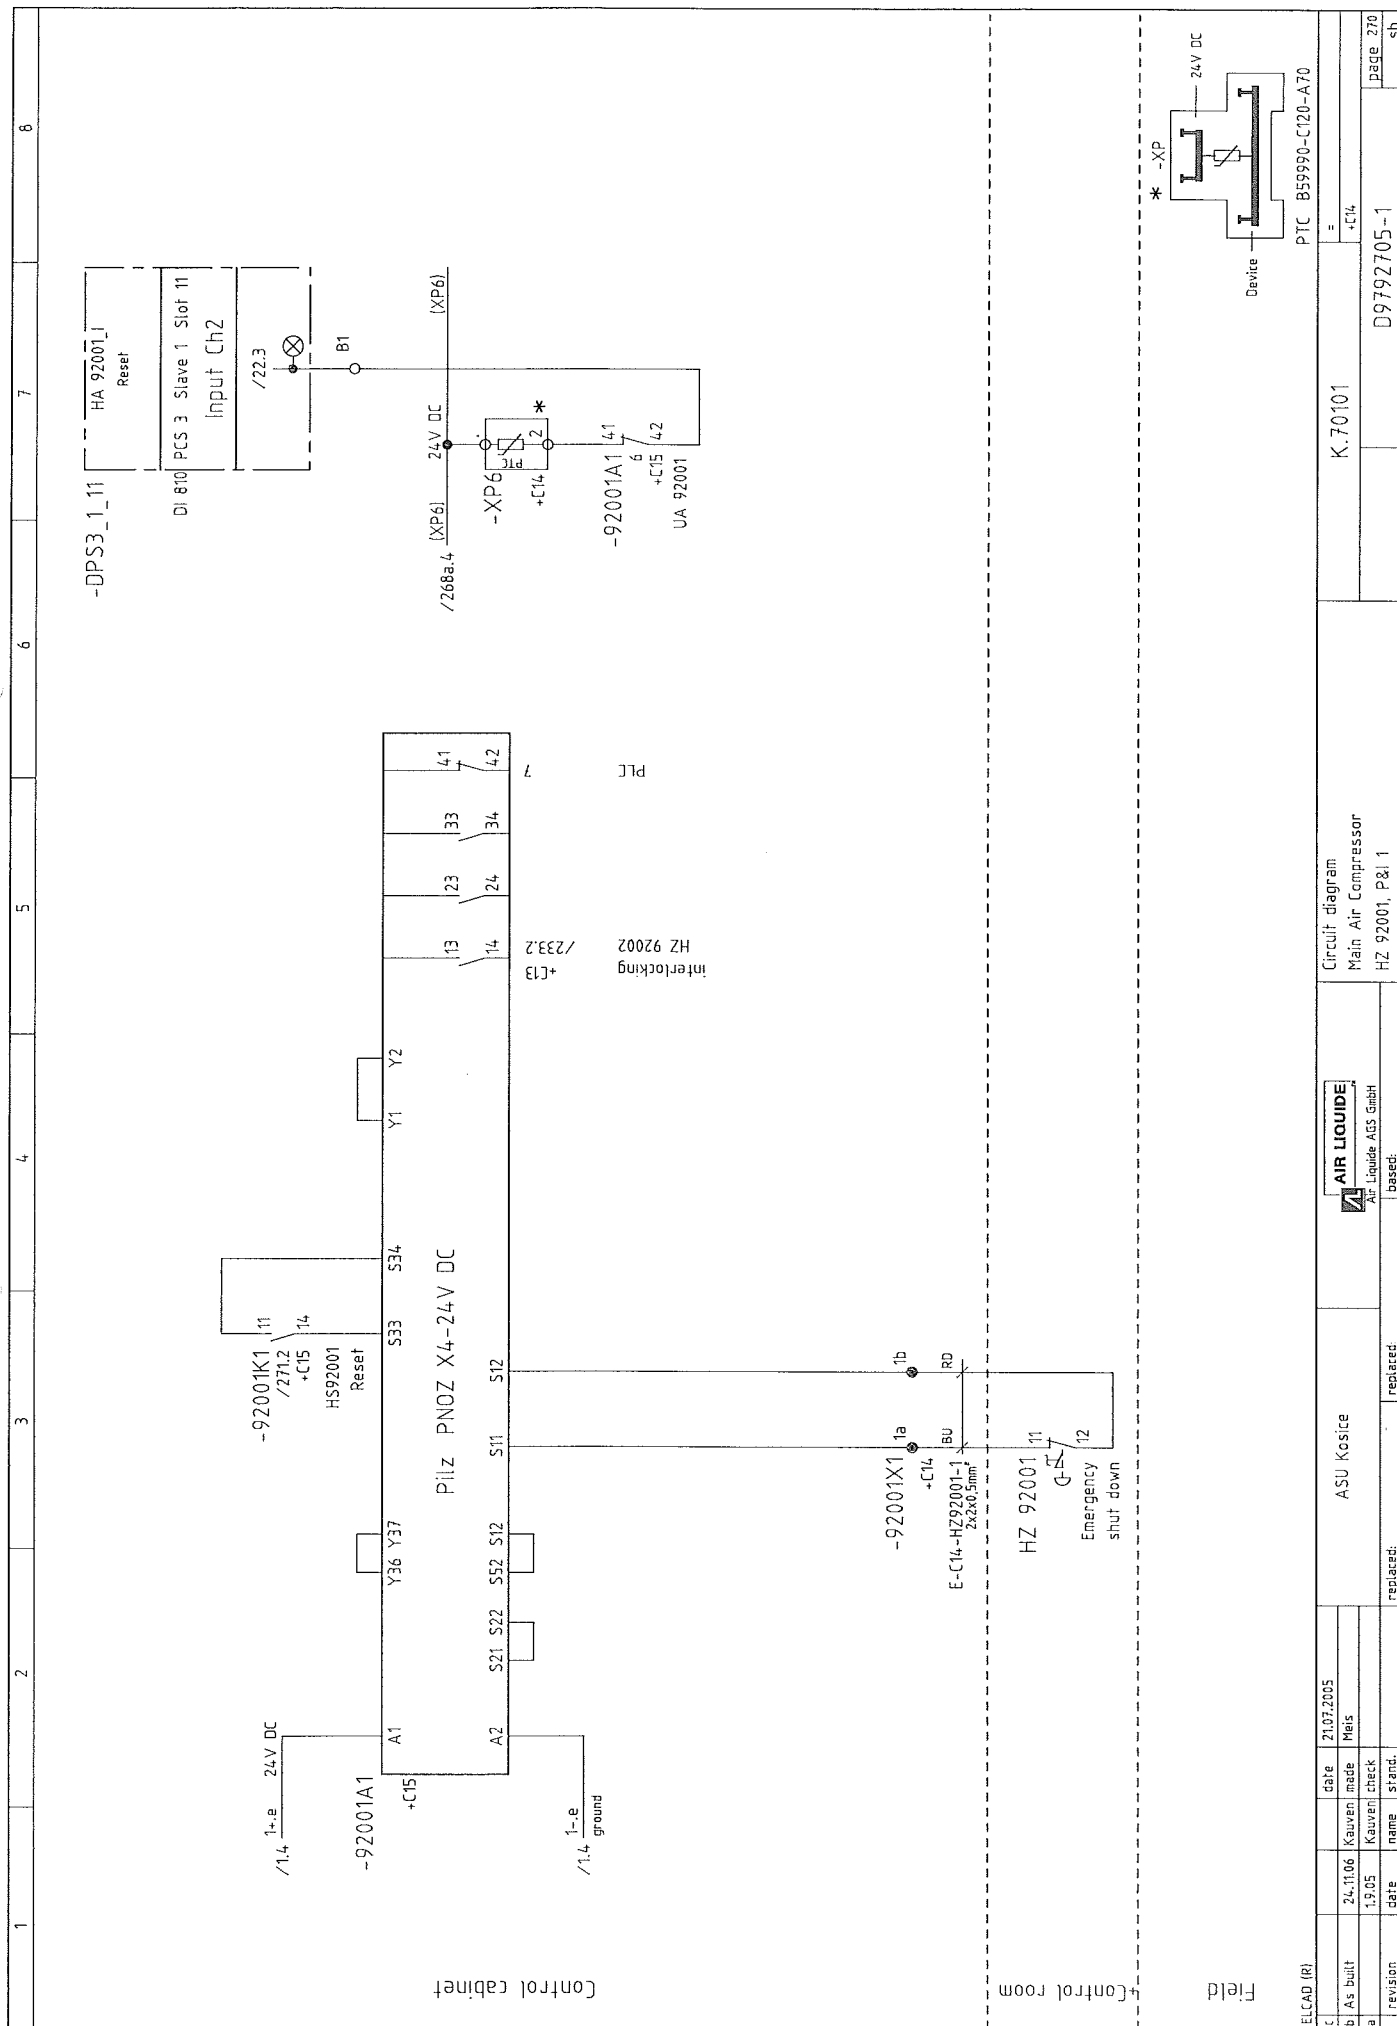

1		2		3		4		5		6		7		8	

ELCAD (R)															
c															
b															
a															
revision															

[illegible]

[illegible]

[illegible]

[illegible]

[illegible]

ELCAD (R) c b a		Date 21.07.2005 Meis	ASU Kosice replaced: replaced:		AIR LIQUIDE Air Liquide AIS GmbH based		Terminal connecting plan -1000X1		= K.70101 = 09792705-1 sh.		page 281 sh.																																		
Kabelbezeichnung / wiring marking		device comments		Strip: -11000X1 total 24 terminals		1a 2b 3c 4d 5e 6f 7g 8h 9a 10b 11c 12d 13e 14f 15g 16h 17a 18b 19c 20d 21e 22f 23g 24h		1a 2b 3c 4d 5e 6f 7g 8h 9a 10b 11c 12d 13e 14f 15g 16h 17a 18b 19c 20d 21e 22f 23g 24h		1a 2b 3c 4d 5e 6f 7g 8h 9a 10b 11c 12d 13e 14f 15g 16h 17a 18b 19c 20d 21e 22f 23g 24h		1a 2b 3c 4d 5e 6f 7g 8h 9a 10b 11c 12d 13e 14f 

ELCAD (R)		Date 21.07.2005		ASU Kosice		AIR LIQUIDE Air Liquide ASS GmbH I based:		Terminal connecting plan		K.70101		= +C14		D9792705-1		page 283 sh.	
