KOTVENIE – ANCHORING

M1:100
M1:50

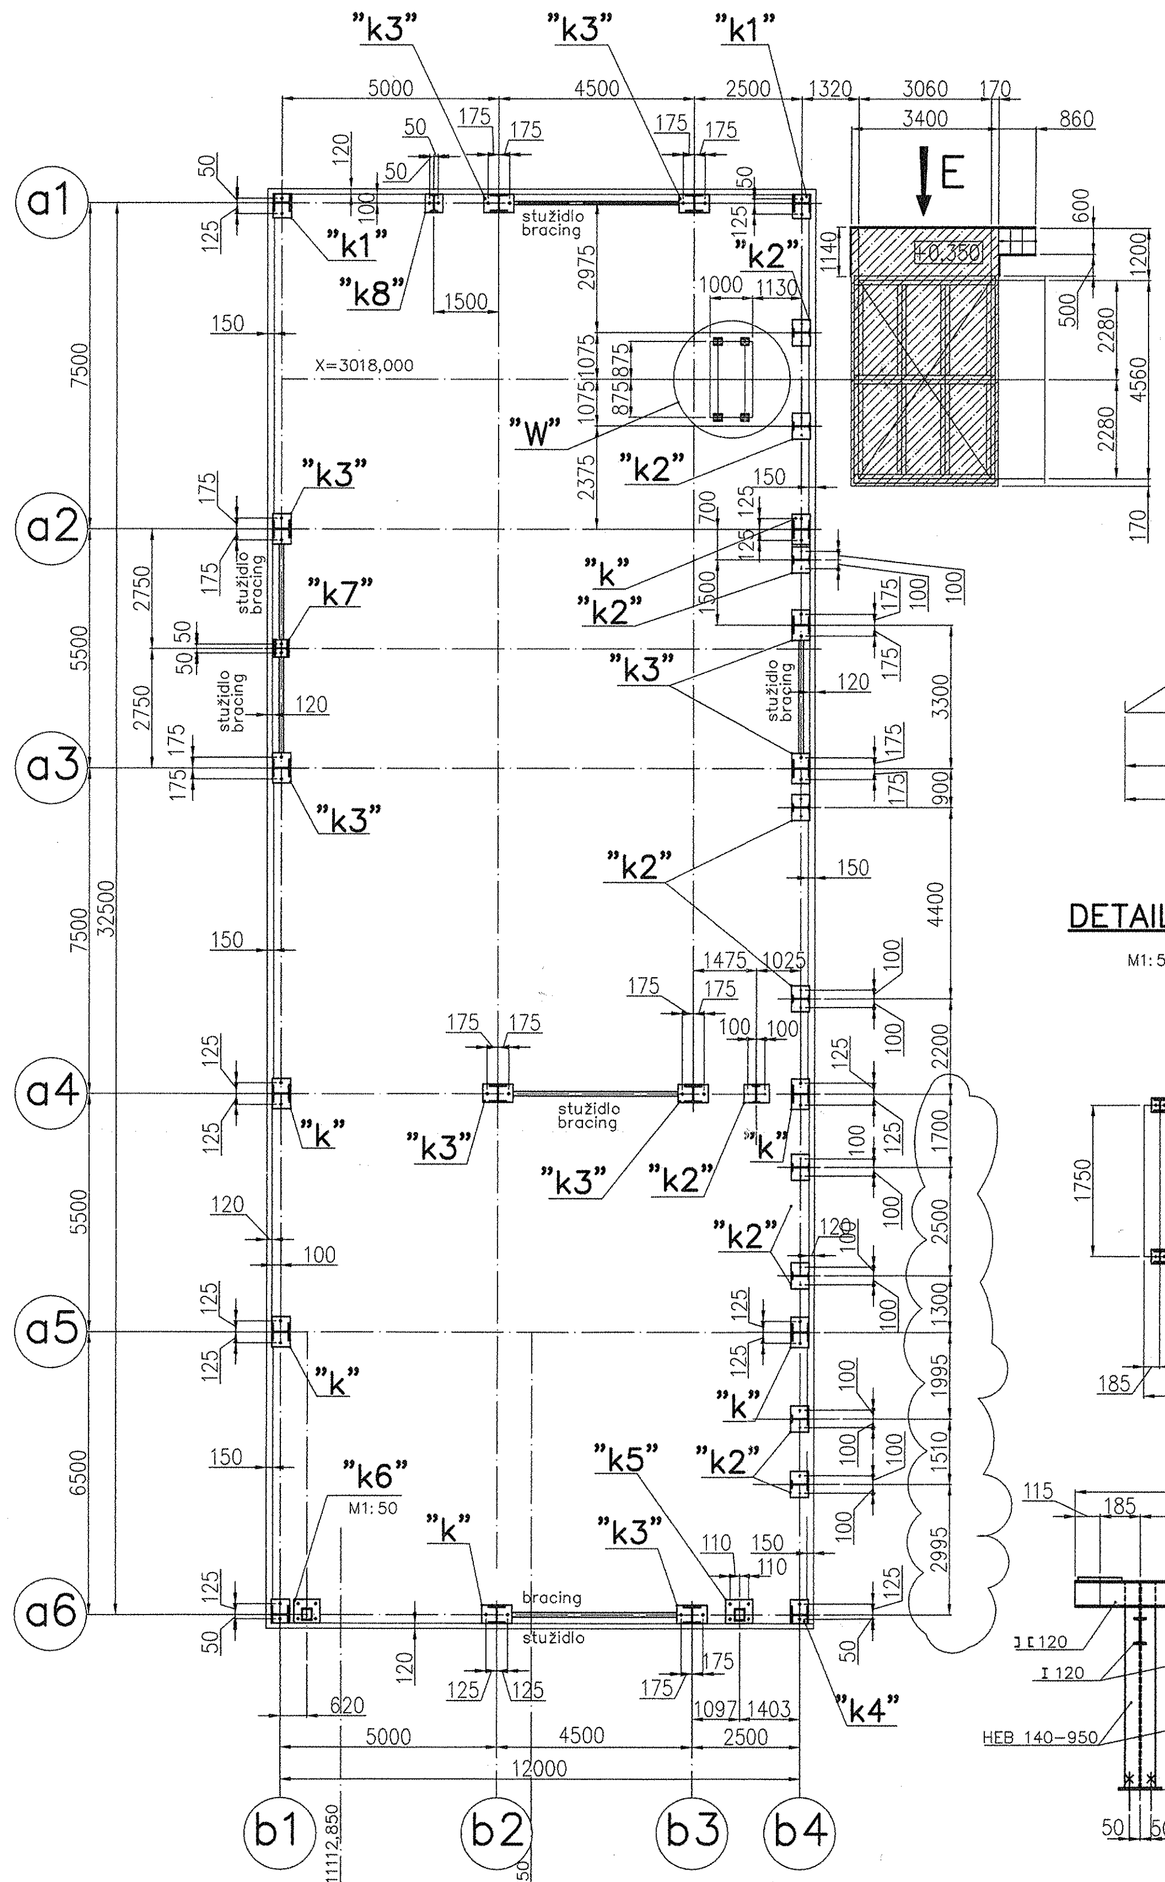

VIEW E

M1:50

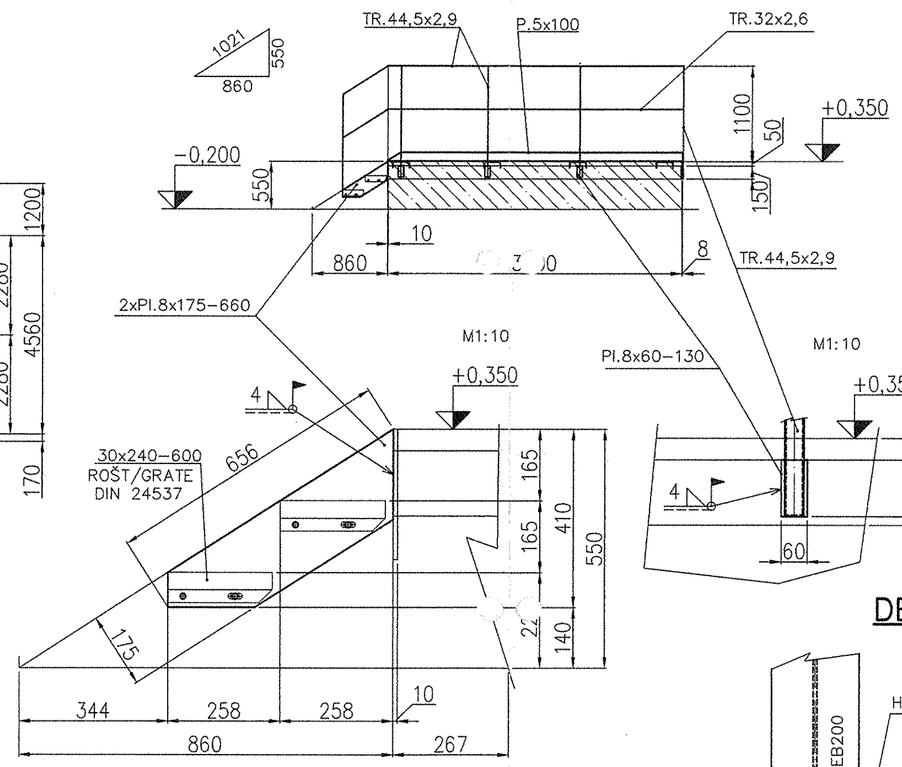

DETAIL "k2"

M1:10

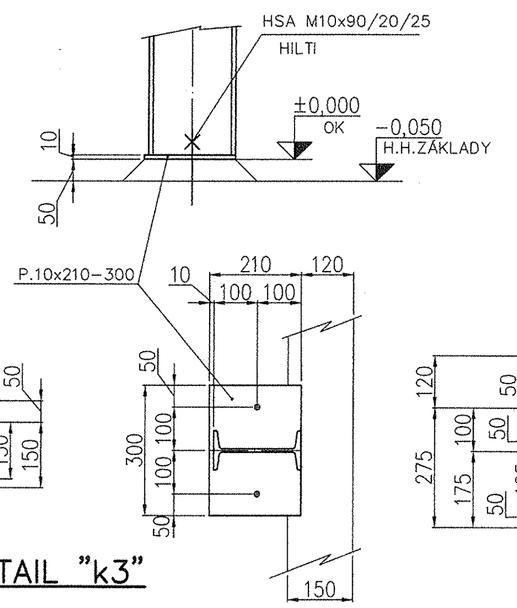

DETAIL "k1"

M1:10

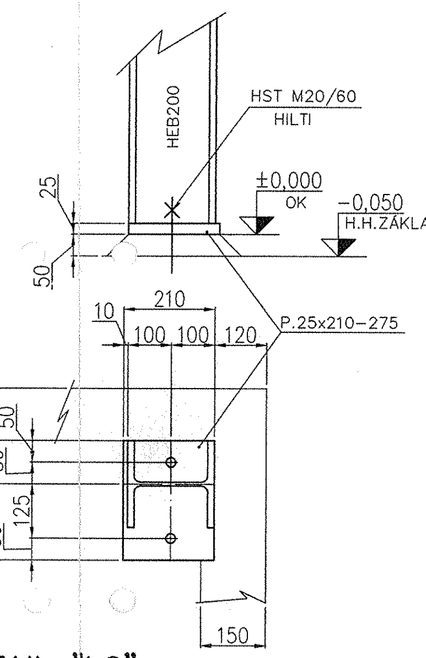

DETAIL "k"

M1:10

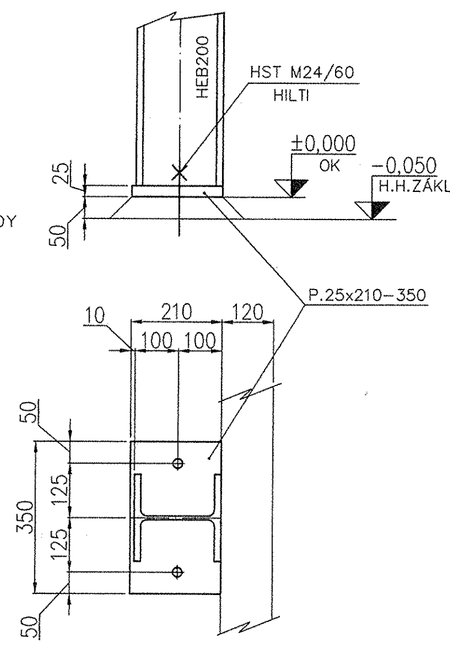

DETAIL "k3"

M1:10

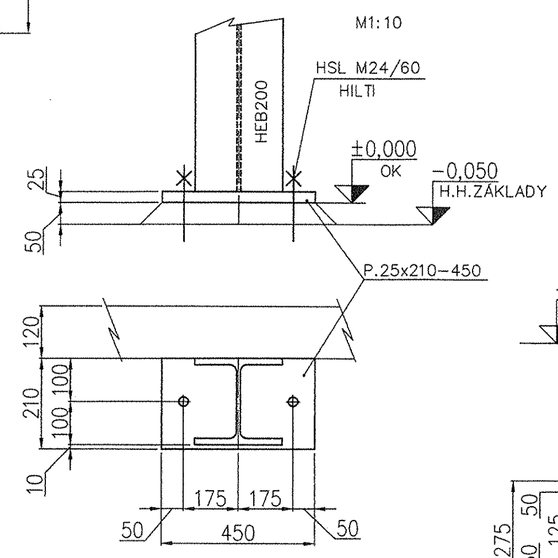

DETAIL "k6"

M1:10

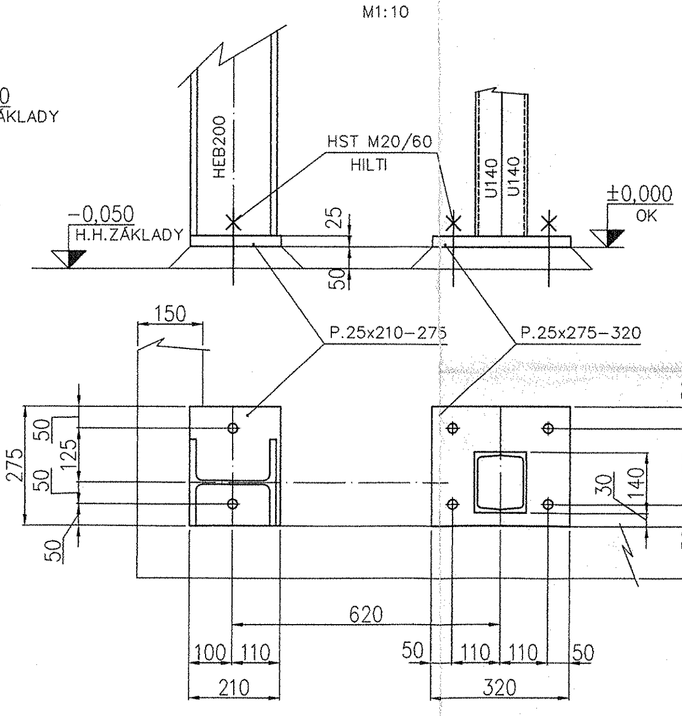

DETAIL "k5"

M1:10

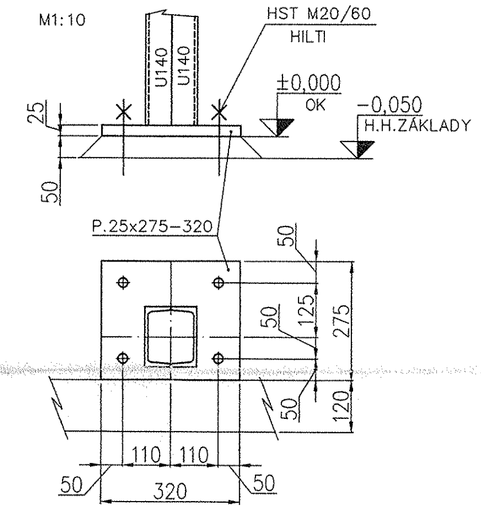

DETAIL "W"

M1:50

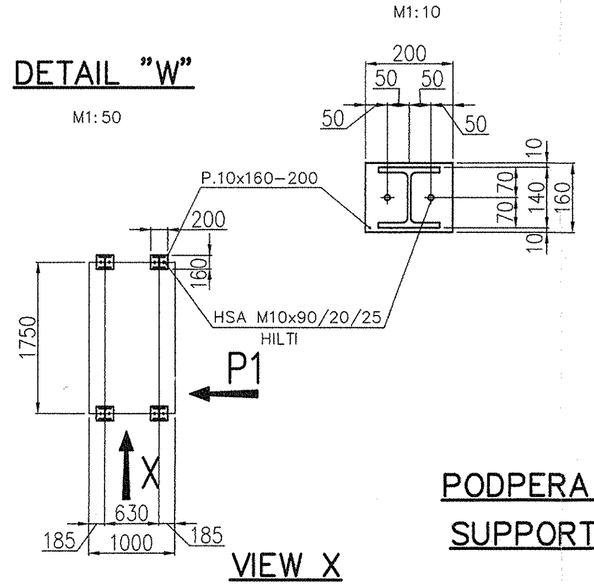

VIEW X

M1:20

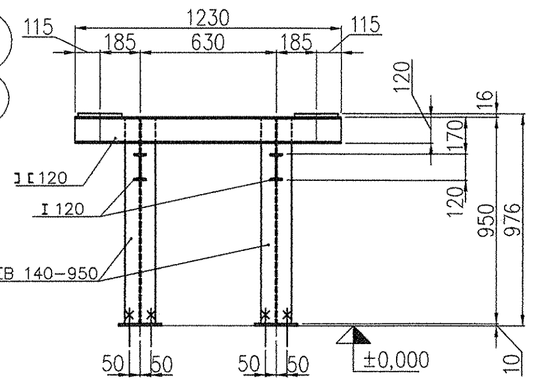

PODPERA PRE TLMIČ
SUPPORT FOR MAC SUCTION SILENCER

M1:20

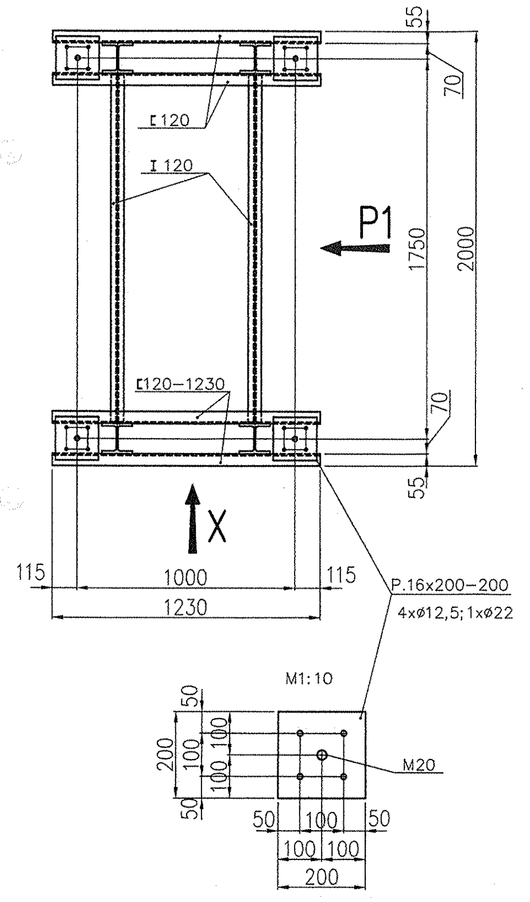

DETAIL "k4"

M1:10

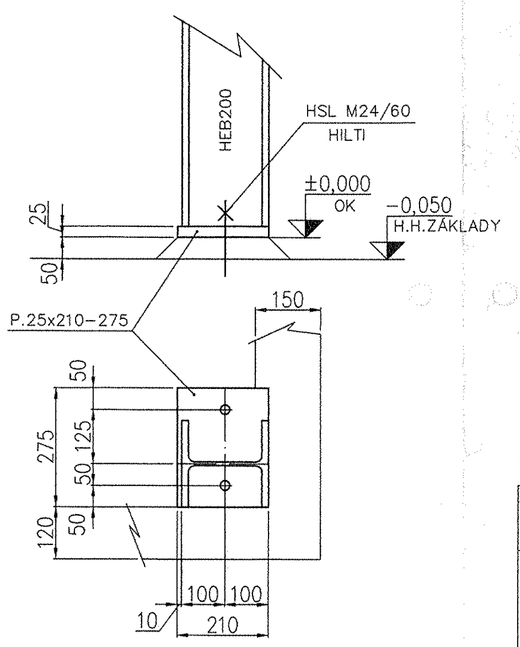

DETAIL "k7"

M1:10

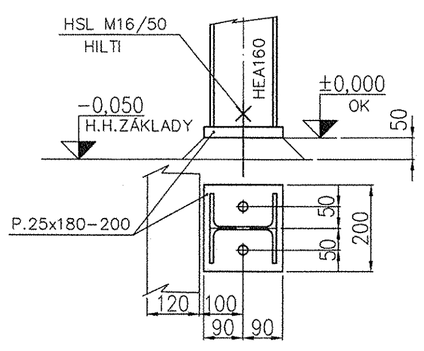

DETAIL "k8"

M1:10

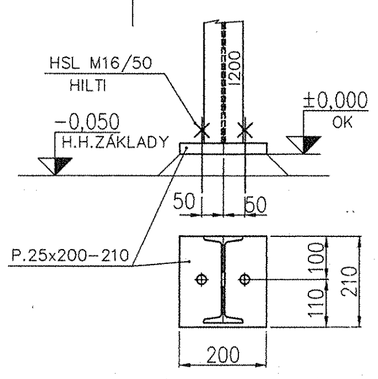

VIEW P1

M1:20

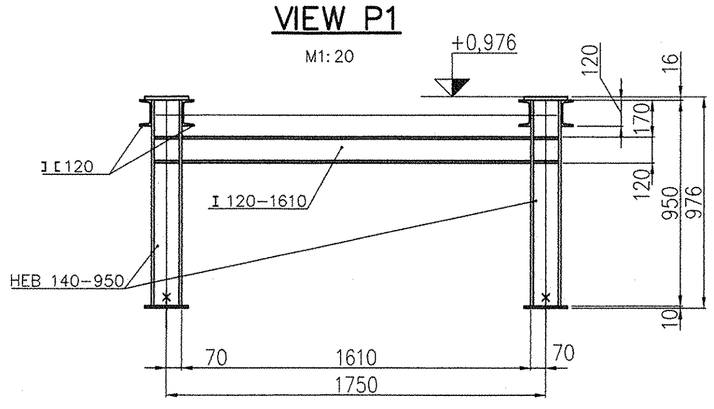

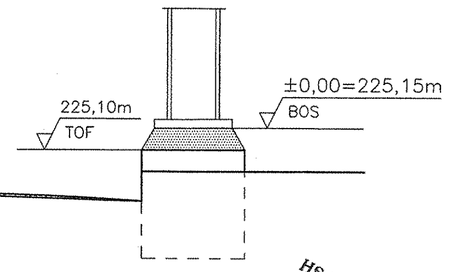

HS HSV s.r.o. KOŠICE
Technický úsek

LEVELS

TOP OF INTERNAL ROADS:	225,00m
TOP OF FOUNDATION:	225,10m
BOTTOM OF STEEL STRUCTURE OR EQUIPMENT:	225,15m = ±0,00

PROJEKT SKUTOČNÉHO VYHOTOVENIA

FREIGABE
FOR CONSTRUCTION
Re 04.08.05

PLANT NORTH
35°

±0,000=225,15 m n. m. Jadran

PROJEKT PRE REALIZÁCIU STAVBY POD z. č. 3821.2.002.0K–03

REV	DATE	NAME	CHECKED	HISTORY FILE
B	03.08.2005	ING.ĎURAŠKOVÁ	ING.PAVLIČKO	POLOHA STĹPOV/ COLUMNS POSITION
A	25.07.2005	ING.ĎURAŠKOVÁ	ING.PAVLIČKO	REAL. PROJ./CONSTRUCTION DESIGN
0	14.02.2005	ING.ĎURAŠKOVÁ	ING.PAVLIČKO	TENDR.DOK./TENDER DOCUMENTATION

HPK engineering a.s.

AIR LIQUIDE

JOB CODE: K70101
REFERENCE: ASU No.9 KOŠICE

SCALE 1:100 | ORIGINAL FORMAT A1
SHEET: 002 | OF 002 SHEETS

REPLACES: 79_____
REPLACED BY: 79_____

TITLE: UNIT 1 –COMPRESSOR BUILDING
SO 002 KOMPRESOROVÁ STANICA
SO 002 COMPRESSOR BUILDING
KOTVENIE / ANCHORING

DRAWING NO.: 792.87450 | REV. B

This drawing is protected by copyright.
It may not be copied or used without our written authorization and it is strictly prohibited to disclose it to any third parties.