


This drawing is protected by copyright.
It may not be copied or used without our written
authorization and it is strictly prohibited
to disclose it to any third parties.

PODORYS
ZAKLADOV

M = 1 : 100

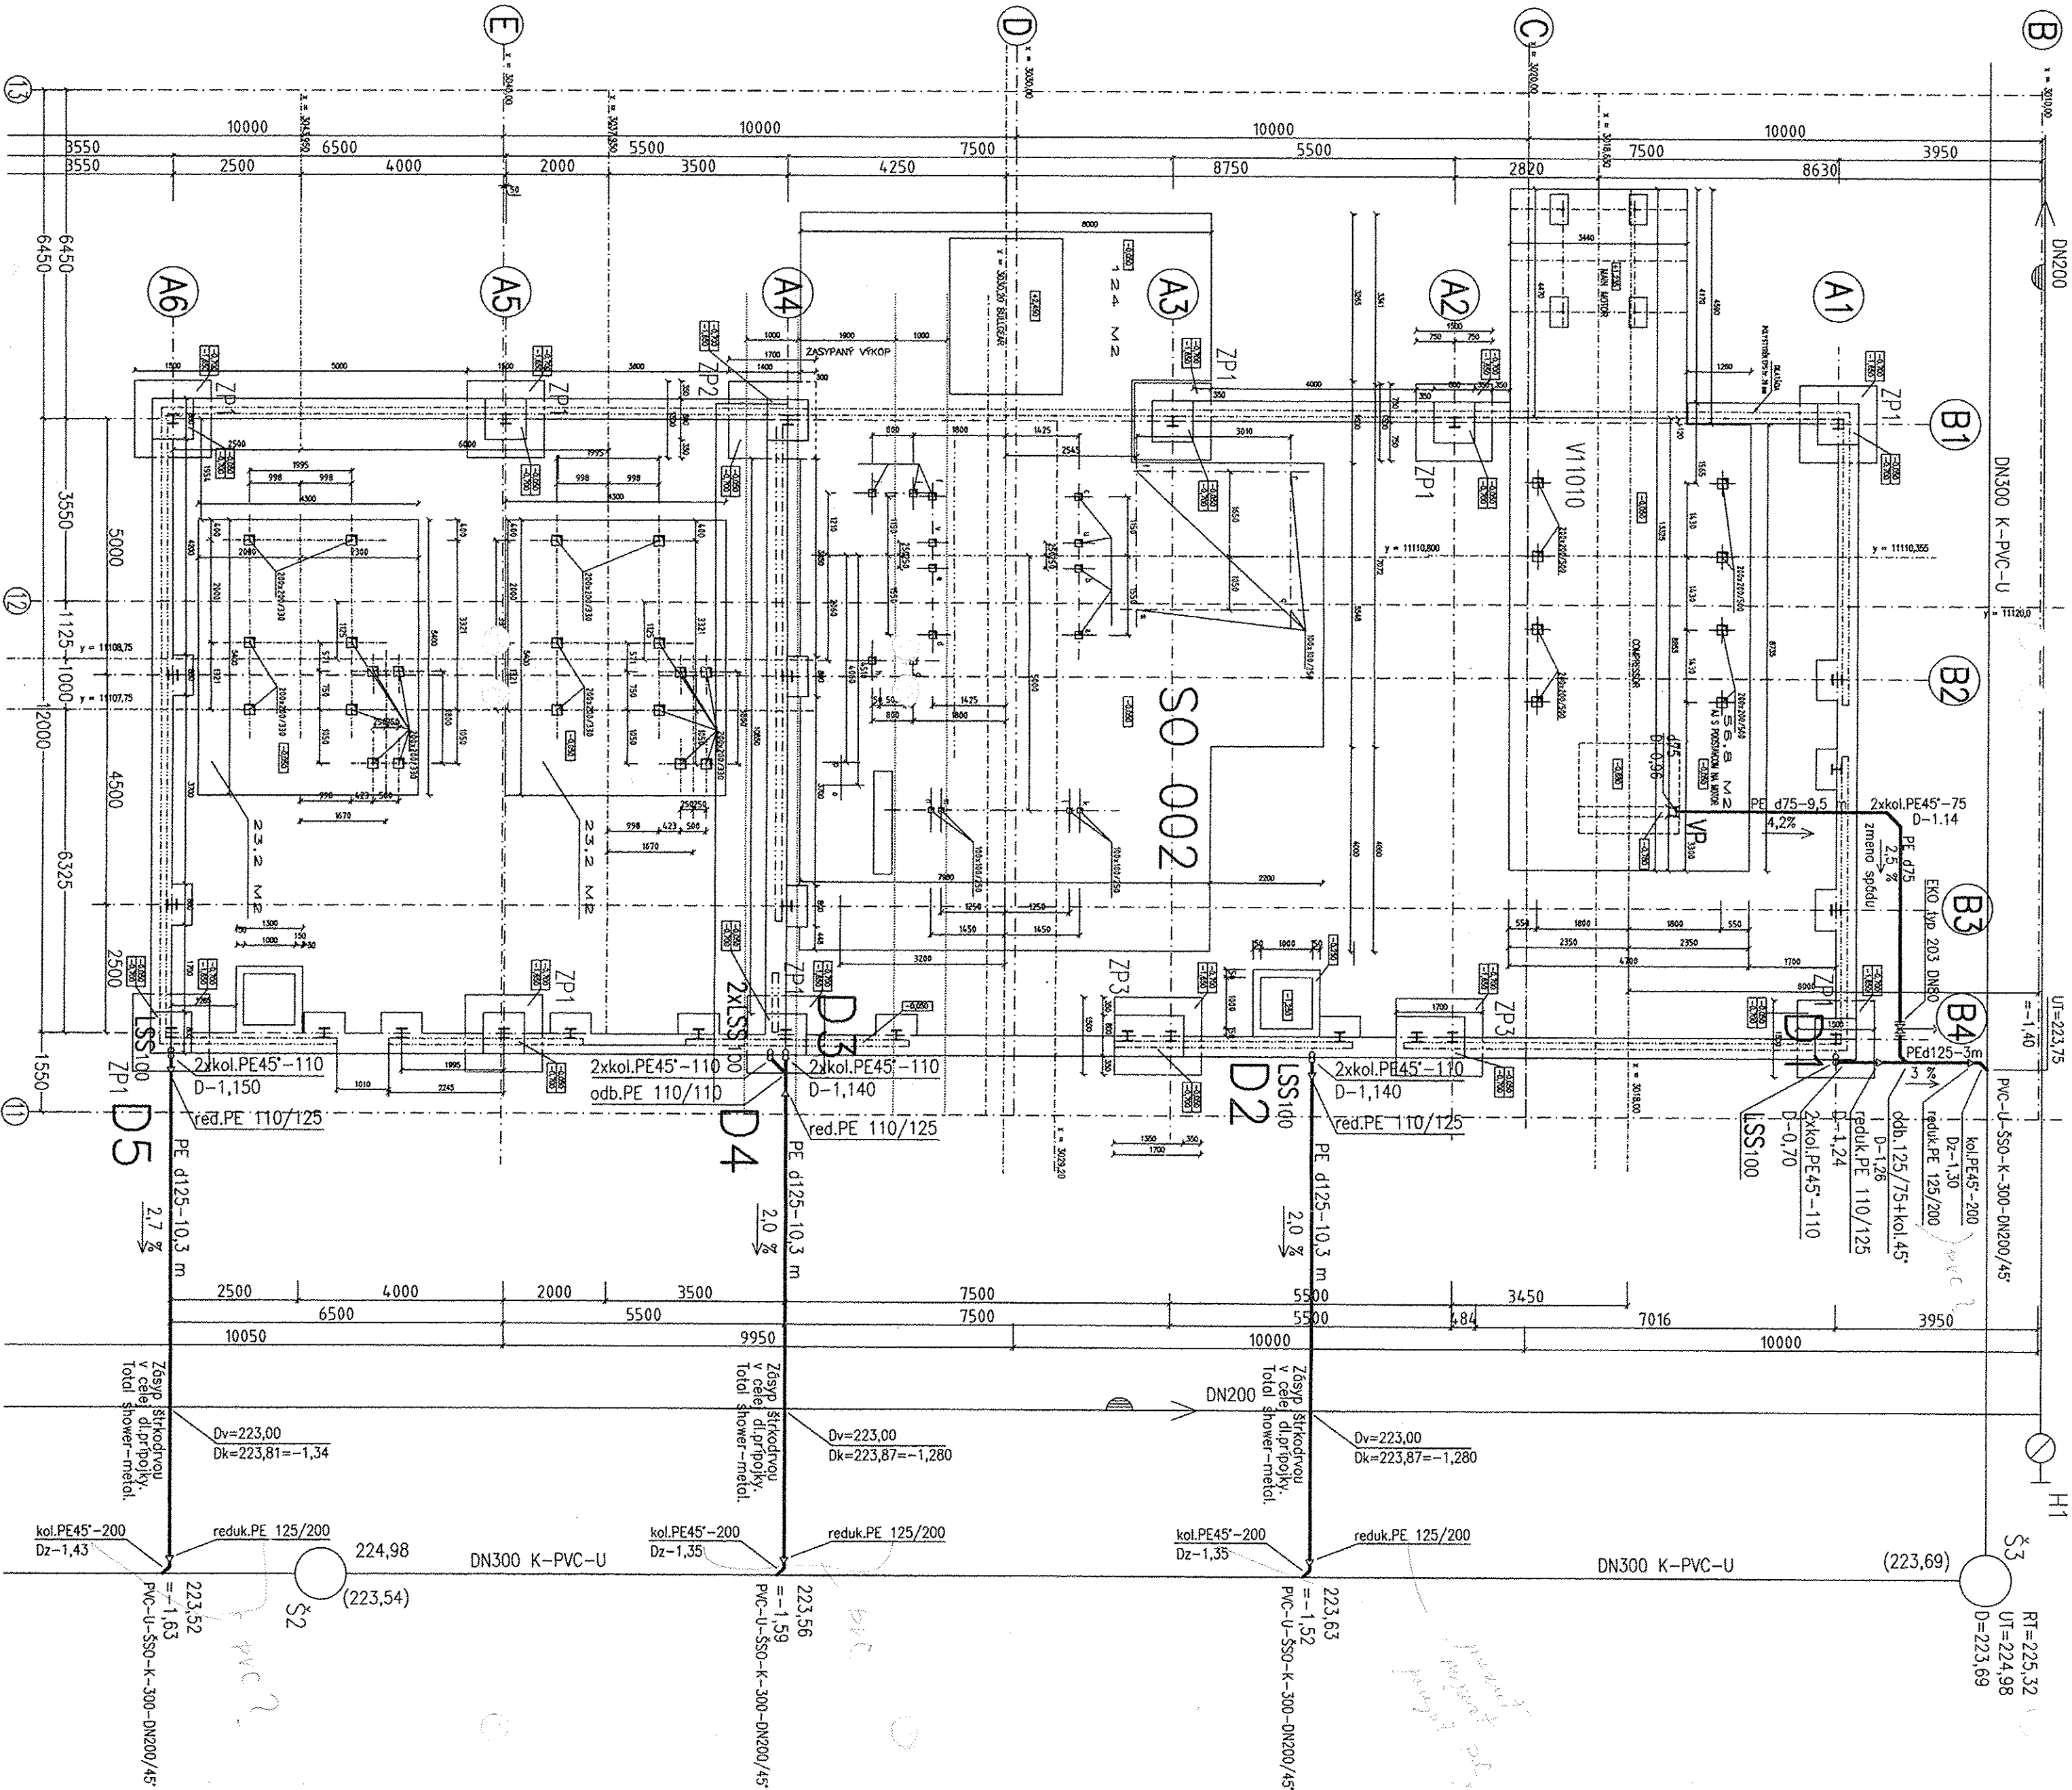

LEGENDA

LSS


LAPAČ STREŠNÝCH SPLAVENÍN S KOŠOM PRE ZACHYTÁVANIE, ODTOK S OTÁČAVÝM
GULOVÝM KLBOOM OD 0-90°, SUCHÁ A NEZAMRZNÁ KLAPKA PROTI ZAPACHU, HL600
D 110, 360 l/min.
RAIN WATER HOPPER, 0-90° ADJUSTABLE BALL-JOINT OUTLET, WITH FROST-PROOF
FLAP VALVE, INSPECTION COVER AND LEAF BASKET.

VP

PODLAHOVÝ VPUSŤ HL 72,1N DN75/110 90l/min.
FLOOR DRAIN WITH INSULATING DN75/110 90 l/min.

POTRUBIE Z PE
PE PIPE

ZVISLÁ SCHEMA M=1:100
VERTICAL SCHEME

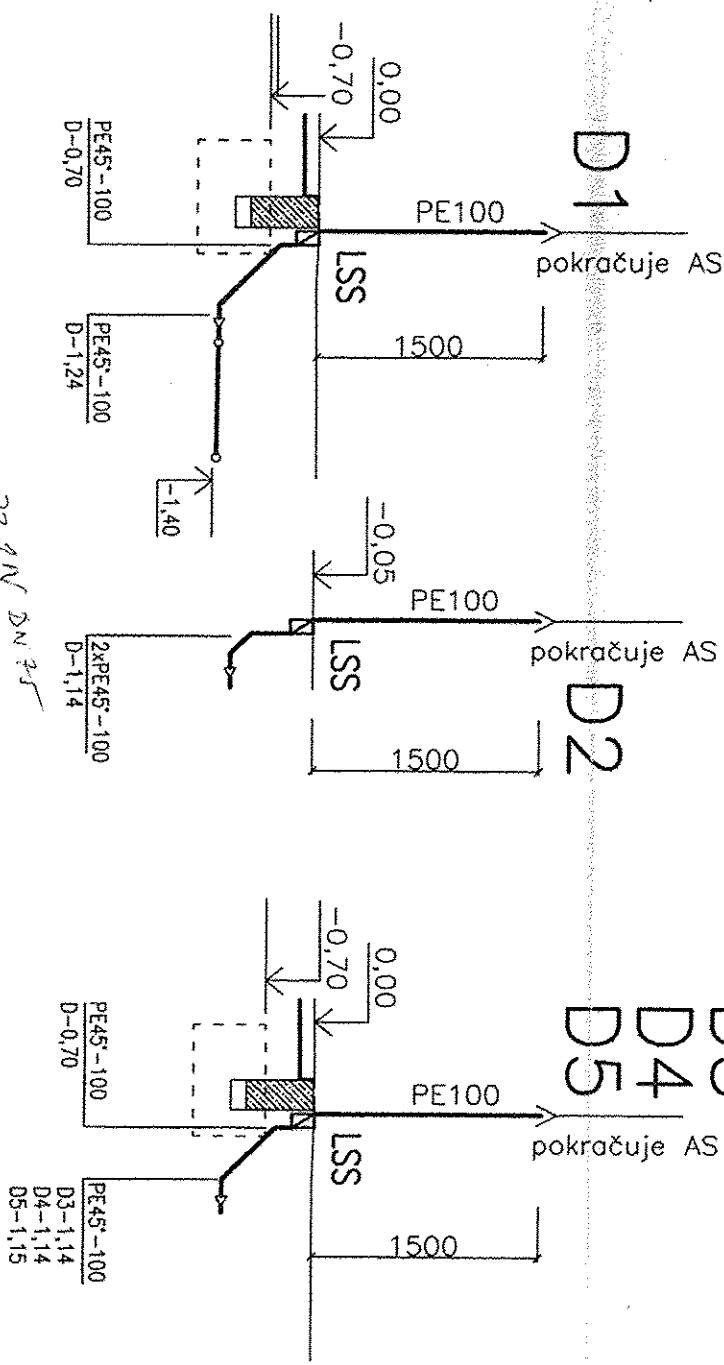

LEVELS

TOP OF INTERNAL ROADS: 225,00m n.m.
TOP OF FOUNDATION: 225,10m
BOTTOM OF STEEL STRUCTURE: 225,15m = ±0,00


±0,000=225,15 m n.m. Jadran

PROJEKT PRE REALIZACIU STAVBY SPRACOVANÝ POD ZČ. 3821.2.002.ZI
CONSTRUCTION DESIGN PREPARED UNDER NO.3821.2.002.ZI



AIR LIQUIDE

REV.	A	B	C	D	E	F	G	H	I	J	K	L	M	N	O	P	Q	R	S	T	U	V	W	X	Y	Z
DATE	05.2005																									
NAME	ING.KOBYLKOVA	ING.BERČOVÁ																								
CHECKED																										
HISTORY FILE																										
SCALE	1:100																									
ORIGINAL FORMAT	6x44																									
SHEET: 001																										
OF 001 SHEETS																										
DRAWING NO.:																										
REV.																										

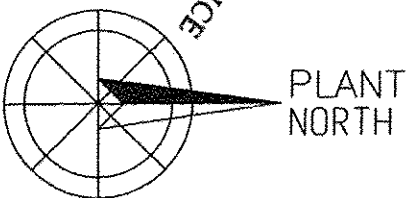

Re 24.08.05