


## POZNÁMKA/NOTE

1. PRED VYROBOU DVERI JE POTREBNE  
SKUTOČNE ROZMERY OTVOROV ZAMERAT NA STAVBE !!  
APERTURE FOR DOORS BEFORE PRODUCTION  
DIRECT AND SPECIFY PROPORTIONS

HS HSV s.r.o. KOŠICE  
Technický úsek

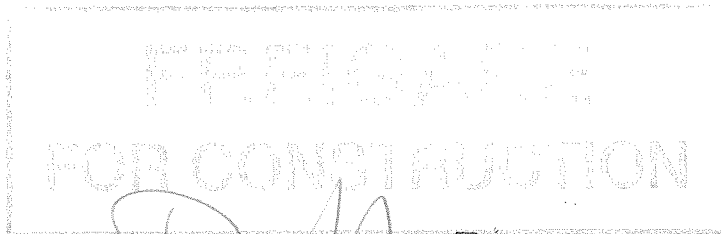

Ra 10.06.05



6

SPRACOVANÉ POD ZÁKAZKOVÝM ČÍSLOM:158/2004/SO/

<b>REFLEX-PRO</b> <small>REFLEX-PRO spol. s r.o.</small>	10.06. 2005		ING.KOŠTENSÁ	ING.RAČEK	ZMENA DISPOZÍCIE CHANGE DISPOSITION	A
	Date :	Name :	Checked:	History file:	Rev.	0
<b>AIR LIQUIDE</b> <small>AIR LIQUIDE AGS GmbH</small>	10.02. 2005		ING.KOŠTENSÁ	ING.RAČEK		
	Job code: K 70101			Scale	Original format DIN A4	
Reference: ASU No.9 KOSICE			Sheet: ---	of --- Sheets		
Replaces: 79_-----	Title: ROZVODŇA T81 ELECTRIKAL ROOM T81 VÝKAZ DVERI/SUMMARY OF DOORS			Drawing No.:	Rev.	
Replaced by: 79_-----				792.87406	A	

[illegible]

[illegible]