



PODORYS STRECHY/PLANE OF ROOF

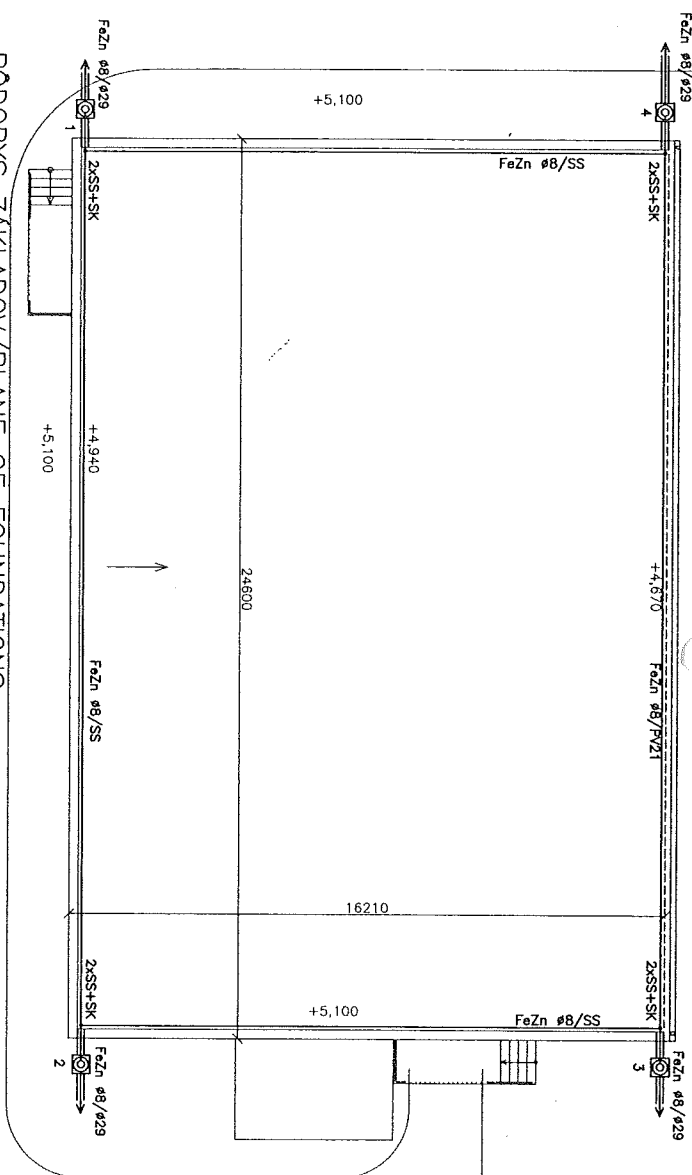

This drawing is protected by copyright.
It may not be copied or used without our written
authorization and it is strictly prohibited
to disclose it to any third parties.

PODORYS ZAKLADOV/PLANE OF FOUNDATIONS

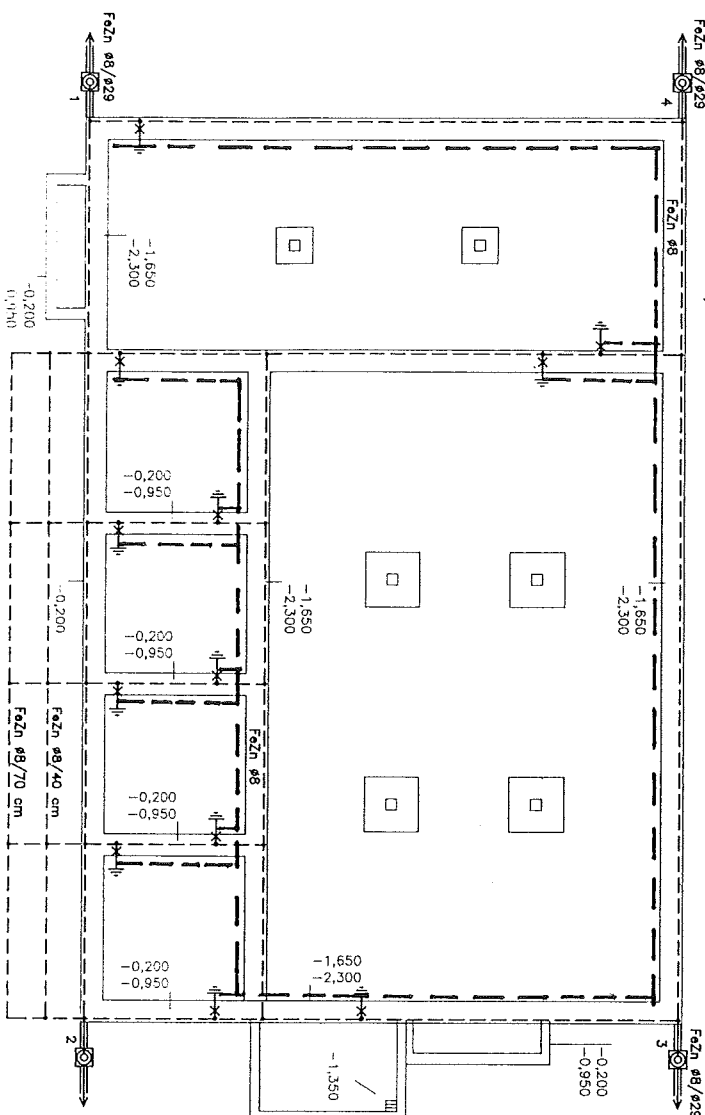

LEGENDA:

- 25 m. COLLECTION WIRE FeZn ø8 ON SUPPORTS P/21
- 80 m. COLLECTION WIRE FeZn ø8 ON SUPPORTS SS
- 40 m. LEAKAGE WIRE FeZn ø8 IN PVC PIPE ø29
- 120 m. EARTHING WIRES FeZn ø8 IN FOOTINGS

- 4 kg. TEST TERMINAL SZ IN BOX KO125
- ACQ. TO BOUND CONNECTION TERMINAL SS
- 4 kg. FOUR WAY CROSS CONNECTOR SK
- 4 kg. TERMINAL FOR CONNECTION OF GUTTER Ss
- 2 kg. TERMINAL FOR CONNECTION OF METAL OBJECTS
- 0 kg. WELDED CONNECTION IN FOOTINGS
- OUTLET FeZn ø8 FOR EQUIPMENTS

LEGENDA:

- 25 m. ZBERNÉ VEDENIE FeZn ø8 NA PODPERÁCH P/21
- 80 m. ZBERNÉ VEDENIE FeZn ø8 NA PODPERÁCH SS
- 40 m. ZVODOVÉ VEDENIE FeZn ø8 V PVC RÖRKE ø29
- 120 m. UZEMŇOVACIE VEDENIA FeZn ø8 V ZAKLADOCH

- 4 kg. SKÚŠOBNÁ SVORKA SZ V KRABICI KO125
- SS SPOJOVACIA SVORKA SS
- 4 kg. KRÍŽOVÁ SVORKA SK
- 4 kg. SVORKA PRE PRÍPOJENIE OKAPOV Ss
- 2 kg. SVORKA PRE PRÍPOJENIE KOVÝCH PREDMETOV
- 0 kg. ZVÁROVANÝ SPOJ V ZAKLADOCH
- SVOD FeZn ø8 PRE TG, ZARADENIA

FeZn 30 x 4

PLANT NORTH

±0,000=225,150m.n.m
SPRACOVANÉ POD ZÁKAZKOVÝM ČÍSLOM:158/2004/SO/

PROJEKT

AIR LIQUIDE

Job code:	K 70101	Scale	1:100	Original format	
Reference:	ASU No.9 KOSICE	Sheet	---	of ---	Sheets
Title:	ROZVODNA 781/ELECT ROOM 781	Drawing No.:	792.874.18	Rev.	A
	BLESKOZVOD/CONDUCTOR				
	Elektronika/ Wiring				

PROJEKT SKUTOČNÉHO
VÝHOTOVENIA

HSV