


3D
P1 - SPODNY / Under
1x
STRIP NA ±0,000
Ceiling on ±0,000

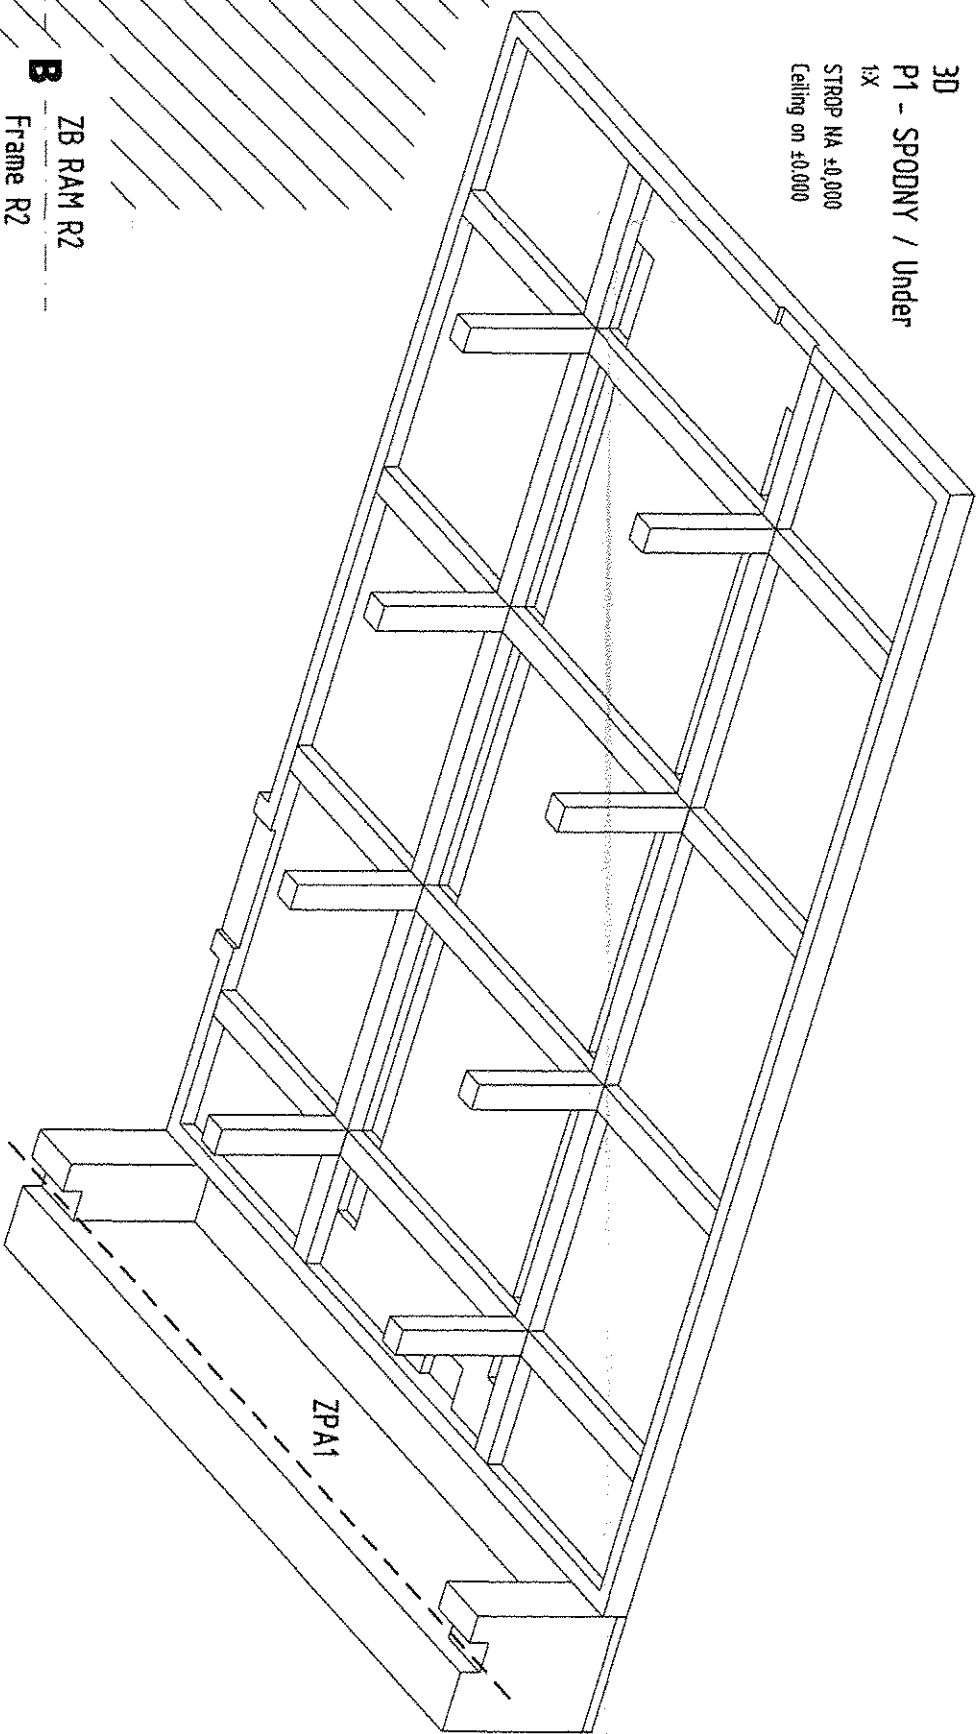

JESTVUJUCA BUDOVA
EXISTING BUILDING

BETON / Concrete: B20, B10-podkladny
VYSTUZ / Reinforcement: 10 425 (V), KARI (SZ)
OCEL / Steel: S 235
±0,000=224,530m.n.m


PROJEKT SKUTOČNOSTI
VYHOTOVENIA

[Handwritten signature]

FREIGABE
FOR CONSTRUCTION
Ra 13.07.06

HS HSV s.r.o. KOŠICE
Technický úsek

SPRACOVANÉ POD ZAKAZKOVÝM ČÍSLOM: 168/2005/SO/

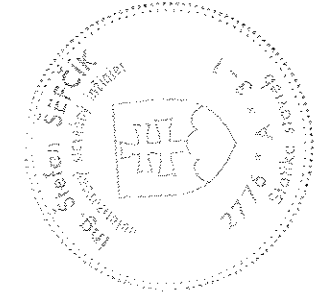

AIR LIQUIDE		Job code: K 70101		Reference: ASU No.9 KOSICE		Scale 1:50		Original format DIN A4		Rev. <i>14.6</i>	
Replaces: 79_		Title: ROZVODNÁ 180/ELECTRICAL ROOM 180		Výres tvaru dosky na ±0,000		Drawing of fashion plate ±0,000		792.87669		0	
Replaced by: 79_		Title: ROZVODNÁ 180/ELECTRICAL ROOM 180		Výres tvaru dosky na ±0,000		Drawing of fashion plate ±0,000		792.87669		0	