

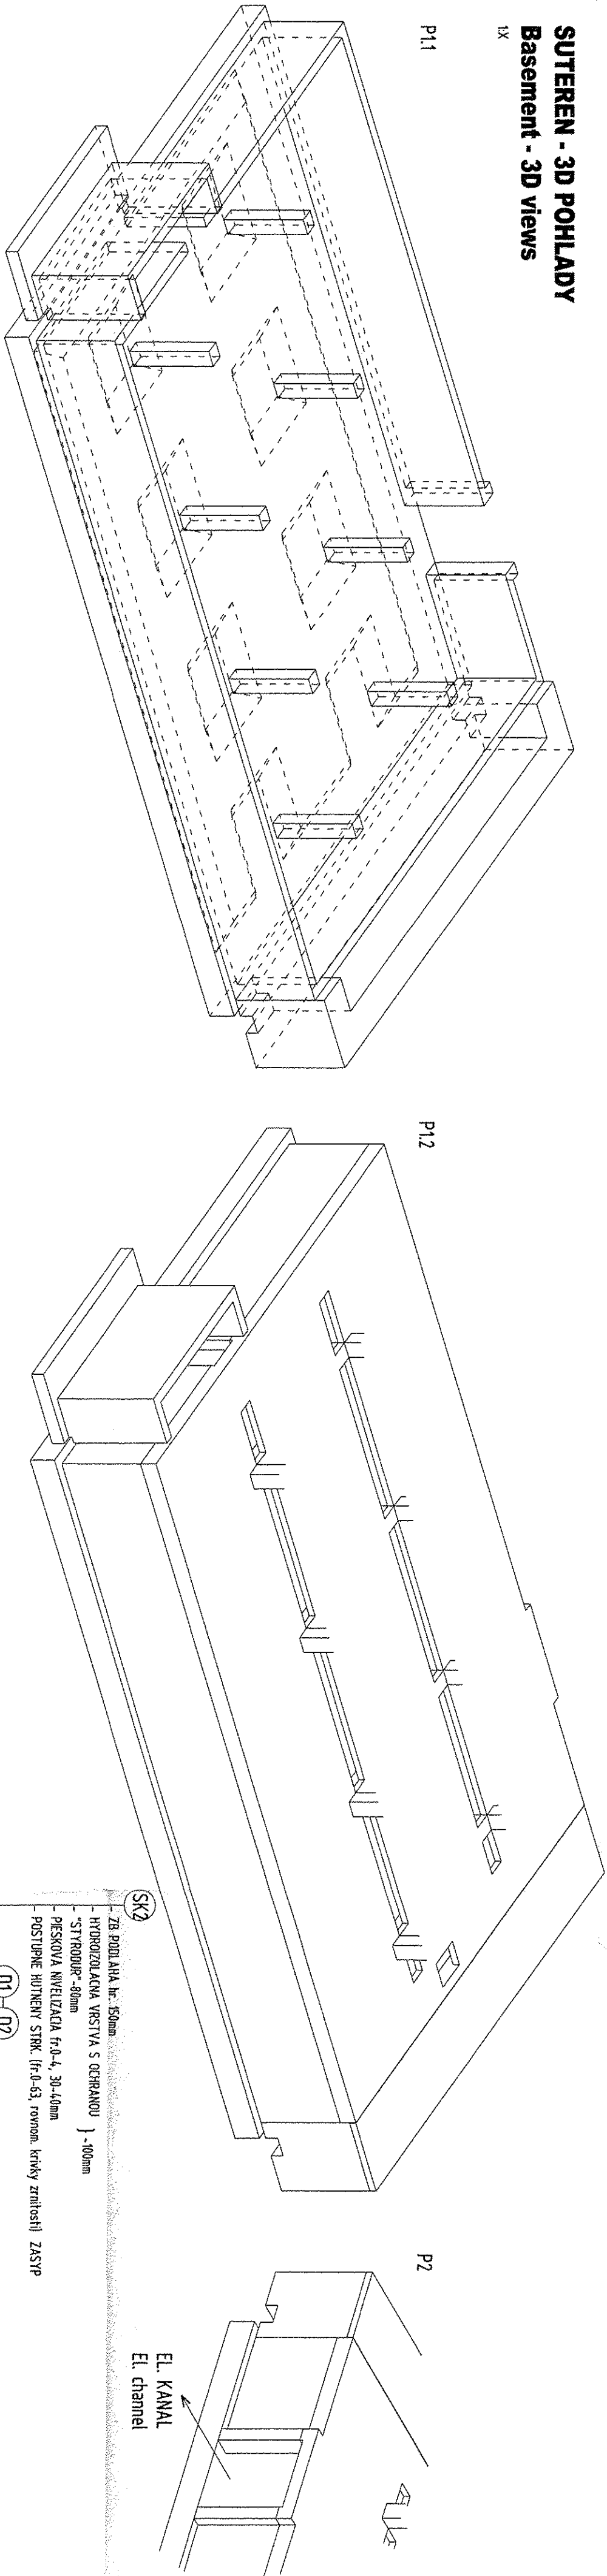


SUTEREN - 3D POHLADY
Basement - 3D views

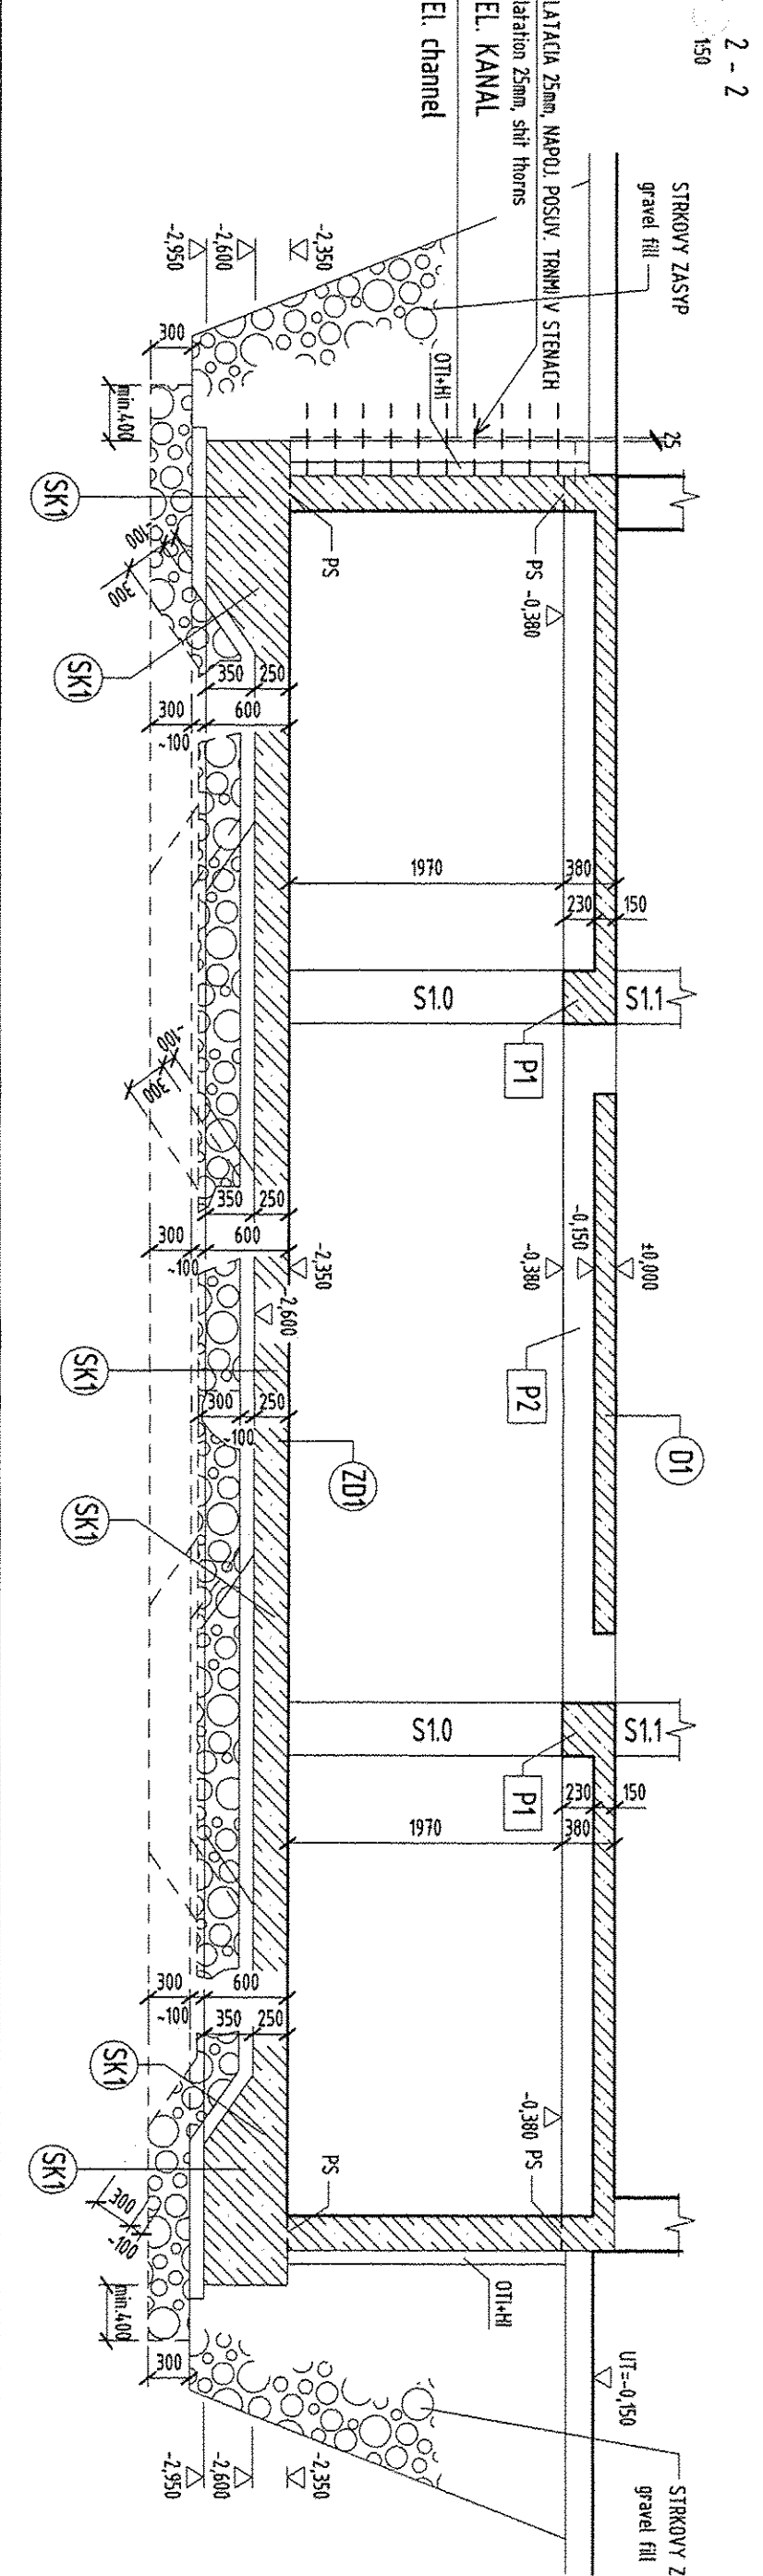

SUTEREN - REZY
Basement - sections

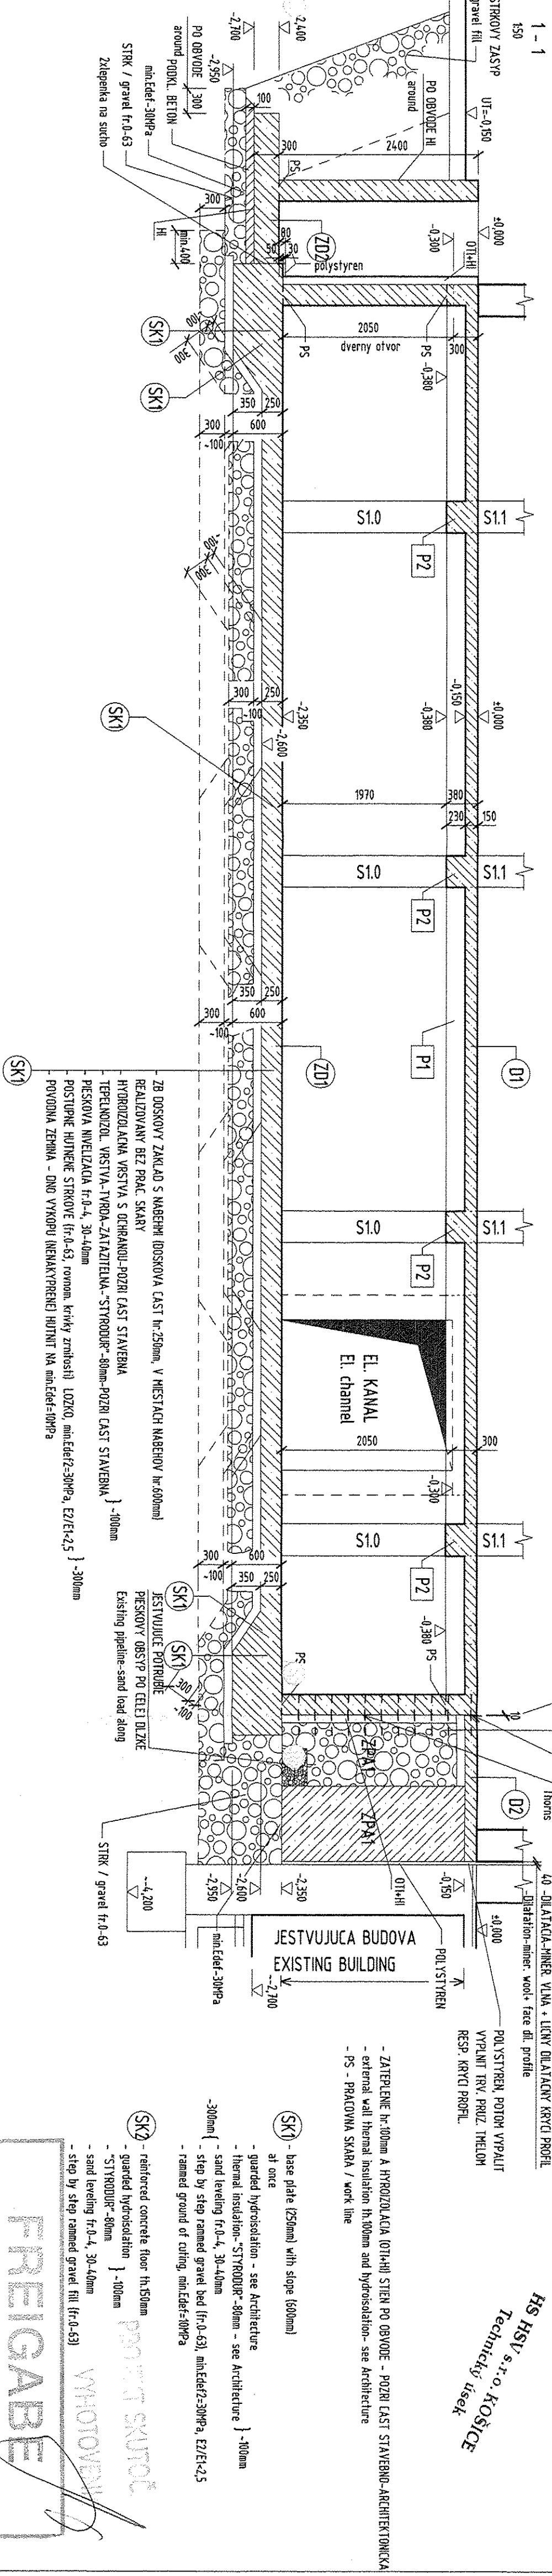

REFLEX-PRO spol. s r.o.		Date : 14.02.2005		Checked: INCSEKIC		History file: 0	
AIR LIQUIDE		Job code: K 70101		Reference: ASU No.9 KOSICE		Scale 1:50	
Air Liquide AOS GmbH		Title: ROZVODNA 180 / ELECTRICAL ROOM 180		Drawing No.: 792.87670		Rev. 0	
Replaces: 79		Replaced by: 79		REZY SUTERENOM / SECTIONS OF CELLAR		0	

SPRACOVANÉ POD ZÁKAZKOVÝM ČÍSLOM: 168 / 2005 / 50 /

±0,000=224,530m.n.m

BETON / concrete: B20, B10-podkladný
VYSTUŽ / Reinforcement: 10 425 (VI, KARI (SZ)
OCEĽ / Steel: S 235

FOR CONSTRUCTION

Freigabe

HS HSV s.r.o. KOŠICE
Technický úsek