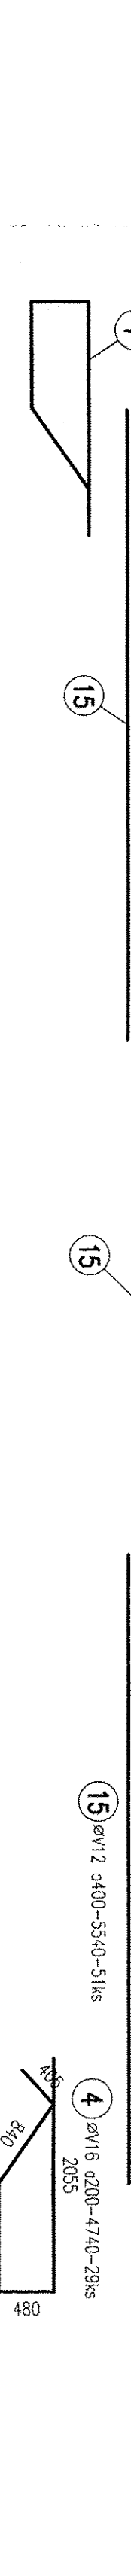
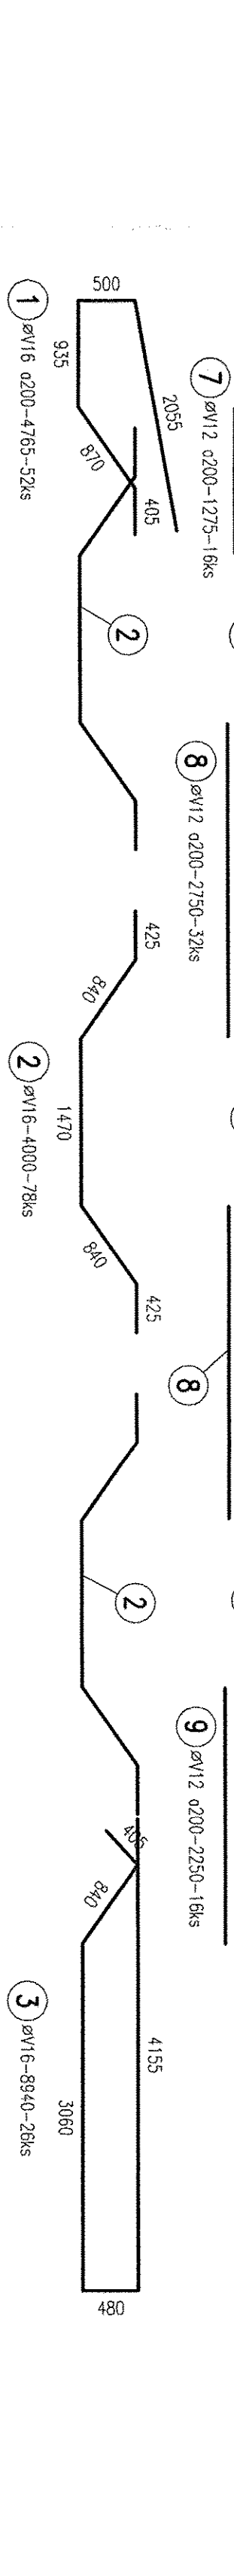
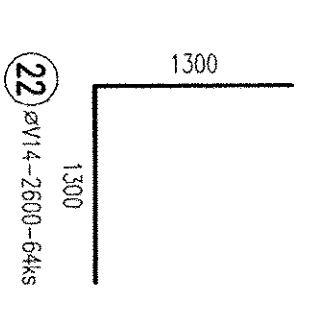
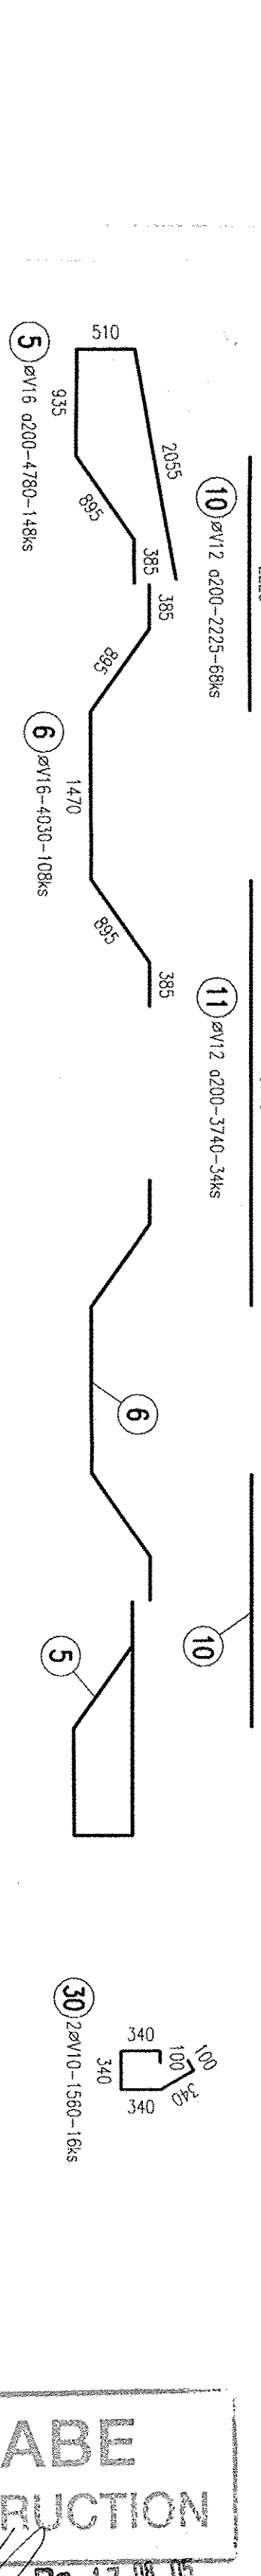
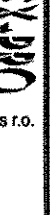


1 2 4 3

[illegible]

ZMENA "A" / CHANGE "A"
doplnenie výstuže zidkovej dosky / addition of concrete deck's reinforcement
konštrukčnou (dizajnovou) výstužou zidkovej dosky / constructional (superficial) reinforcement
deska hr. 250 mm
300x300
200x100
100
0,8 x 2,25 x 0,517 = 130,5 kg
0,10-0,00-2,515 = 264/m²
desa s výš. 300
550x550
100
0,10-0,00-3,25 = 464/slp
1,6 x 3,2 x 0,617 = 316,6 kg

BETON / Concrete: B20, B10-podkladny
VSTUŤ / Reinforcement: 10 425 (V), KARI (SZ)
OCEL / Steel: S 235
±0,000=224,530m.n.m
SPRACOVANÉ POD ZÁVÄZNOU ĽIS OM-166/2005/ISO /

 KLEEN-PRO spot. s.r.o.									
2 AIR LIQUIDE		MAINT. ZONES DATE : ULL. ZONES		INS-SPK INS-SPK INS-SPK		INS-SPK INS-SPK INS-SPK			
Air Liquide AG GmbH		Job code: K 70101		Reference: ASU No.9 KOISCE		Title: WPC ROOM 180, ELECTRICAL ROOM 180 Wires system shutdown Drilling of support foundations			
Repairs: 79, _____ Replaced by: 79, _____		Scale 1:50		Original format DIN A4		Signature, name, address of architect History file: _____		A 0	
		Drawing No.: 792.87671		Sheet: --- of --- Sheet		Rev		A	