




Hilfsring support ring

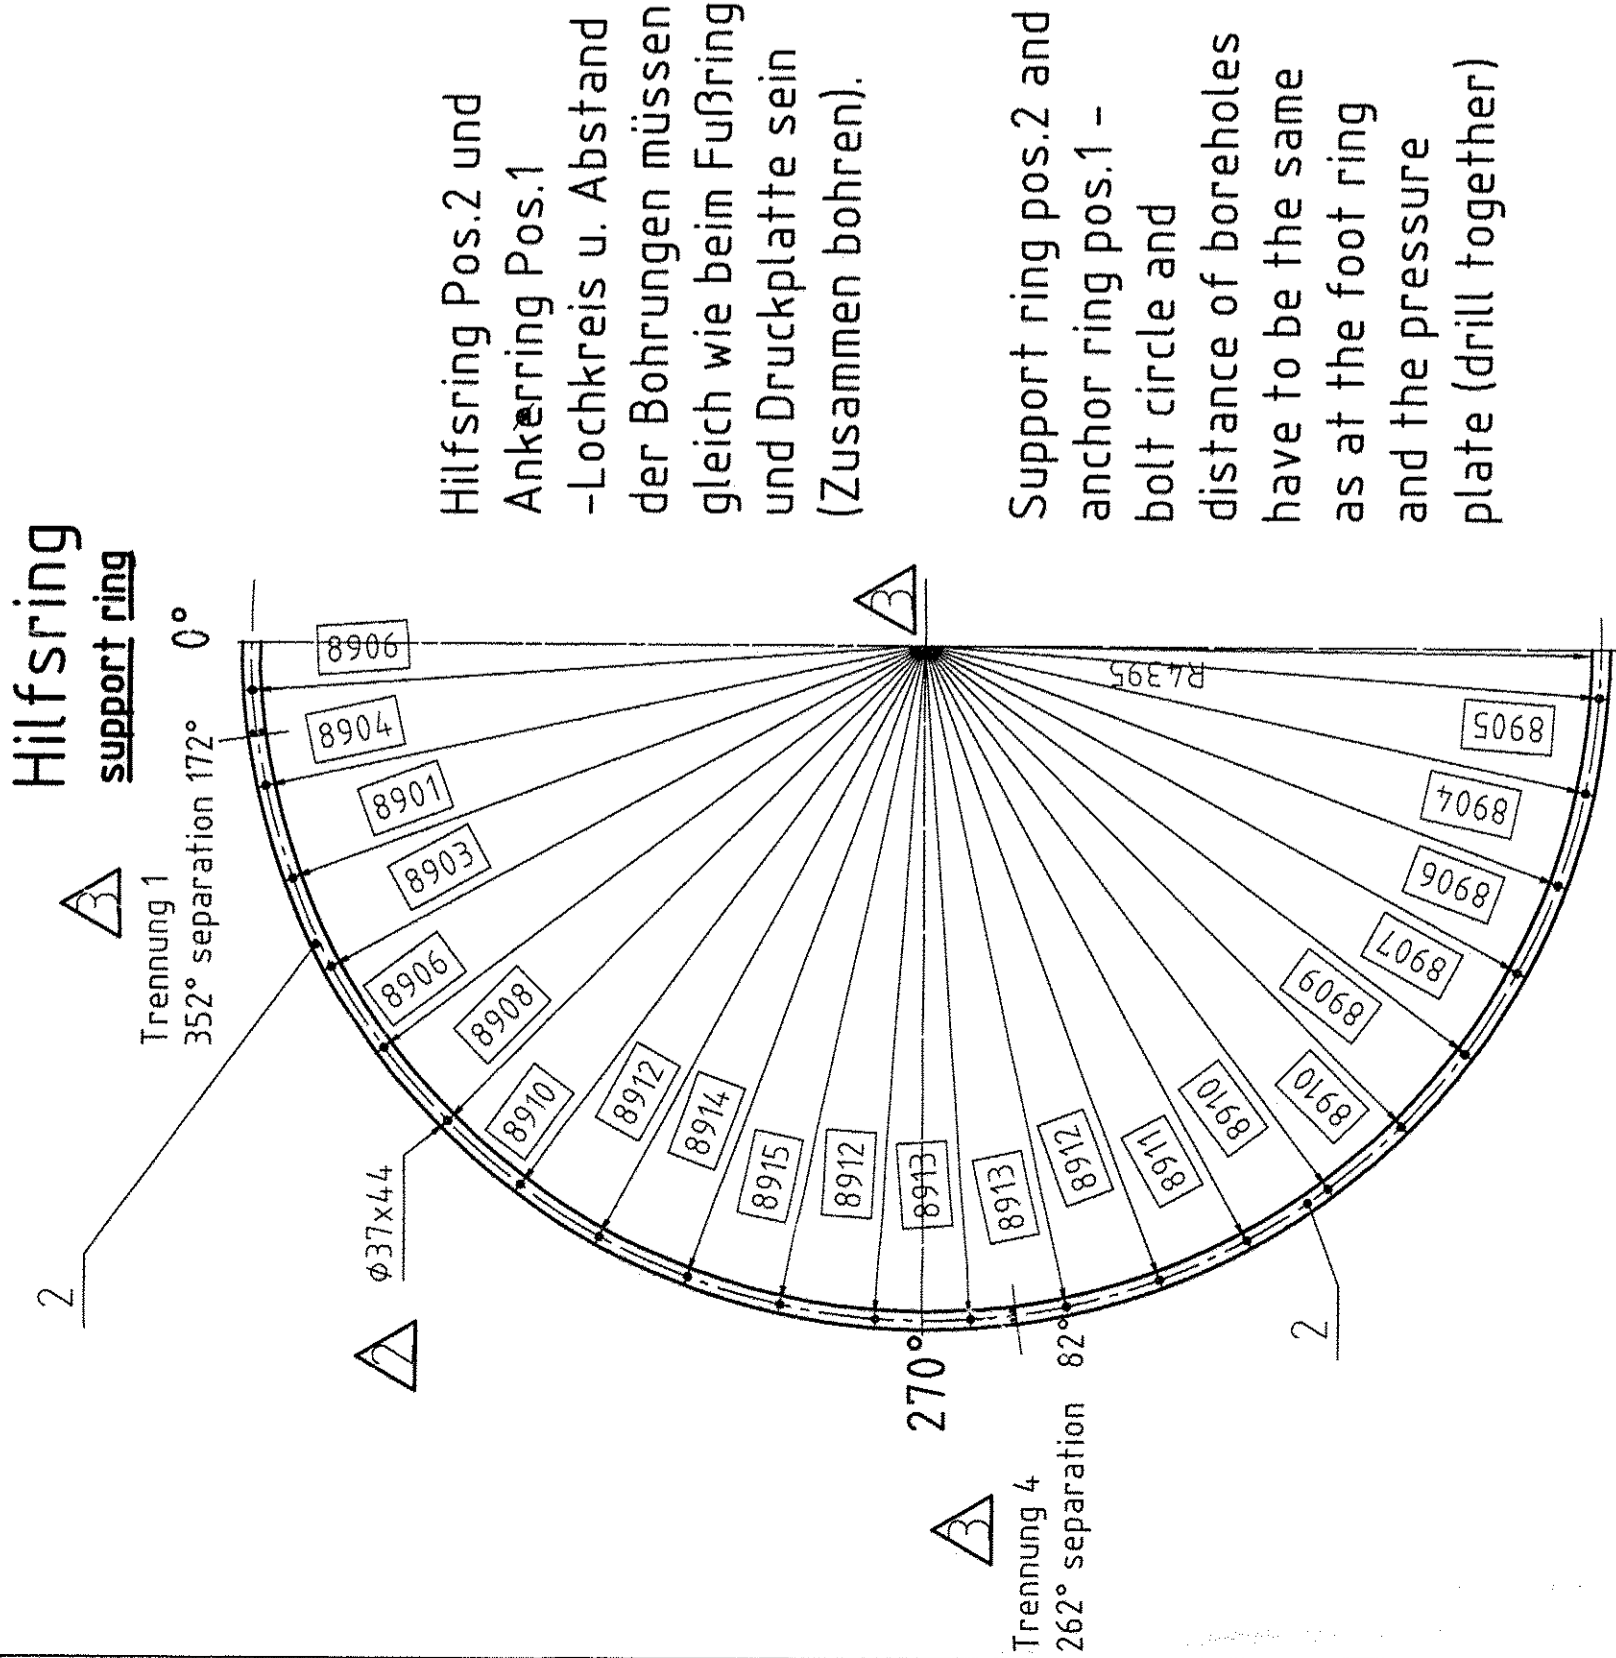

Schnittdarstellung cutaway view

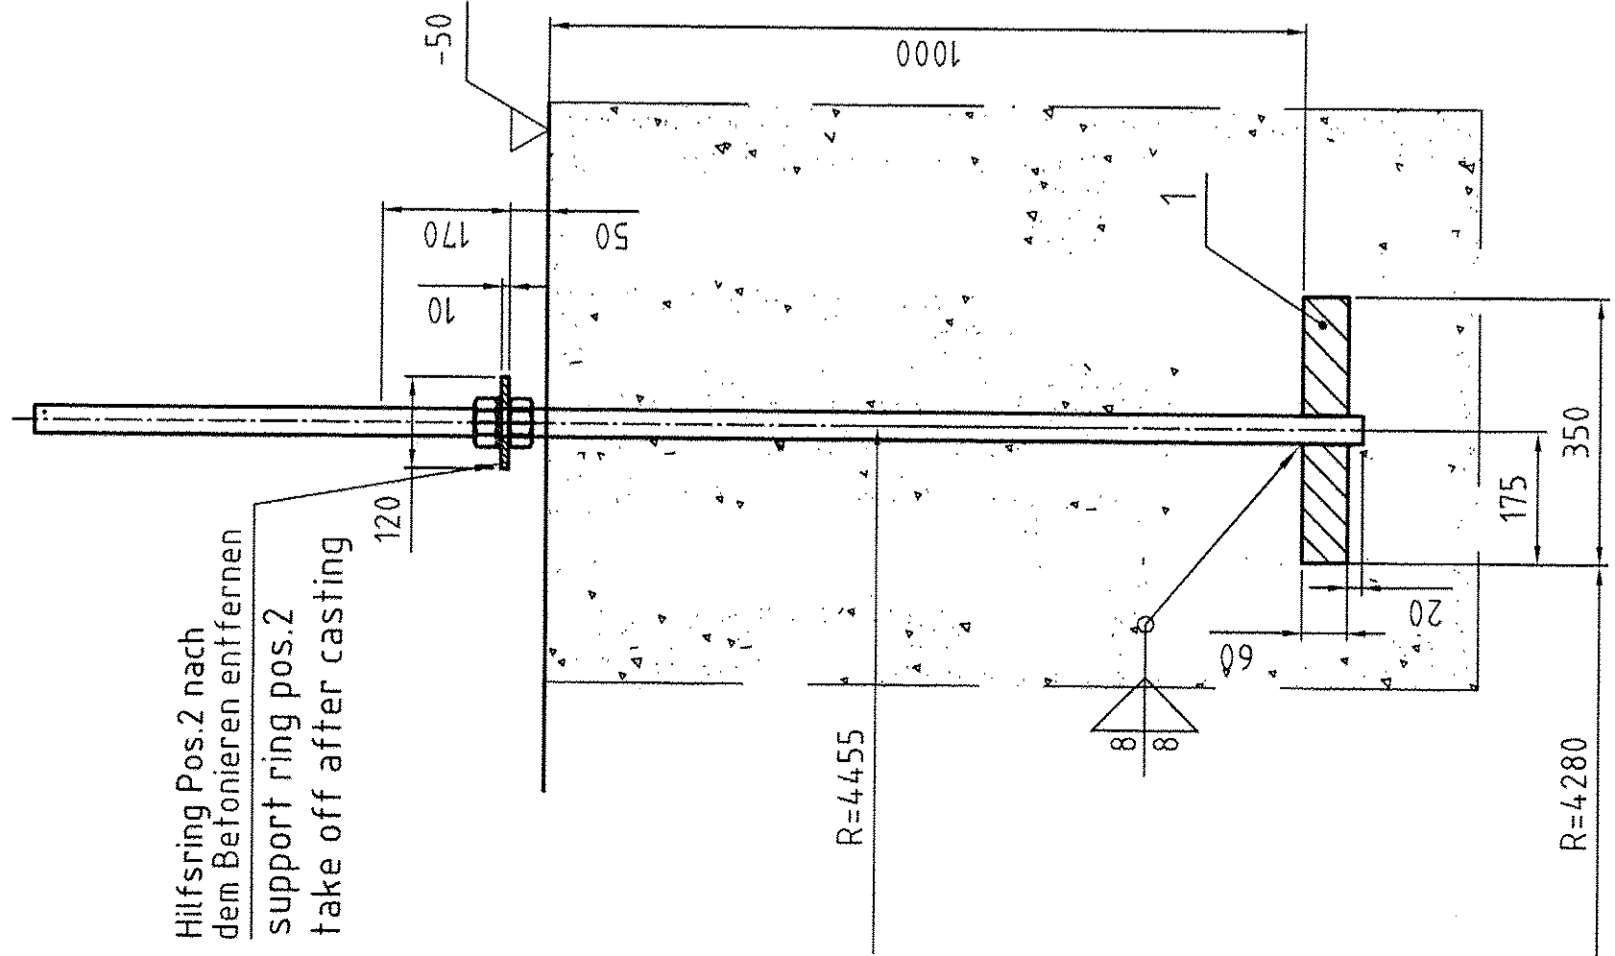

Ankertring anchor ring

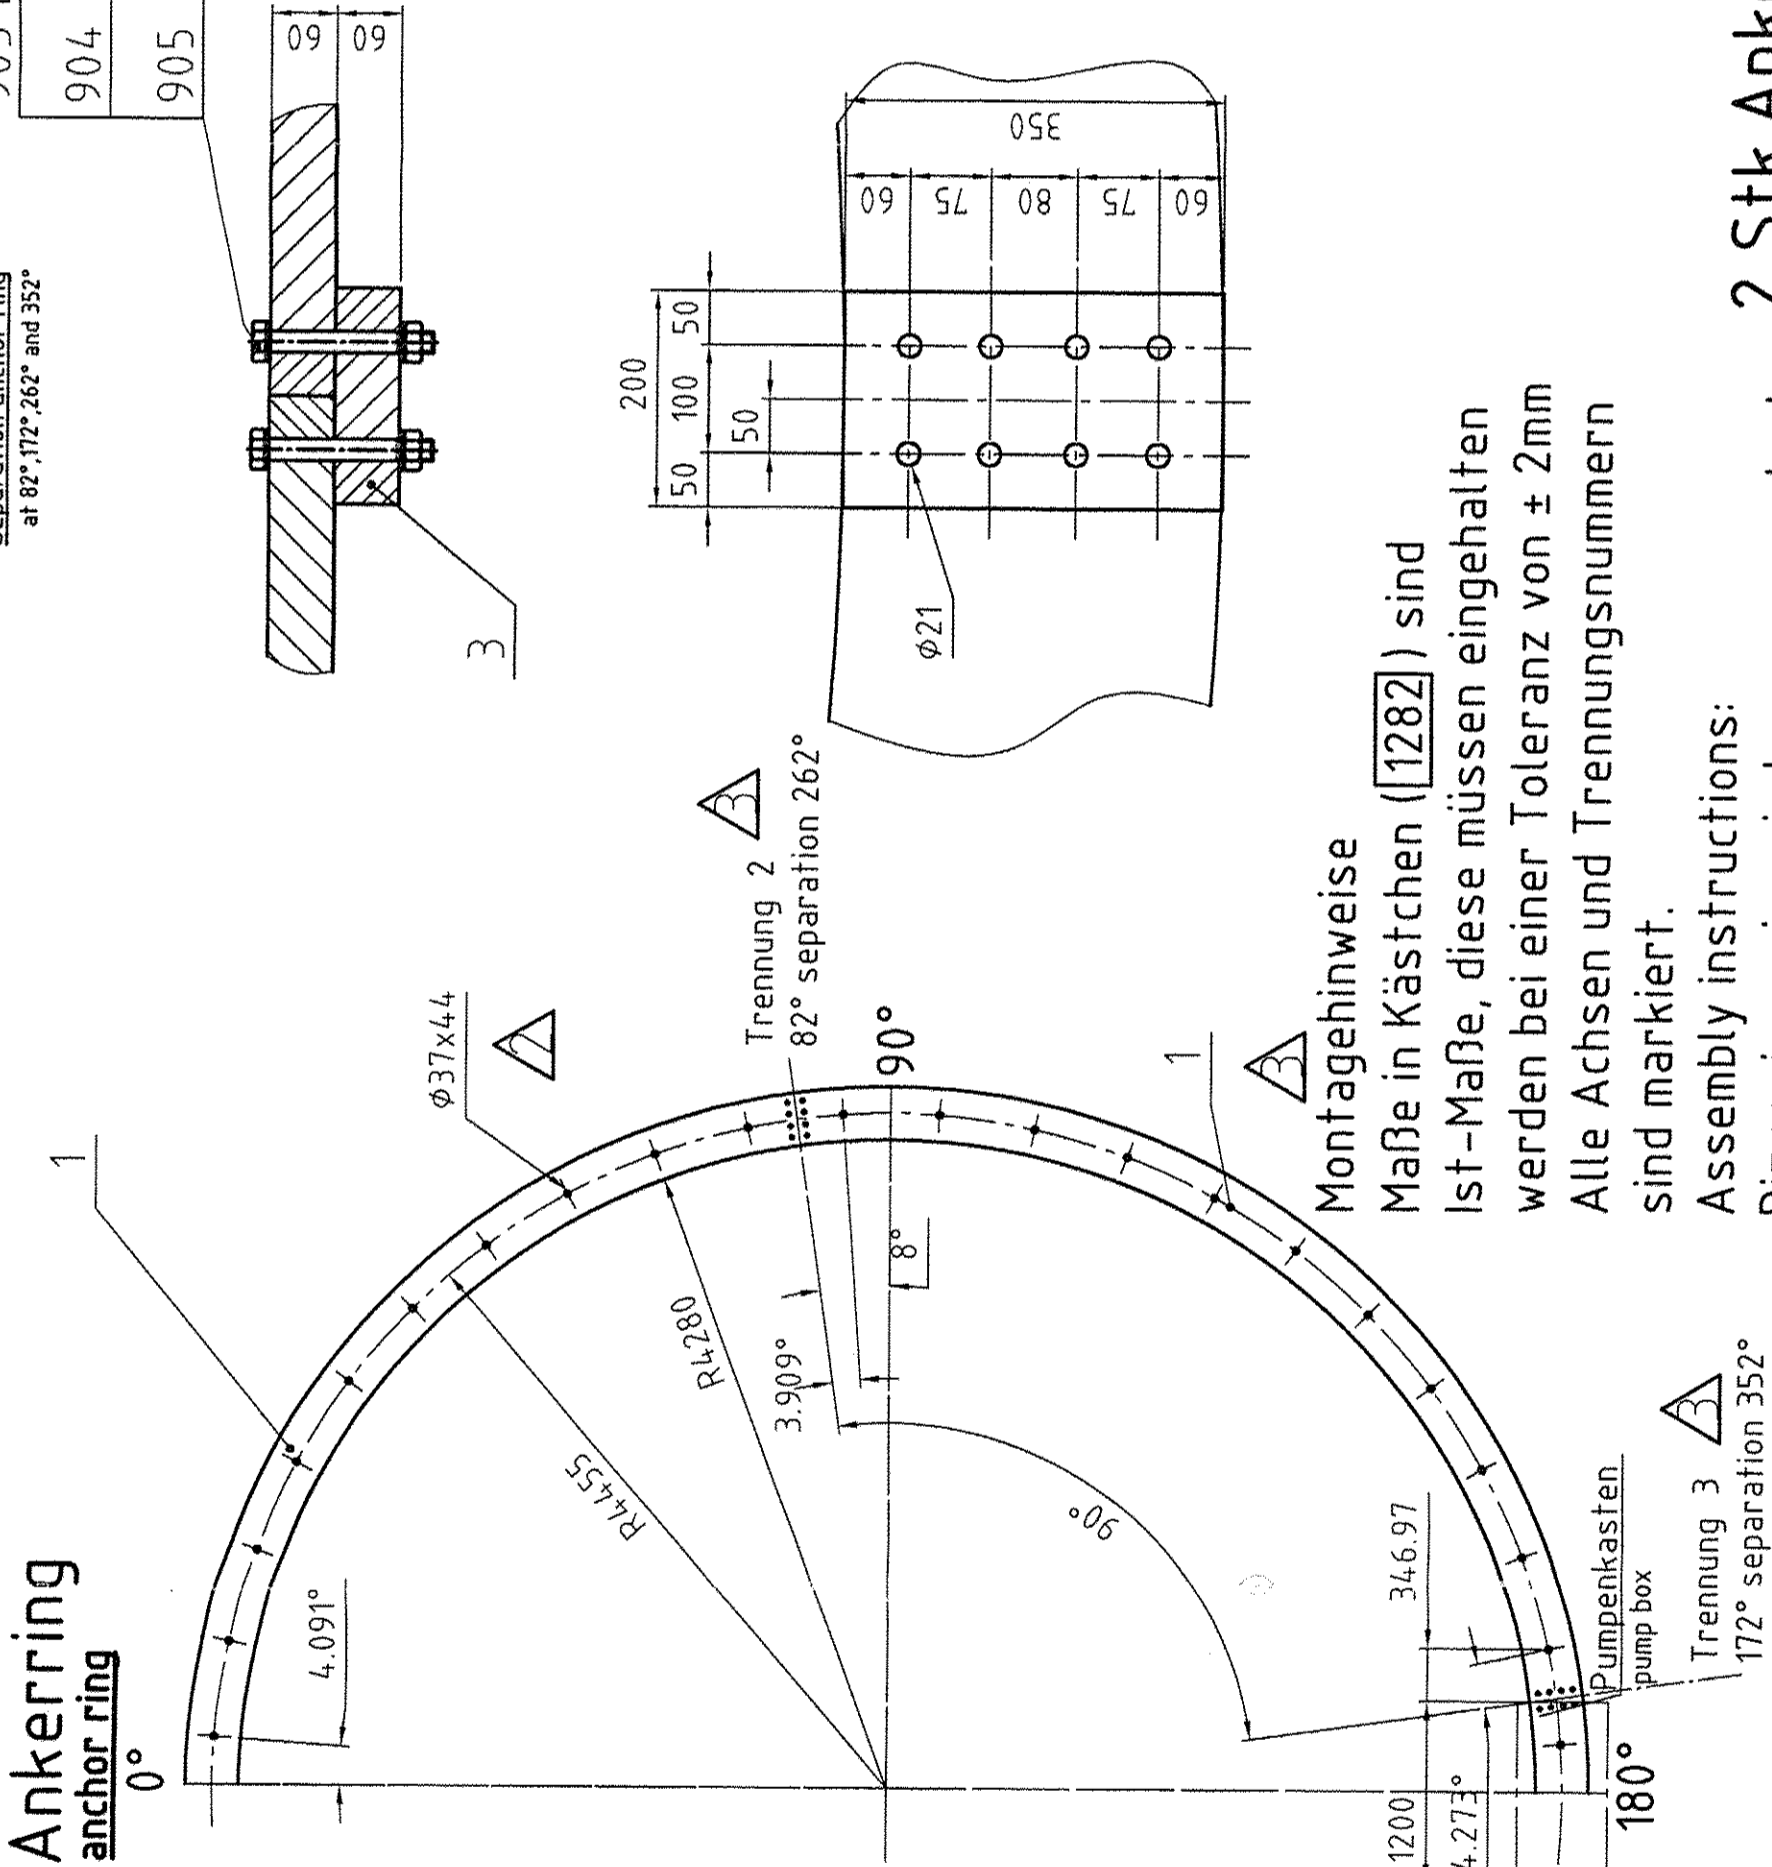


Verankerung anchorage

- 900 Stud bolt DIN 976-1 M36x1760-A-8.8 x42
- 901 Washer DIN 125-A 37 -300HV x42
- 902 Hex. nut ISO 4032 - M36-8 x84

2 Stk.Ankerschrauben im Bereich des Pumpenkastens

2 anchor screw in the area of the pump box

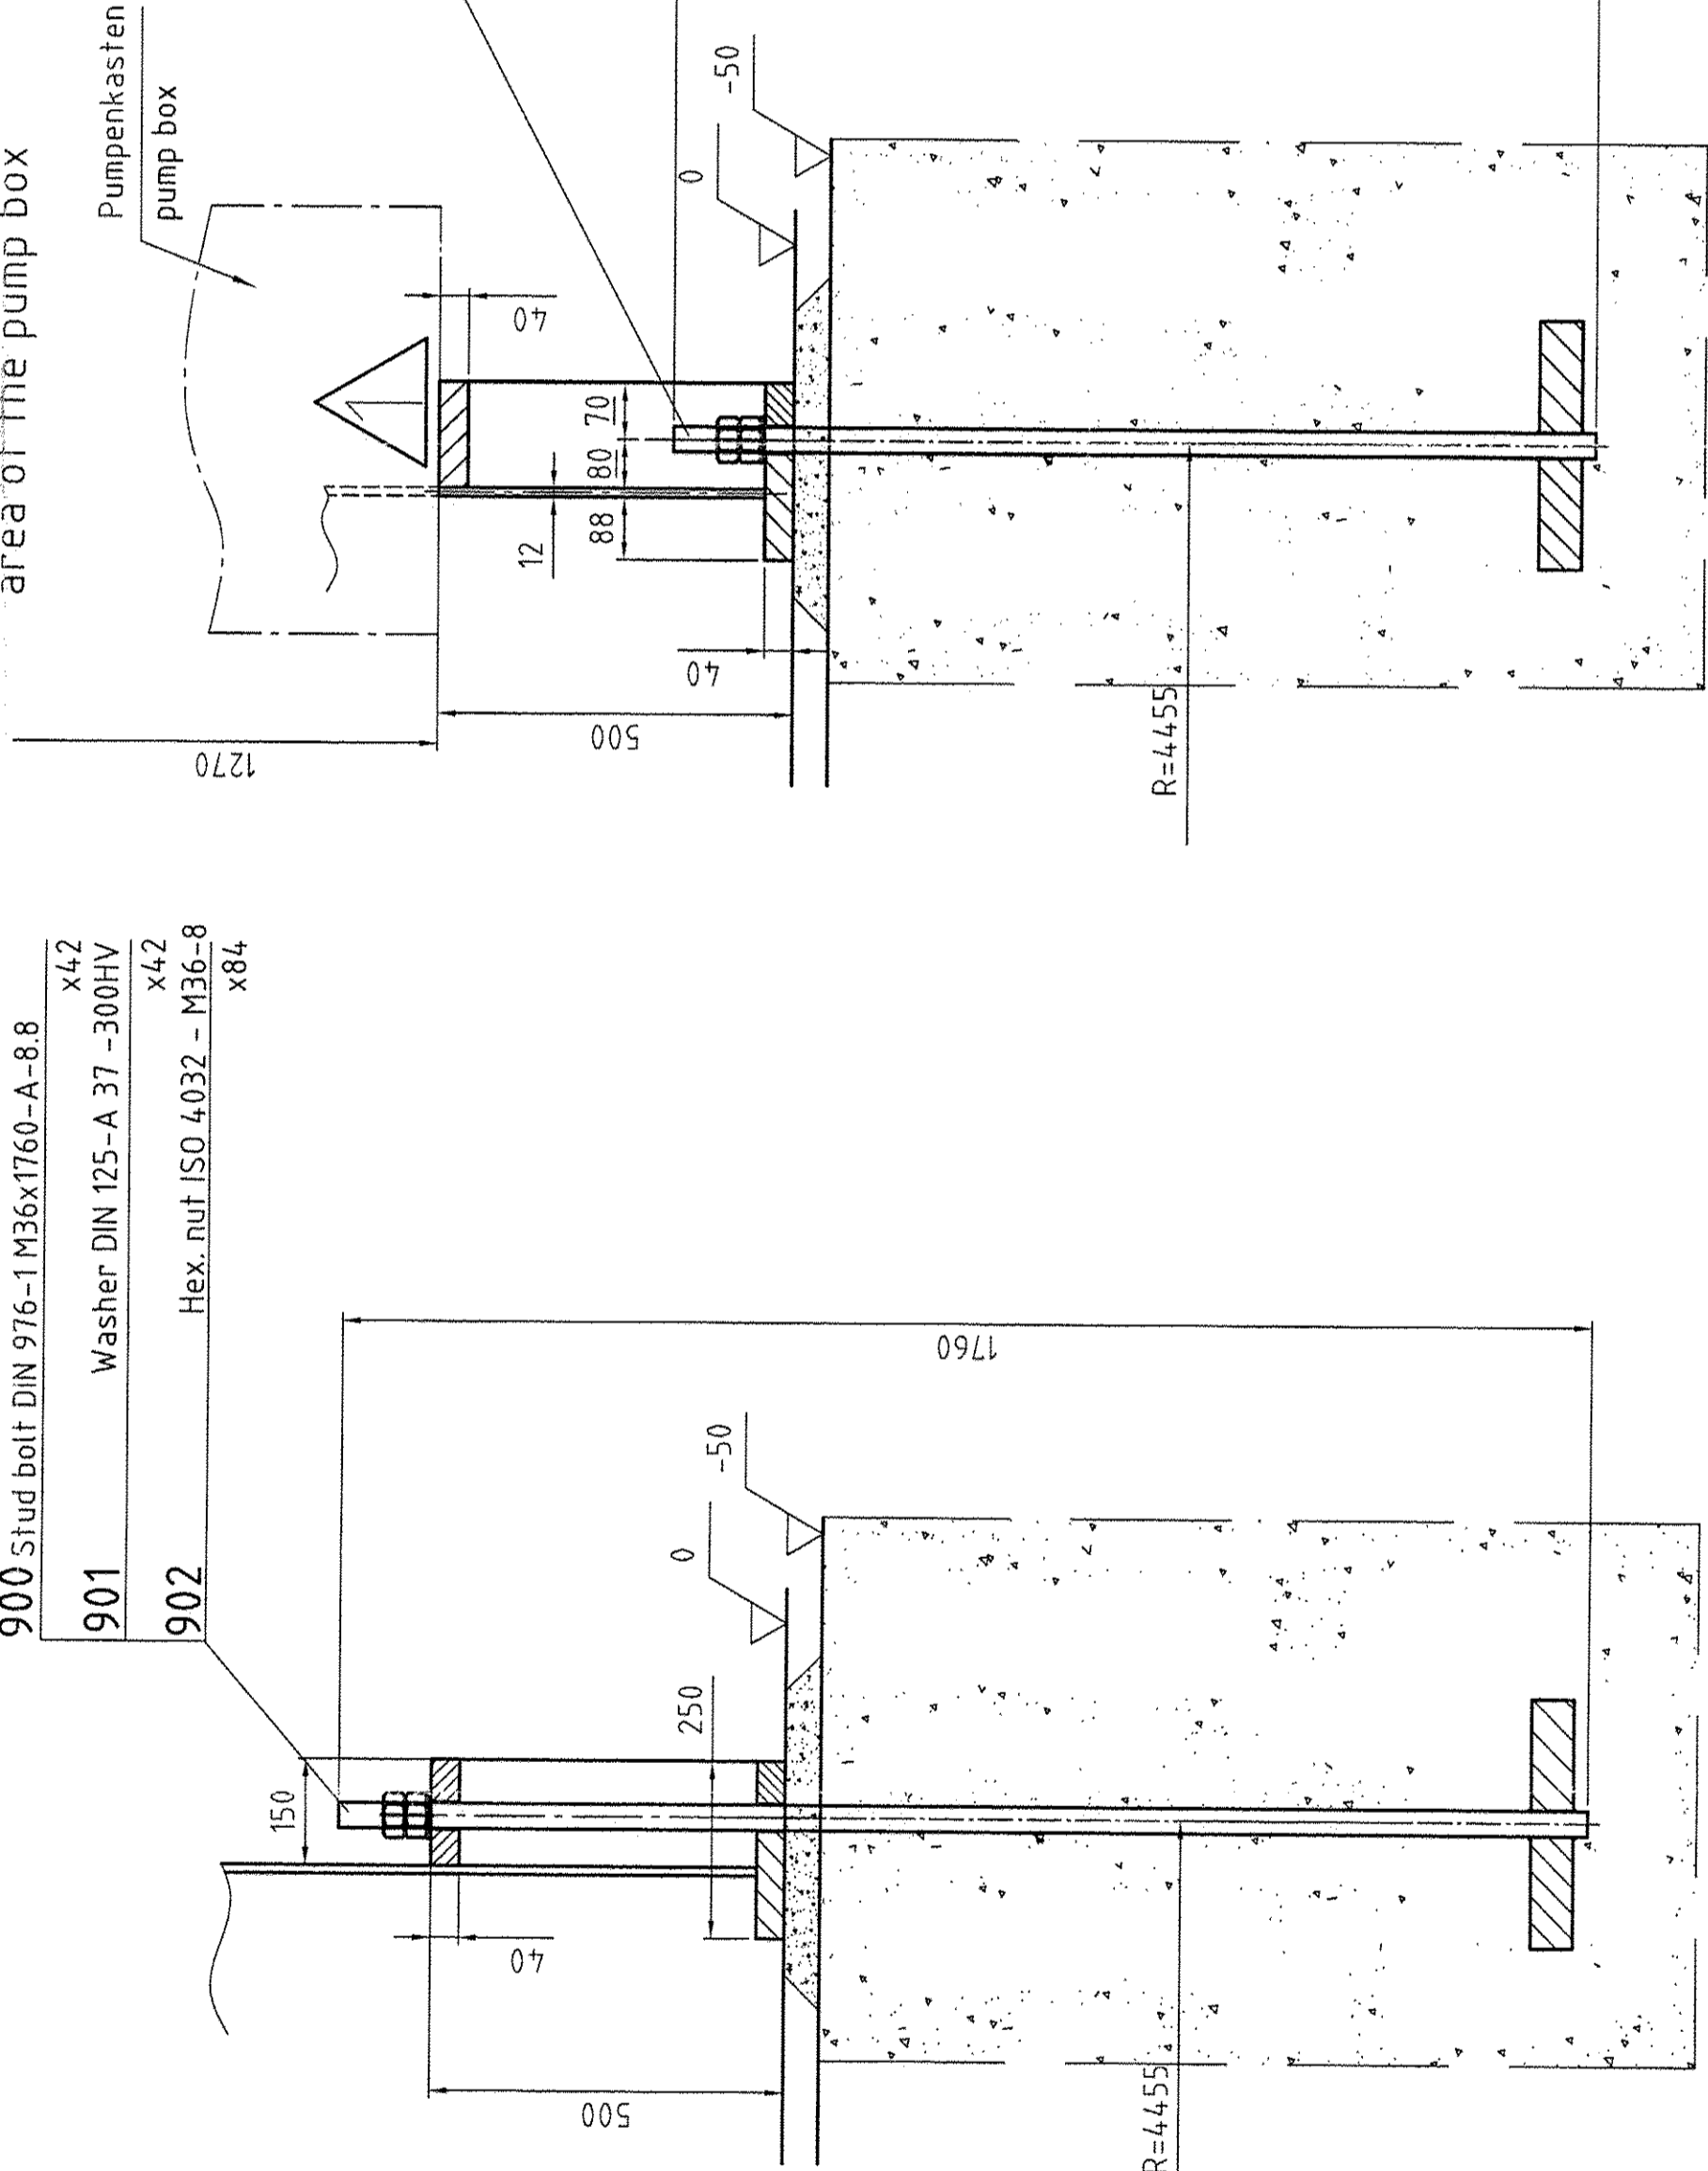

REV.	JOB NO.	DESCRIPTION	SIGN.	DATE
3		6 x Revision		10.05.05
2		2 x Revision		6.04.05
1		1 x Revision		16.03.05
ARCHIVES REVISED				

REVISIONS

REPLACED BY:

Anchor basket

DRAWING No.:

05-101-100

TITLE:

Anchor basket

REFERENCE:

K70101 ASU No. 9 Kosice

JOB CODE:

K70101 ASU No. 9 Kosice

SCALE

1:50

ORIGINAL FORMAT

DIN A1

SHEET: 1

OF 1 SHEETS

REV.

3


















