This drawing is protected by copyright.
It may not be copied or used without our written authorization and it is strictly prohibited to disclose it to any third parties.

Welding No.	DN	Diameter	Welder No.	Protocoll No.
01	100	114,3	____	____
02	100	114,3	____	____
03	100	114,3	____	____
04	100	114,3	____	____
05	100	114,3	____	____
06	100	114,3	____	____
07	100	114,3	____	____
08	65	76,1	____	____
09		12	____	____
10		12	____	____

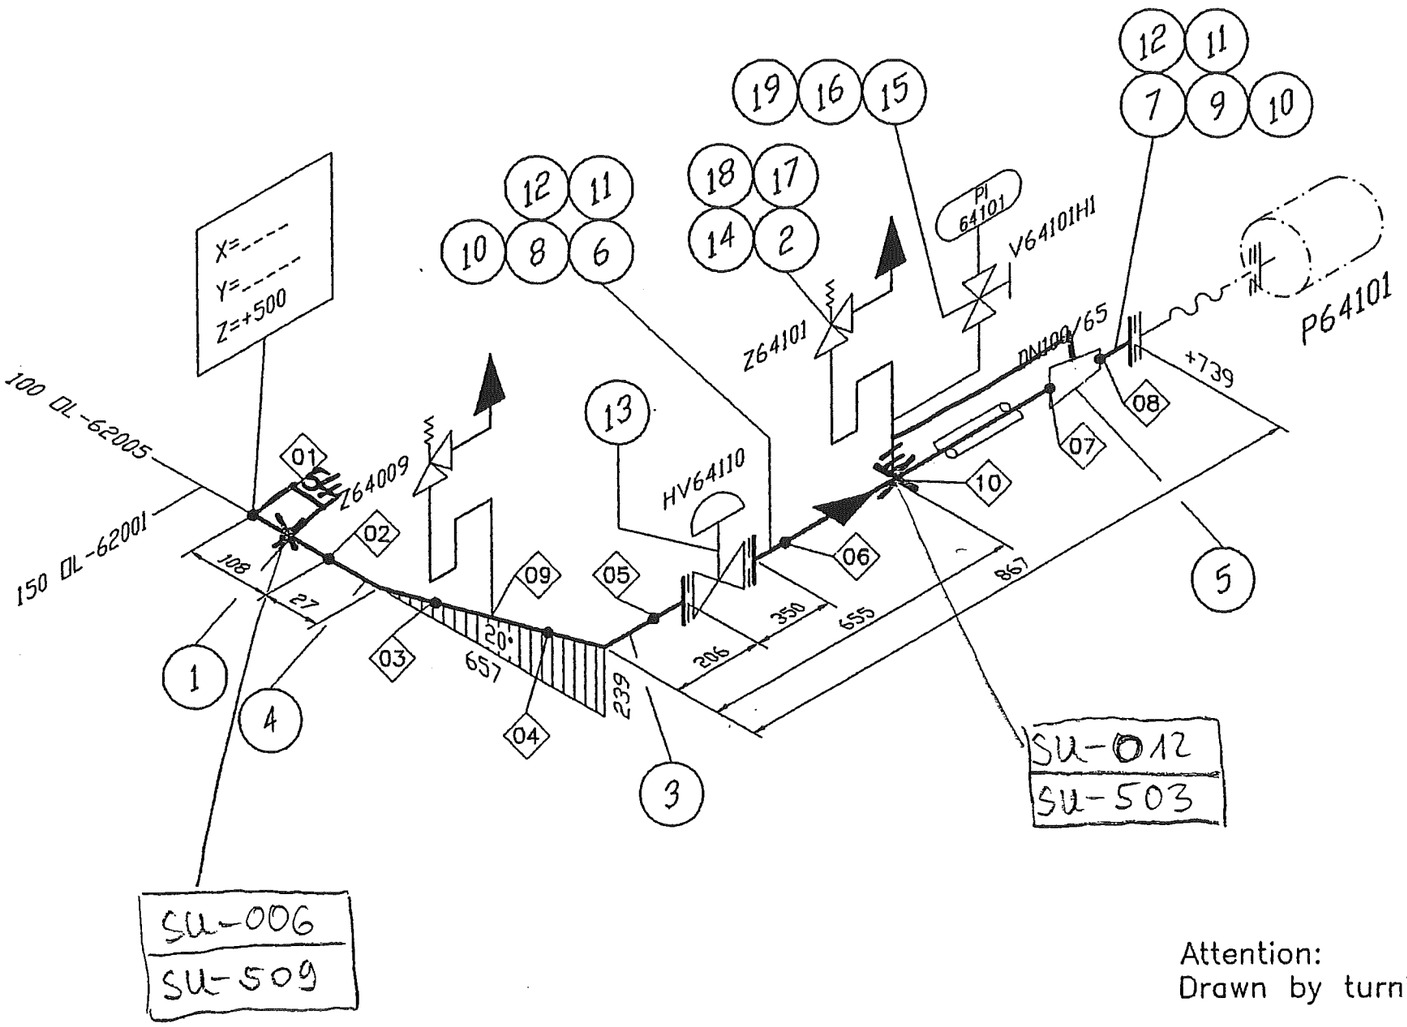

Remarks:

Responsibility of the assembling company:
- Situation of mounting seams
- Situation of pass-lengths
- Check of measure details and pipe courses on the construction site
- Situation of the spindle at valve

Accompanying drawings:

- 150 OL-62001 ZB10C1C
- 100 OL-62005 ZB10C1C

Accompanying lists:

- Parts list:
  100 OL-62001-ZB10C1C

Pipe standard:

- AL Standard No.:
  50030

Attention:
Drawn by turning around 45°

AIR LIQUIDE	Date : 27.10.2004	Name : Reid./IES	Checked: Hr. Gans	History file: 79287106.doc
	Job code: K70101		Scale --:--	Original format DIN A3
Air Liquide AGS GmbH	Reference: ASU Kosice		Sheet: 001	of 001 Sheets
Replaces: 79_.____	Title:		Drawing No.:	Rev.
Replaced by: 79_.-----	100 OL-62001		792.87106	___

This drawing is protected by copyright.
It may not be copied or used without our written authorization and it is strictly prohibited to disclose it to any third parties.

Welding No.	DN	Diameter	Welder No.	Protocoll No.
01	150	168,3	___	___
02	150	168,3	___	___
03	100	114,3	___	___

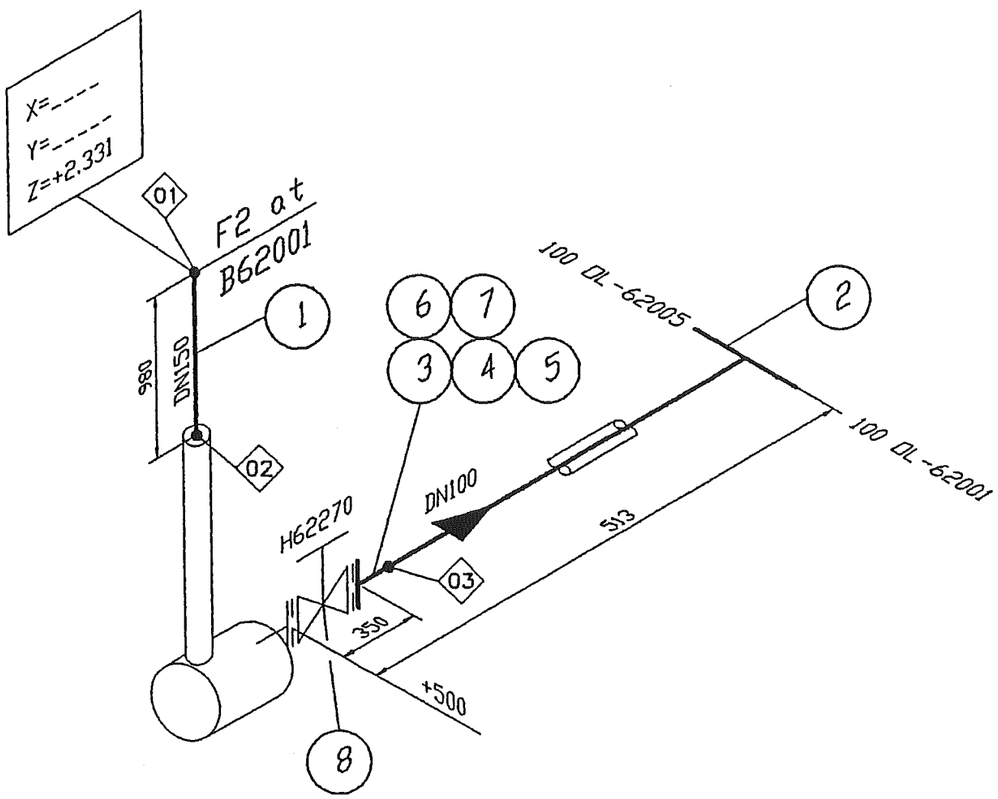

Remarks:

Responsibility of the assembling company:
- Situation of mounting seams
- Situation of pass-lengths
- Check of measure details and pipe courses on the construction site
- Situation of the spindle at valve

Accompanying drawings:

- 100 OL-62001 ZB10C1C
- 100 OL-62005 ZB10C1C

Accompanying lists:

- Parts list:
  150 OL-62001-ZB10C1C

Pipe standard:

- AL Standard No.:
  50030

Attention:
Drawn by turning around 45°

AIR LIQUIDE	Date : 27.10.2004	Name : Reid./IES	Checked: Hr. Gans	History file: 79287106.doc
	Job code: K70101		Scale --:--	Original format DIN A3
Air Liquide AGS GmbH	Reference: ASU Kosice		Sheet: 001	of 001 Sheets
Replaces: 79_.____ Replaced by: 79_.-----	Title: 150 OL-62001		Drawing No.: 792.87106	Rev. ___

This drawing is protected by copyright.
It may not be copied or used without our written authorization and it is strictly prohibited to disclose it to any third parties.

Welding No.	DN	Diameter	Welder No.	Protocoll No.
01	100	114,3	___	___
02	80	88,9	___	___
03	80	88,9	___	___
04	80	88,9	___	___
05	80	88,9	___	___
06	80	88,9	___	___
07	80	88,9	___	___
08	65	76,1	___	___
09		12	___	___

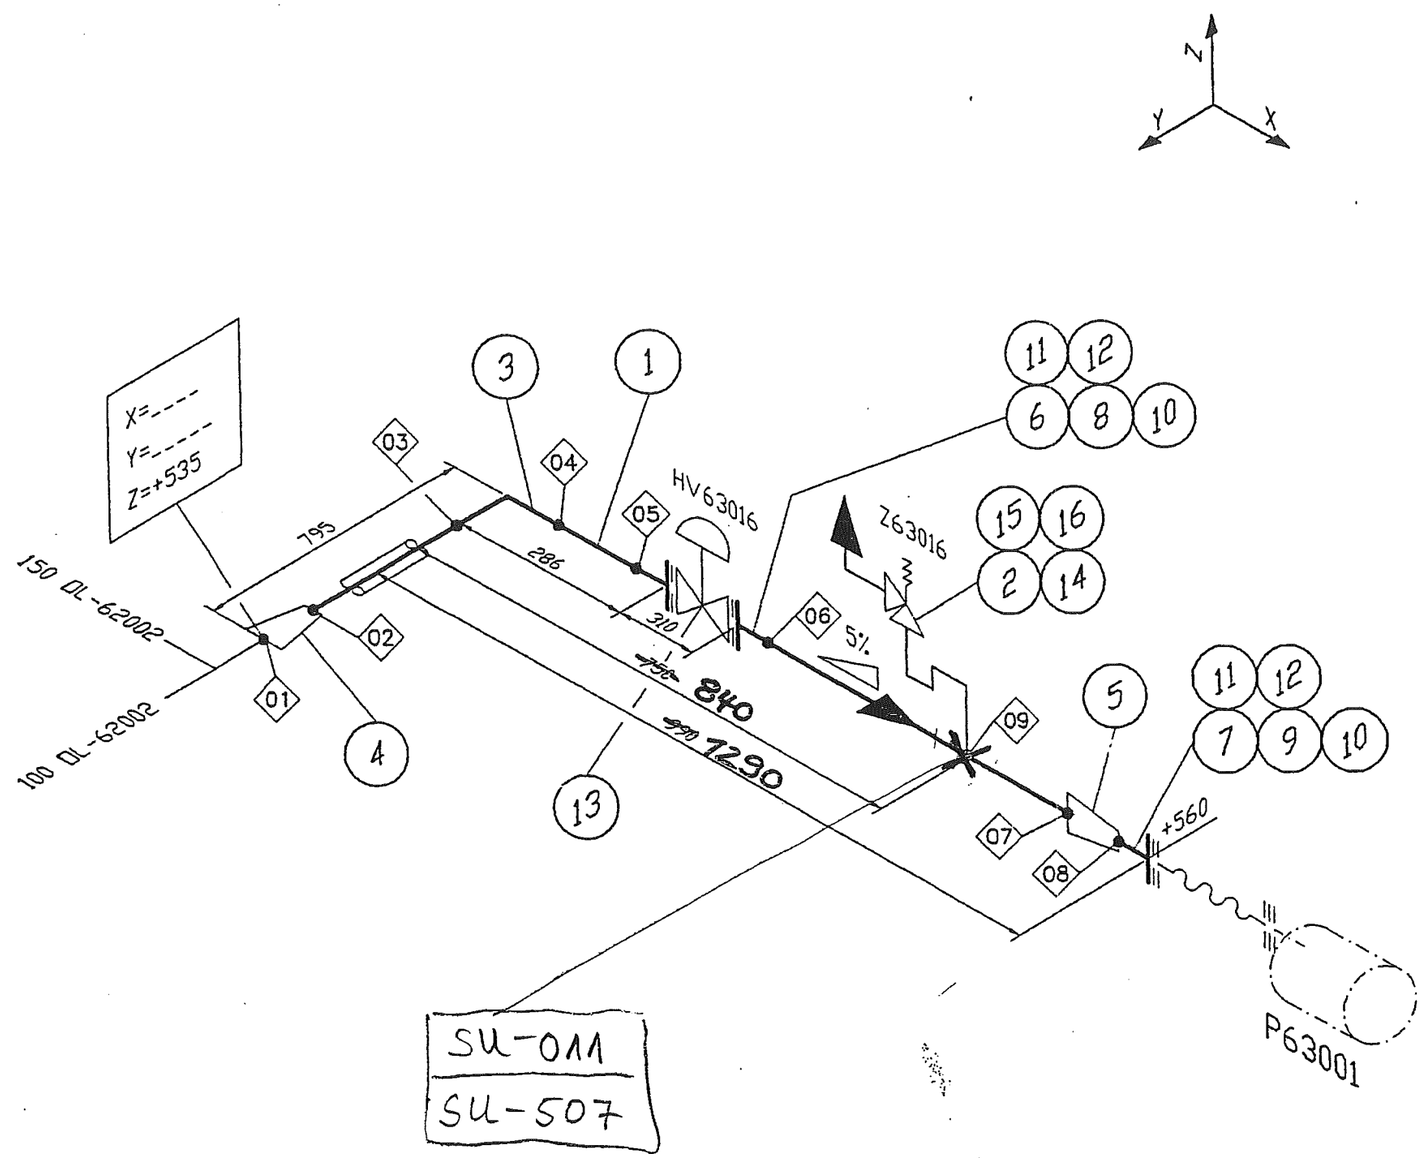

Remarks:

Responsibility of the assembling company:
- Situation of mounting seams
- Situation of pass-lengths
- Check of measure details and pipe courses on the construction site
- Situation of the spindle at valve

Accompanying drawings:

- 150 OL-62002 ZB10C1C
- 100 OL-62002 ZB10C1C

Accompanying lists:

- 80 OL-62002 ZB10C1C

Pipe standard:

- AL Standard No.: 50030

Attention:
Drawn by turning around 45°

	Date :	Name :	Checked:	History file:
AIR LIQUIDE	27.10.2004	Reid./IES	Hr. Gans	79287106.doc
Air Liquide AGS GmbH	Job code: K70101		Scale --:--	Original format DIN A3
	Reference: ASU Kosice		Sheet: 001	of 001 Sheets
Replaces: 79_.____	Title:		Drawing No.:	Rev.
Replaced by: 79_.-----	80 OL-62002		792.87106	___

This drawing is protected by copyright.
It may not be copied or used without our written authorization and it is strictly prohibited to disclose it to any third parties.

Welding No.	DN	Diameter	Welder No.	Protocoll No.
01	100	114,3	----	----
02	100	114,3	----	----
03	100	114,3	----	----
04	100	114,3	----	----
05	100	114,3	----	----
06		12	----	----

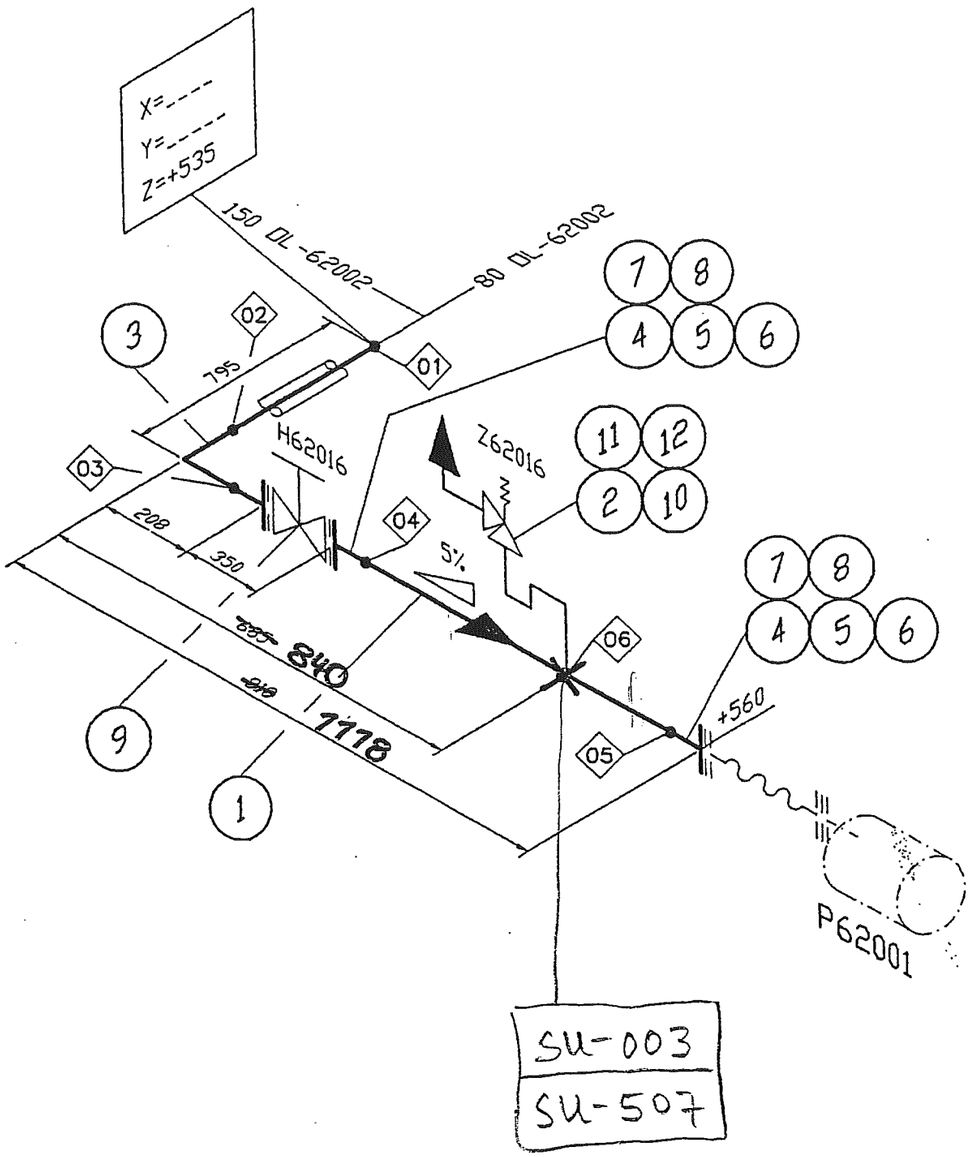

Remarks:

Responsibility of the assembling company:
- Situation of mounting seams
- Situation of pass-lengths
- Check of measure details and pipe courses on the construction site
- Situation of the spindle at valve

Accompanying drawings:

- 150 OL-62002 ZB10C1C
- 80 OL-62002 ZB10C1C

Accompanying lists:

- 100 OL-62002 ZB10C1C

Pipe standard:

- AL Standard No.: 50030

Attention:
Drawn by turning around 45°

AIR LIQUIDE	Date : 27.10.2004	Name : Reid./IES	Checked: Hr. Gans	History file: 79287106.doc
Air Liquide AGS GmbH	Job code: K70101	Reference: ASU Kosice	Scale --:--	Original format DIN A3
Replaces: 79_.____			Sheet: 001	of 001 Sheets
Replaced by: 79_.-----	Title: 100 OL-62002		Drawing No.: 792.87106	Rev. ___

drawing is protected by copyright.
It may not be copied or used without our written authorization and it is strictly prohibited to disclose it to any third parties.

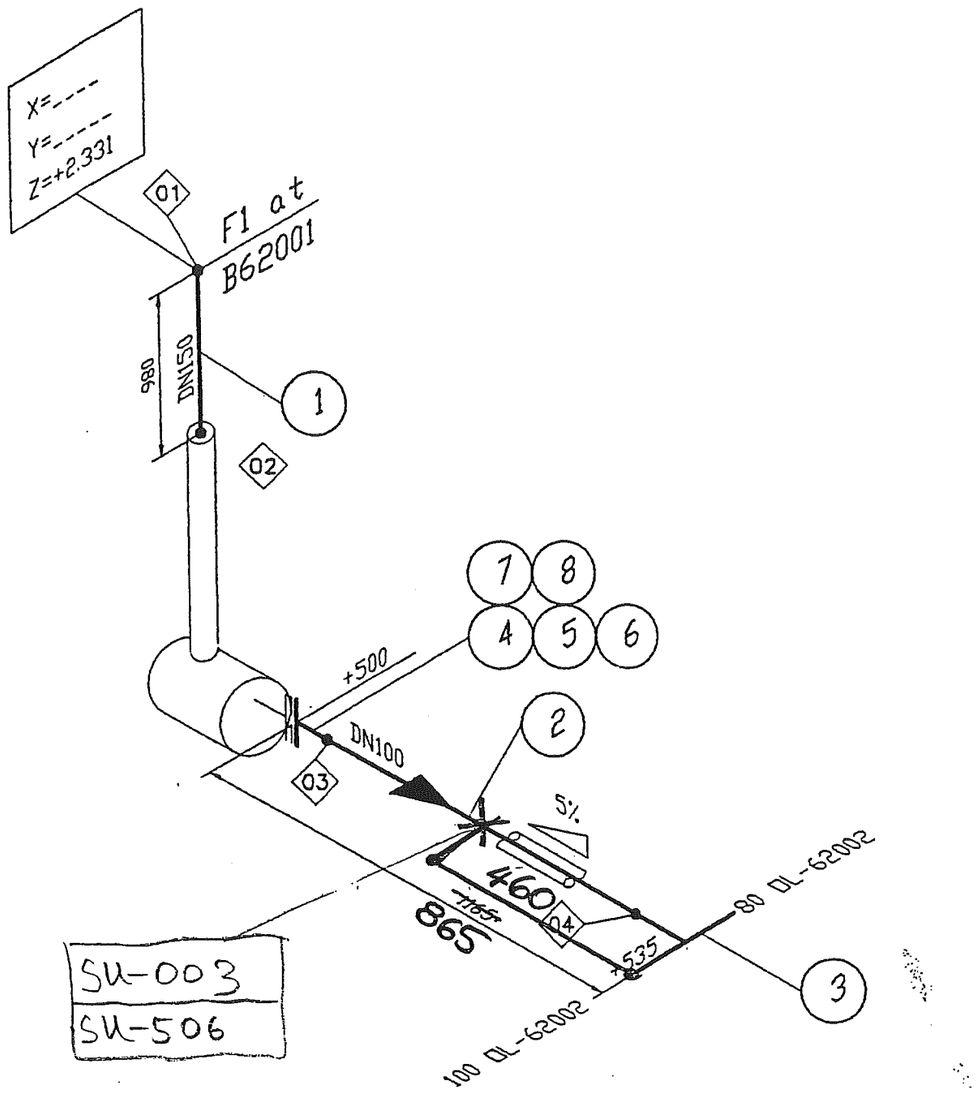

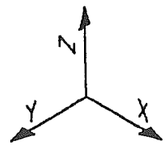

Welding No.	DN	Diameter	Welder No.	Protocoll No.
01	150	168,3	---	---
02	150	168,3	---	---
03	100	114,3	---	---
04	100	114,3	---	---

Remarks:

Responsibility of the assembling company:
- Situation of mounting seams
- Situation of pass-lengths
- Check of measure details and pipe courses on the construction site
- Situation of the spindle at valve

Accompanying drawings:

- 100 OL-62002 ZB10C1C
- 80 OL-62002 ZB10C1C

Accompanying lists:

- 150 OL-62002 ZB10C1C

Pipe standard:

- AL Standard No.: 50030

Attention:
Drawn by turning around 45°

AIR LIQUIDE	Date : 27.10.2004	Name : Reid./IES	Checked: Hr. Gans	History file: 79287106.doc
	Job code: K70101		Scale --:--	Original format DIN A3
Air Liquide AGS GmbH	Reference: ASU Kosice		Sheet: 001	of 001 Sheets
Replaces: 79_.____	Title: 150 OL-62002		Drawing No.: 792.87106	Rev. ___
Replaced by: 79_.-----				

This drawing is protected by copyright.
It may not be copied or used without our written authorization and it is strictly prohibited to disclose it to any third parties.

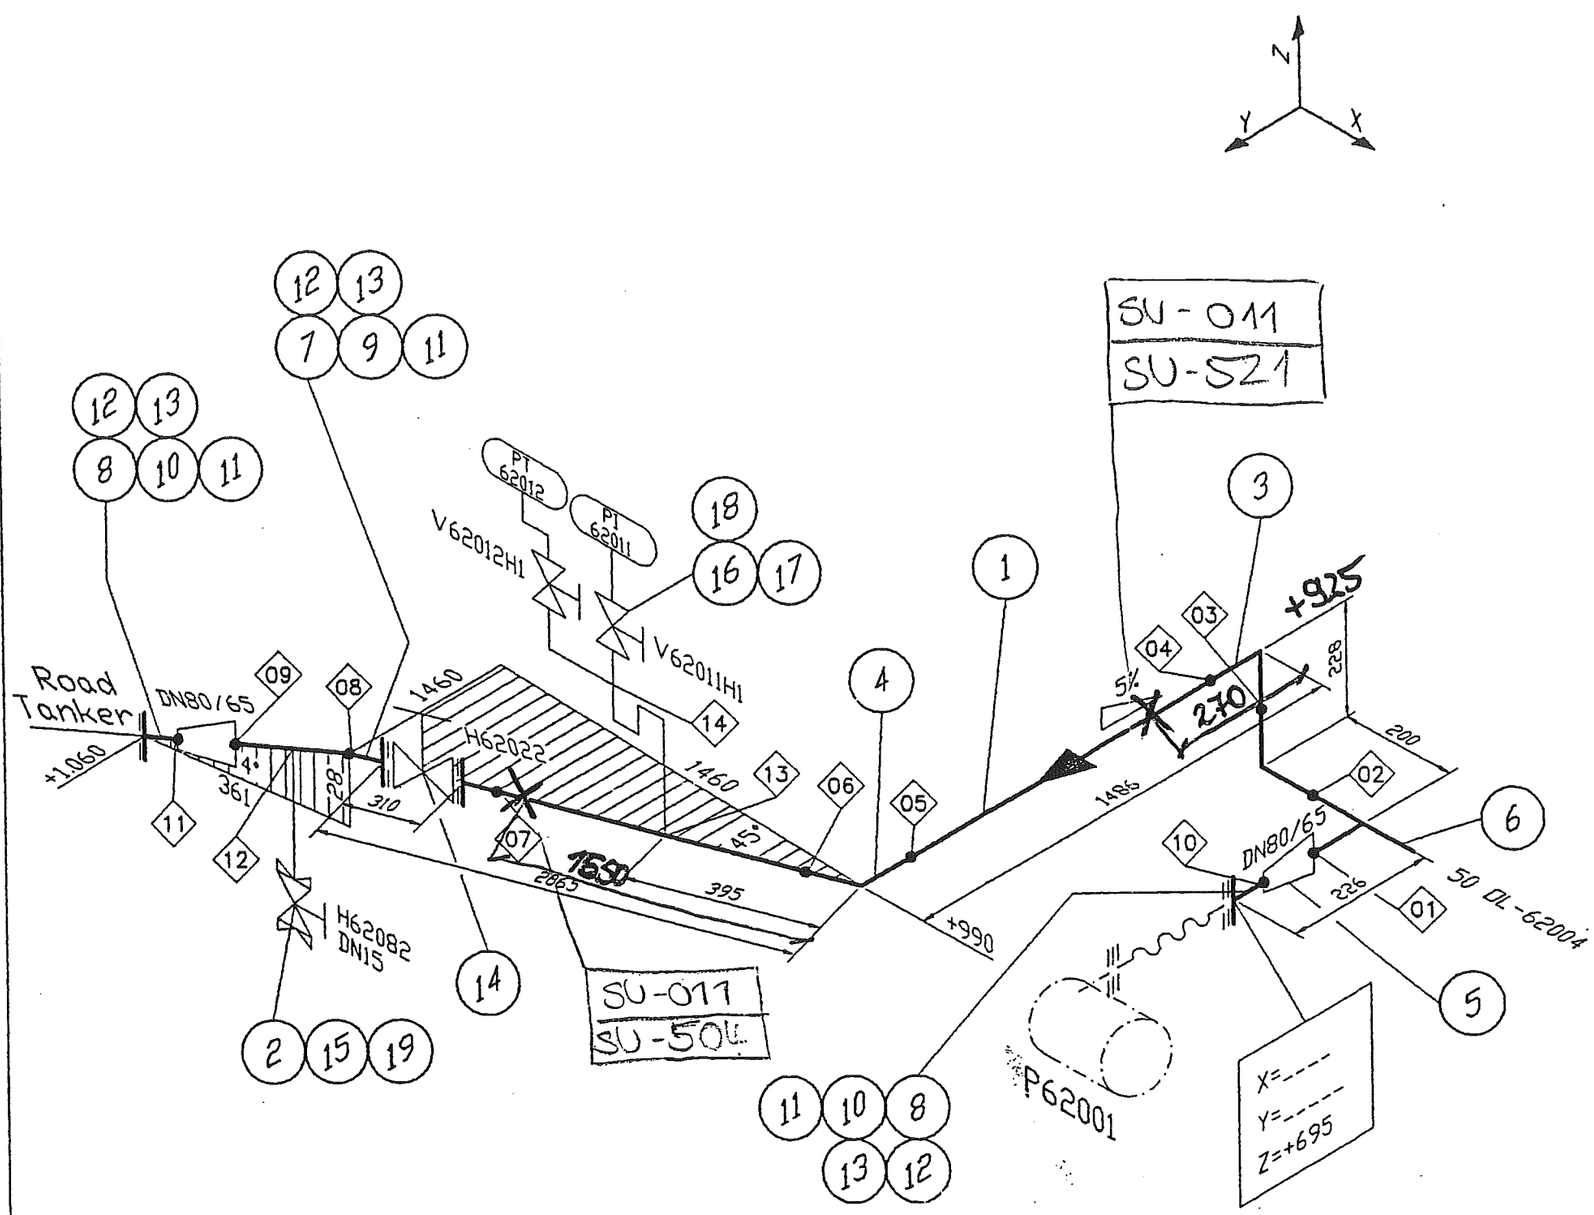

Welding No.	DN	Diameter	Welder No.	Protocoll No.
01	80	88,9	----	----
02	80	88,9	----	----
03	80	88,9	----	----
04	80	88,9	----	----
05	80	88,9	----	----
06	80	88,9	----	----
07	80	88,9	----	----
08	80	88,9	----	----
09	80	88,9	----	----
10	65	76,1	----	----
11	65	76,1	----	----
12	15	21,3	----	----
13		22	----	----
14		22	----	----

Remarks:

Responsibility of the assembling company:
- Situation of mounting seams
- Situation of pass-lengths
- Check of measure details and pipe courses on the construction site
- Situation of the spindle at valve

Accompanying drawings:

- 50 OL-62004 ZB40C1C

Accompanying lists:

- 80 OL-62003 ZB10C1C

Pipe standard:

- AL Standard No.: 50030

Attention:
Drawn by turning around 45°

AIR LIQUIDE	Date : 02.10.2004	Name : Reid./IES	Checked: Hr. Gans	History file: 79287106.doc
Air Liquide AGS GmbH	Job code: K70101		Scale --:--	Original format DIN A3
	Reference: ASU Kosice		Sheet: 001	of 001 Sheets
Replaces: 79_.-----	Title: 80 OL-62003		Drawing No.: 792.87106	Rev. ---
Replaced by: 79_.-----				

This drawing is protected by copyright.
It may not be copied or used without our written authorization and it is strictly prohibited to disclose it to any third parties.

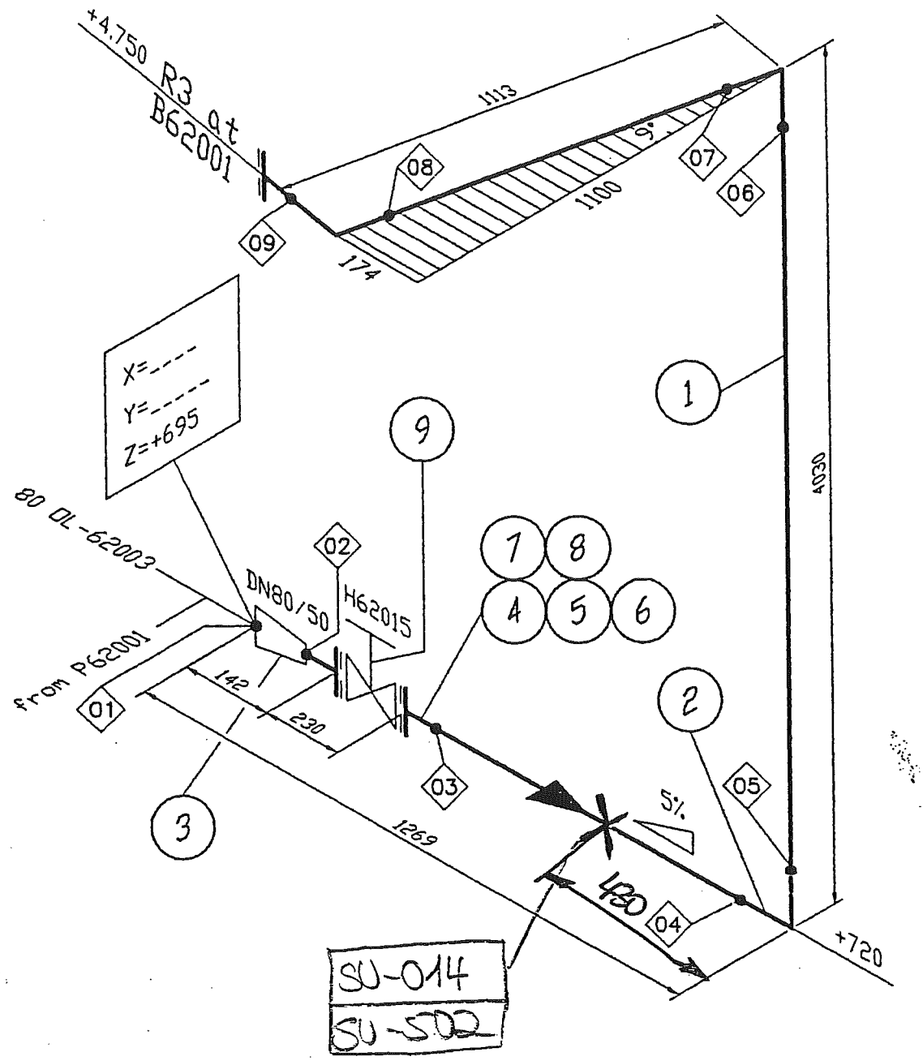

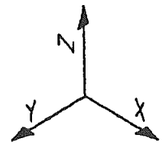

Welding No.	DN	Diameter	Welder No.	Protocoll No.
01	80	88,9	---	---
02	50	60,3	---	---
03	50	60,3	---	---
04	50	60,3	---	---
05	50	60,3	---	---
06	50	60,3	---	---
07	50	60,3	---	---
08	50	60,3	---	---
09	50	60,3	---	---

Remarks:

Responsibility of the assembling company:
- Situation of mounting seams
- Situation of pass-lengths
- Check of measure details and pipe courses on the construction site
- Situation of the spindle at valve

Accompanying drawings:

- 80 OL-62003 ZB10C1C

Accompanying lists:

- 50 OL-62004 ZB40C1C

Pipe standard:

- AL Standard No.: 50006

Attention:
Drawn by turning around 45°

AIR LIQUIDE	Date : 02.10.2004	Name : Reid./IES	Checked: Hr. Gans	History file: 79287106.doc
	Job code: K70101		Scale --:--	Original format DIN A3
Air Liquide AGS GmbH	Reference: ASU Kosice		Sheet: 001	of 001 Sheets
Replaces: 79_.____ Replaced by: 79_.-----	Title: 50 OL-62004		Drawing No.: 792.87106	Rev. ---

This drawing is protected by copyright.
It may not be copied or used without our written authorization and it is strictly prohibited to disclose it to any third parties.

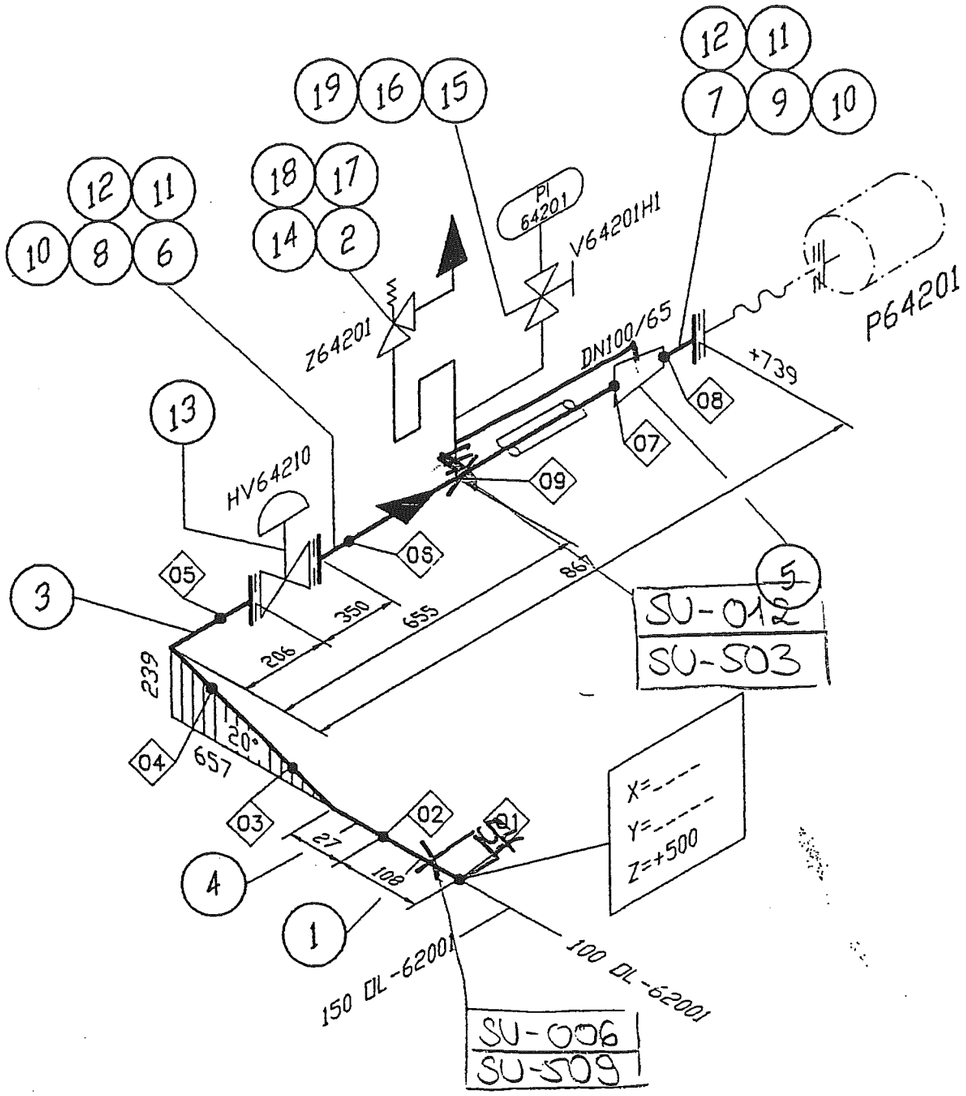

Welding No.	DN	Diameter	Welder No.	Protocoll No.
01	100	114,3	---	---
02	100	114,3	---	---
03	100	114,3	---	---
04	100	114,3	---	---
05	100	114,3	---	---
06	100	114,3	---	---
07	100	114,3	---	---
08	65	76,1	---	---
09		12	---	---

Remarks:

Responsibility of the assembling company:
- Situation of mounting seams
- Situation of pass-lengths
- Check of measure details and pipe courses on the construction site
- Situation of the spindle at valve

Accompanying drawings:

- 150 OL-62001 ZB10C1C
- 100 OL-62001 ZB10C1C

Accompanying lists:

- Parts list:
  100 OL-62005-ZB10C1C

Pipe standard:

- AL Standard No.:
  50030

Attention:
Drawn by turning around 45°

AIR LIQUIDE	Date : 27.10.2004	Name : Reid./IES	Checked: Hr. Gans	History file: 79287106.doc
	Job code: K70101		Scale --:--	Original format DIN A3
Air Liquide AGS GmbH	Reference: ASU Kosice		Sheet: 001	of 001 Sheets
Replaces: 79_.-----	Title: 100 OL-62005		Drawing No.: 792.87106	Rev. ---
Replaced by: 79_.-----				

This drawing is protected by copyright.
It may not be copied or used without our written authorization and it is strictly prohibited to disclose it to any third parties.

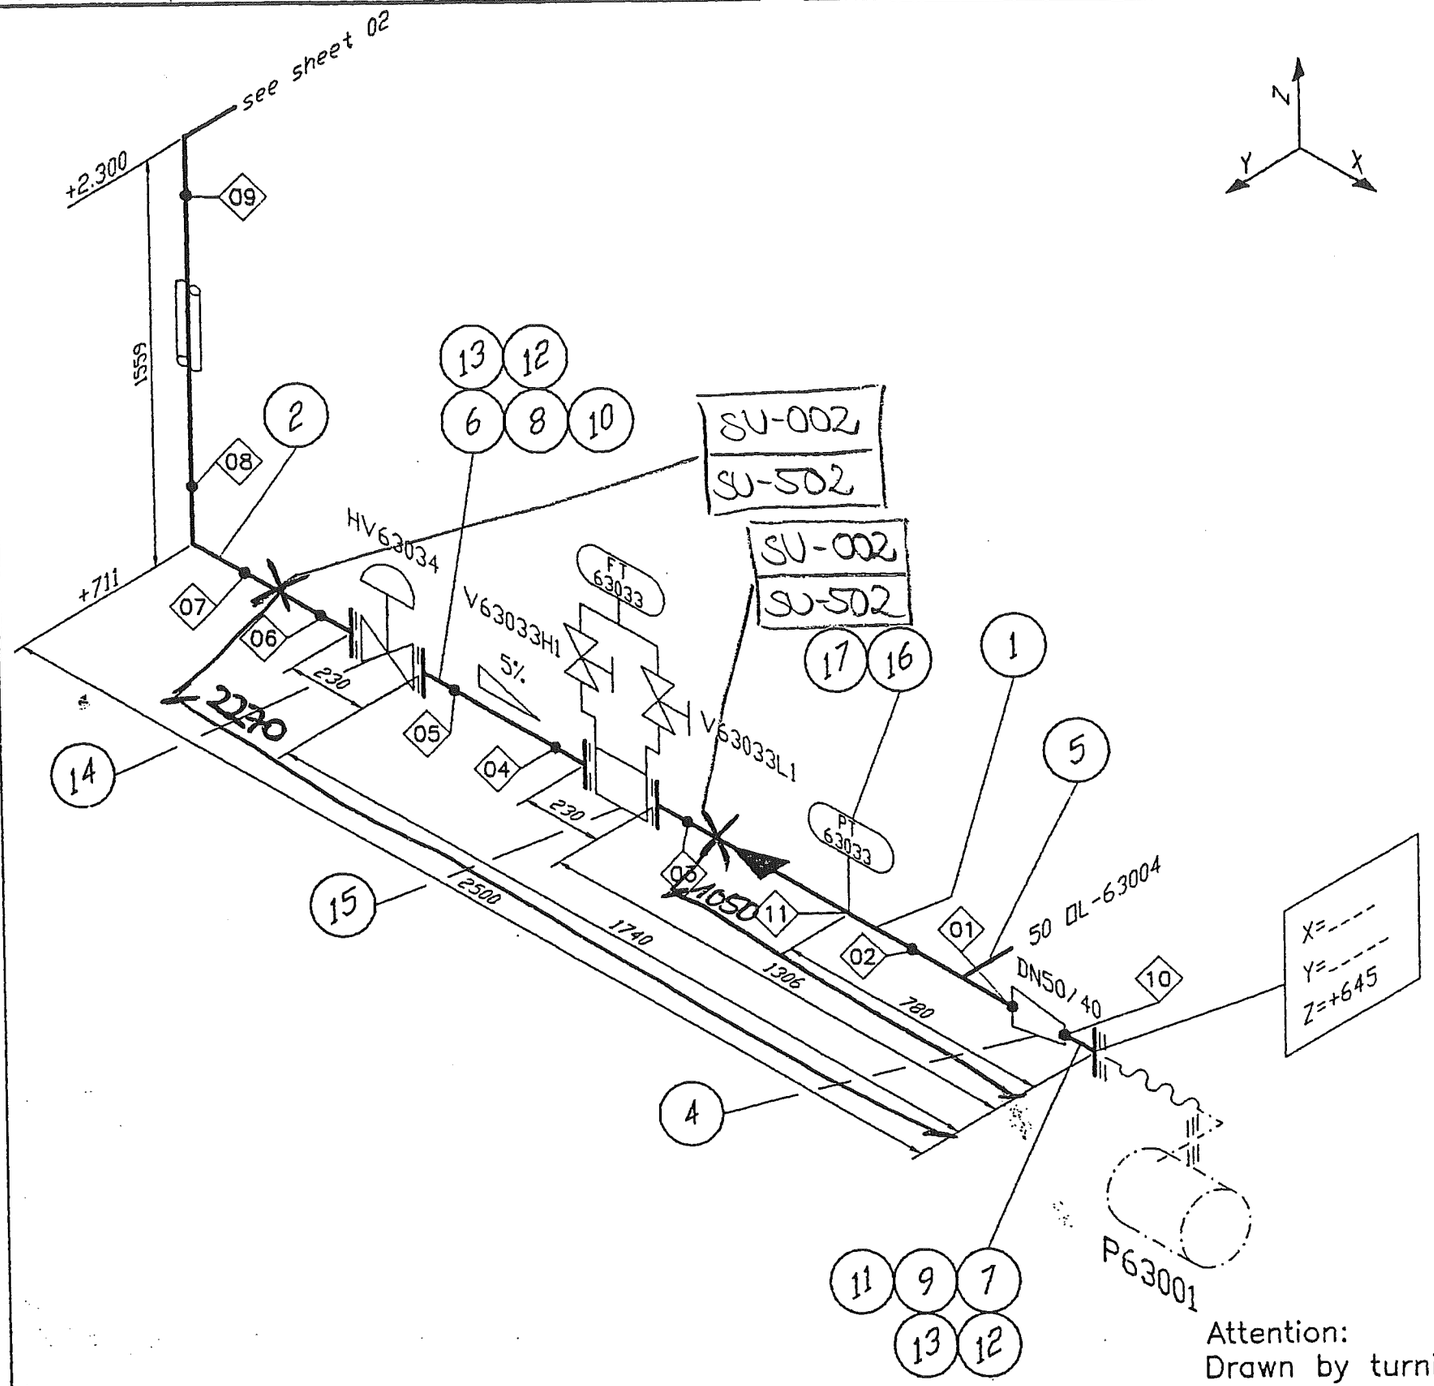

Welding No.	DN	Diameter	Welder No.	Protocoll No.
01	50	60,3	---	---
02	50	60,3	---	---
03	50	60,3	---	---
04	50	60,3	---	---
05	50	60,3	---	---
06	50	60,3	---	---
07	50	60,3	---	---
08	50	60,3	---	---
09	50	60,3	---	---
10	40	48,3	---	---
11		22	---	---

Remarks:

Responsibility of the assembling company:
- Situation of mounting seams
- Situation of pass-lengths
- Check of measure details and pipe courses on the construction site
- Situation of the spindle at valve

Accompanying drawings:

- 50 OL-63003 ZB10C1C Blatt 02
- 50 OL-63004 ZB40C1C

Accompanying lists:

- 50 OL-63003 ZB10C1C

Pipe standard:

- AL Standard No.: 50030

Attention:
Drawn by turning around 45°

AIR LIQUIDE	Date : 03.11.2004	Name : Reid./IES	Checked: Hr. Gans	History file: 79287106.doc
Air Liquide AGS GmbH	Job code: K70101	Reference: ASU Kosice	Scale --:--	Original format DIN A3
			Sheet: 001	of 002 Sheets
Replaces: 79_.____	Title: 50 OL-63003		Drawing No.: 792.87106	Rev. ___
Replaced by: 79_.-----				

This drawing is protected by copyright.
It may not be copied or used without our written authorization and it is strictly prohibited to disclose it to any third parties.

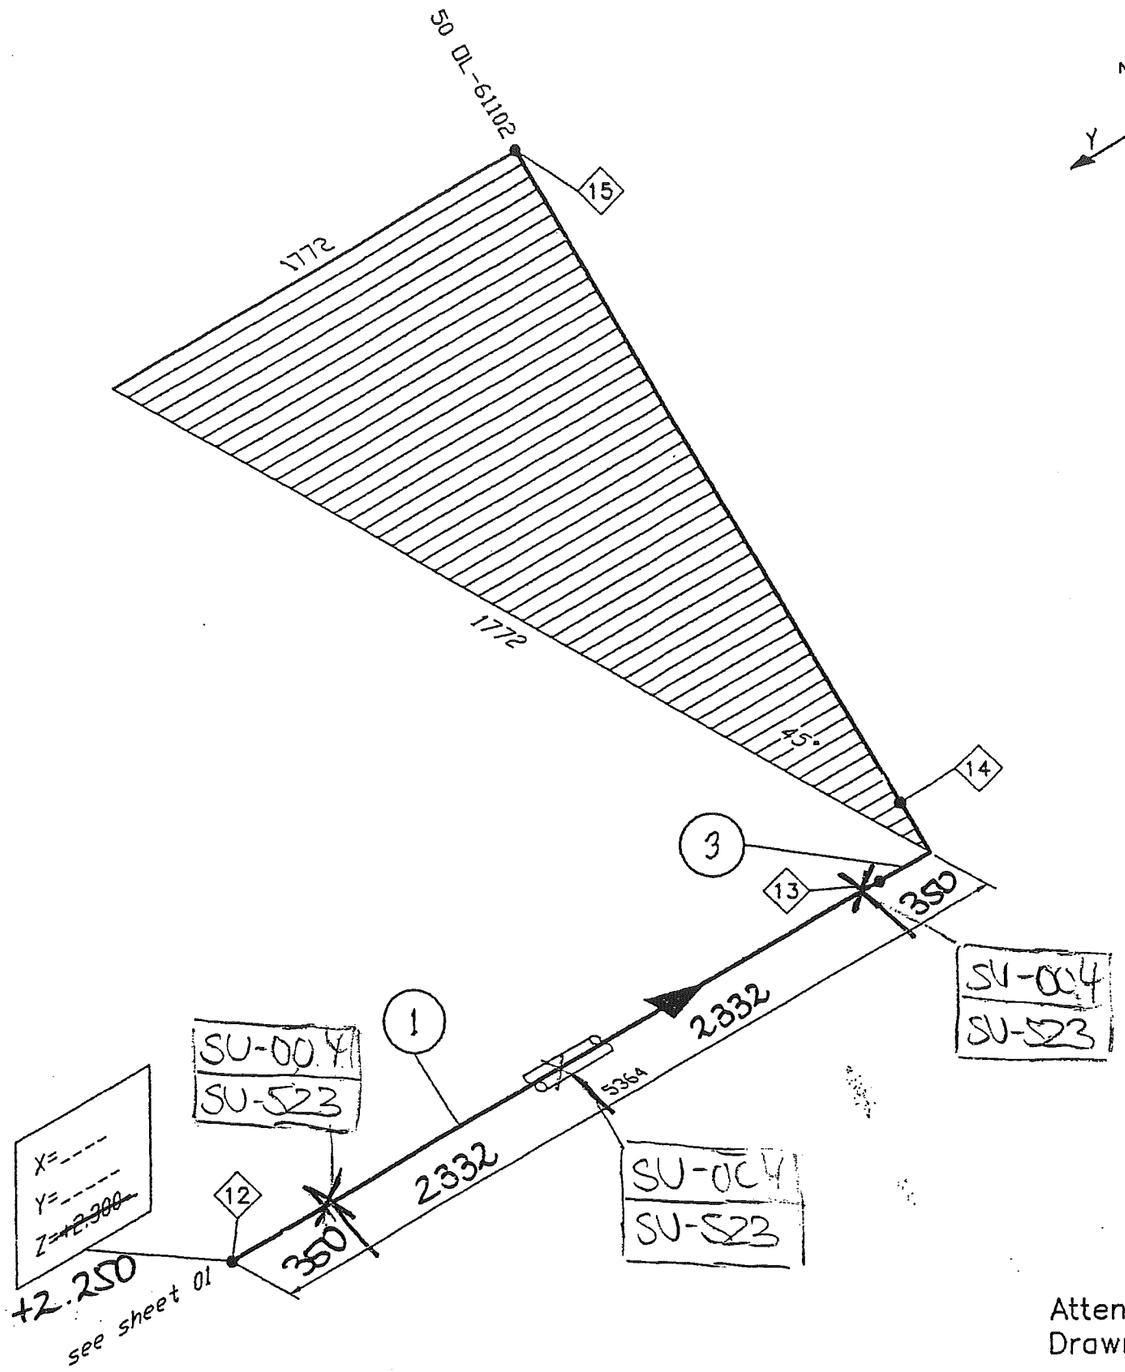

Welding No.	DN	Diameter	Welder No.	Protocoll No.
12	50	60,3	---	---
13	50	60,3	---	---
14	50	60,3	---	---
15	50	60,3	---	---

Remarks:

Responsibility of the assembling company:
- Situation of mounting seams
- Situation of pass-lengths
- Check of measure details and pipe courses on the construction site
- Situation of the spindle at valve

Accompanying drawings:

- 50 OL-63003 ZB10C1C Blatt 01
- 50 OL-61102 ZB10C1C

Accompanying lists:

- 50 OL-63003 ZB10C1C

Pipe standard:

- AL Standard No.: 50030

Attention:

Drawn by turning around 45°

AIR LIQUIDE	Date : 03.11.2004	Name : Reid./IES	Checked: Hr. Gans	History file: 79287106.doc
	Job code: K70101		Scale --:--	Original format DIN A3
Air Liquide AGS GmbH	Reference: ASU Kosice		Sheet: 002	of 002 Sheets
Replaces: 79_.----- Replaced by: 79_.-----	Title: 50 OL-63003		Drawing No.: 792.87106	Rev. ---

this drawing is protected by copyright.
It may not be copied or used without our written authorization and it is strictly prohibited to disclose it to any third parties.

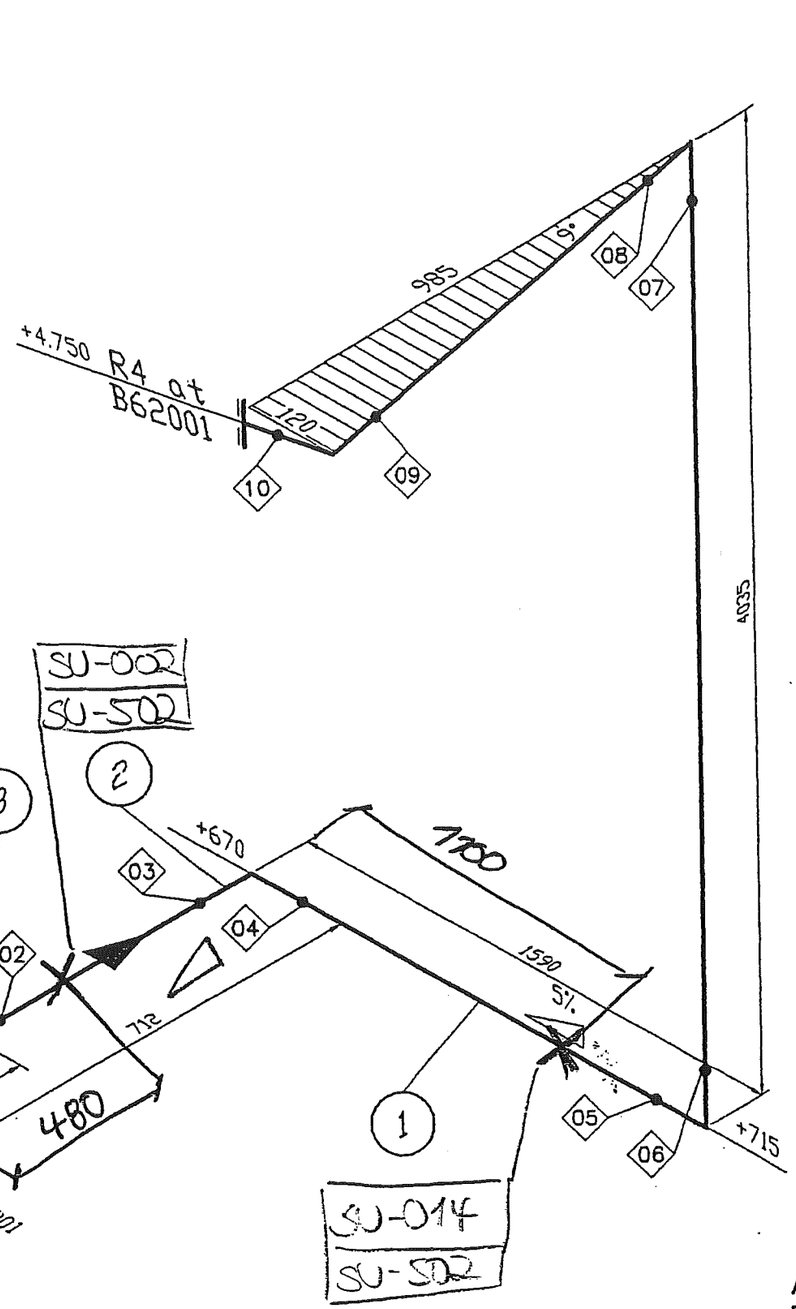

Welding No.	DN	Diameter	Welder No.	Protocoll No.
01	50	60,3	---	---
02	50	60,3	---	---
03	50	60,3	---	---
04	50	60,3	---	---
05	50	60,3	---	---
06	50	60,3	---	---
07	50	60,3	---	---
08	50	60,3	---	---
09	50	60,3	---	---
10	50	60,3	---	---

Remarks:

Responsibility of the assembling company:
- Situation of mounting seams
- Situation of pass-lengths
- Check of measure details and pipe courses on the construction site
- Situation of the spindle at valve

Accompanying drawings:

- 50 OL-63004 ZB40C1C

Accompanying lists:

- 50 OL-63003 ZB10C1C

Pipe standard:

- AL Standard No.: 50006

Attention:

Drawn by turning around 45°

AIR LIQUIDE	Date : 02.11.2004	Name : Reid./IES	Checked: Hr. Gans	History file: 79287106.doc
	Job code: K70101		Scale --:--	Original format DIN A3
Air Liquide AGS GmbH	Reference: ASU Kosice		Sheet: 001	of 001 Sheets
Replaces: 79_.____	Title: 50 OL-63004		Drawing No.: 792.87106	Rev. ---
Replaced by: 79_.-----				

This drawing is protected by copyright.
It may not be copied or used without our written authorization and it is strictly prohibited to disclose it to any third parties.

Welding No.	DN	Diameter	Welder No.	Protocoll No.
01	80	88,9	----	----
02	80	88,9	----	----
03	80	88,9	----	----
04		12	----	----

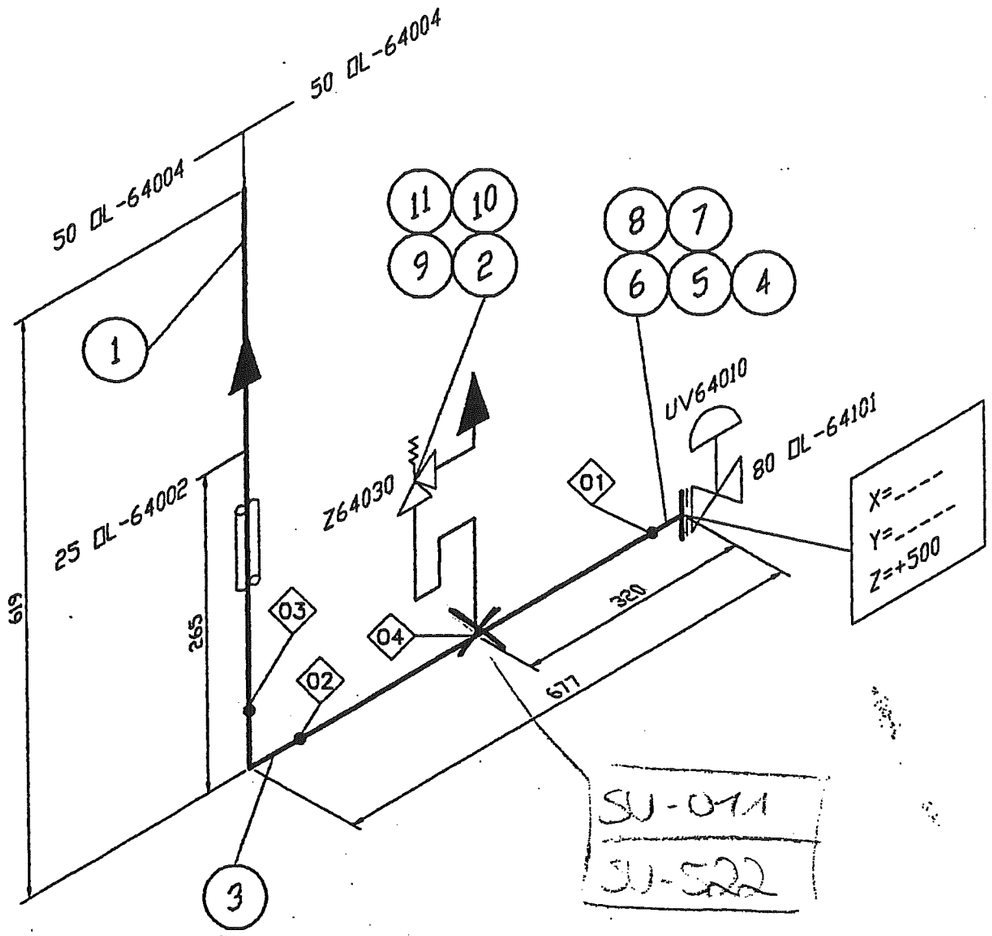

Remarks:

Responsibility of the assembling company:
- Situation of mounting seams
- Situation of pass-lengths
- Check of measure details and pipe courses on the construction site
- Situation of the spindle at valve

Accompanying drawings:

- 80 OL-64101 ZB40C1C Blatt 02
- 50 OL-64004 ZB40C1
- 25 OL-64002 ZB40C1

Accompanying lists:

- 80 OL-64001 ZB40C1

Pipe standard:

- AL Standard No.: 50006

AIR LIQUIDE	Date : 04.11.2004	Name : Reid./IES	Checked: Hr. Gans	History file: 79287106.doc
Air Liquide AGS GmbH	Job code: K70101	Reference: ASU Kosice	Scale --:--	Original format DIN A3
Replaces: 79_.____			Sheet: 001	of 001 Sheets
Replaced by: 79_.-----	Title: 80 OL-64001		Drawing No.: 792.87106	Rev. ___

This drawing is protected by copyright.
It may not be copied or used without our written authorization and it is strictly prohibited to disclose it to any third parties.

Welding No.	DN	Diameter	Welder No.	Protocoll No.
01	25	33,7	___	___
02	25	33,7	___	___
03	25	33,7	___	___
04	25	33,7	___	___
05	25	33,7	___	___

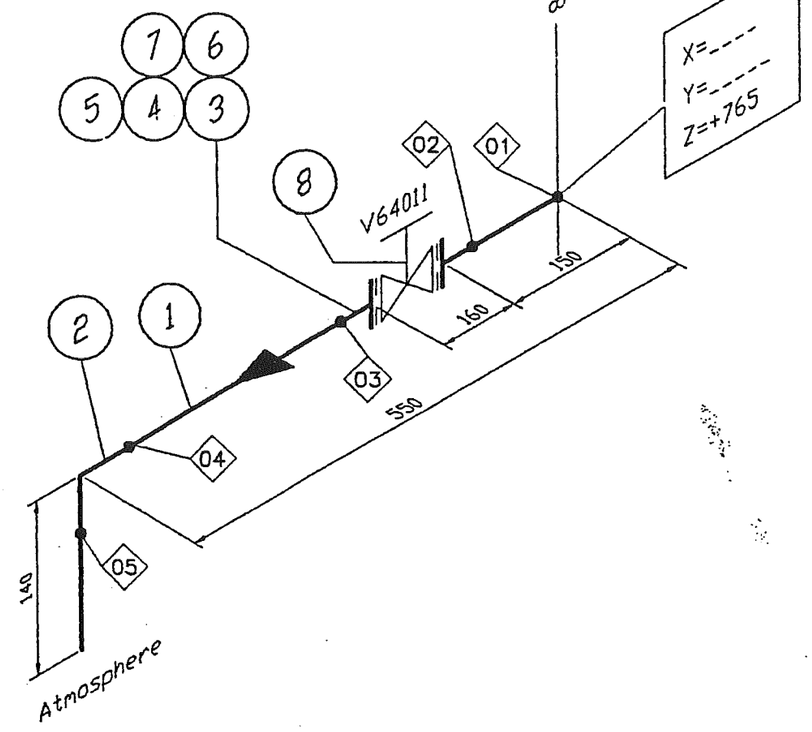

Remarks:

Responsibility of the assembling company:
- Situation of mounting seams
- Situation of pass-lengths
- Check of measure details and pipe courses on the construction site
- Situation of the spindle at valve

Accompanying drawings:

- 80 OL-64001 ZB40C1

Accompanying lists:

- 25 OL-64002 ZB40C1

Pipe standard:

- AL Standard No.: 50006

AIR LIQUIDE	Date : 08.11.2004	Name : Reid./IES	Checked: Hr. Gans	History file: 79287106.doc
Air Liquide AGS GmbH	Job code: K70101	Reference: ASU Kosice	Scale --:--	Original format DIN A3
			Sheet: 001	of 001 Sheets
Replaces: 79_.____	Title: 25 OL-64002		Drawing No.: 792.87106	Rev. ___
Replaced by: 79_.-----				

This drawing is protected by copyright.
It may not be copied or used without our written authorization and it is strictly prohibited to disclose it to any third parties.

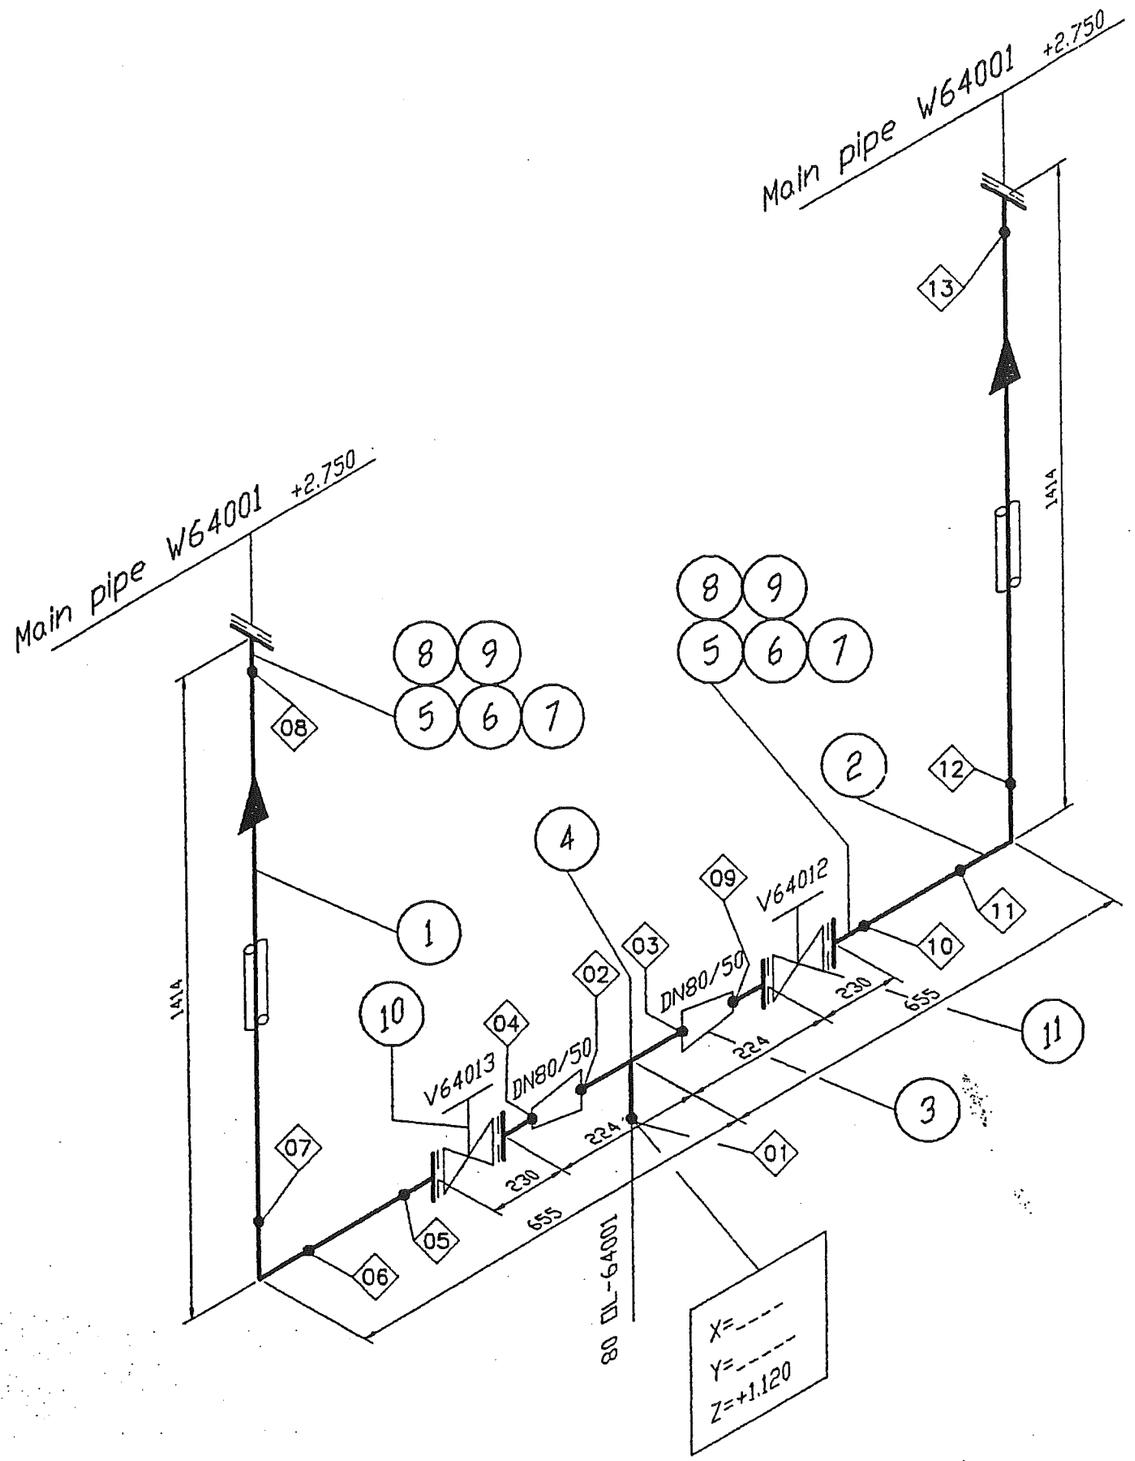

Welding No.	DN	Diameter	Welder No.	Protocoll No.
01	80	88,9	---	---
02	80	88,9	---	---
03	80	88,9	---	---
04	50	60,3	---	---
05	50	60,3	---	---
06	50	60,3	---	---
07	50	60,3	---	---
08	50	60,3	---	---
09	50	60,3	---	---
10	50	60,3	---	---
11	50	60,3	---	---
12	50	60,3	---	---
13	50	60,3	---	---

Remarks:

Responsibility of the assembling company:
- Situation of mounting seams
- Situation of pass-lengths
- Check of measure details and pipe courses on the construction site
- Situation of the spindle at valve

Accompanying drawings:

- 80 OL-64001 ZB40C1

Accompanying lists:

- 50 OL-64004 ZB40C1

Pipe standard:

- AL Standard No.: 50006

AIR LIQUIDE

Air Liquide AGS GmbH

Replaces: 79_.-----
Replaced by: 79_.-----

Date :	Name :	Checked:	History file:
08.11.2004	Reid./IES	Hr. Gans	79287106.doc

Job code: K70101
Reference: ASU Kosice

Scale --:--
Original format DIN A3
Sheet: 001 of 001 Sheets

Title: 50 OL-64004

Drawing No.: 792.87106
Rev. ---

This drawing is protected by copyright.
It may not be copied or used without our written authorization and it is strictly prohibited to disclose it to any third parties.

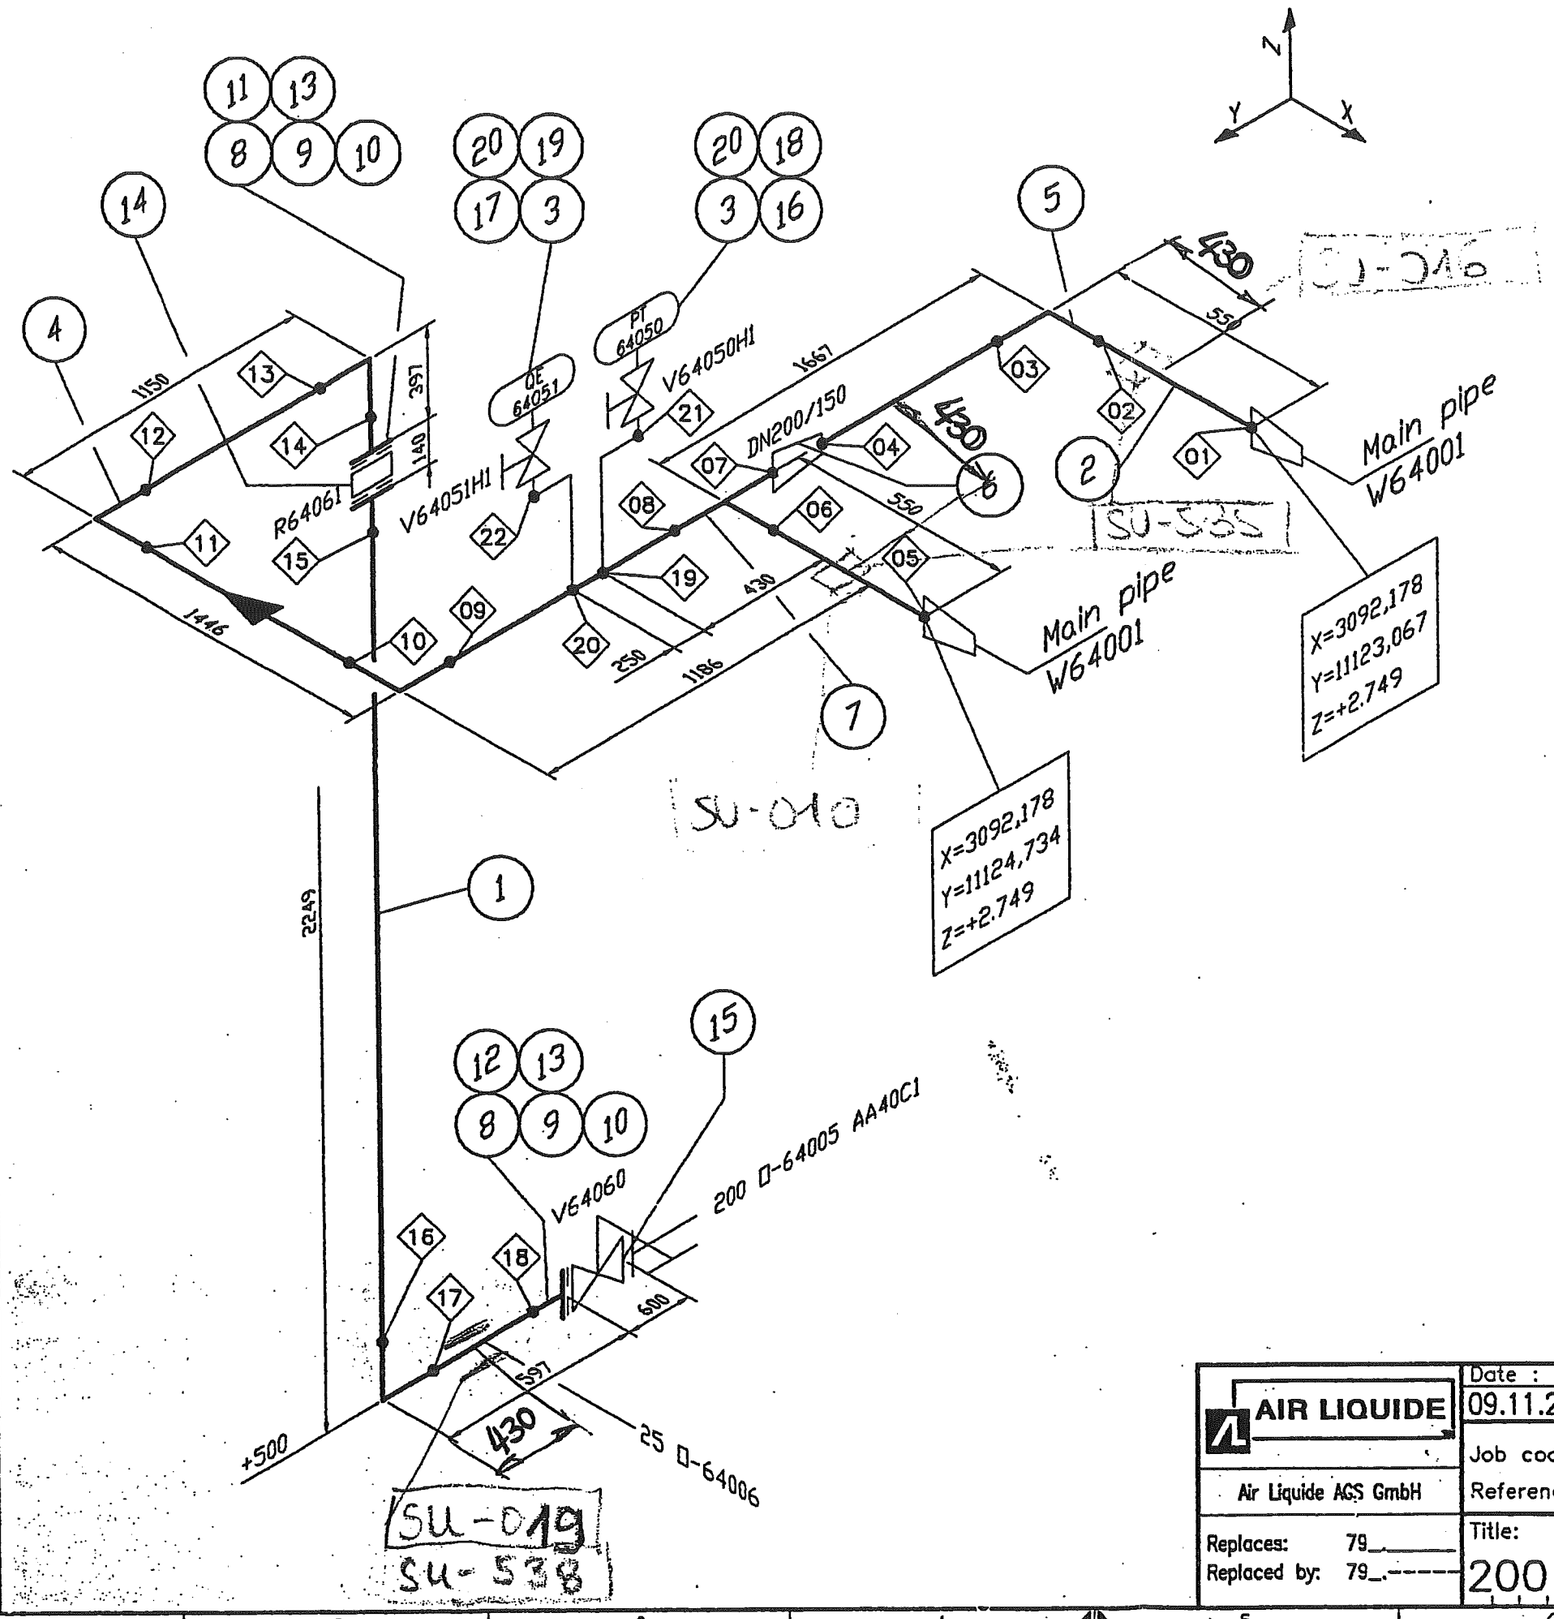

Welding No.	DN	Diameter	Welder No.	Protocoll No.
01	150	168,3	___	___
02	150	168,3	___	___
03	150	168,3	___	___
04	150	168,3	___	___
05	150	168,3	___	___
06	150	168,3	___	___
07	200	219,1	___	___
08	200	219,1	___	___
09	200	219,1	___	___
10	200	219,1	___	___
11	200	219,1	___	___
12	200	219,1	___	___
13	200	219,1	___	___
14	200	219,1	___	___
15	200	219,1	___	___
16	200	219,1	___	___
17	200	219,1	___	___
18	200	219,1	___	___
19	15	21,3	___	___
20	15	21,3	___	___
21		22	___	___
22		22	___	___

Remarks:

Responsibility of the assembling company:
- Situation of mounting seams
- Situation of pass-lengths
- Check of measure details and pipe courses on the construction site
- Situation of the spindle at valve

Accompanying drawings:

- 200 0-64005 AA40C1
- 25 0-64006 ZB40C2-Monel

Accompanying lists:

- 200 0-64005 ZB40C1

Pipe standard:

- AL Standard No.: 50006

AIR LIQUIDE	Date : 09.11.2004	Name : Reid./IES	Checked: Hr. Gans	History file: 79287106.doc
Air Liquide AGS GmbH	Job code: K70101	Reference: ASU Kosice	Scale --:--	Original format DIN A3
Replaces: 79_____ Replaced by: 79_-----	Sheet: 001	of 001 Sheets	Title: 200 0-64005 ZB40	Drawing No.: 792.87106 Rev. ___

This drawing is protected by copyright.
It may not be copied or used without our written authorization and it is strictly prohibited to disclose it to any third parties.

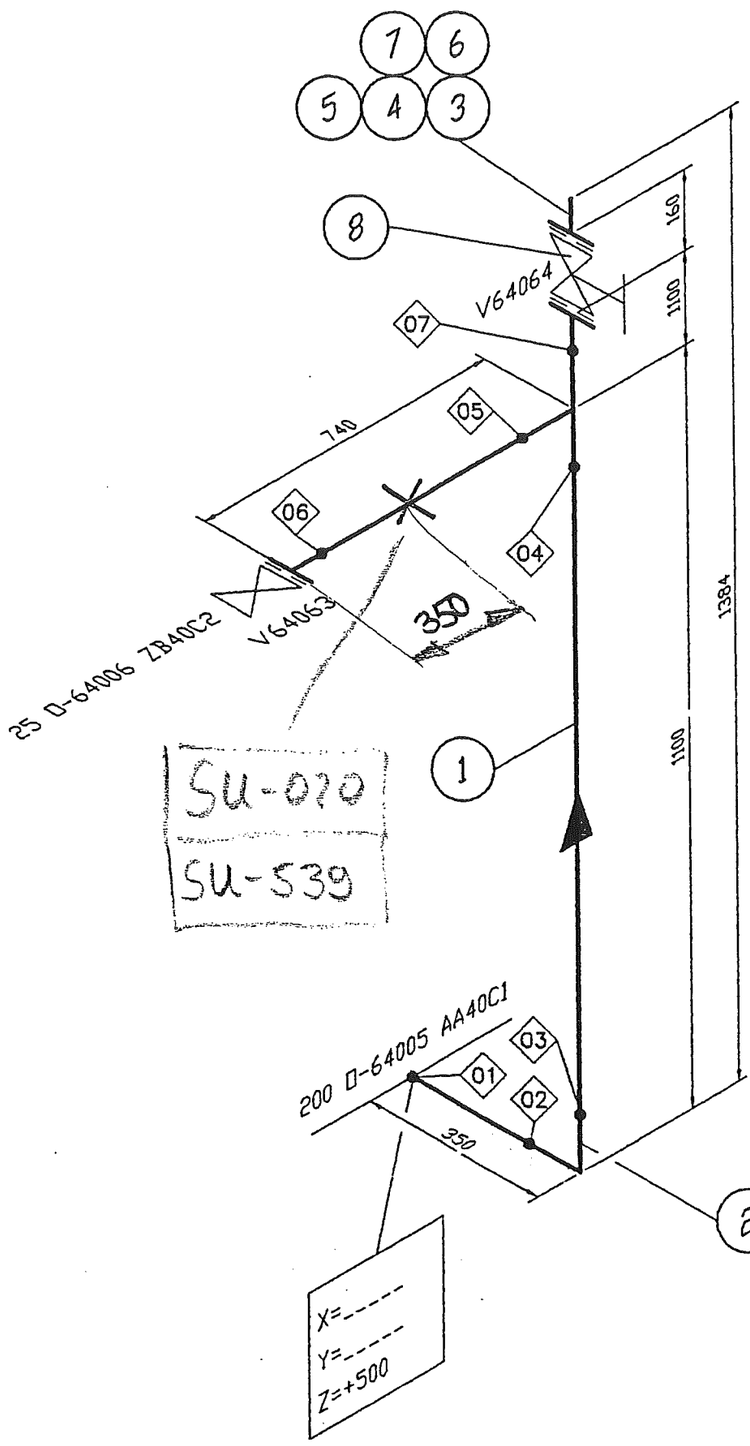

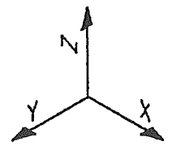

Welding No.	DN	Diameter	Welder No.	Protocoll No.
01	25	33,7	___	___
02	25	33,7	___	___
03	25	33,7	___	___
04	25	33,7	___	___
05	25	33,7	___	___
06	25	33,7	___	___
07	25	33,7	___	___

Remarks:

Responsibility of the assembling company:
- Situation of mounting seams
- Situation of pass-lengths
- Check of measure details and pipe courses on the construction site
- Situation of the spindle at valve

Accompanying drawings:

- 200 O-64005 AA40C1
- 25 O-64006 ZB40C2-Monel

Accompanying lists:

- 25 O-64006 AA40C1

Pipe standard:

- AL Standard No.: 50013

AIR LIQUIDE	Date : 09.11.2004	Name : Reid./IES	Checked: Hr. Gans	History file: 79287106.doc
	Job code: K70101		Scale --:--	Original format DIN A3
Air Liquide AGS GmbH	Reference: ASU Kosice		Sheet: 001	of 001 Sheets
Replaces: 79_._____ Replaced by: 79_._-----	Title: 25 O-64006 AA40		Drawing No.: 792.87106	Rev. ___

This drawing is protected by copyright.
It may not be copied or used without our written authorization and it is strictly prohibited to disclose it to any third parties.

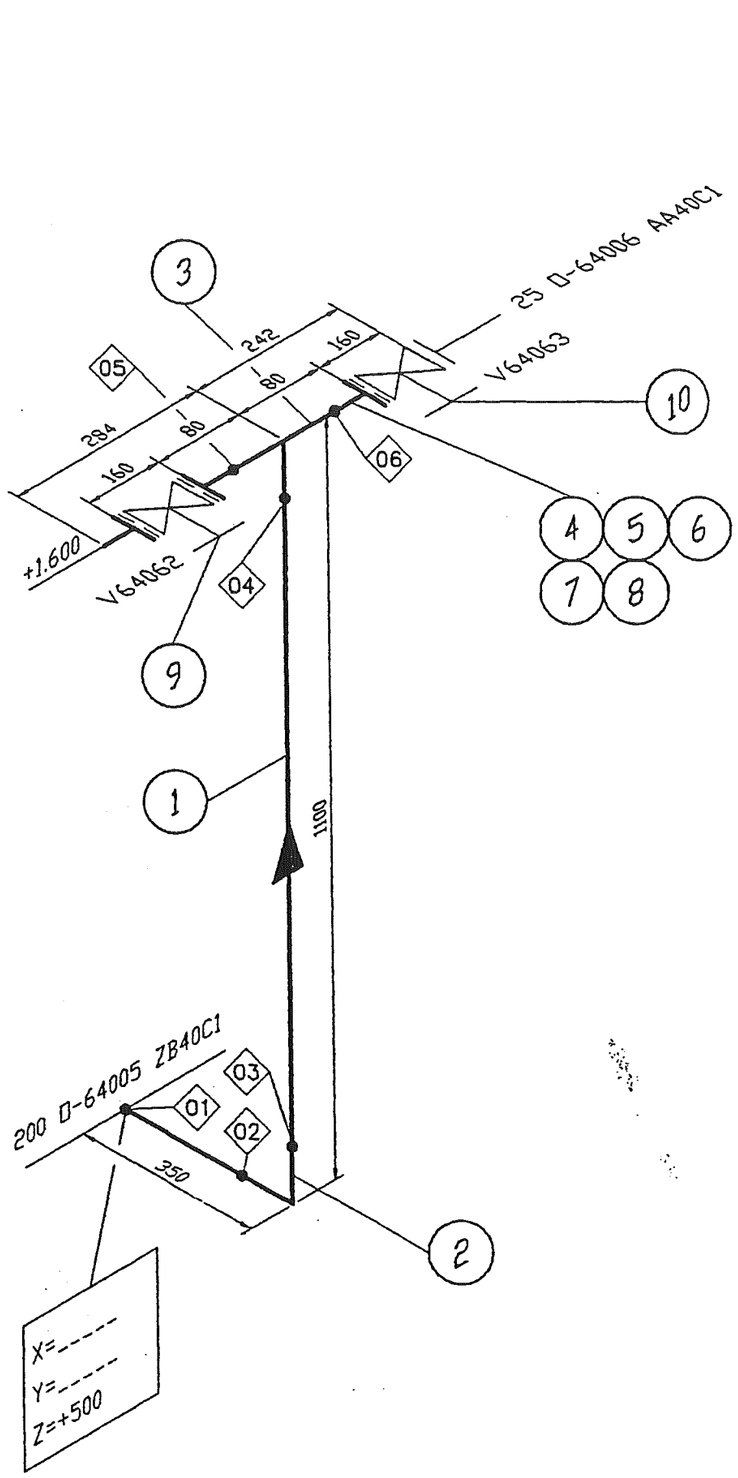

Welding No.	DN	Diameter	Welder No.	Protocoll No.
01	25	33,7	---	---
02	25	33,7	---	---
03	25	33,7	---	---
04	25	33,7	---	---
05	25	33,7	---	---
06	25	33,7	---	---

Remarks:

Responsibility of the assembling company:
- Situation of mounting seams
- Situation of pass-lengths
- Check of measure details and pipe courses on the construction site
- Situation of the spindle at valve

Accompanying drawings:

- 200 0-64005 ZB40C1
- 25 0-64006 AA40C

Accompanying lists:

- 25 0-64006 ZB40C2-Monel

Pipe standard:

- AL Standard No.: 500__

AIR LIQUIDE	Date : 09.11.2004	Name : Reid./IES	Checked: Hr. Gans	History file: 79287106.doc
Air Liquide AGS GmbH	Job code: K70101	Reference: ASU Kosice	Scale --:--	Original format DIN A3
			Sheet: 001	of 001 Sheets
Replaces: 79_.-----	Title: 25 0-64006 ZB40		Drawing No.: 792.87106	Rev. ---
Replaced by: 79_.-----				

This drawing is protected by copyright.
It may not be copied or used without our written authorization and it is strictly prohibited to disclose it to any third parties.

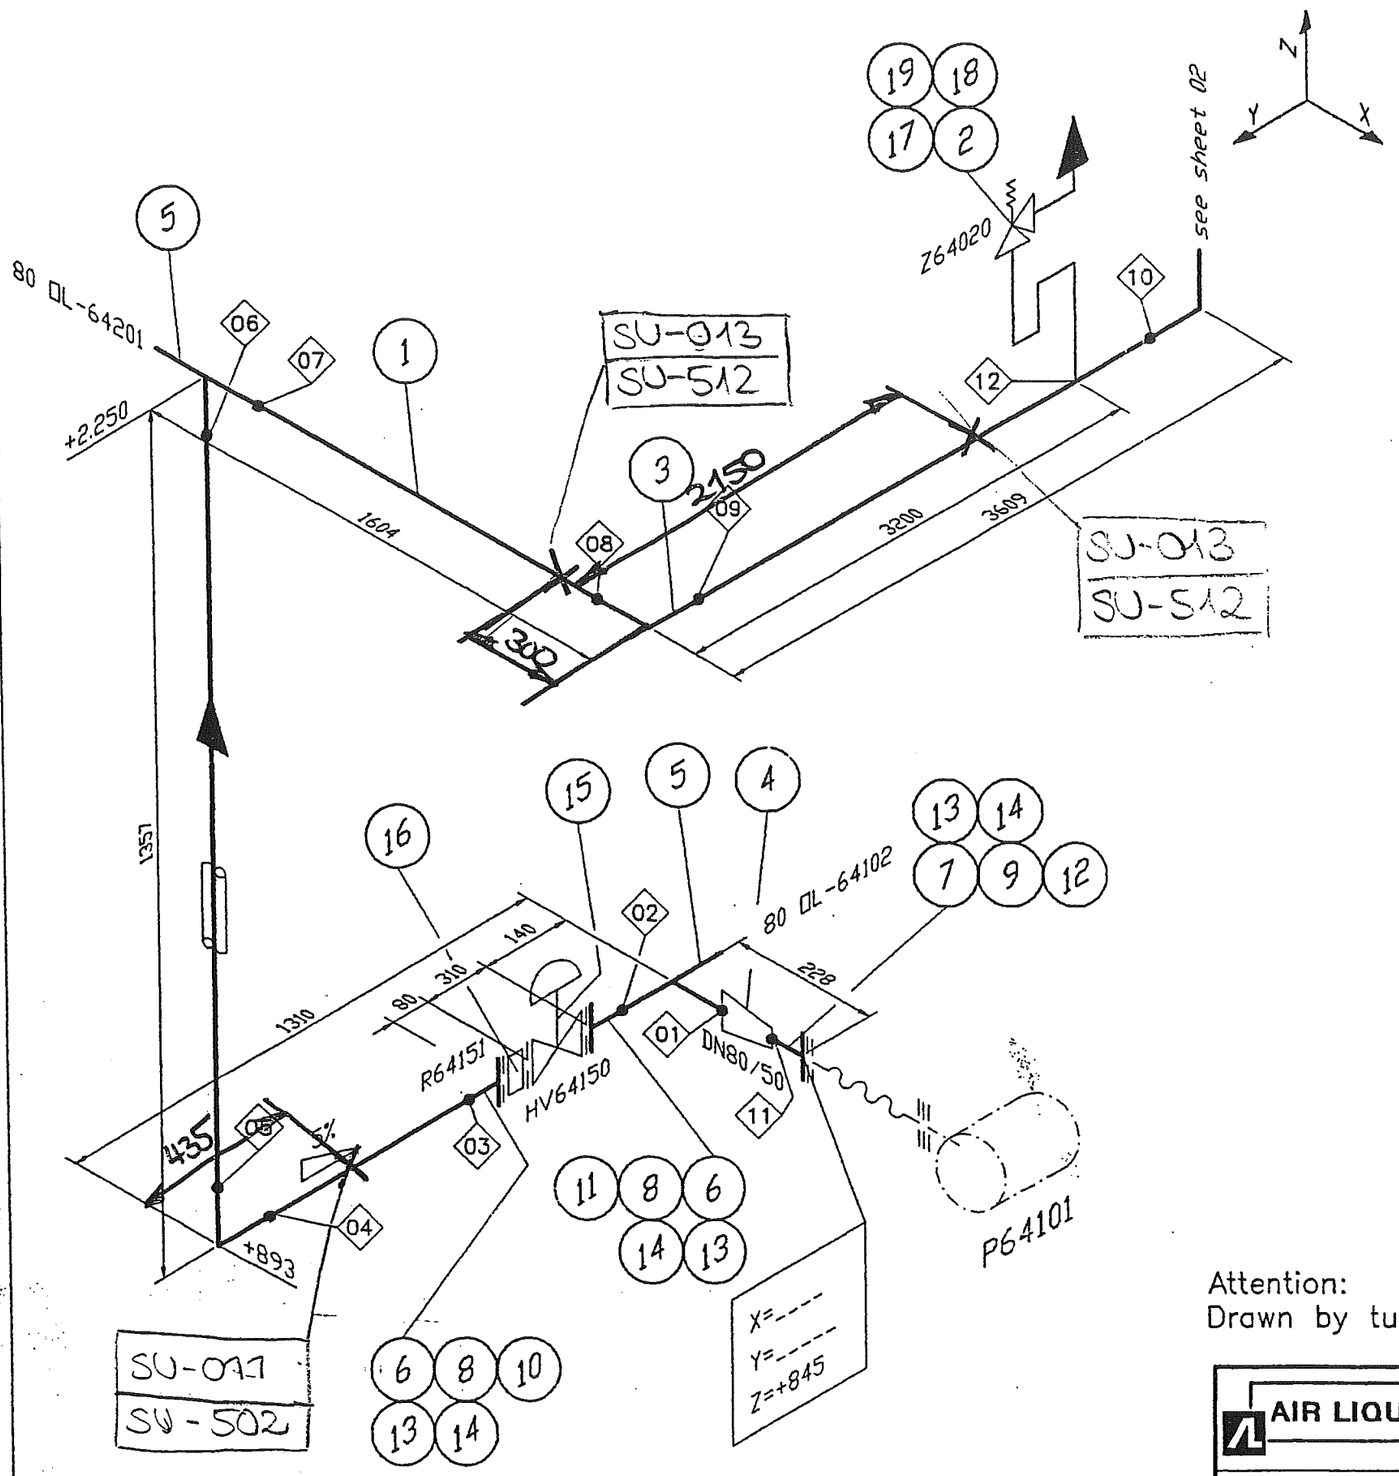

Welding No.	DN	Diameter	Welder No.	Protocoll No.
01	80	88,9	___	___
02	80	88,9	___	___
03	80	88,9	___	___
04	80	88,9	___	___
05	80	88,9	___	___
06	80	88,9	___	___
07	80	88,9	___	___
08	80	88,9	___	___
09	80	88,9	___	___
10	80	88,9	___	___
11	50	60,3	___	___
12		12	___	___

Remarks:

Responsibility of the assembling company:
- Situation of mounting seams
- Situation of pass-lengths
- Check of measure details and pipe courses on the construction site
- Situation of the spindle at valve

Accompanying drawings:

- 80 OL-64101 ZB40C1C Blatt 02
- 80 OL-64102 ZB40C1C
- 80 OL-64201 ZB40C1C

Accompanying lists:

- 80 OL-64101 ZB40C1C

Pipe standard:

- AL Standard No.: 50006

Attention:
Drawn by turning around 45°

AIR LIQUIDE	Date : 04.11.2004	Name : Reid./IES	Checked: Hr. Gans	History file: 79287106.doc
	Job code: K70101		Scale --:--	Original format DIN A3
Air Liquide AGS GmbH	Reference: ASU Kosice		Sheet: 001	of 002 Sheets
Replaces: 79_.____	Title:		Drawing No.:	Rev.
Replaced by: 79_.-----	80 OL-64101		792.87106	___

This drawing is protected by copyright.
It may not be copied or used without our written authorization and it is strictly prohibited to disclose it to any third parties.

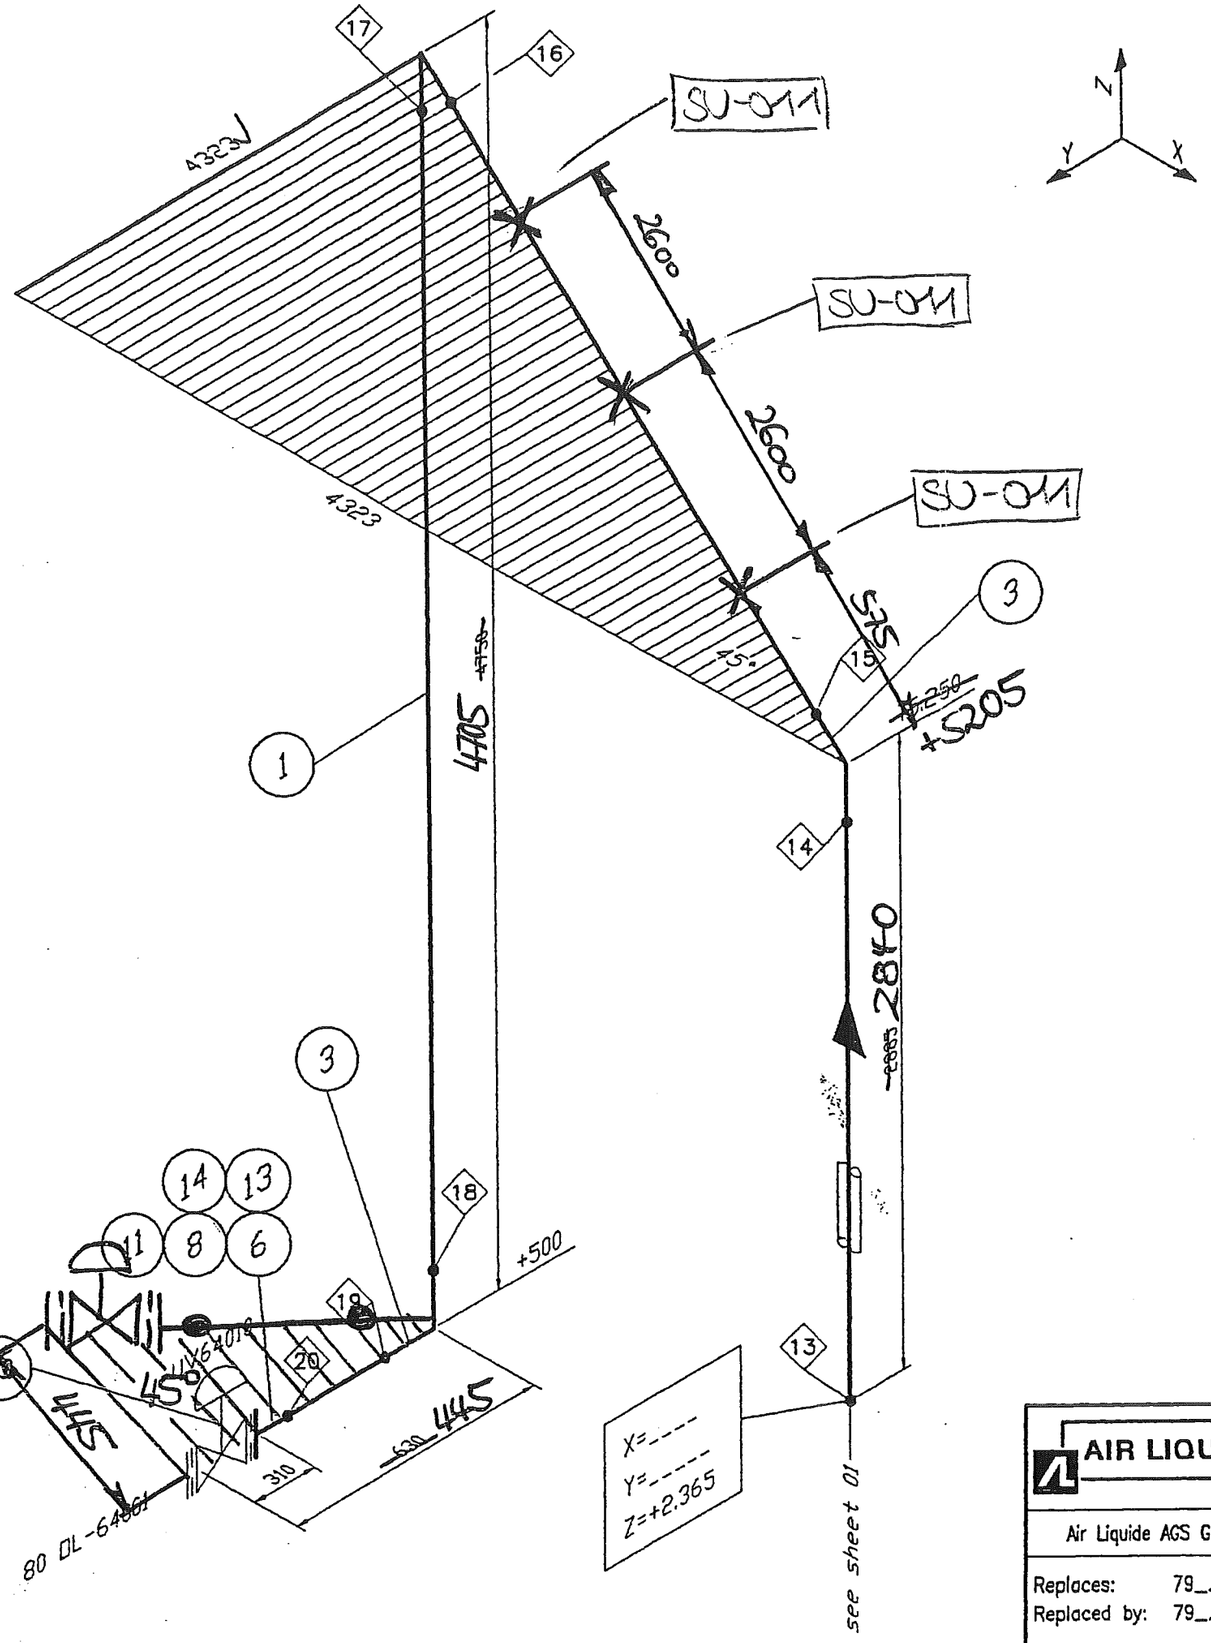

Welding No.	DN	Diameter	Welder No.	Protocoll No.
13	80	88,9	---	---
14	80	88,9	---	---
15	80	88,9	---	---
16	80	88,9	---	---
17	80	88,9	---	---
18	80	88,9	---	---
19	80	88,9	---	---
20	80	88,9	---	---

Remarks:

Responsibility of the assembling company:
- Situation of mounting seams
- Situation of pass-lengths
- Check of measure details and pipe courses on the construction site
- Situation of the spindle at valve

Accompanying drawings:

- 80 0L-64101 ZB40C1C Blatt 01
- 80 0L-64001 ZB40C1

Accompanying lists:

- 80 0L-64101 ZB40C1C

Pipe standard:

- AL Standard No.: 50006

AIR LIQUIDE	Date : 04.11.2004	Name : Reid./IES	Checked: Hr. Gans	History file: 79287106.doc
	Job code: K70101		Scale --:--	Original format DIN A3
Air Liquide AGS GmbH	Reference: ASU Kosice		Sheet: 002	of 002 Sheets
Replaces: 79_.____	Title: 80 0L-64101		Drawing No.: 792.87106	Rev. ---
Replaced by: 79_.----				

This drawing is protected by copyright.
It may not be copied or used without our written authorization and it is strictly prohibited to disclose it to any third parties.

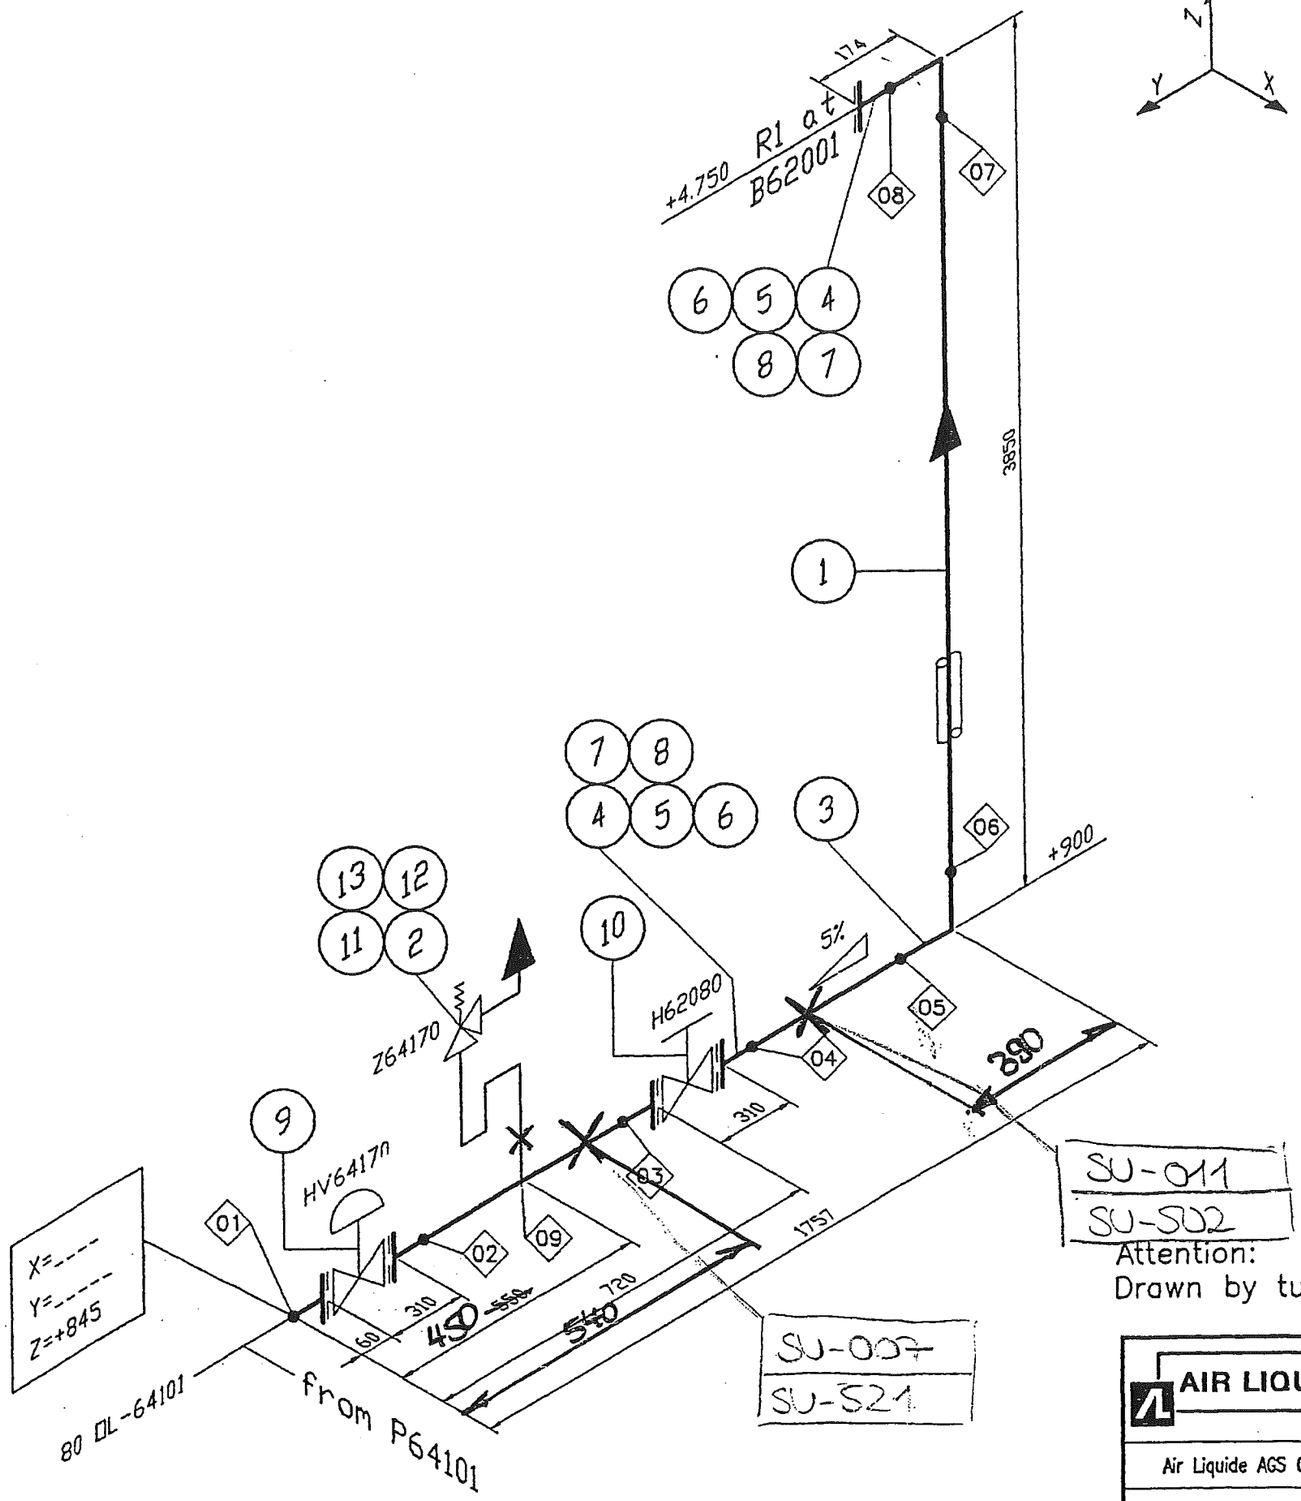

Welding No.	DN	Diameter	Welder No.	Protocoll No.
01	80	88,9	---	---
02	80	88,9	---	---
03	80	88,9	---	---
04	80	88,9	---	---
05	80	88,9	---	---
06	80	88,9	---	---
07	80	88,9	---	---
08	80	88,9	---	---
09		12	---	---

Remarks:

Responsibility of the assembling company:
- Situation of mounting seams
- Situation of pass-lengths
- Check of measure details and pipe courses on the construction site
- Situation of the spindle at valve

Accompanying drawings:

- 80 OL-64101 ZB40C1C

Accompanying lists:

- 80 OL-64102 ZB40C1C

Pipe standard:

- AL Standard No.: 50006

Attention:
Drawn by turning around 45°

AIR LIQUIDE	Date : 04.11.2004	Name : Reid./IES	Checked: Hr. Gans	History file: 79287106.doc
	Job code: K70101		Scale --:--	Original format DIN A3
Air Liquide AGS GmbH	Reference: ASU Kosice		Sheet: 001	of 001 Sheets
Replaces: 79_.____	Title:		Drawing No.:	Rev.
Replaced by: 79_.-----	80 OL-64102		792.87106	---

This drawing is protected by copyright.
It may not be copied or used without our written authorization and it is strictly prohibited to disclose it to any third parties.

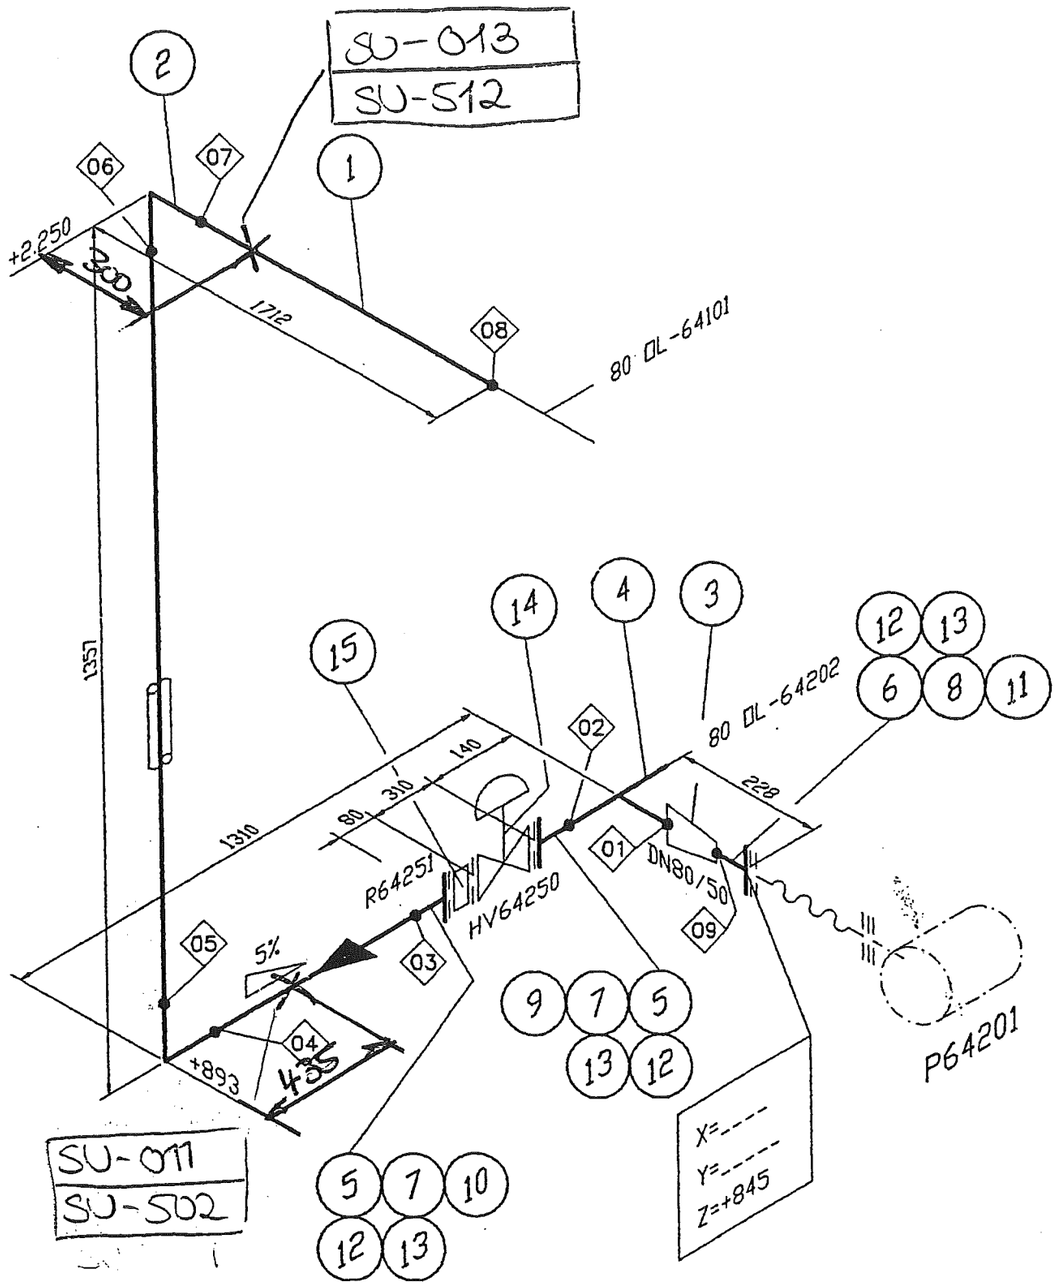

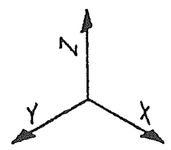

Welding No.	DN	Diameter	Welder No.	Protocoll No.
01	80	88,9	---	---
02	80	88,9	---	---
03	80	88,9	---	---
04	80	88,9	---	---
05	80	88,9	---	---
06	80	88,9	---	---
07	80	88,9	---	---
08	80	88,9	---	---
09	50	60,3	---	---

Remarks:

Responsibility of the assembling company:
- Situation of mounting seams
- Situation of pass-lengths
- Check of measure details and pipe courses on the construction site
- Situation of the spindle at valve

Accompanying drawings:

- 80 OL-64101 ZB40C1C
- 80 OL-64202 ZB40C1C

Accompanying lists:

- 80 OL-64201 ZB40C1C

Pipe standard:

- AL Standard No.: 50006

Attention:
Drawn by turning around 45°

AIR LIQUIDE	Date : 03.11.2004	Name : Reid./IES	Checked: Hr. Gans	History file: 79287106.doc
	Job code: K70101		Scale --:--	Original format DIN A3
Air Liquide AGS GmbH	Reference: ASU Kosice		Sheet: 001	of 001 Sheets
Replaces: 79_.____ Replaced by: 79_.----	Title: 80 OL-64201		Drawing No.: 792.87106	Rev. ---

This drawing is protected by copyright.
It may not be copied or used without our written authorization and it is strictly prohibited to disclose it to any third parties.

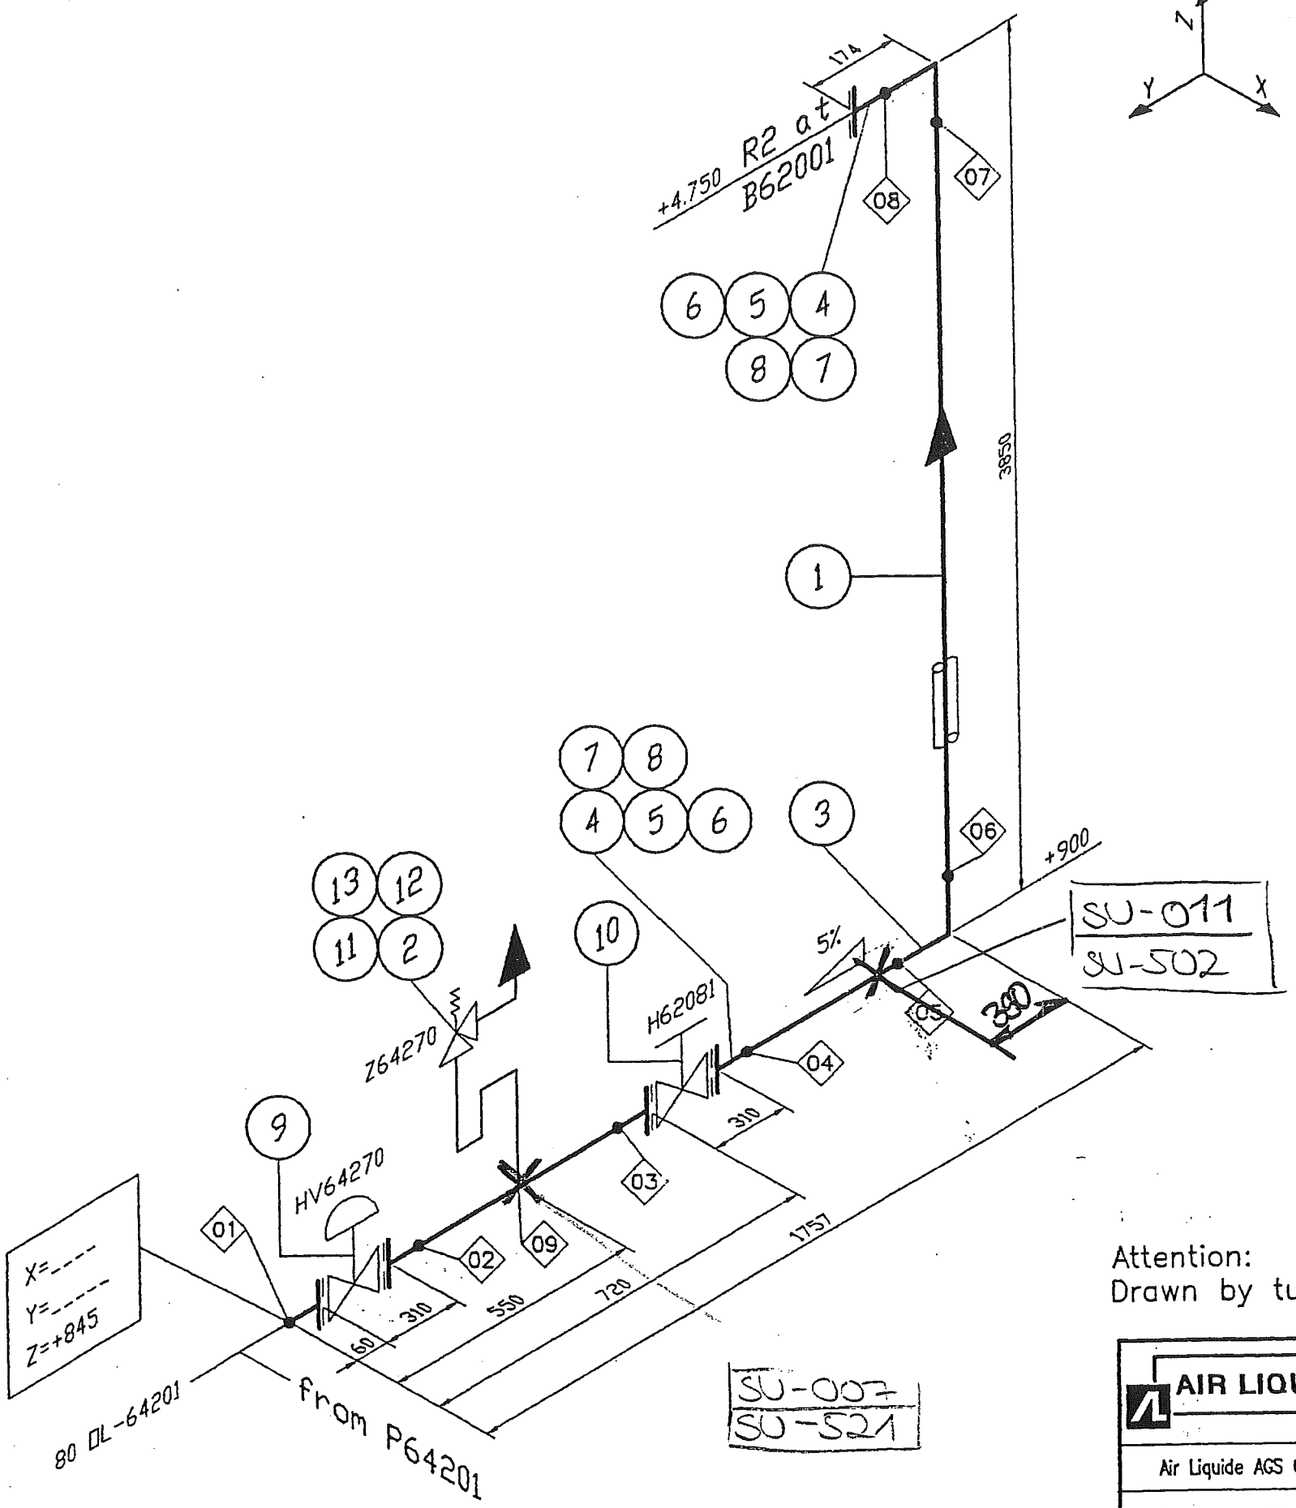

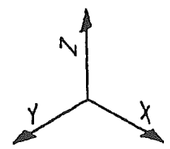

Welding No.	DN	Diameter	Welder No.	Protocoll No.
01	80	88,9	---	---
02	80	88,9	---	---
03	80	88,9	---	---
04	80	88,9	---	---
05	80	88,9	---	---
06	80	88,9	---	---
07	80	88,9	---	---
08	80	88,9	---	---
09		12	---	---

Remarks:

Responsibility of the assembling company:
- Situation of mounting seams
- Situation of pass-lengths
- Check of measure details and pipe courses on the construction site
- Situation of the spindle at valve

Accompanying drawings:

- 80 OL-64201 ZB40C1C

Accompanying lists:

- 80 OL-64202 ZB40C1C

Pipe standard:

- AL Standard No.: 50006

Attention:
Drawn by turning around 45°

AIR LIQUIDE	Date: 04.11.2004	Name: Reid./IES	Checked: Hr. Gans	History file: 79287106.doc
Air Liquide AGS GmbH	Job code: K70101	Reference: ASU Kosice	Scale --:--	Original format DIN A3
			Sheet: 001	of 001 Sheets
Replaces: 79_.-----	Title: 80 OL-64202		Drawing No.: 792.87106	Rev. ---
Replaced by: 79_.-----				

This drawing is protected by copyright.
It may not be copied or used without our written authorization and it is strictly prohibited to disclose it to any third parties.

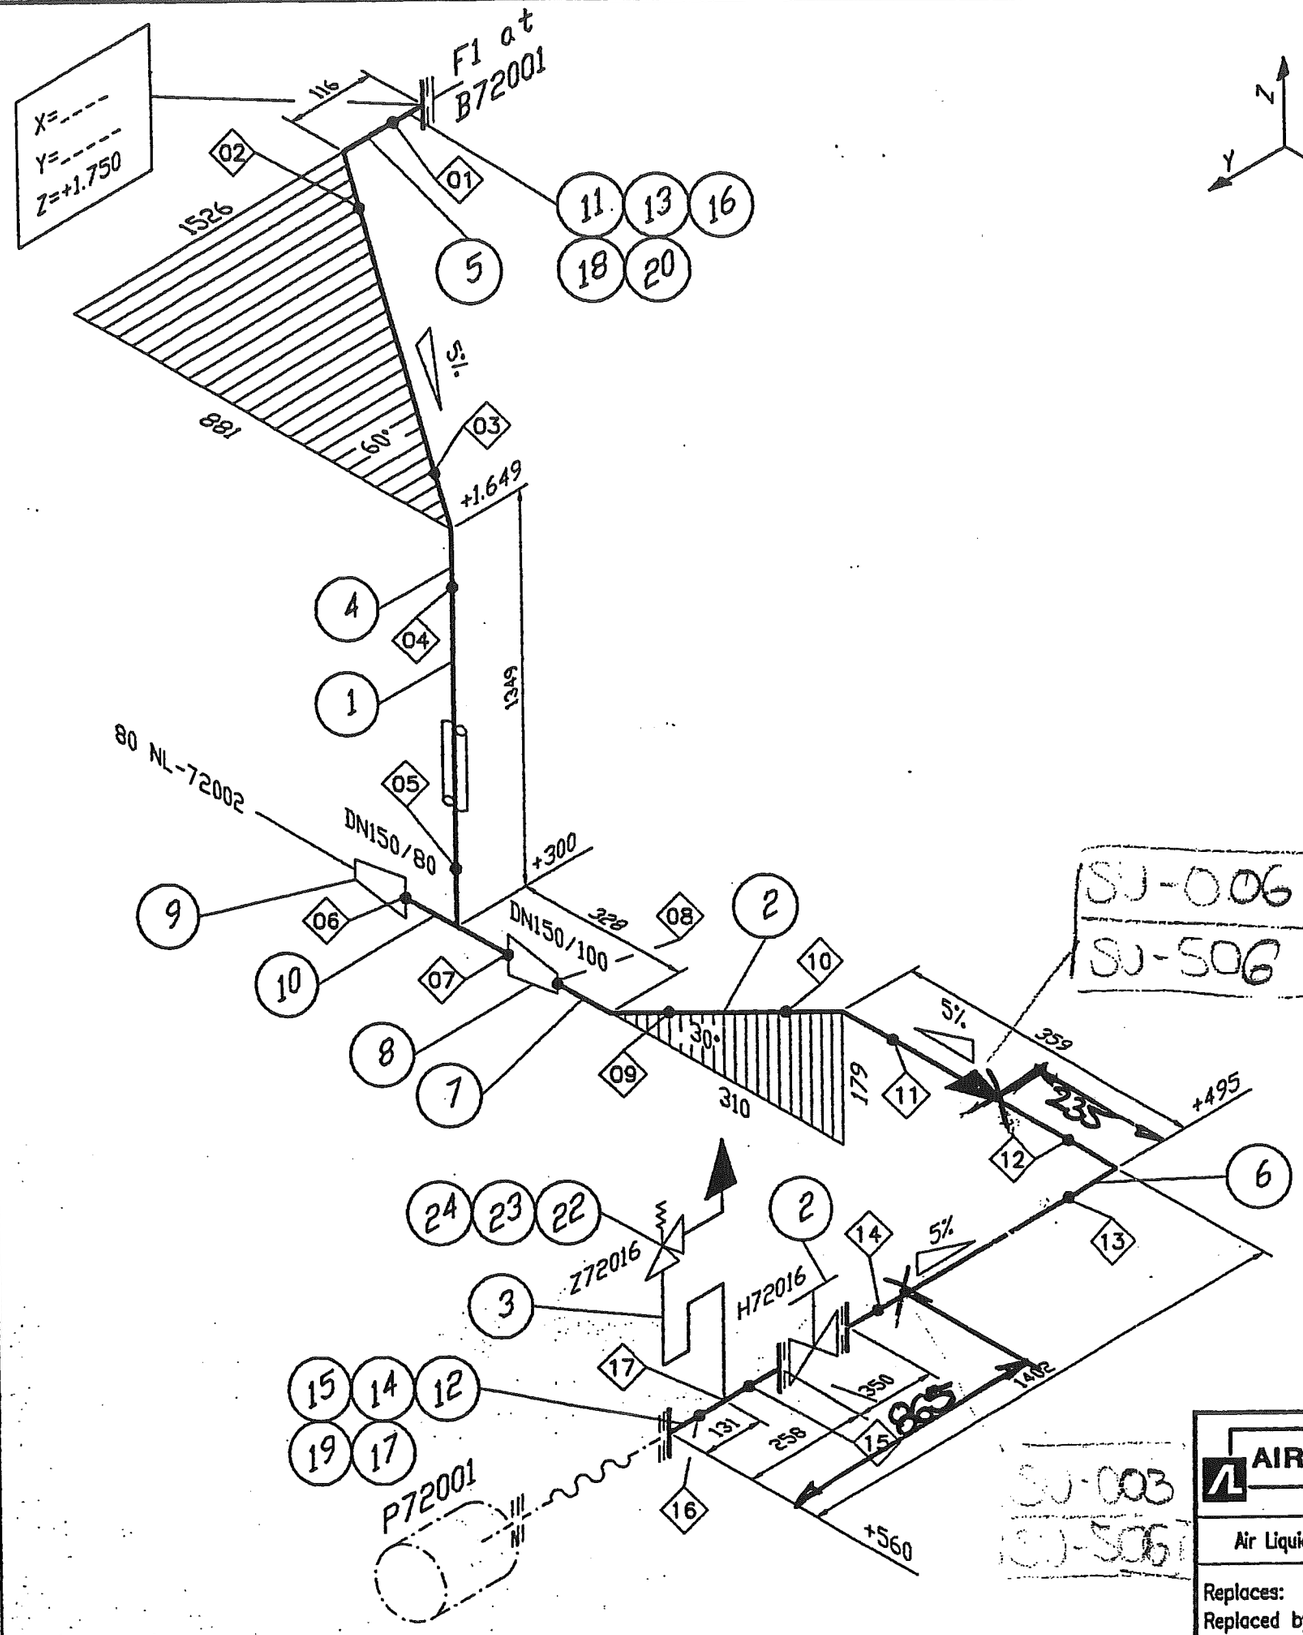

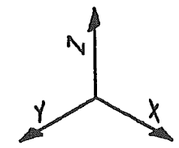

Welding No.	DN	Diameter	Welder No.	Protocoll No.
01	150	168,3	____	____
02	150	168,3	____	____
03	150	168,3	____	____
04	150	168,3	____	____
05	150	168,3	____	____
06	150	168,3	____	____
07	150	168,3	____	____
08	100	114,3	____	____
09	100	114,3	____	____
10	100	114,3	____	____
11	100	114,3	____	____
12	100	114,3	____	____
13	100	114,3	____	____
14	100	114,3	____	____
15	100	114,3	____	____
16	100	114,3	____	____
17		12	____	____

Remarks:

Responsibility of the assembling company:
- Situation of mounting seams
- Situation of pass-lengths
- Check of measure details and pipe courses on the construction site
- Situation of the spindle at valve

Accompanying drawings:

- 80 NL-72002 ZB10C1C

Accompanying lists:

- Parts list:
  150 NL-72001-ZB10C1C

Pipe standard:

- AL Standard No.:
  50030

AIR LIQUIDE	Date : 25.10.2004	Name : Reid./IES	Checked: Hr. Gans
Air Liquide AGS GmbH	Job code: K70101	Reference: ASU Kosice	History file: 79287106.doc
Replaces: 79_.____ Replaced by: 79_.----	Title: 150 NL-72001	Scale --:--	Original format DIN A3
		Sheet: 001	of 001 Sheets
		Drawing No.: 792.87106	Rev. ____

This drawing is protected by copyright.
It may not be copied or used without our written authorization and it is strictly prohibited to disclose it to any third parties.

SU-077
SU-527

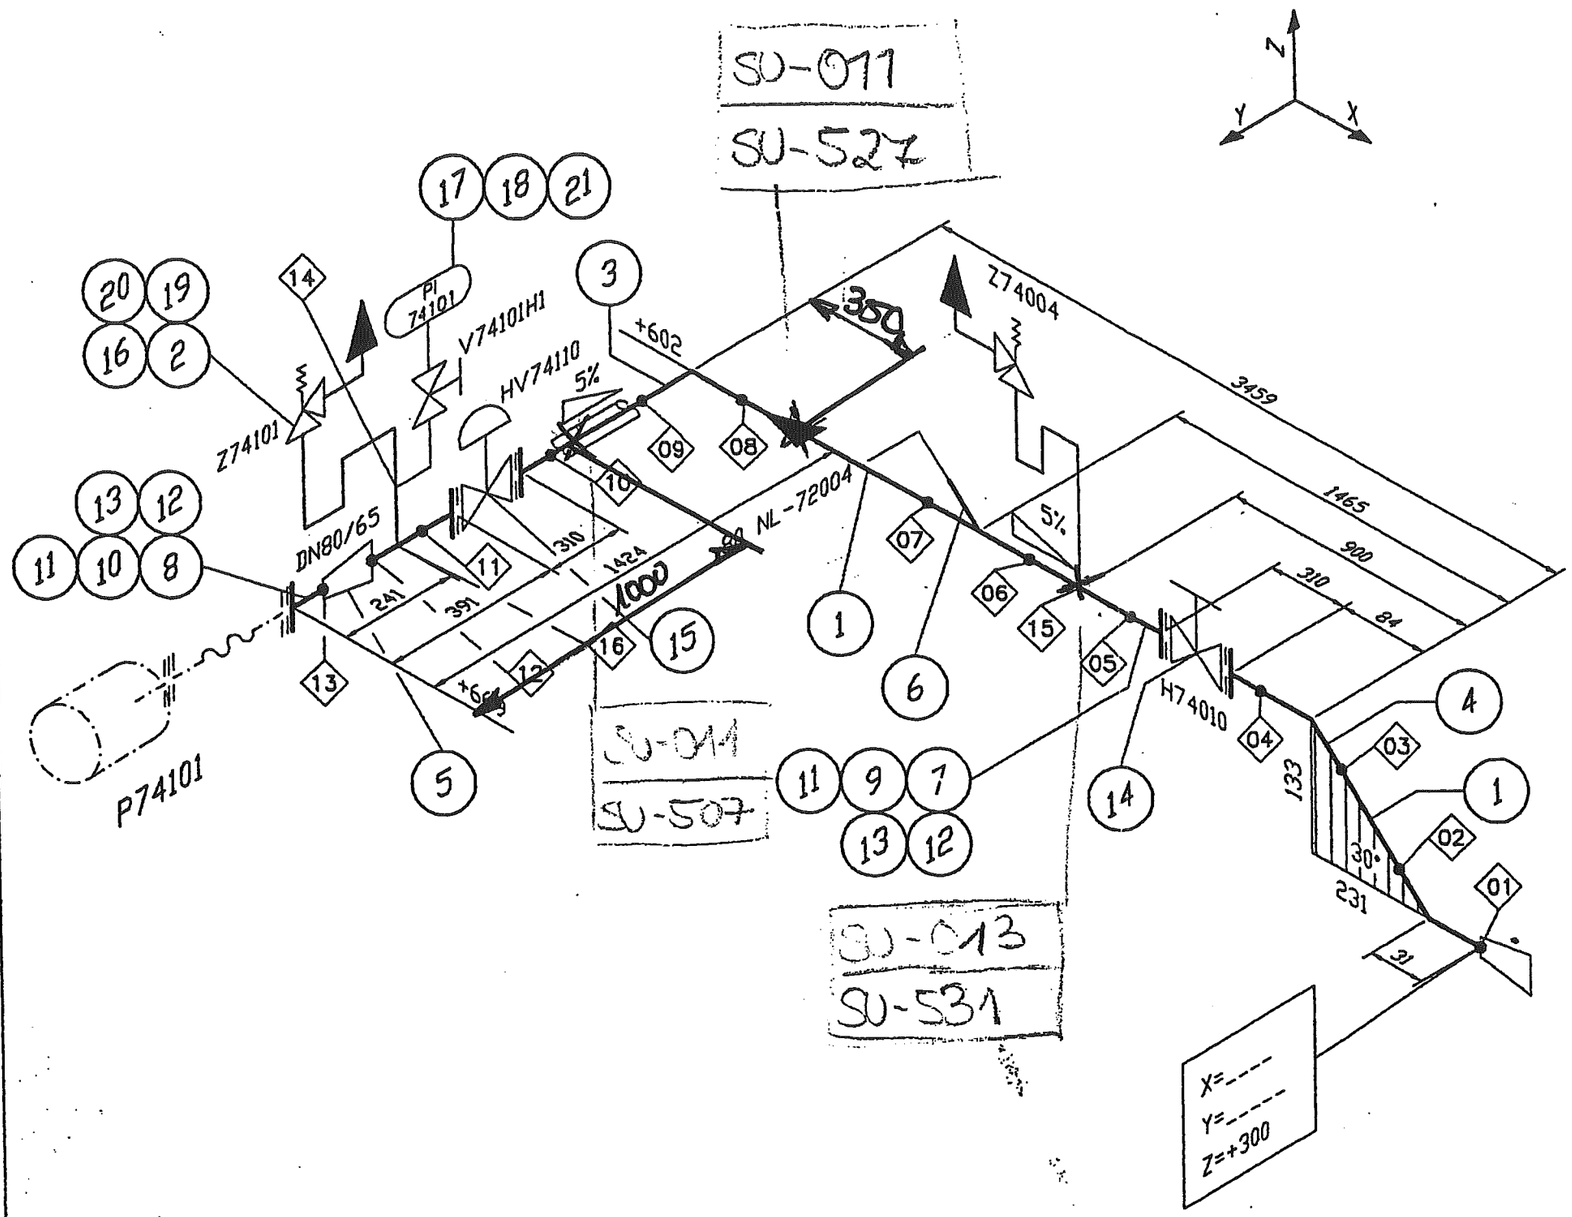

SU-011
SU-507

SU-013
SU-531

Welding No.	DN	Diameter	Welder No.	Protocoll No.
01	80	88,9	___	___
02	80	88,9	___	___
03	80	88,9	___	___
04	80	88,9	___	___
05	80	88,9	___	___
06	80	88,9	___	___
07	80	88,9	___	___
08	80	88,9	___	___
09	80	88,9	___	___
10	80	88,9	___	___
11	80	88,9	___	___
12	80	88,9	___	___
13	80	88,9	___	___
14		22	___	___
15		12	___	___
16		12	___	___

Remarks:

Responsibility of the assembling company:
- Situation of mounting seams
- Situation of pass-lengths
- Check of measure details and pipe courses on the construction site
- Situation of the spindle at valve

Accompanying drawings:

- 150 NL-72001 ZB10C1C
- 80 NL-72004 ZB10C1C

Accompanying lists:

- Parts list:
  80 NL-72002-ZB10C1C

Pipe standard:

- AL Standard No.:
  50030

AIR LIQUIDE	Date : 25.10.2004	Name : Reid./IES	Checked: Hr. Gans	History file: 79287106.doc
	Job code: K70101		Scale --:--	Original format DIN A3
Air Liquide AGS GmbH	Reference: ASU Kosice		Sheet: 001	of 001 Sheets
Replaces: 79_____	Title:		Drawing No.:	Rev.
Replaced by: 79_-----	80 NL-72002 X		792.87106	___

This drawing is protected by copyright.
It may not be copied or used without our written authorization and it is strictly prohibited to disclose it to any third parties.

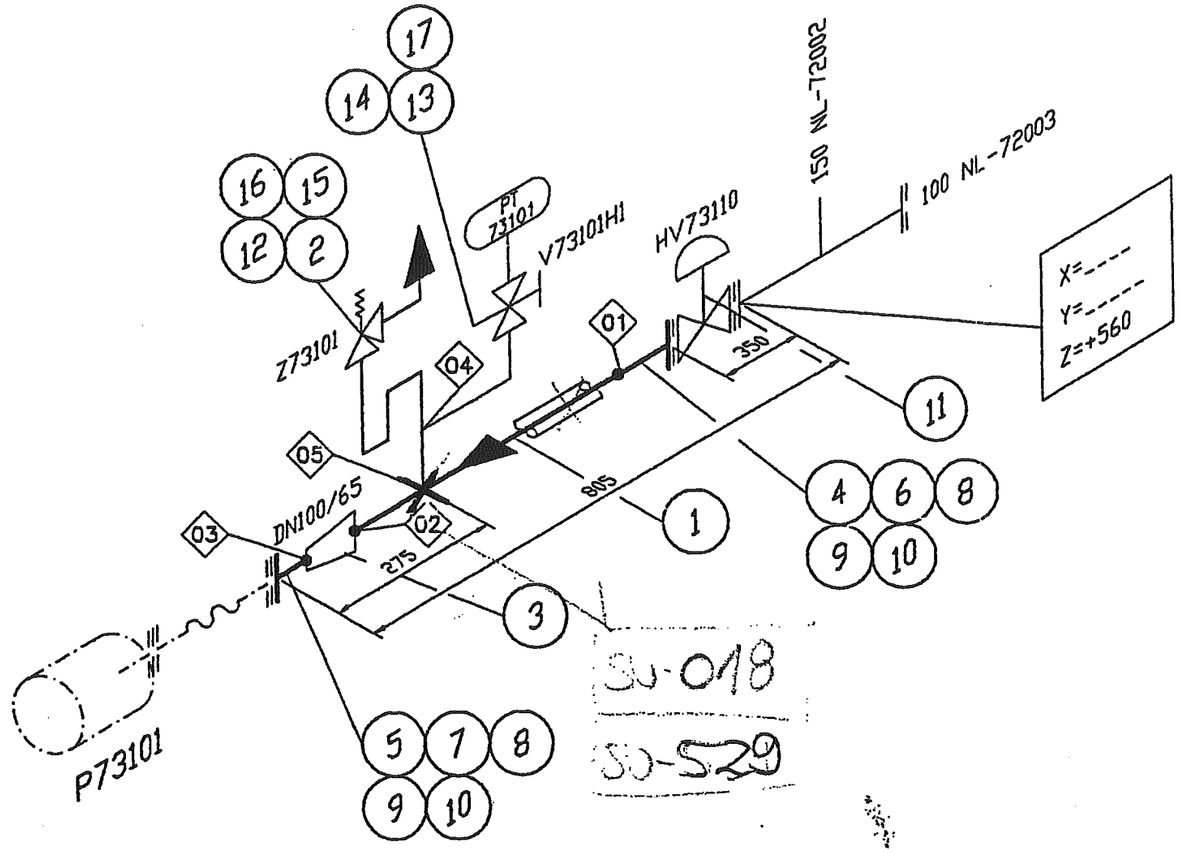

Welding No.	DN	Diameter	Welder No.	Protocoll No.
01	100	114,3	___	___
02	100	114,3	___	___
03	65	76,1	___	___
04		22	___	___
05		12	___	___

Remarks:

Responsibility of the assembling company:
- Situation of mounting seams
- Situation of pass-lengths
- Check of measure details and pipe courses on the construction site
- Situation of the spindle at valve

Accompanying drawings:

- 150 NL-72002 ZB10C1C
- 100 NL-72003 ZB10C1C

Accompanying lists:

- Parts list:
  100 NL-72002-ZB10C1C

Pipe standard:

- AL Standard No.:
  50030

	Date :	Name :	Checked:	History file:
AIR LIQUIDE	25.10.2004	Reid./IES	Hr. Gans	79287106.doc
Air Liquide AGS GmbH	Job code: K70101		Scale --:--	Original format DIN A3
	Reference: ASU Kosice		Sheet: 001	of 001 Sheets
Replaces: 79_____	Title:		Drawing No.:	Rev.
Replaced by: 79_-----	100 NL-72002		792.87106	

This drawing is protected by copyright.
It may not be copied or used without our written authorization and it is strictly prohibited to disclose it to any third parties.

Welding No.	DN	Diameter	Welder No.	Protocoll No.
01	150	168,3	____	____
02	150	168,3	____	____
03	100	114,3	____	____
04	100	114,3	____	____
05	100	114,3	____	____
06	100	114,3	____	____
07	100	114,3	____	____
08	100	114,3	____	____
09	100	114,3	____	____
10		12	____	____

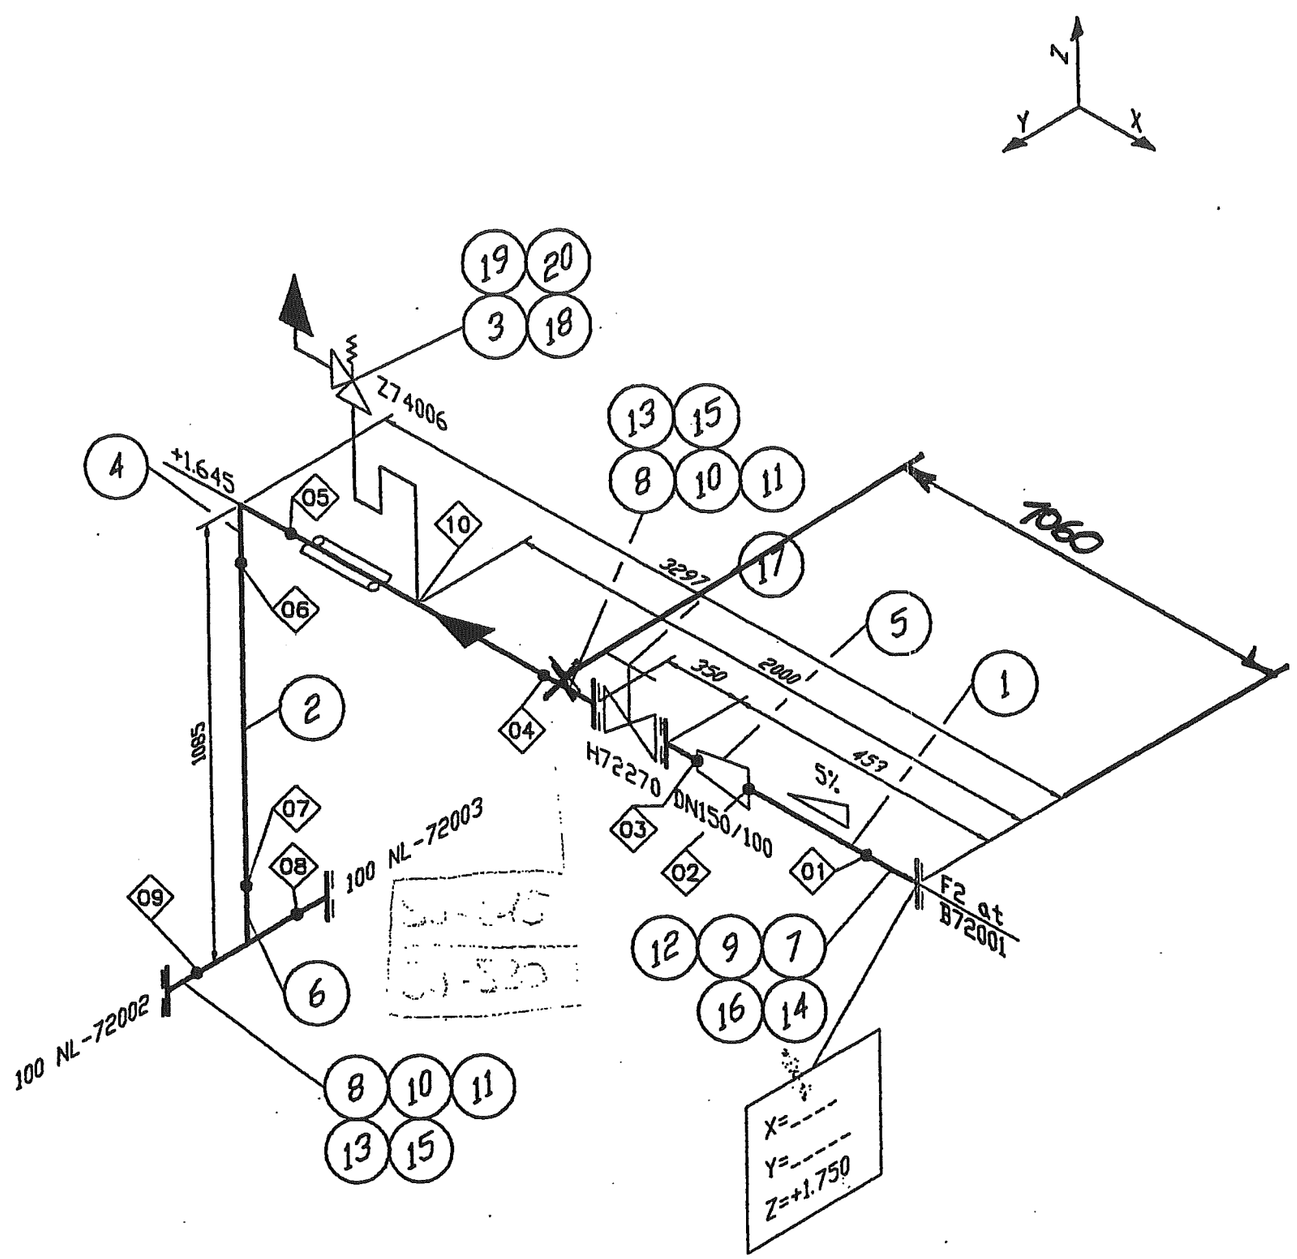

Remarks:

Responsibility of the assembling company:
- Situation of mounting seams
- Situation of pass-lengths
- Check of measure details and pipe courses on the construction site
- Situation of the spindle at valve

Accompanying drawings:

- 100 NL-72002 ZB10C1C
- 100 NL-72003 ZB10C1C

Accompanying lists:

- Parts list:
  150 NL-72002-ZB10C1C

Pipe standard:

- AL Standard No.:
  50030

AIR LIQUIDE	Date : 25.10.2004	Name : Reid./IES	Checked: Hr. Gans	History file: 79287106.doc
	Job code: K70101		Scale --:--	Original format DIN A3
Air Liquide AGS GmbH	Reference: ASU Kosice		Sheet: 001	of 001 Sheets
Replaces: 79_____ Replaced by: 79_____	Title: 150 NL-72002x		Drawing No.: 792.87106	Rev.

This drawing is protected by copyright.
It may not be copied or used without our written authorization and it is strictly prohibited to disclose it to any third parties.

Welding No.	DN	Diameter	Welder No.	Protocoll No.
01	100	114,3	---	---
02	100	114,3	---	---
03	65	76,1	---	---
04		22	---	---
05		12	---	---

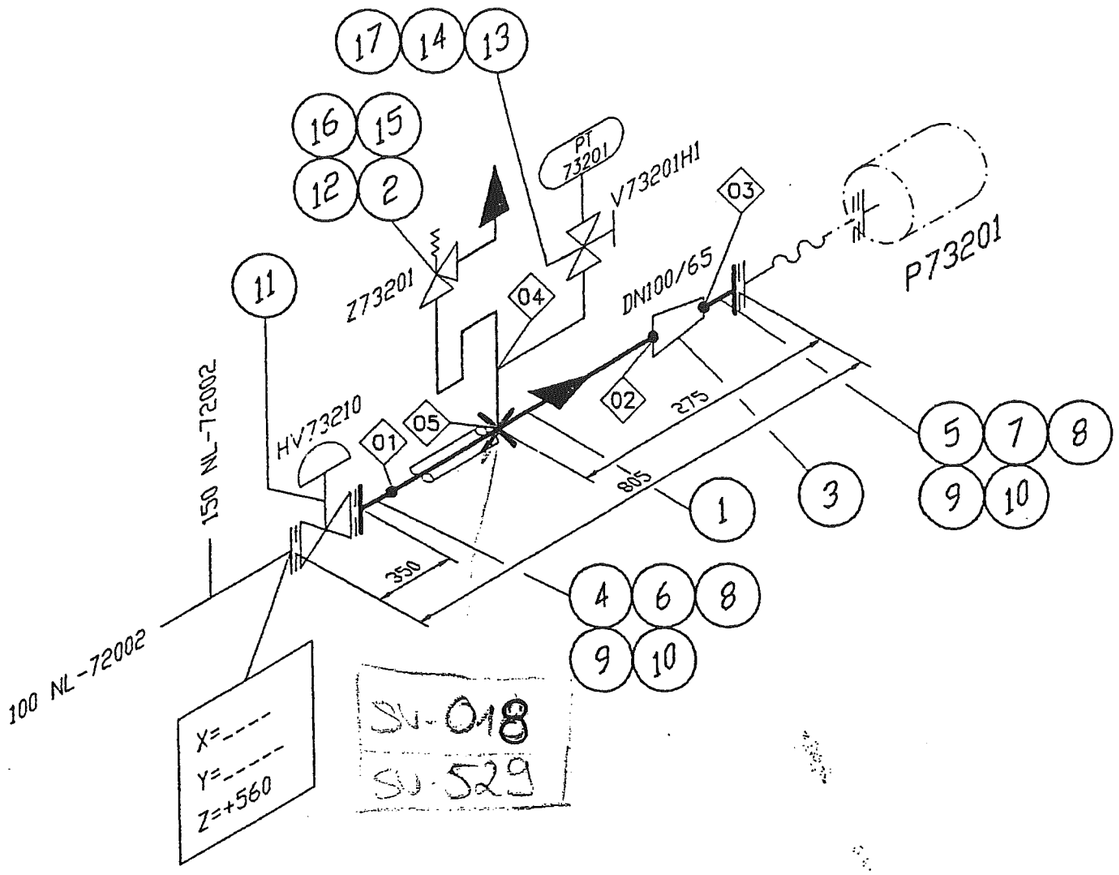

Remarks:

Responsibility of the assembling company:
- Situation of mounting seams
- Situation of pass-lengths
- Check of measure details and pipe courses on the construction site
- Situation of the spindle at valve

Accompanying drawings:

- 150 NL-72002 ZB10C1C
- 100 NL-72002 ZB10C1C

Accompanying lists:

- Parts list:
  100 NL-72003-ZB10C1C

Pipe standard:

- AL Standard No.:
  50030

AIR LIQUIDE	Date : 25.10.2004	Name : Reid./IES	Checked: Hr. Gans	History file: 79287106.doc
Air Liquide AGS GmbH	Job code: K70101 Reference: ASU Kosice		Scale --:--	Original format DIN A3
			Sheet: 001	of 001 Sheets
Replaces: 79_.____ Replaced by: 79_.-----	Title: 100 NL-72003		Drawing No.: 792.87106	Rev. ---

This drawing is protected by copyright.
It may not be copied or used without our written authorization and it is strictly prohibited to disclose it to any third parties.

Welding No.	DN	Diameter	Welder No.	Protocoll No.
01	80	88,9	___	___
02	80	88,9	___	___
03	80	88,9	___	___
04	80	88,9	___	___
05	80	88,9	___	___
06	65	76,1	___	___
07		22	___	___
08		12	___	___

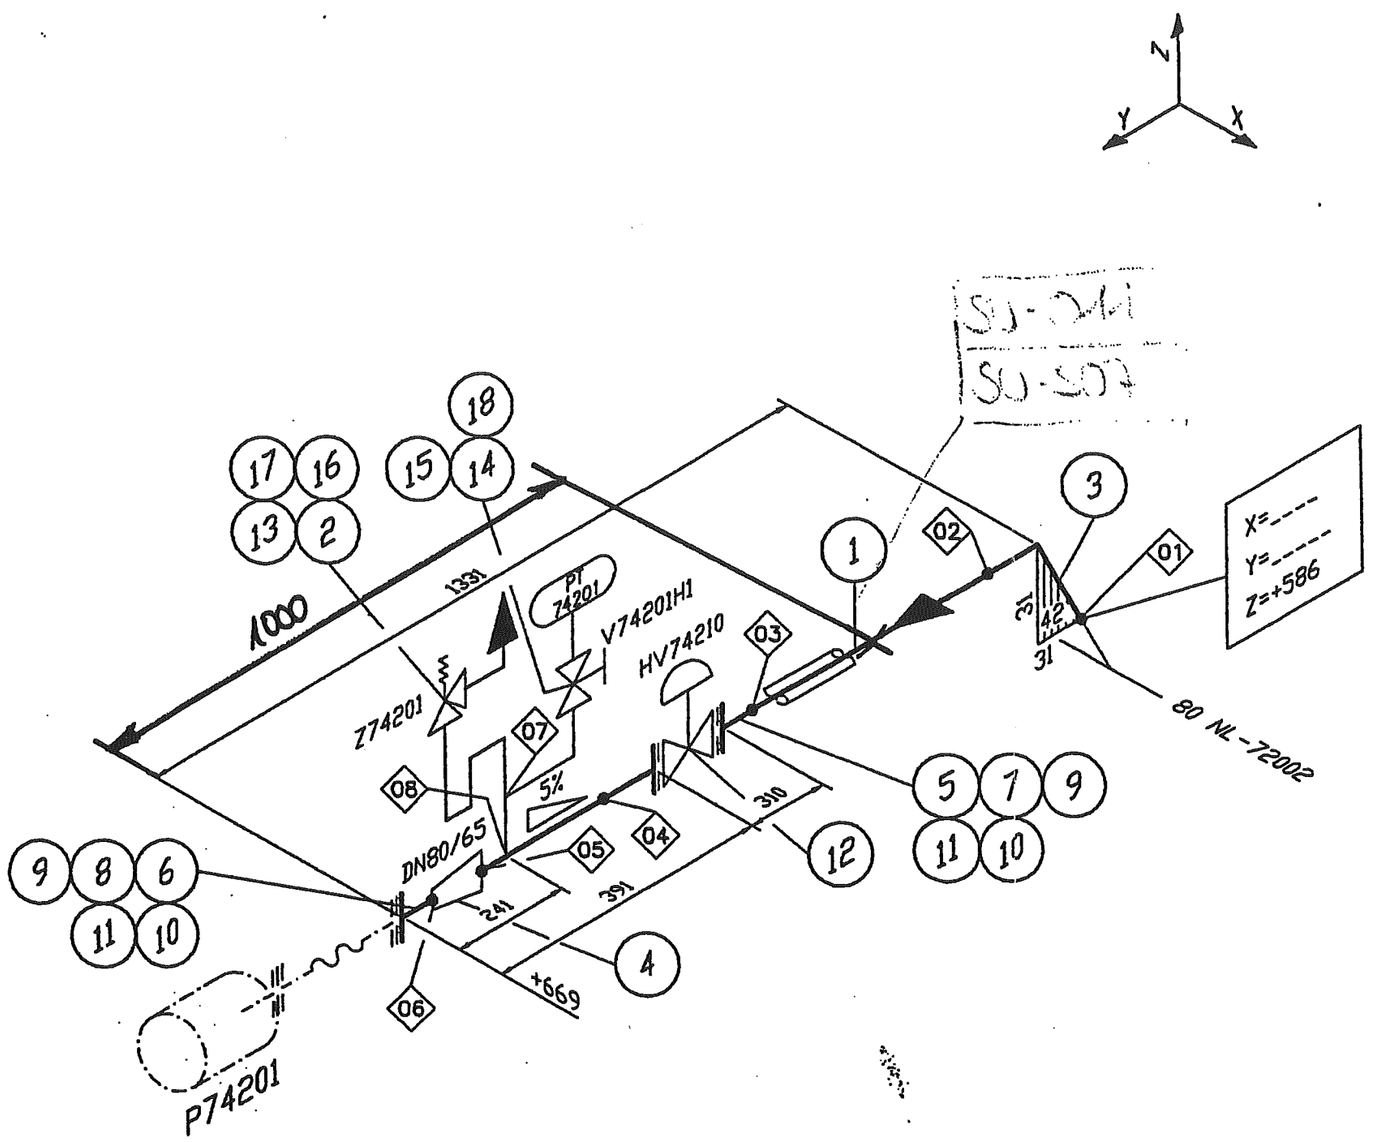

Remarks:

Responsibility of the assembling company:
- Situation of mounting seams
- Situation of pass-lengths
- Check of measure details and pipe courses on the construction site
- Situation of the spindle at valve

Accompanying drawings:

- 80 NL-72002 ZB10C1C

Accompanying lists:

- Parts list:
  80 NL-72004-ZB10C1C

Pipe standard:

- AL Standard No.:
  50030

AIR LIQUIDE	Date : 25.10.2004	Name : Reid./IES	Checked: Hr. Gans	History file: 79287106.doc
Air Liquide AGS GmbH	Job code: K70101 Reference: ASU Kosice		Scale --:--	Original format DIN A3
			Sheet: 001	of 001 Sheets
Replaces: 79_____ Replaced by: 79_.-----	Title: 80 NL-72004 x		Drawing No.: 792.87106	Rev.

This drawing is protected by copyright.
It may not be copied or used without our written authorization and it is strictly prohibited to disclose it to any third parties.

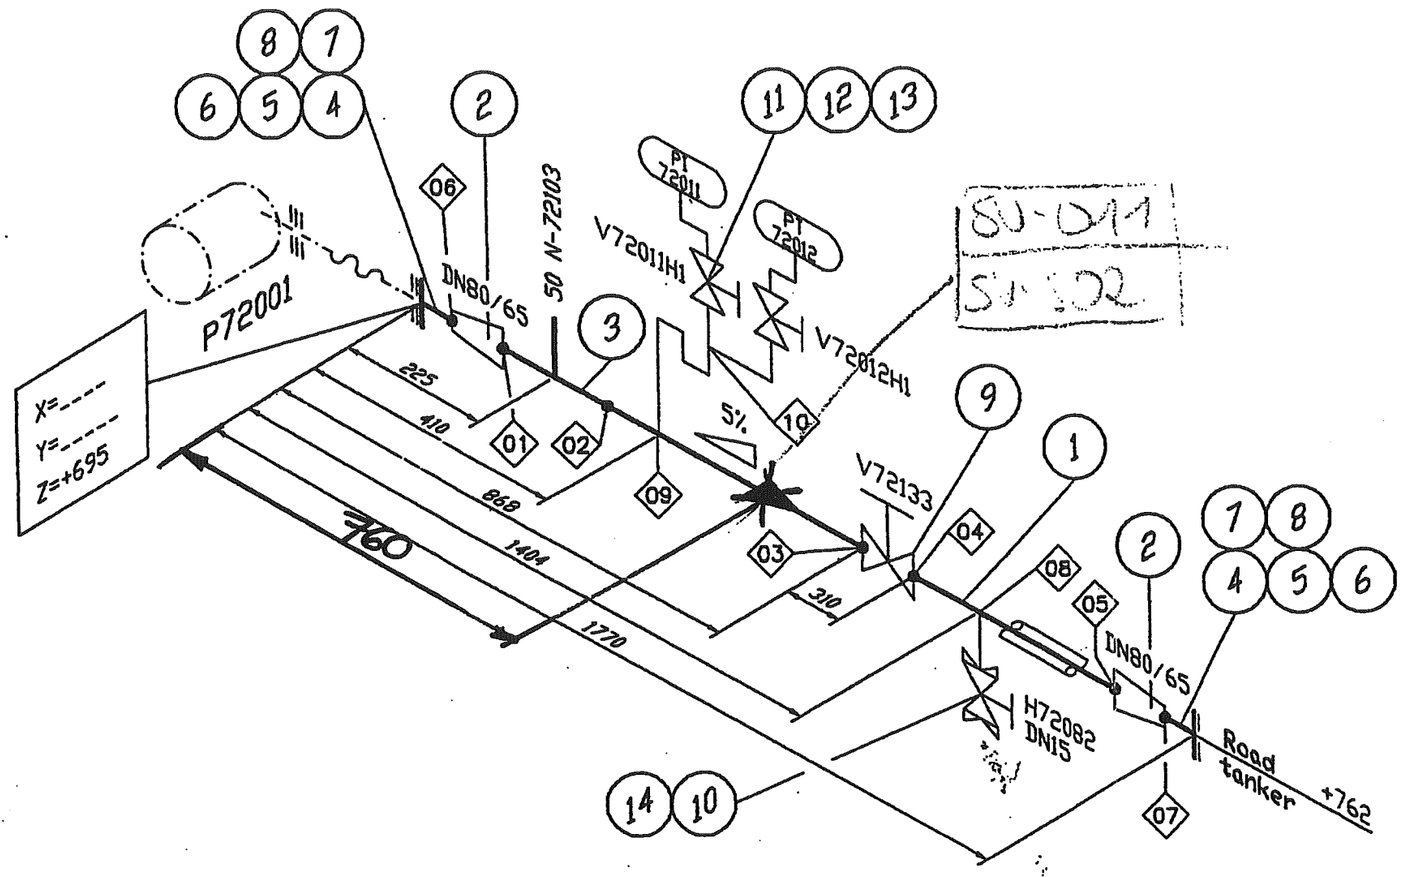

Welding No.	DN	Diameter	Welder No.	Protocoll No.
01	80	88,9	---	---
02	80	88,9	---	---
03	80	88,9	---	---
04	80	88,9	---	---
05	80	88,9	---	---
06	65	76,1	---	---
07	65	76,1	---	---
08	15	21,3	---	---
09		22	---	---
10		22	---	---

Remarks:

Responsibility of the assembling company:
- Situation of mounting seams
- Situation of pass-lengths
- Check of measure details and pipe courses on the construction site
- Situation of the spindle at valve

Accompanying drawings:

- 50 N-72103 ZB10C1C

Accompanying lists:

- Parts list:
  80 NL-72102-ZB10C1C

Pipe standard:

- AL Standard No.:
  50030

AIR LIQUIDE	Date : 25.10.2004	Name : Reid./IES	Checked: Hr. Gans	History file: 79287106.doc
Air Liquide AGS GmbH	Job code: K70101	Reference: ASU Kosice	Scale --:--	Original format DIN A3
Replaces: 79_____ Replaced by: 79_-----	Title: 80 NL-72102X		Sheet: 001	of 001 Sheets
			Drawing No.: 792.87106	Rev.

This drawing is protected by copyright.
It may not be copied or used without our written authorization and it is strictly prohibited to disclose it to any third parties.

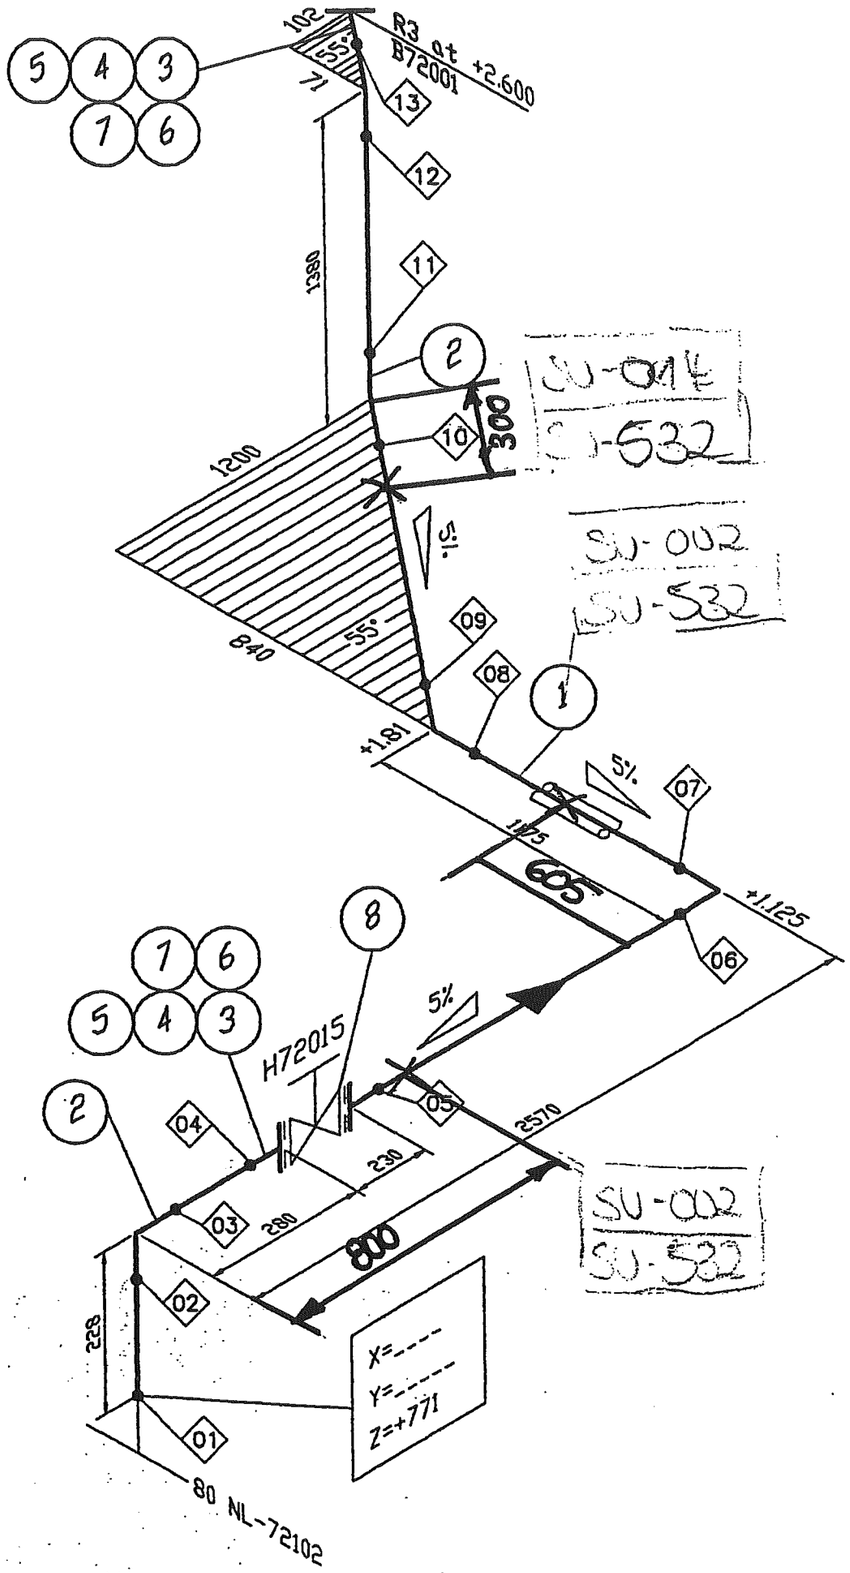

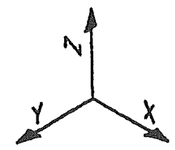

Welding No.	DN	Diameter	Welder No.	Protocoll No.
01	50	60,3	___	___
02	50	60,3	___	___
03	50	60,3	___	___
04	50	60,3	___	___
05	50	60,3	___	___
06	50	60,3	___	___
07	50	60,3	___	___
08	50	60,3	___	___
09	50	60,3	___	___
10	50	60,3	___	___
11	50	60,3	___	___
12	50	60,3	___	___
13	50	60,3	___	___

Remarks:

Responsibility of the assembling company:
- Situation of mounting seams
- Situation of pass-lengths
- Check of measure details and pipe courses on the construction site
- Situation of the spindle at valve

Accompanying drawings:

- 80 N-72102 ZB10C1C

Accompanying lists:

- Parts list:
  50 N-72103-ZB10C1C

Pipe standard:

- AL Standard No.:
  50030

AIR LIQUIDE	Date : 27.10.2004	Name : Reid./IES	Checked: Hr. Gans	History file: 79287106.doc
Air Liquide AGS GmbH	Job code: K70101	Reference: ASU Kosice	Scale --:--	Original format DIN A3
			Sheet: 001	of 001 Sheets
Replaces: 79_.____	Title: 50 N-72103		Drawing No.: 792.87106	Rev.
Replaced by: 79_.-----				

This drawing is protected by copyright.
It may not be copied or used without our written authorization and it is strictly prohibited to disclose it to any third parties.

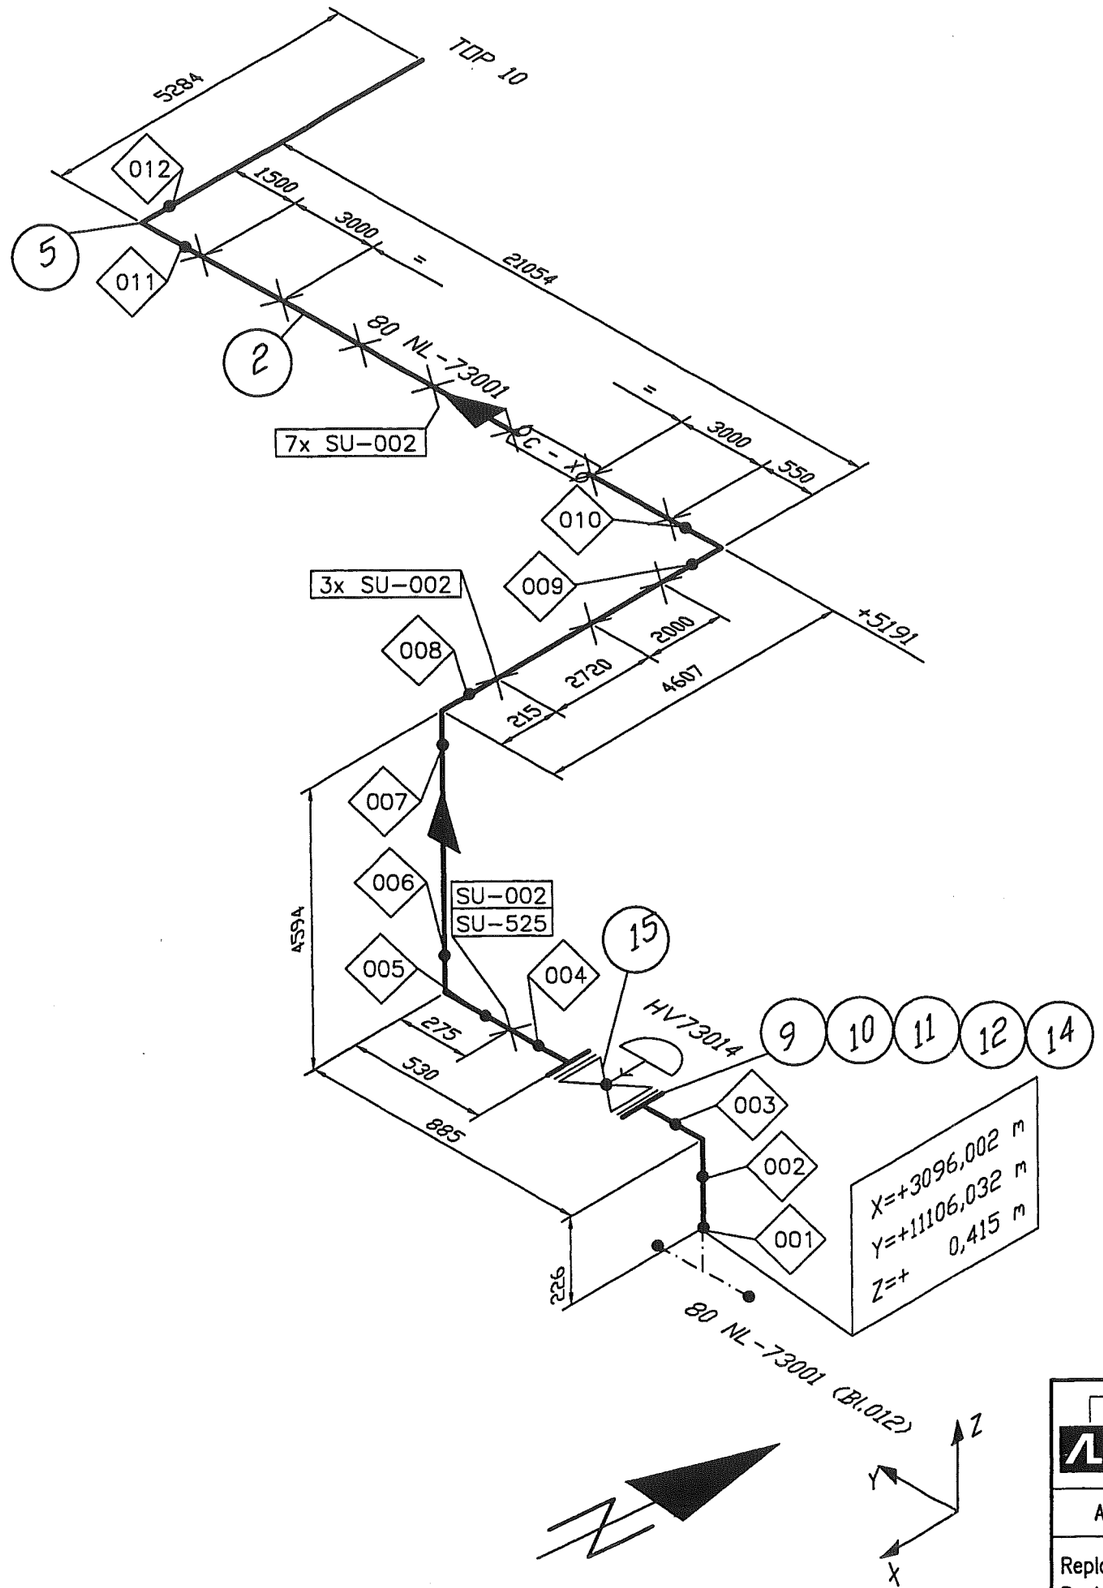

Welding No.	DN	ø	Welder No.	Protoc. No.
001	50	60,3	___	___
002	50	60,3	___	___
003	50	60,3	___	___
004	50	60,3	___	___
005	50	60,3	___	___
006	50	60,3	___	___
007	50	60,3	___	___
008	50	60,3	___	___
009	50	60,3	___	___
010	50	60,3	___	___
011	50	60,3	___	___
012	50	60,3	___	___

Remarks:

Responsibility of the assembling company:
- Situation of mounting seams
- Situation of pass-lengths
- Check of measure details and pipe courses on the construction site
- Situation of the spindle at valve

Accompanying drawings:

- 80 NL-73001

Accompanying lists:

- Parts list: 80 NL-73001

Pipe Standard:

- AL Standard No.: 50026 / ZB25C1

AIR LIQUIDE	Date : 28.10.2004	Name : WIP/Rad.	Checked: –	History file: 79287106.doc
Air Liquide AGS GmbH	Job code: K70101 Reference: ASU Kosice		Scale --:--	Original format DIN A3
			Sheet: 010	of – Sheets
Replaces: 79_._____ Replaced by: 79_._-----	Title: 80 NL 73001		Drawing No.: 792.87106	Rev. A

This drawing is protected by copyright.
It may not be copied or used without our written authorization and it is strictly prohibited to disclose it to any third parties.

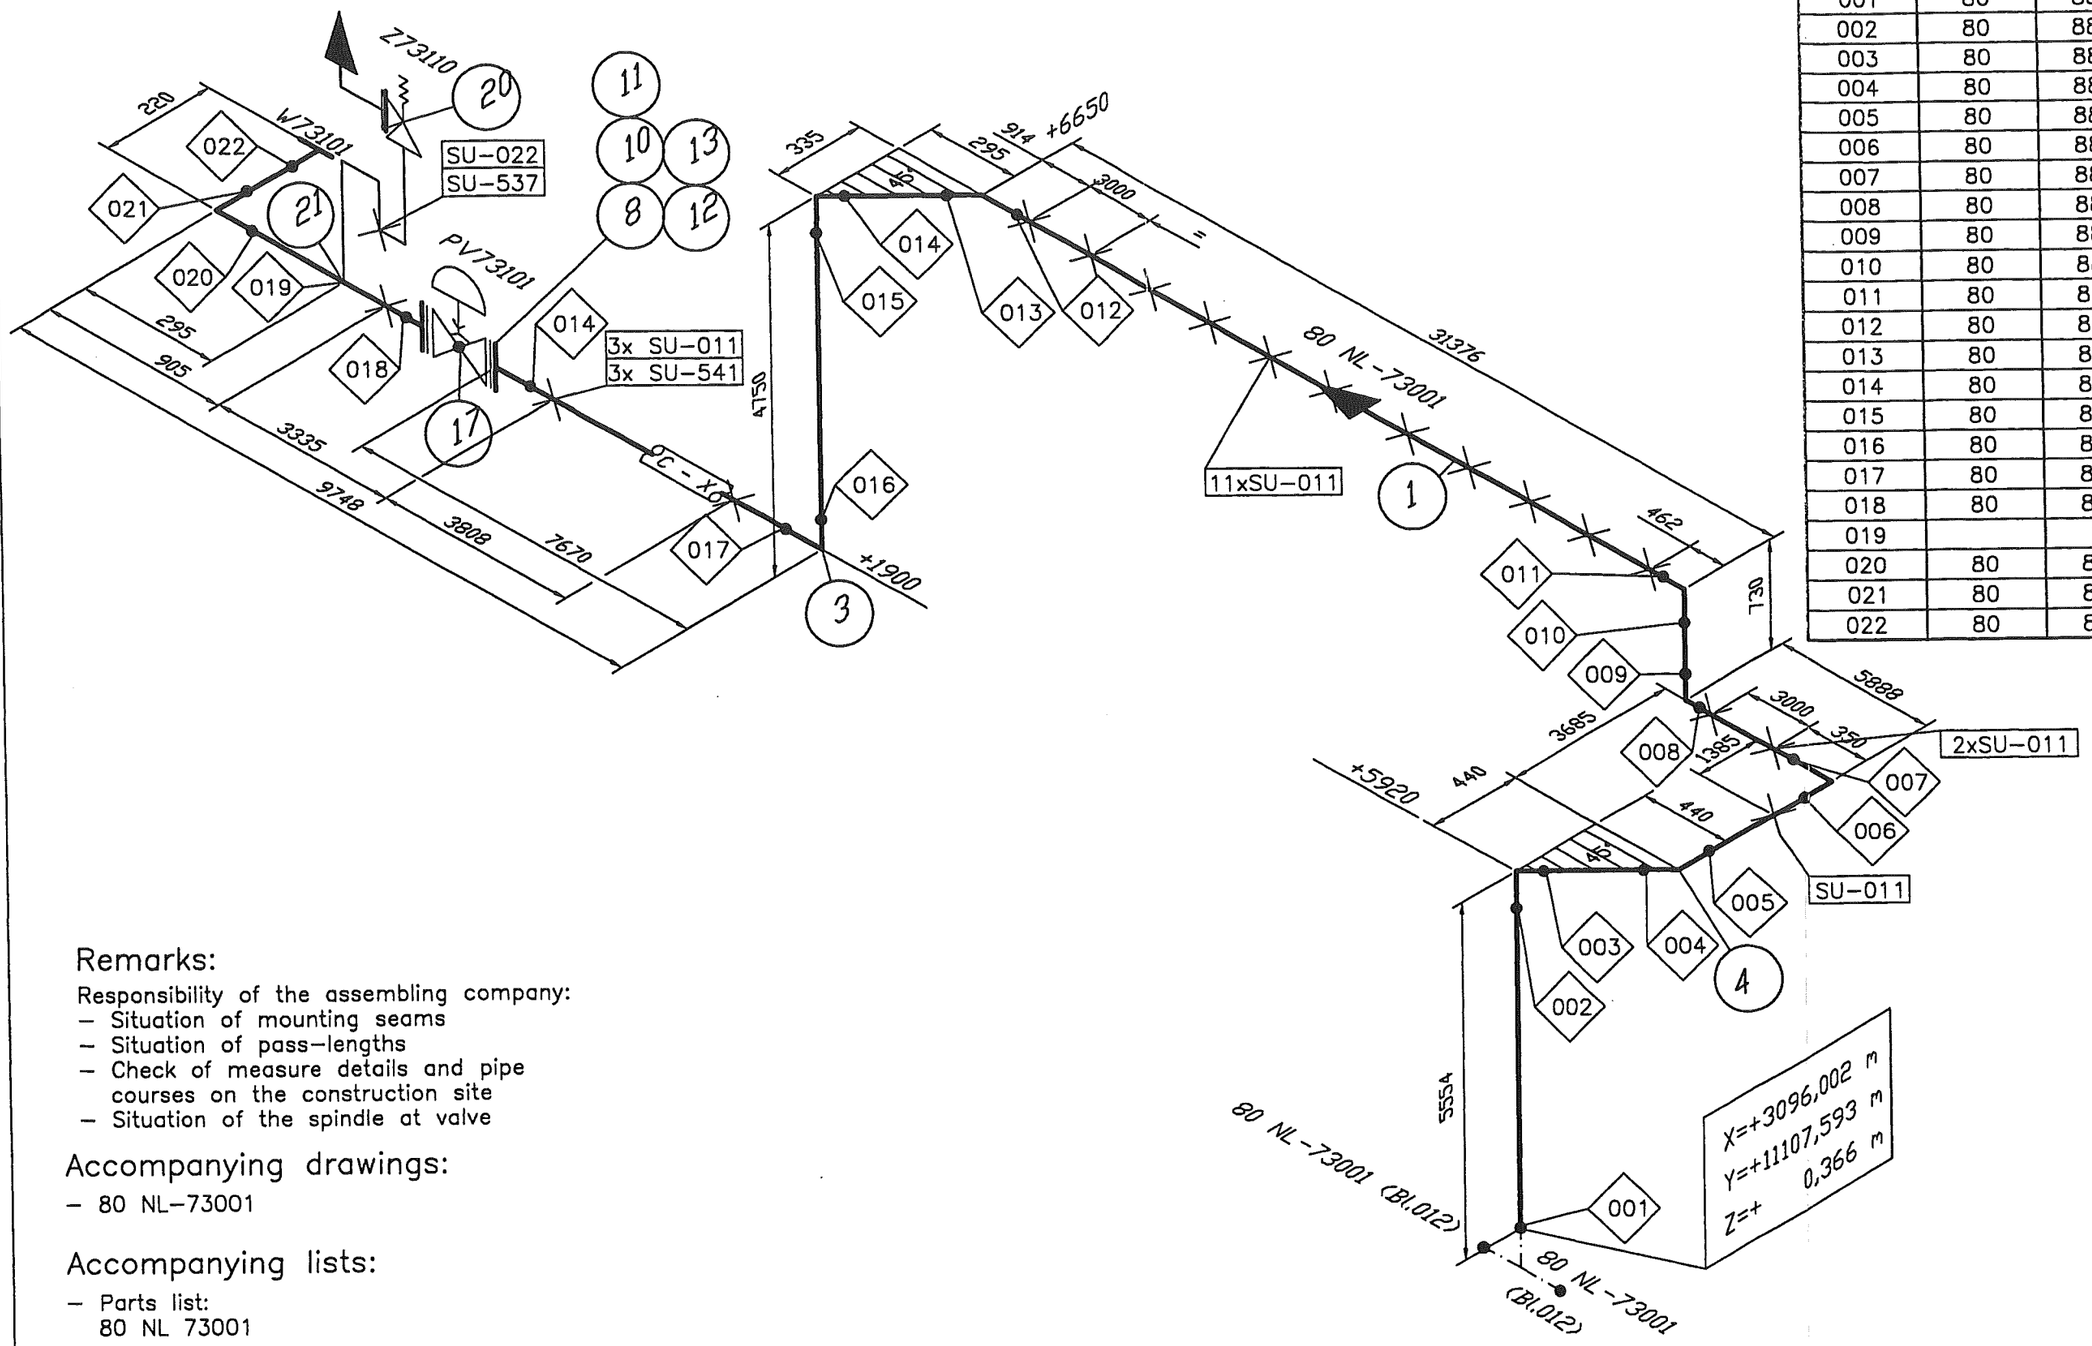

Welding No.	DN	ø	Welder No.	Protoc. No.
001	80	88,9	___	___
002	80	88,9	___	___
003	80	88,9	___	___
004	80	88,9	___	___
005	80	88,9	___	___
006	80	88,9	___	___
007	80	88,9	___	___
008	80	88,9	___	___
009	80	88,9	___	___
010	80	88,9	___	___
011	80	88,9	___	___
012	80	88,9	___	___
013	80	88,9	___	___
014	80	88,9	___	___
015	80	88,9	___	___
016	80	88,9	___	___
017	80	88,9	___	___
018	80	88,9	___	___
019		12	___	___
020	80	88,9	___	___
021	80	88,9	___	___
022	80	88,9	___	___

Remarks:

Responsibility of the assembling company:
- Situation of mounting seams
- Situation of pass-lengths
- Check of measure details and pipe courses on the construction site
- Situation of the spindle at valve

Accompanying drawings:

- 80 NL-73001

Accompanying lists:

- Parts list:
  80 NL 73001

Pipe Standard:

- AL Standard No.:
  50026 / ZB25C1

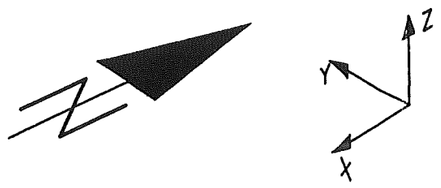

AIR LIQUIDE	Date : 28.10.2004	Name : WIP/Rad.	Checked: –	History file: 79287106.doc
Air Liquide AGS GmbH	Job code: K70101 Reference: ASU Kosice		Scale --:--	Original format DIN A3
			Sheet: 011	of – Sheets
Replaces: 79_._____ Replaced by: 79_.-----	Title: 80 NL 73001		Drawing No.: 792.87106	Rev. A

This drawing is protected by copyright.
It may not be copied or used without our written authorization and it is strictly prohibited to disclose it to any third parties.

Welding No.	DN	ø	Welder No.	Protoc. No.
001	80	88,9	___	___
002	80	88,9	___	___
003	80	88,9	___	___
004	80	88,9	___	___
005	80	88,9	___	___
006	80	88,9	___	___
007	80	88,9	___	___
008	80	88,9	___	___
009	80	88,9	___	___
010	80	88,9	___	___
011	80	88,9	___	___
012	80	88,9	___	___
013		12	___	___
014	80	88,9	___	___
015	80	88,9	___	___
016	80	88,9	___	___
017	80	88,9	___	___
018	80	88,9	___	___
019	80	88,9	___	___
020	50	60,3	___	___
021	50	60,3	___	___
022	50	60,3	___	___
023	50	60,3	___	___

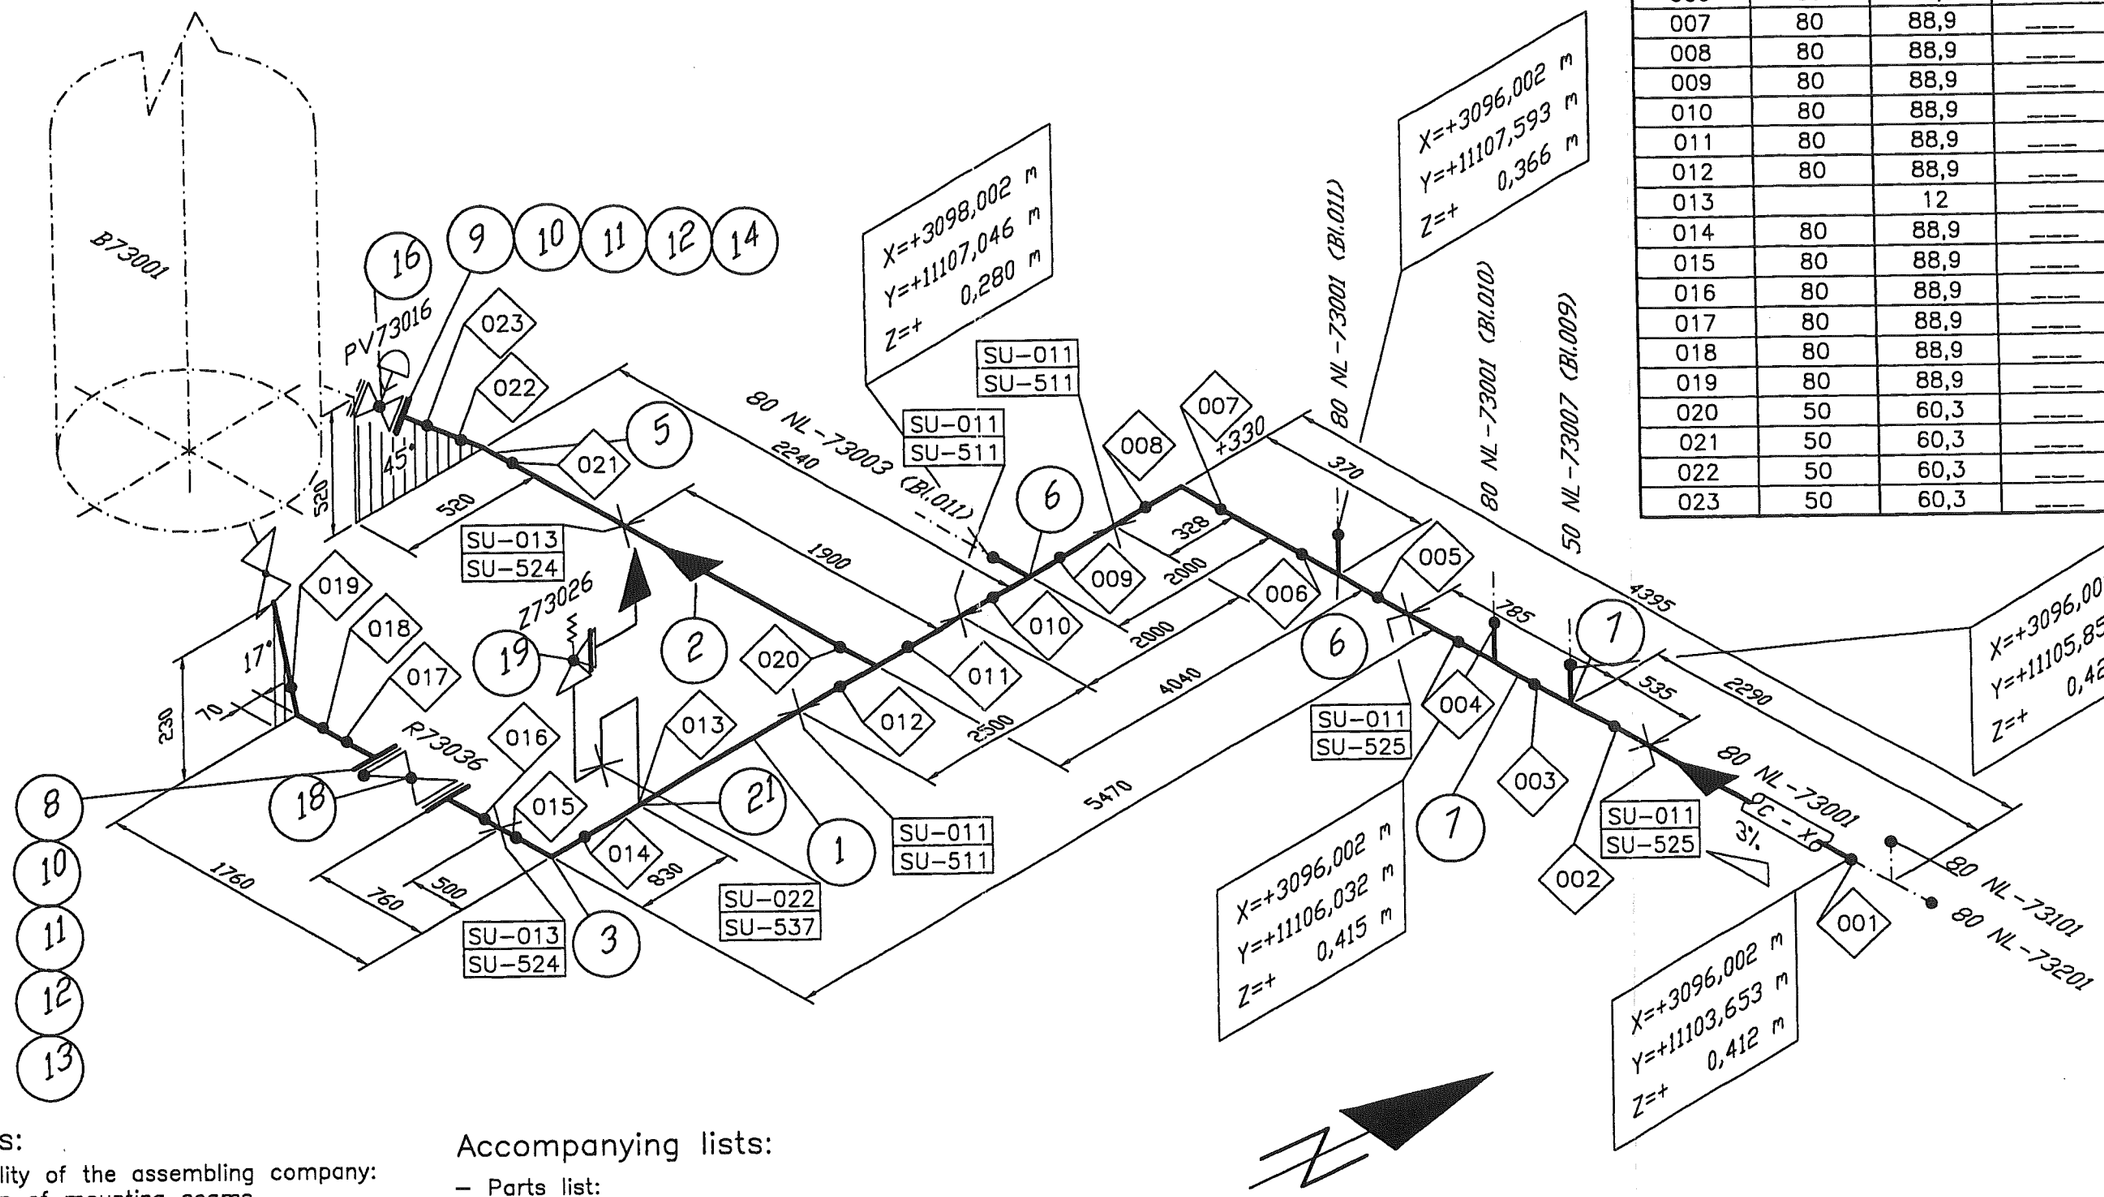

Remarks:

Responsibility of the assembling company:
- Situation of mounting seams
- Situation of pass-lengths
- Check of measure details and pipe courses on the construction site
- Situation of the spindle at valve

Accompanying drawings:

- 80 NL-73001
- 50 NL-73007
- 80 NL-73101
- 80 NL-73201

Accompanying lists:

- Parts list:
  80 NL 73001

Pipe Standard:

- AL Standard No.:
  50026 / ZB25C1

AIR LIQUIDE	Date : 28.10.2004	Name : WIP/Rad.	Checked: –	History file: 79287106.doc
	Job code: K70101		Scale --:--	Original format DIN A3
Air Liquide AGS GmbH	Reference: ASU Kosice		Sheet: 012	of – Sheets
Replaces: 79_.____	Title:		Drawing No.:	Rev.
Replaced by: 79_.-----	80 NL 73001		792.87106	A

This drawing is protected by copyright.
It may not be copied or used without our written authorization and it is strictly prohibited to disclose it to any third parties.

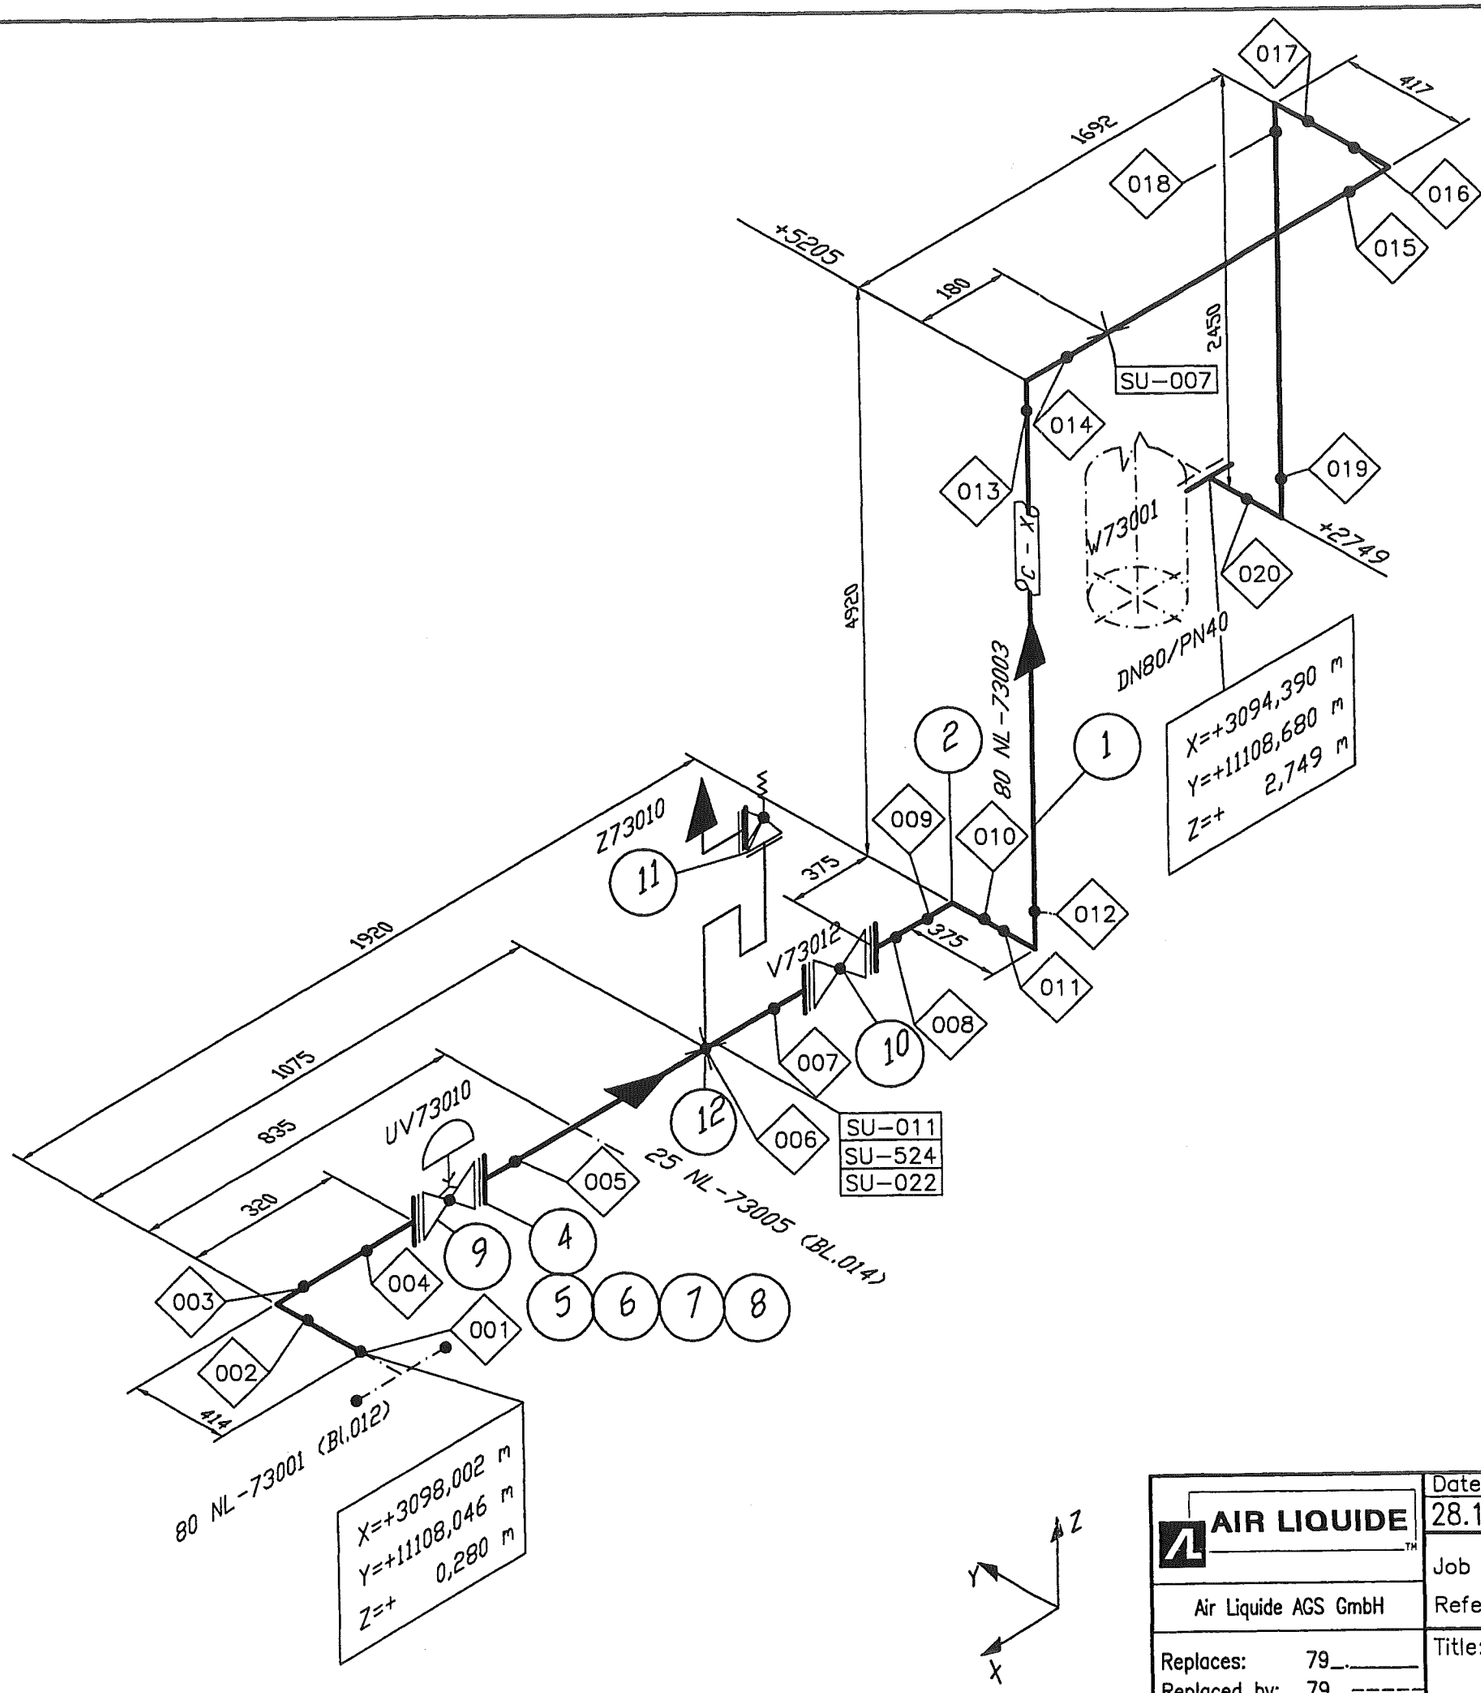

Welding No.	DN	ø	Welder No.	Protoc. No.
001	80	88,9	___	___
002	80	88,9	___	___
003	80	88,9	___	___
004	80	88,9	___	___
005	80	88,9	___	___
006		12	___	___
007	80	88,9	___	___
008	80	88,9	___	___
009	80	88,9	___	___
010	80	88,9	___	___
011	80	88,9	___	___
012	80	88,9	___	___
013	80	88,9	___	___
014	80	88,9	___	___
015	80	88,9	___	___
016	80	88,9	___	___
017	80	88,9	___	___
018	80	88,9	___	___
019	80	88,9	___	___
020	80	88,9	___	___

Remarks:

Responsibility of the assembling company:
- Situation of mounting seams
- Situation of pass-lengths
- Check of measure details and pipe courses on the construction site
- Situation of the spindle at valve

Accompanying drawings:

- 80 NL-73001
- 25 NL-73005

Accompanying lists:

- Parts list: 80 NL-73003

Pipe Standard:

- AL Standard No.: 50026 / ZB25C1

AIR LIQUIDE	Date : 28.10.2004	Name : WIP/Rad.	Checked: –	History file: 79287106.doc
Air Liquide AGS GmbH	Job code: K70101 Reference: ASU Kosice		Scale --:--	Original format DIN A3
			Sheet: 013	of – Sheets
Replaces: 79_.____ Replaced by: 79_.-----	Title: 80 NL 73003		Drawing No.: 792.87106	Rev. A

This drawing is protected by copyright.
It may not be copied or used without our written authorization and it is strictly prohibited to disclose it to any third parties.

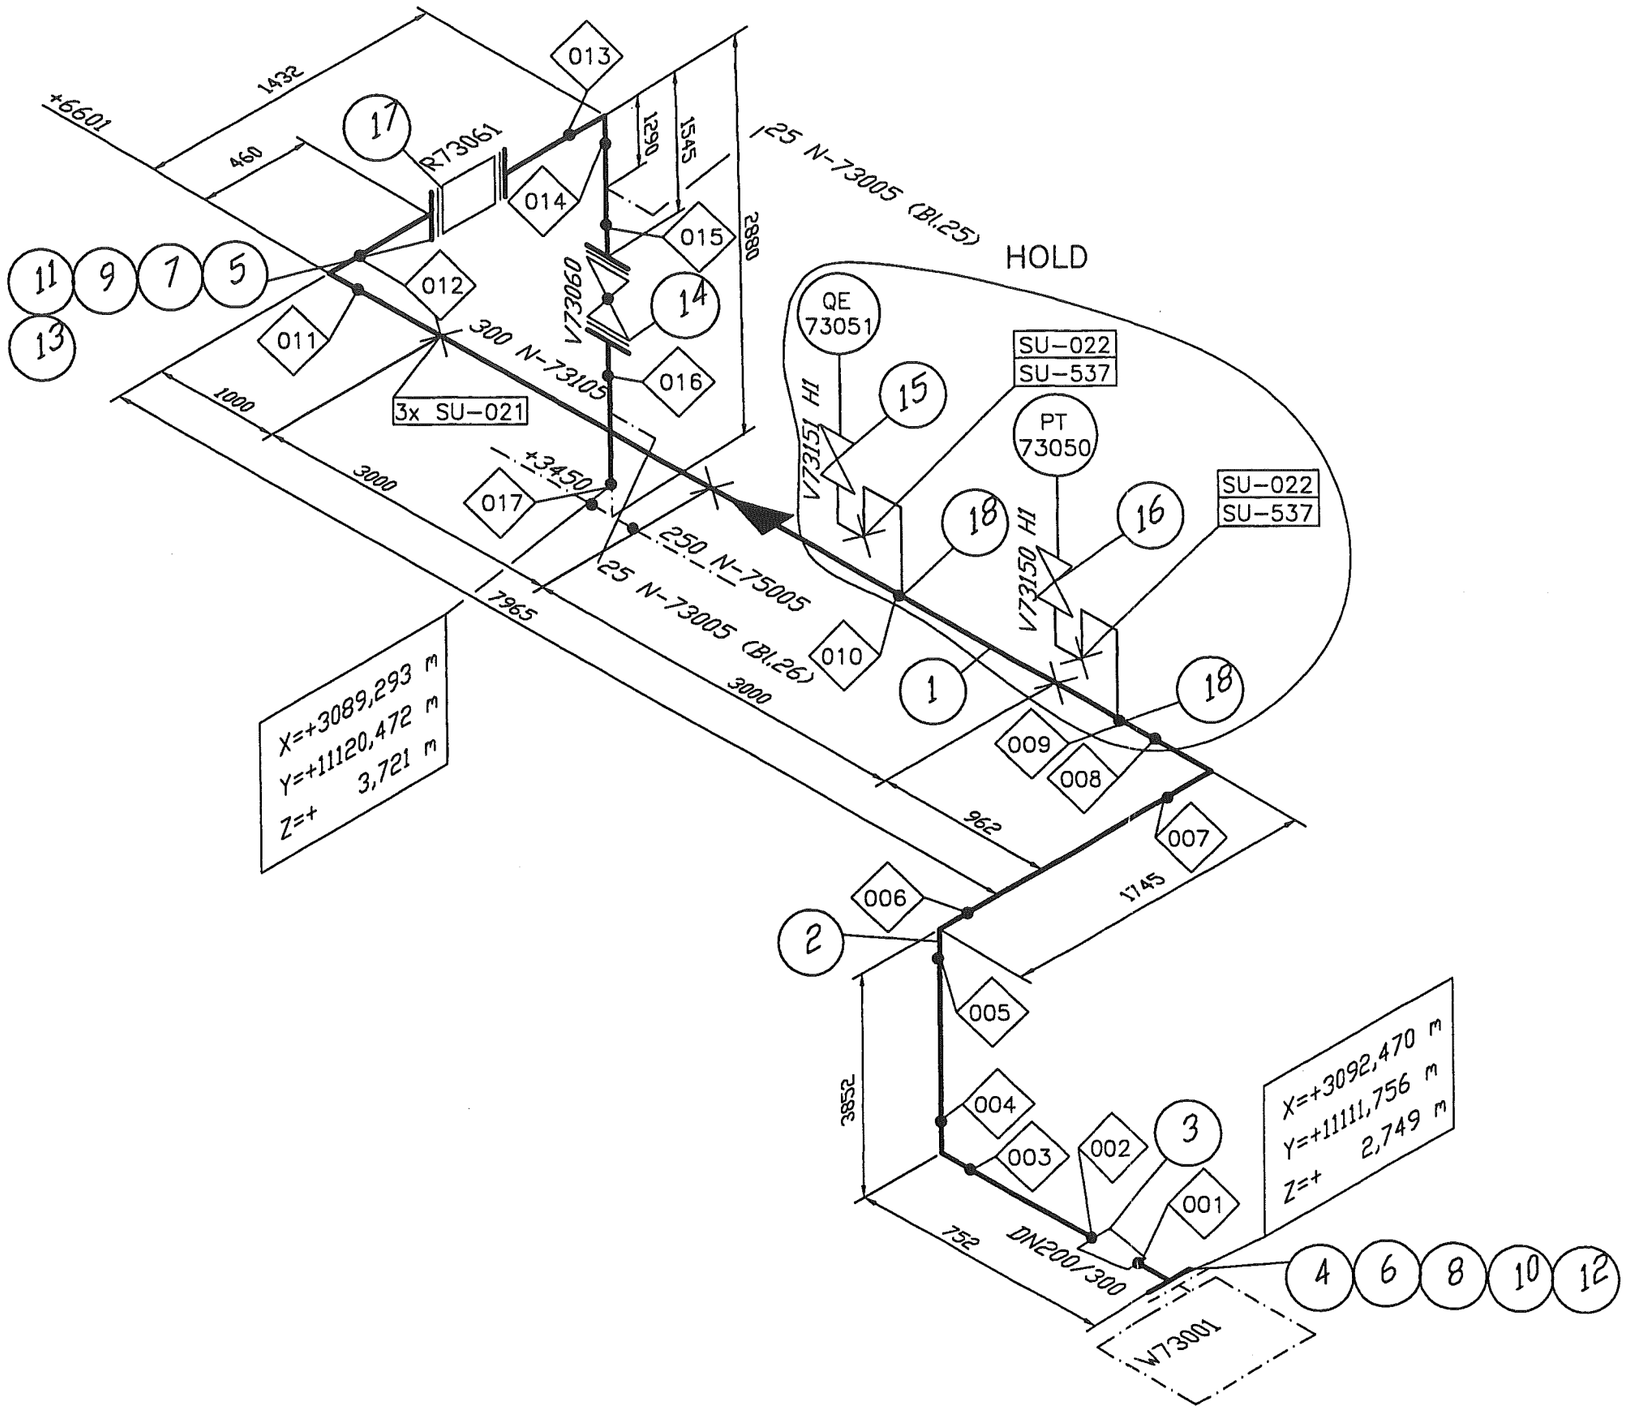

Welding No.	DN	ø	Welder No.	Protoc. No.
001	150	168,3	___	___
002	300	329,9	___	___
003	300	329,9	___	___
004	300	329,9	___	___
005	300	329,9	___	___
006	300	329,9	___	___
007	300	329,9	___	___
008	300	329,9	___	___
009		12	___	___
010		12	___	___
011	300	329,9	___	___
012	300	329,9	___	___
013	300	329,9	___	___
014	300	329,9	___	___
015	300	329,9	___	___
016	300	329,9	___	___
017	300	329,9	___	___

Remarks:

Responsibility of the assembling company:
- Situation of mounting seams
- Situation of pass-lengths
- Check of measure details and pipe courses on the construction site
- Situation of the spindle at valve

Accompanying drawings:

- 250 N-75005
- 25 N-73005 ZB40C1
- 25 N-73005 AA40C1

Accompanying lists:

- Parts list:
  300 N-73004

Pipe Standard:

- AL Standard No.:
  50026 / ZB25C1

AIR LIQUIDE	Date : 08.11.2004	Name : WIP/Rad.	Checked: –	History file: 79287106.doc
Air Liquide AGS GmbH	Job code: K70101 Reference: ASU Kosice		Scale --:--	Original format DIN A3
			Sheet: 016	of – Sheets
Replaces: 79_.____ Replaced by: 79_.-----	Title: 300 N 73004		Drawing No.: 792.87106	Rev. A

This drawing is protected by copyright.
It may not be copied or used without our written authorization and it is strictly prohibited to disclose it to any third parties.

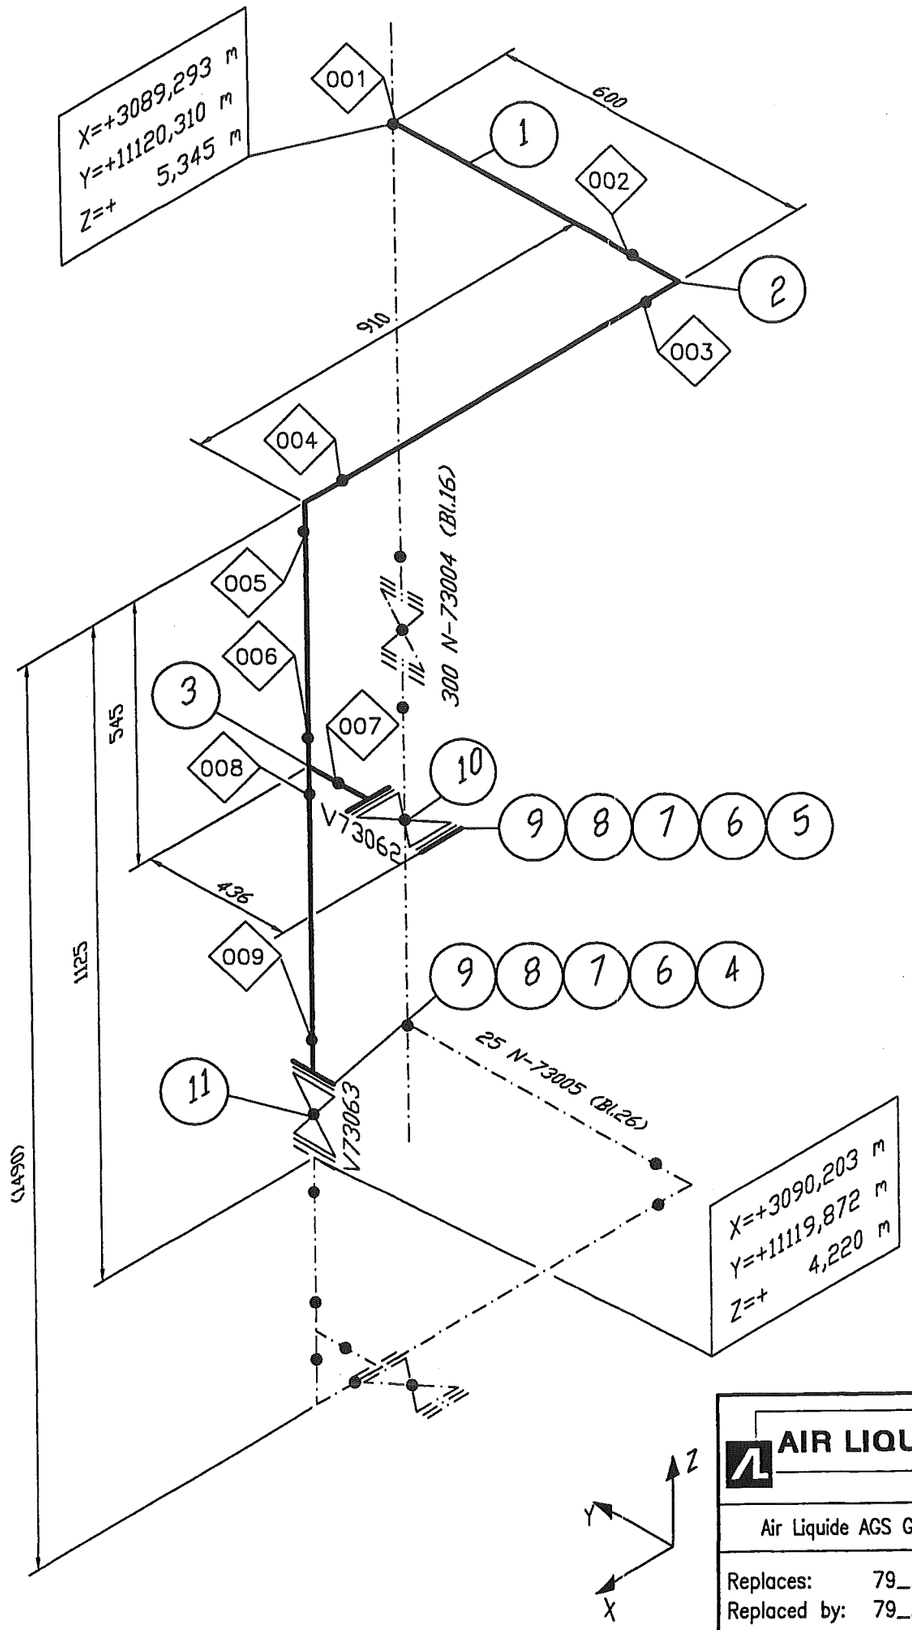

Welding No.	DN	ø	Welder No.	Protoc. No.
001	25	33,9	___	___
002	25	33,9	___	___
003	25	33,9	___	___
004	25	33,9	___	___
005	25	33,9	___	___
006	25	33,9	___	___
007	25	33,9	___	___
008	25	33,9	___	___
009	25	33,9	___	___

Remarks:

Responsibility of the assembling company:
- Situation of mounting seams
- Situation of pass–lengths
- Check of measure details and pipe courses on the construction site
- Situation of the spindle at valve

Accompanying drawings:

- 300 N–73004
- 25 N–73004–AA40C1

Accompanying lists:

- Parts list:
  25 N–73005 ZB25C1

Pipe Standard:

- AL Standard No.:
  50026 / ZB25C1

AIR LIQUIDE

Air Liquide AGS GmbH

Replaces: 79_.-----
Replaced by: 79_.-----

Date :	Name :	Checked:	History file:
13.12.2004	WIP/Rad.	–	79287106.doc

Job code: K70101
Reference: ASU Kosice

Scale --:--
Original format DIN A3
Sheet: 025
of – Sheets

Title: 25 N 73005

Drawing No.: 792.87106
Rev. A

This drawing is protected by copyright.
It may not be copied or used without our written authorization and it is strictly prohibited to disclose it to any third parties.

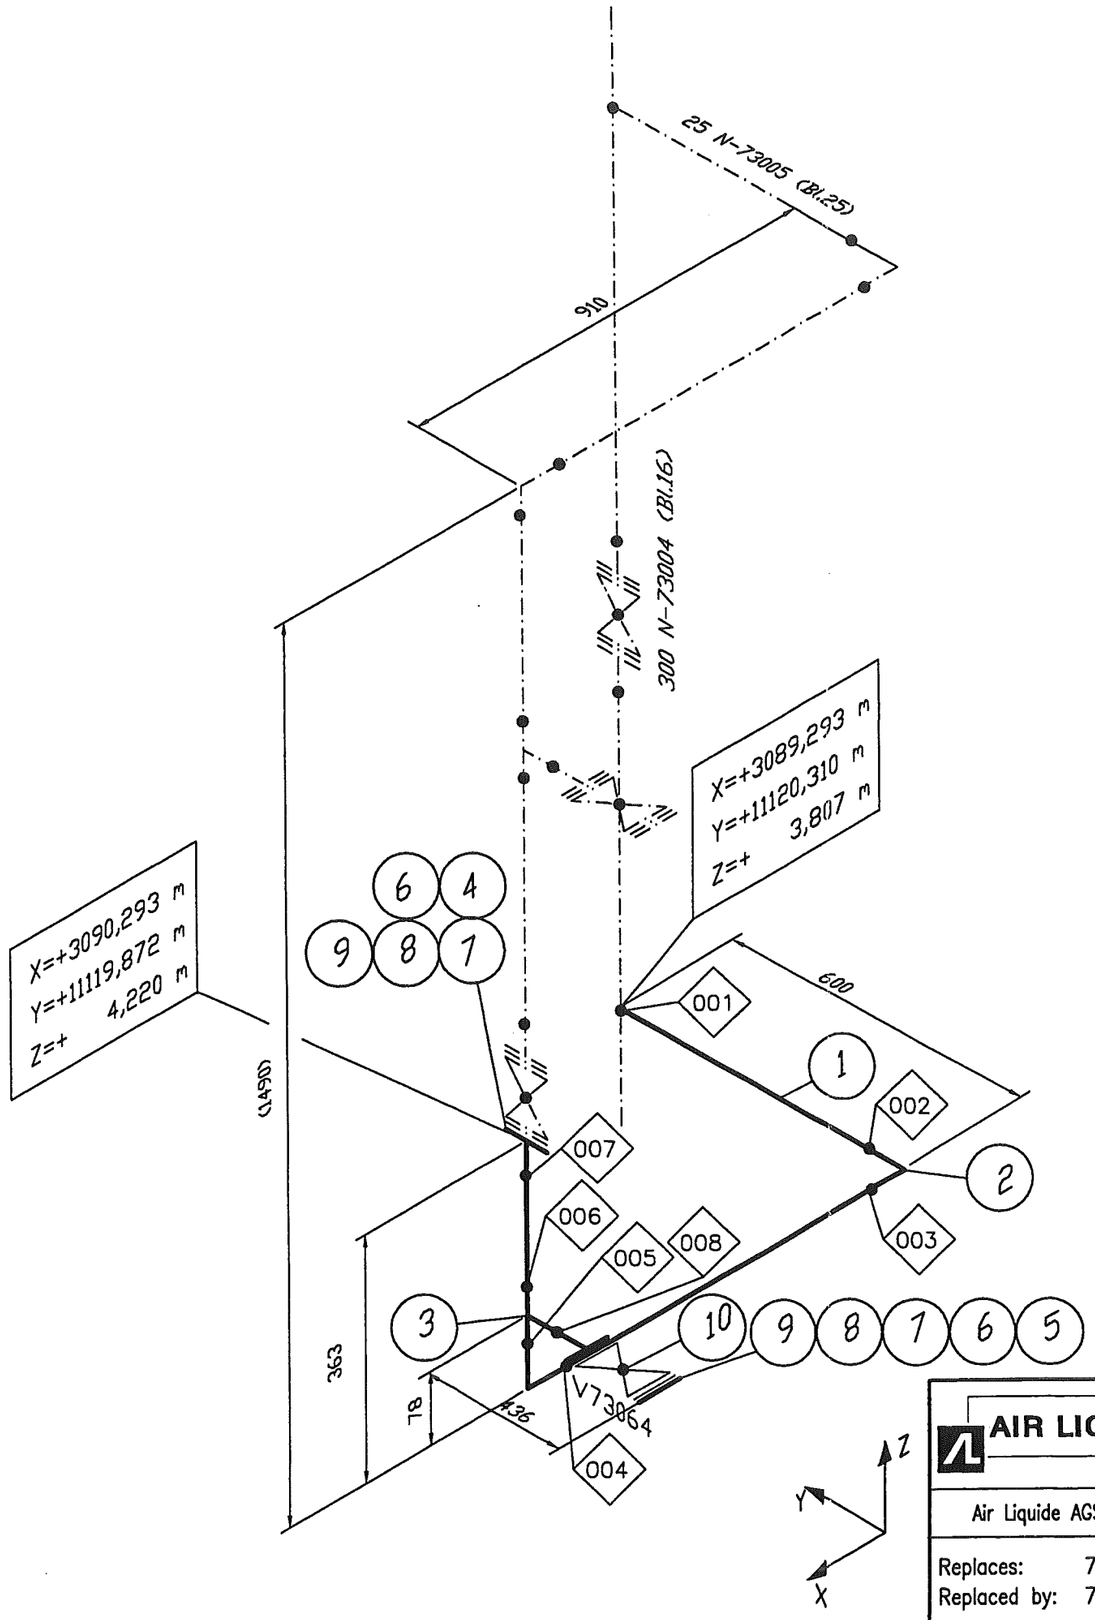

Welding No.	DN	ø	Welder No.	Protoc. No.
001	25	33,9	___	___
002	25	33,9	___	___
003	25	33,9	___	___
004	25	33,9	___	___
005	25	33,9	___	___
006	25	33,9	___	___
007	25	33,9	___	___
008	25	33,9	___	___

Remarks:

Responsibility of the assembling company:
- Situation of mounting seams
- Situation of pass-lengths
- Check of measure details and pipe courses on the construction site
- Situation of the spindle at valve

Accompanying drawings:

- 300 N-73004
- 25 N-73004

Accompanying lists:

- Parts list:
  25 N-73005 AA40C1

Pipe Standard:

- AL Standard No.:
  50013 / AA40C1

AIR LIQUIDE™

Air Liquide AGS GmbH

Replaces: 79_._____
Replaced by: 79_.-----

Date :	Name :	Checked:	History file:
13.12.2004	WIP/Rad.	–	79287106.doc

Job code: K70101
Reference: ASU Kosice

Scale --:--
Original format DIN A3
Sheet: 026
of – Sheets

Title: 25 N 73005

Drawing No.: 792.87106
Rev.: A

This drawing is protected by copyright.
It may not be copied or used without our written authorization and it is strictly prohibited to disclose it to any third parties.

Welding No.	DN	ø	Welder No.	Protoc. No.
001	25	33,7	___	___
002	25	33,7	___	___
003	25	33,7	___	___
004	25	33,7	___	___
005	25	33,7	___	___
006	25	33,7	___	___
007	25	33,7	___	___

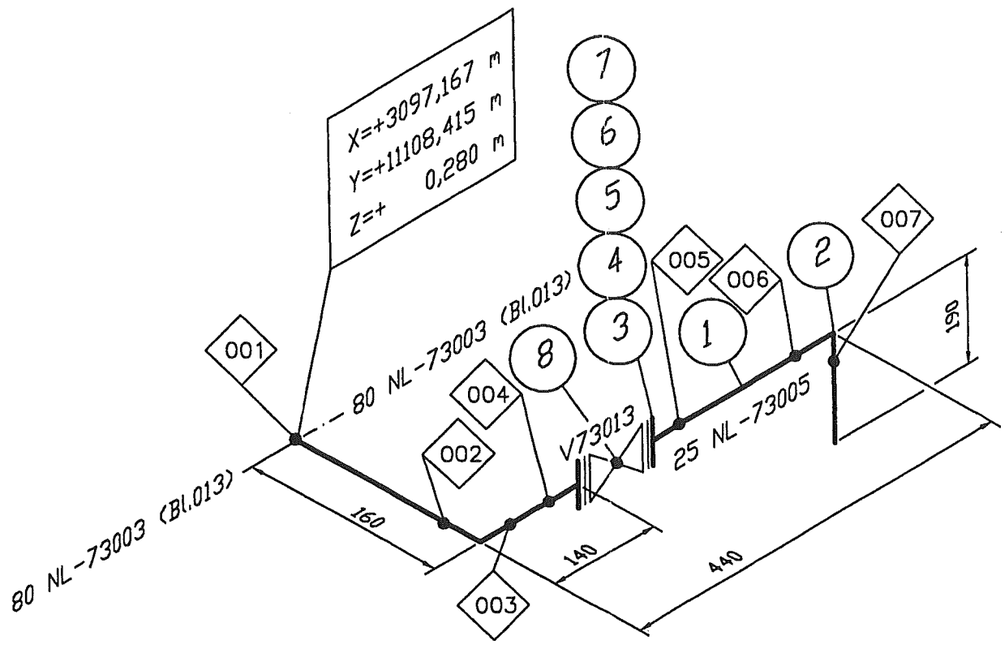

Remarks:

Responsibility of the assembling company:
- Situation of mounting seams
- Situation of pass–lengths
- Check of measure details and pipe courses on the construction site
- Situation of the spindle at valve

Accompanying drawings:

- 80 NL–73003

Accompanying lists:

- Parts list:
  25 NL–73005

Pipe Standard:

- AL Standard No.:
  50026 / ZB25C1

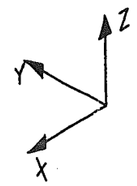

AIR LIQUIDE™

Air Liquide AGS GmbH

Replaces: 79_.-----
Replaced by: 79_.-----

Date :	Name :	Checked:	History file:
29.10.2004	WIP/Rad.	–	79287106.doc

Job code: K70101
Reference: ASU Kosice

Scale --:--
Original format DIN A3
Sheet: 014
of – Sheets

Title: 25 NL 73005

Drawing No.: 792.87106
Rev. A

This drawing is protected by copyright.
It may not be copied or used without our written authorization and it is strictly prohibited to disclose it to any third parties.

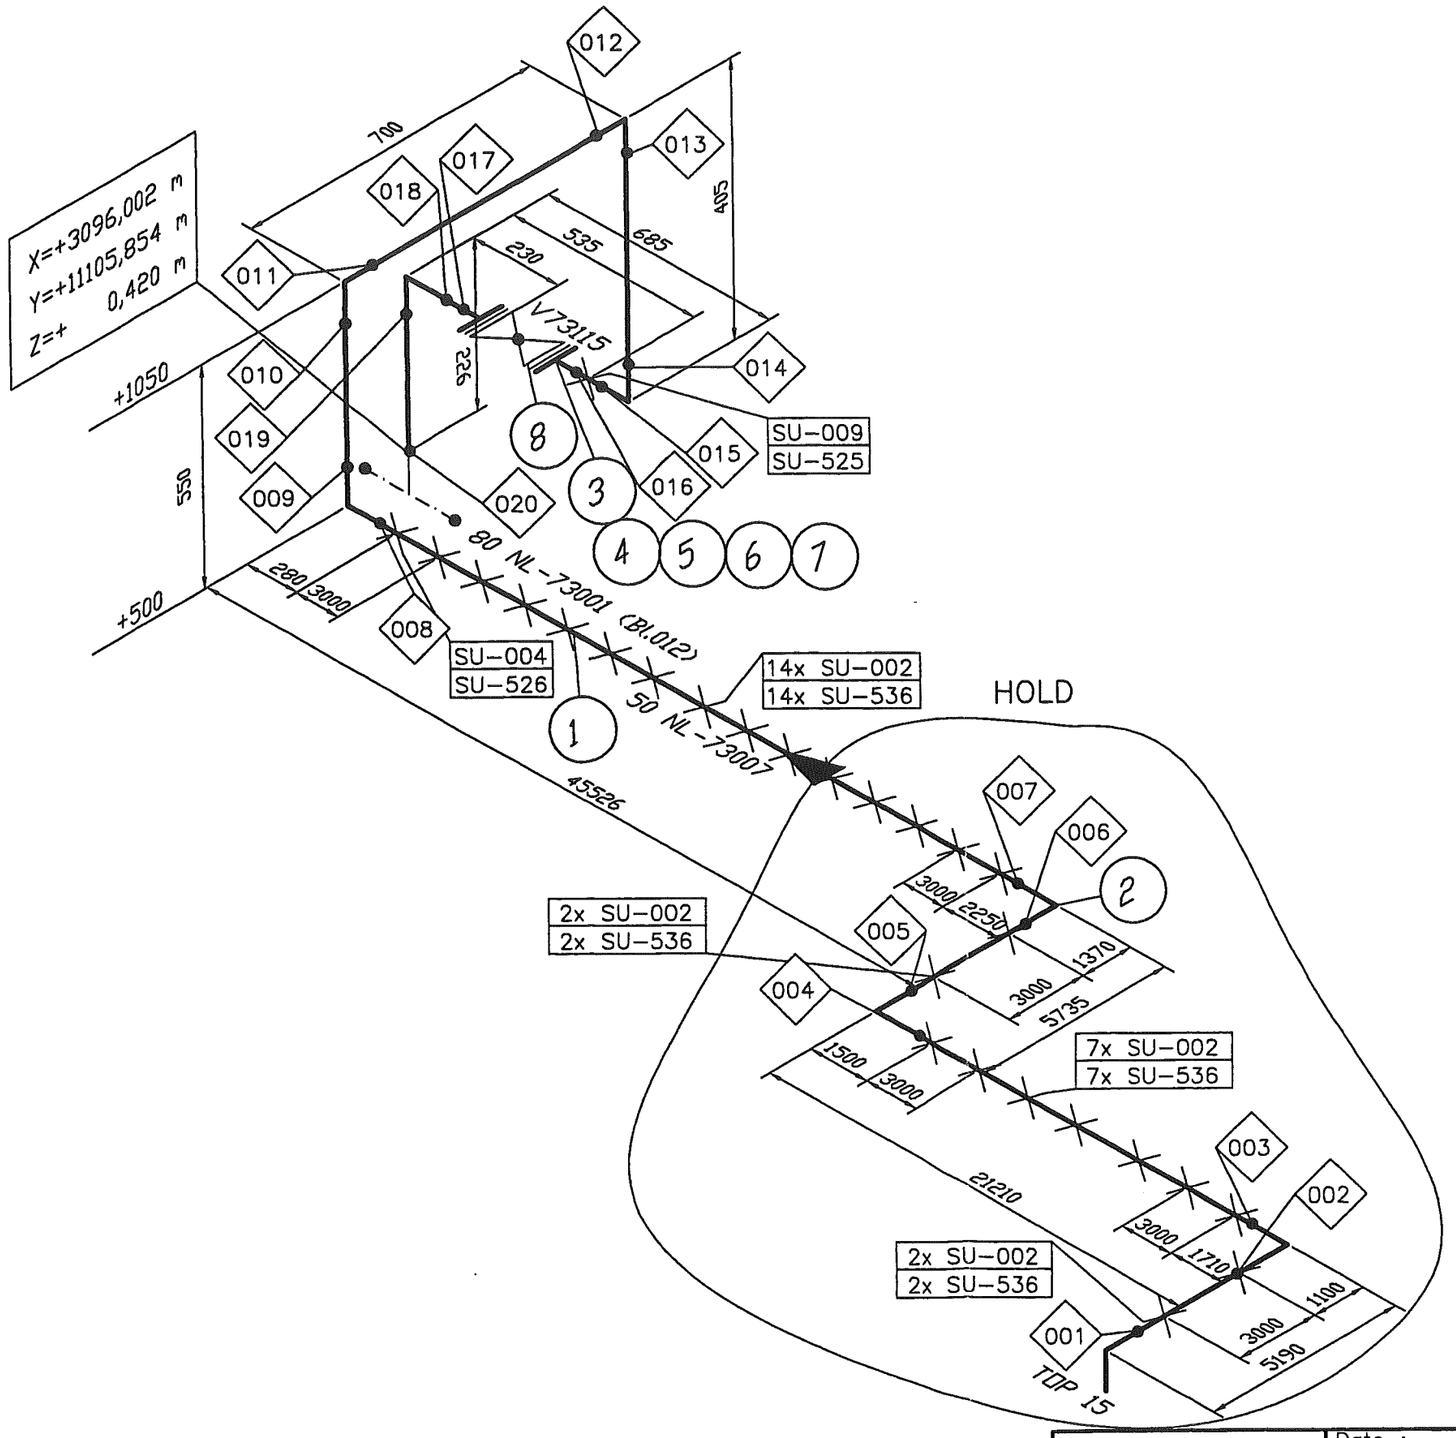

Welding No.	DN	ø	Welder No.	Protoc No.
001	50	60,3	___	___
002	50	60,3	___	___
003	50	60,3	___	___
004	50	60,3	___	___
005	50	60,3	___	___
006	50	60,3	___	___
007	50	60,3	___	___
008	50	60,3	___	___
009	50	60,3	___	___
010	50	60,3	___	___
011	50	60,3	___	___
012	50	60,3	___	___
013	50	60,3	___	___
014	50	60,3	___	___
015	50	60,3	___	___
016	50	60,3	___	___
017	50	60,3	___	___
018	50	60,3	___	___
019	50	60,3	___	___
020	50	60,3	___	___

Remarks:

Responsibility of the assembling company:
- Situation of mounting seams
- Situation of pass-lengths
- Check of measure details and pipe courses on the construction site
- Situation of the spindle at valve

Accompanying drawings:

- 80 NL-73001

Accompanying lists:

- Parts list:
  50 NL 73007

Pipe Standard:

- AL Standard No.:
  50026 / ZB25C1

AIR LIQUIDE	Date : 28.10.2004	Name : WIP/Rad.	Checked: –
Air Liquide AGS GmbH	Job code: K70101	Reference: ASU Kosice	History file: 79287106.doc
Replaces: 79_.____	Replaced by: 79_.-----	Title: 50 NL 73007	Scale --:--
Original format DIN A3	Sheet: 009	of – Sheets	Drawing No.: 792.87106
Rev. ___			

This drawing is protected by copyright.
It may not be copied or used without our written authorization and it is strictly prohibited to disclose it to any third parties.

Welding No.	DN	Diameter	Welder No.	Protocoll No.
01	80	88,9	____	____
02	80	88,9	____	____
03	80	88,9	____	____
04	80	88,9	____	____
05	80	88,9	____	____
06	80	88,9	____	____
07	40	48,3	____	____
08		12	____	____

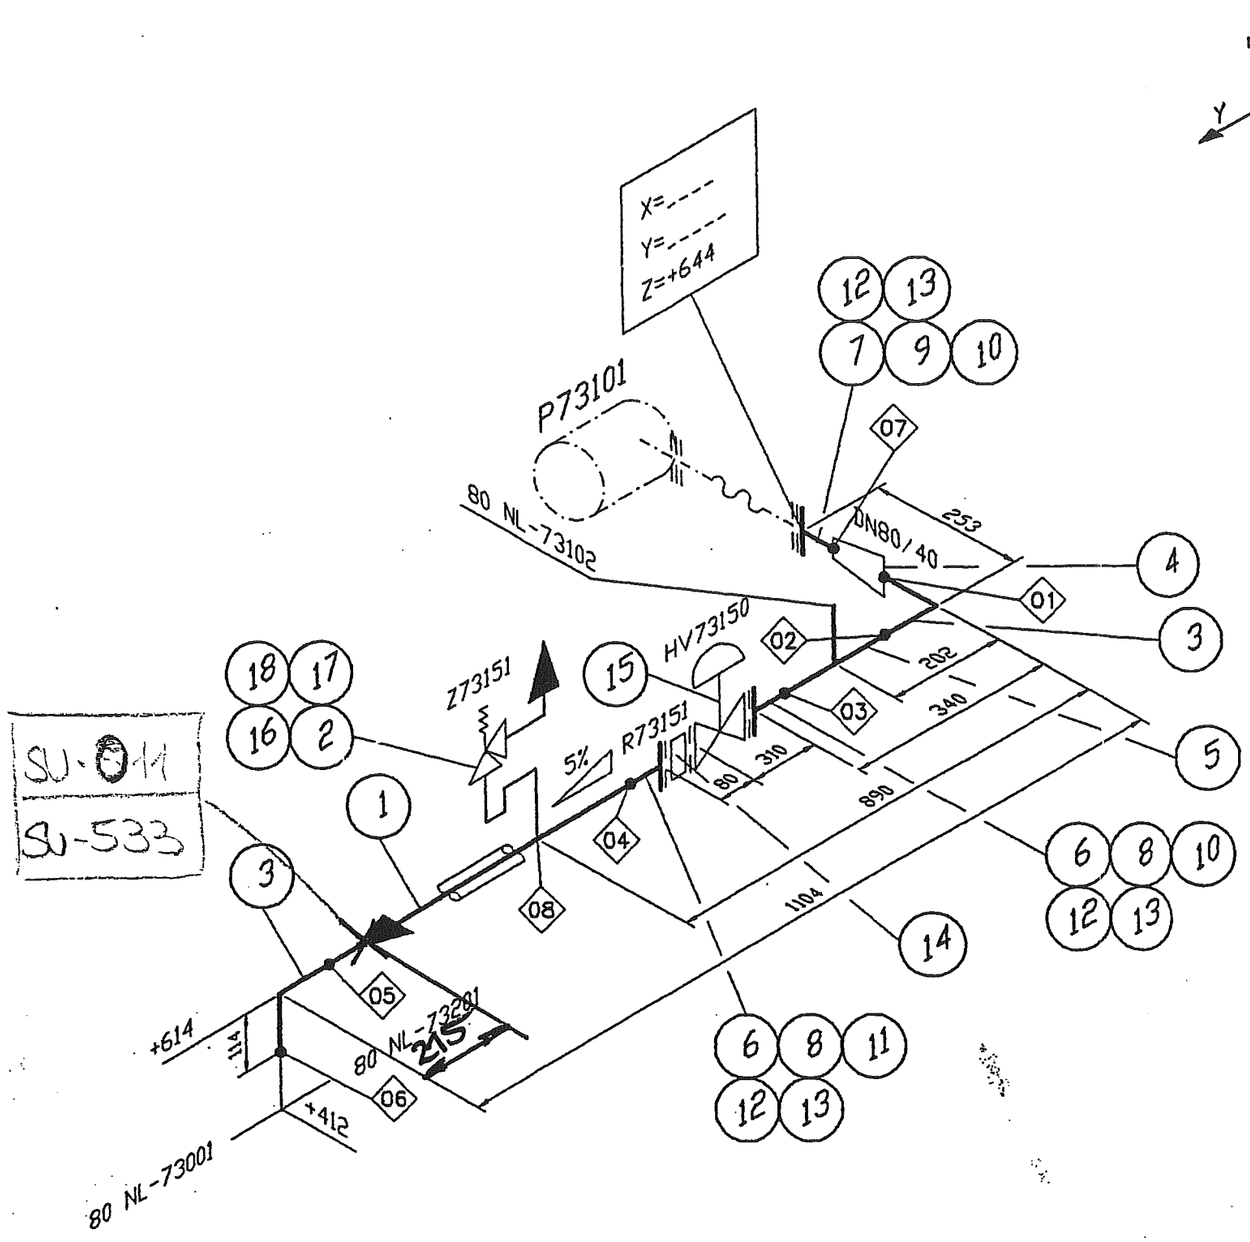

SU-011
SU-533

Remarks:

Responsibility of the assembling company:
- Situation of mounting seams
- Situation of pass-lengths
- Check of measure details and pipe courses on the construction site
- Situation of the spindle at valve

Accompanying drawings:

- 80 NL-73201 ZB25C1C
- 80 NL-73001 ZB25C1C
- 80 NL-73102 ZB25C1C

Accompanying lists:

- Parts list:
  80 NL-73101 ZB25C1C

Pipe standard:

- AL Standard No.:
  50026

AIR LIQUIDE	Date : 25.10.2004	Name : Reid./IES	Checked: Hr. Gans	History file: 79287106.doc
Air Liquide AGS GmbH	Job code: K70101 Reference: ASU Kosice		Scale --:--	Original format DIN A3
			Sheet: 001	of 003 Sheets
Replaces: 79_____ Replaced by: 79_-----	Title: 80 NL-73101		Drawing No.: 792.87106	Rev. ___

This drawing is protected by copyright.
It may not be copied or used without our written authorization and it is strictly prohibited to disclose it to any third parties.

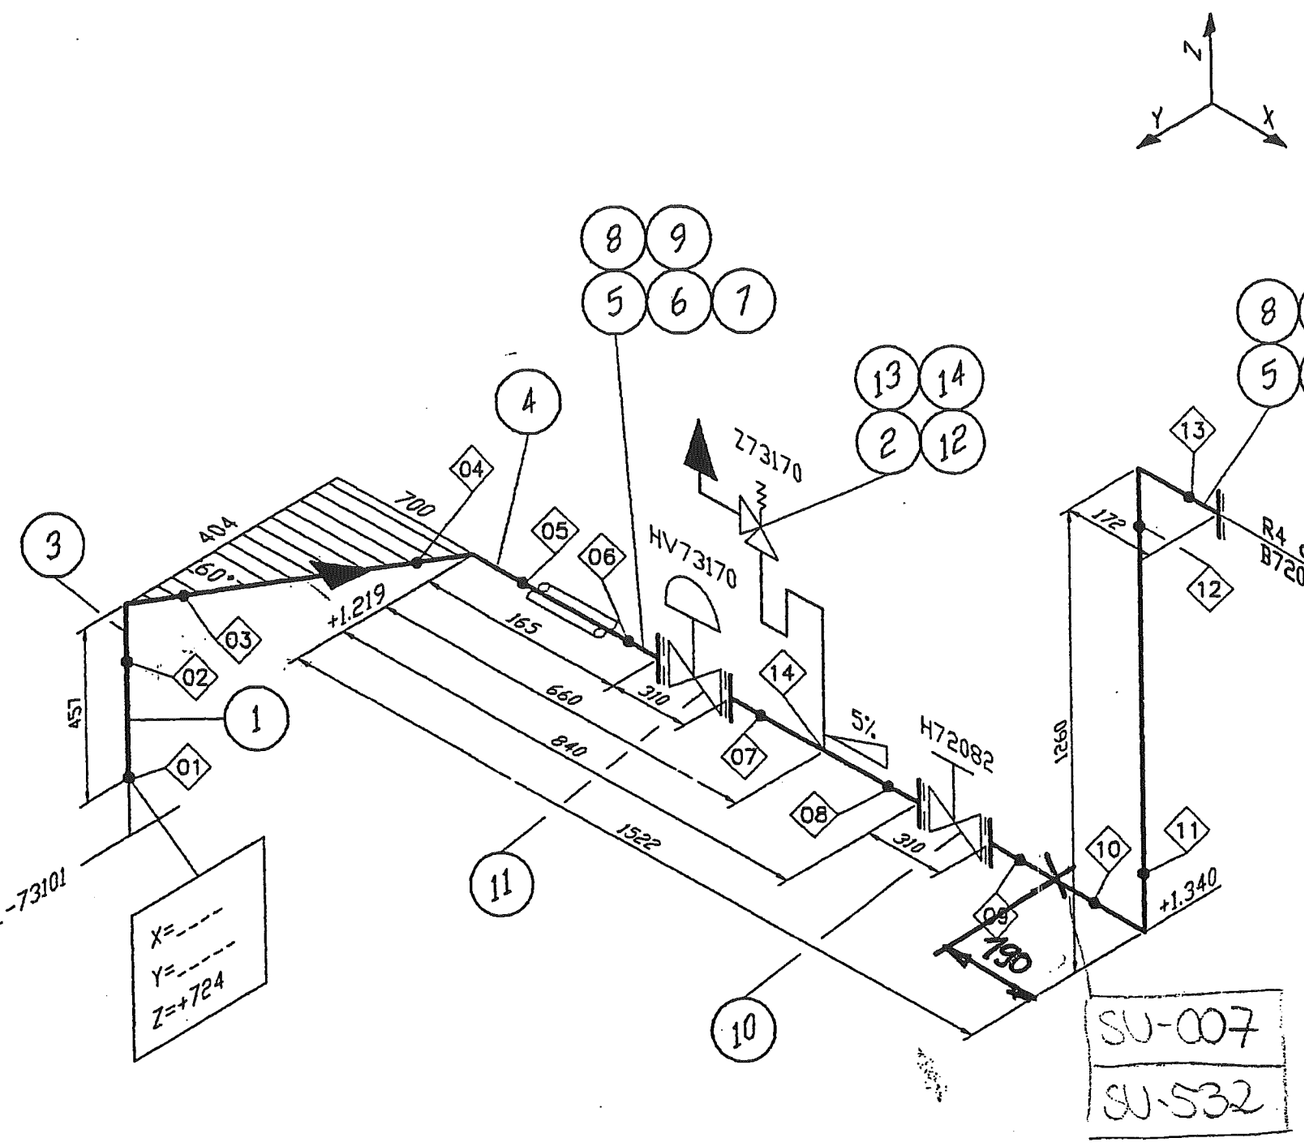

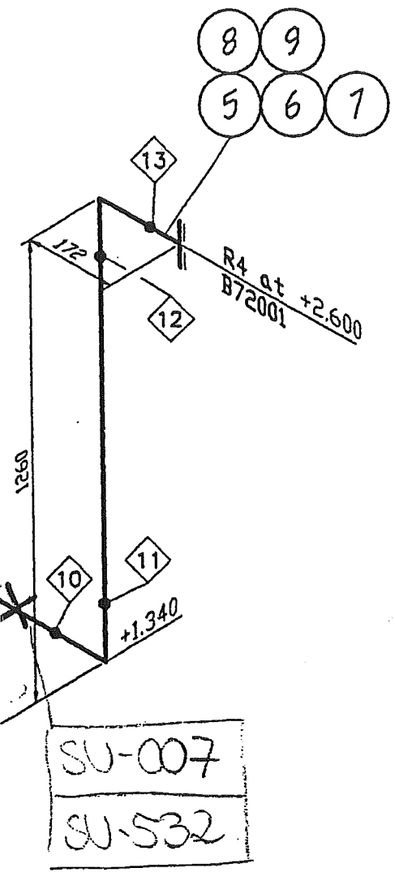

Welding No.	DN	Diameter	Welder No.	Protocoll No.
01	80	88,9	___	___
02	80	88,9	___	___
03	80	88,9	___	___
04	80	88,9	___	___
05	80	88,9	___	___
06	80	88,9	___	___
07	80	88,9	___	___
08	80	88,9	___	___
09	80	88,9	___	___
10	80	88,9	___	___
11	80	88,9	___	___
12	80	88,9	___	___
13	80	88,9	___	___
14		12	___	___

Remarks:

Responsibility of the assembling company:
- Situation of mounting seams
- Situation of pass-lengths
- Check of measure details and pipe courses on the construction site
- Situation of the spindle at valve

Accompanying drawings:

- 80 NL-73101 ZB25C1C

Accompanying lists:

- Parts list:
  80 NL-73102 ZB25C1C

Pipe standard:

- AL Standard No.:
  50026

AIR LIQUIDE	Date : 27.10.2004	Name : Reid./IES	Checked: Hr. Gans	History file: 79287106.doc
Air Liquide AGS GmbH	Job code: K70101	Reference: ASU Kosice	Scale --:--	Original format DIN A3
Replaces: 79_.____			Sheet: 001	of 001 Sheets
Replaced by: 79_.-----	Title: 80 NL-73102		Drawing No.: 792.87106	Rev. ___

This drawing is protected by copyright.
It may not be copied or used without our written authorization and it is strictly prohibited to disclose it to any third parties.

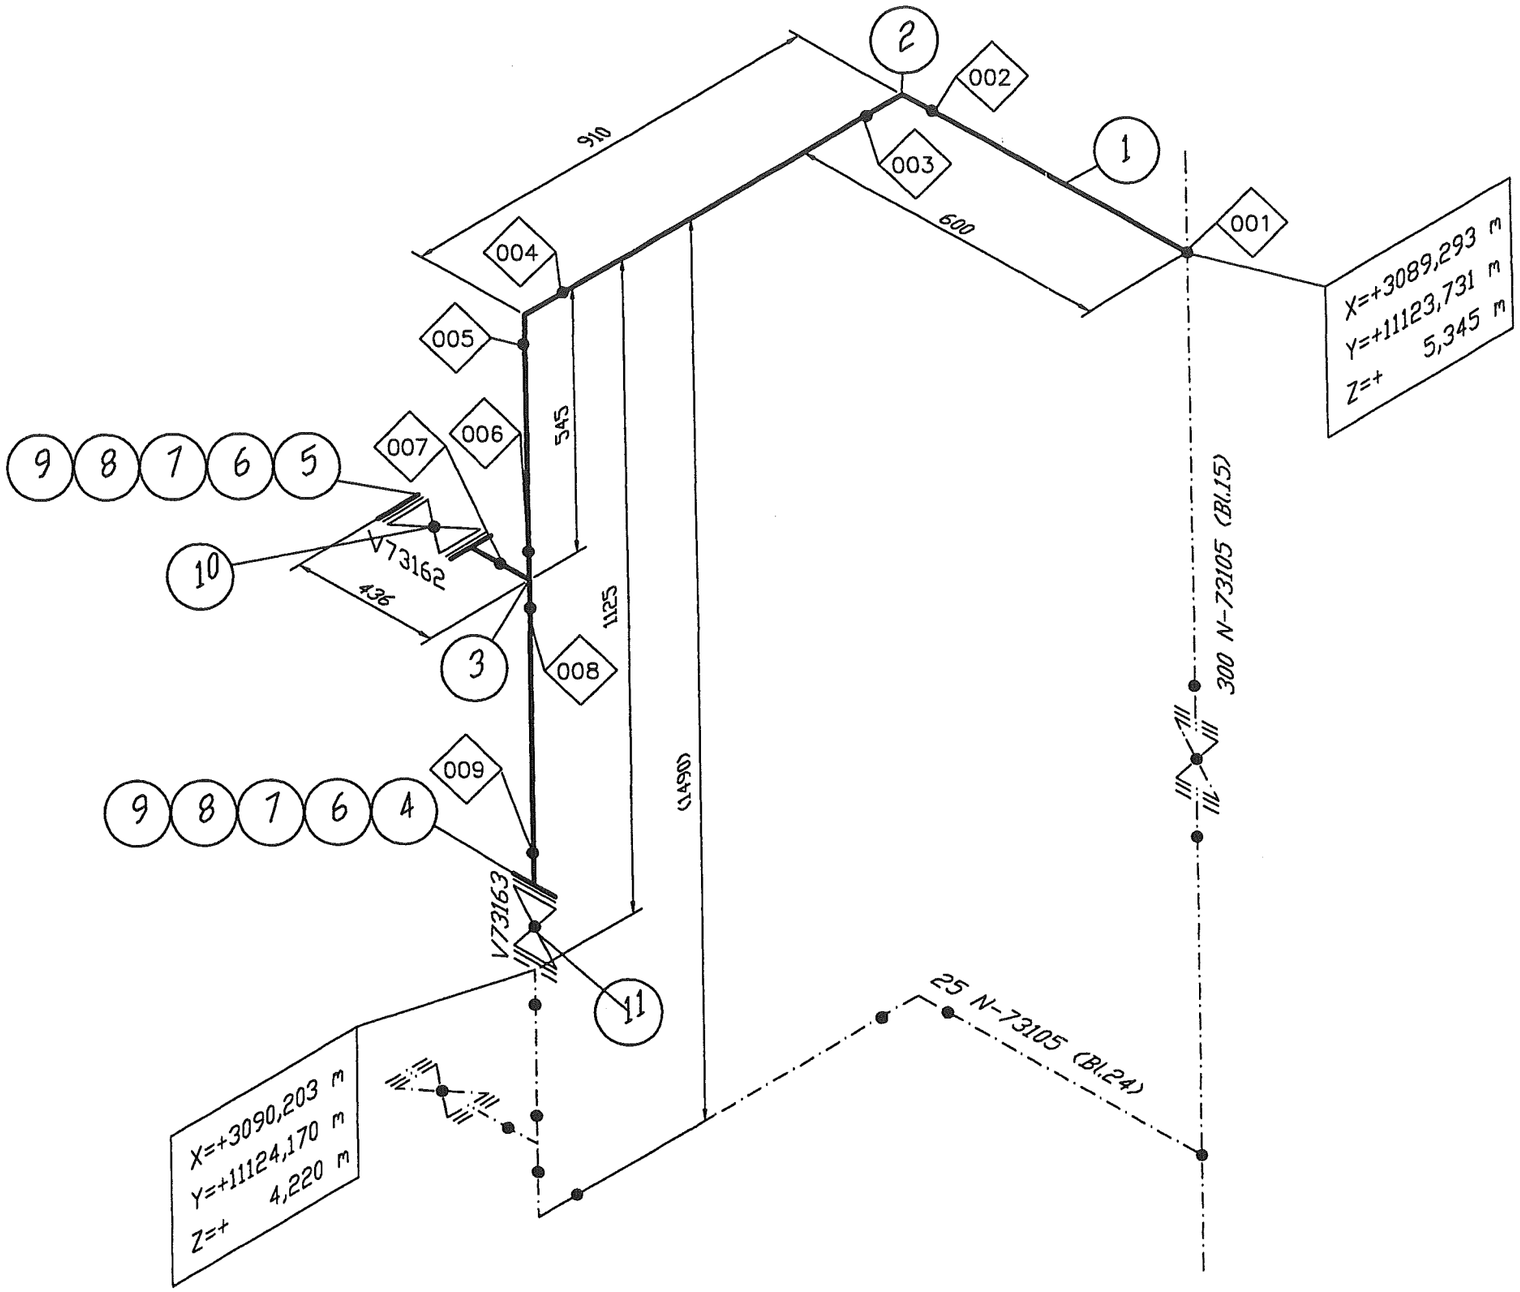

Welding No.	DN	ø	Welder No.	Protoc. No.
001	25	33,9	———	———
002	25	33,9	———	———
003	25	33,9	———	———
004	25	33,9	———	———
005	25	33,9	———	———
006	25	33,9	———	———
007	25	33,9	———	———
008	25	33,9	———	———
009	25	33,9	———	———

Remarks:

Responsibility of the assembling company:
- Situation of mounting seams
- Situation of pass–lengths
- Check of measure details and pipe courses on the construction site
- Situation of the spindle at valve

Accompanying drawings:

- 300 N–73105
- 25 N–73105–AA40C1

Accompanying lists:

- Parts list:
  25 N–73105 ZB40C1

Pipe Standard:

- AL Standard No.:
  50006 ZB40C1

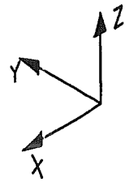

AIR LIQUIDE	Date : 13.12.2004	Name : WIP/Rad.	Checked: –	History file: 79287106.doc
Air Liquide AGS GmbH	Job code: K70101 Reference: ASU Kosice		Scale --:--	Original format DIN A3
			Sheet: 023	of – Sheets
Replaces: 79_.——— Replaced by: 79_.-----	Title: 25 N 73105		Drawing No.: 792.87106	Rev. A

This drawing is protected by copyright.
It may not be copied or used without our written authorization and it is strictly prohibited to disclose it to any third parties.

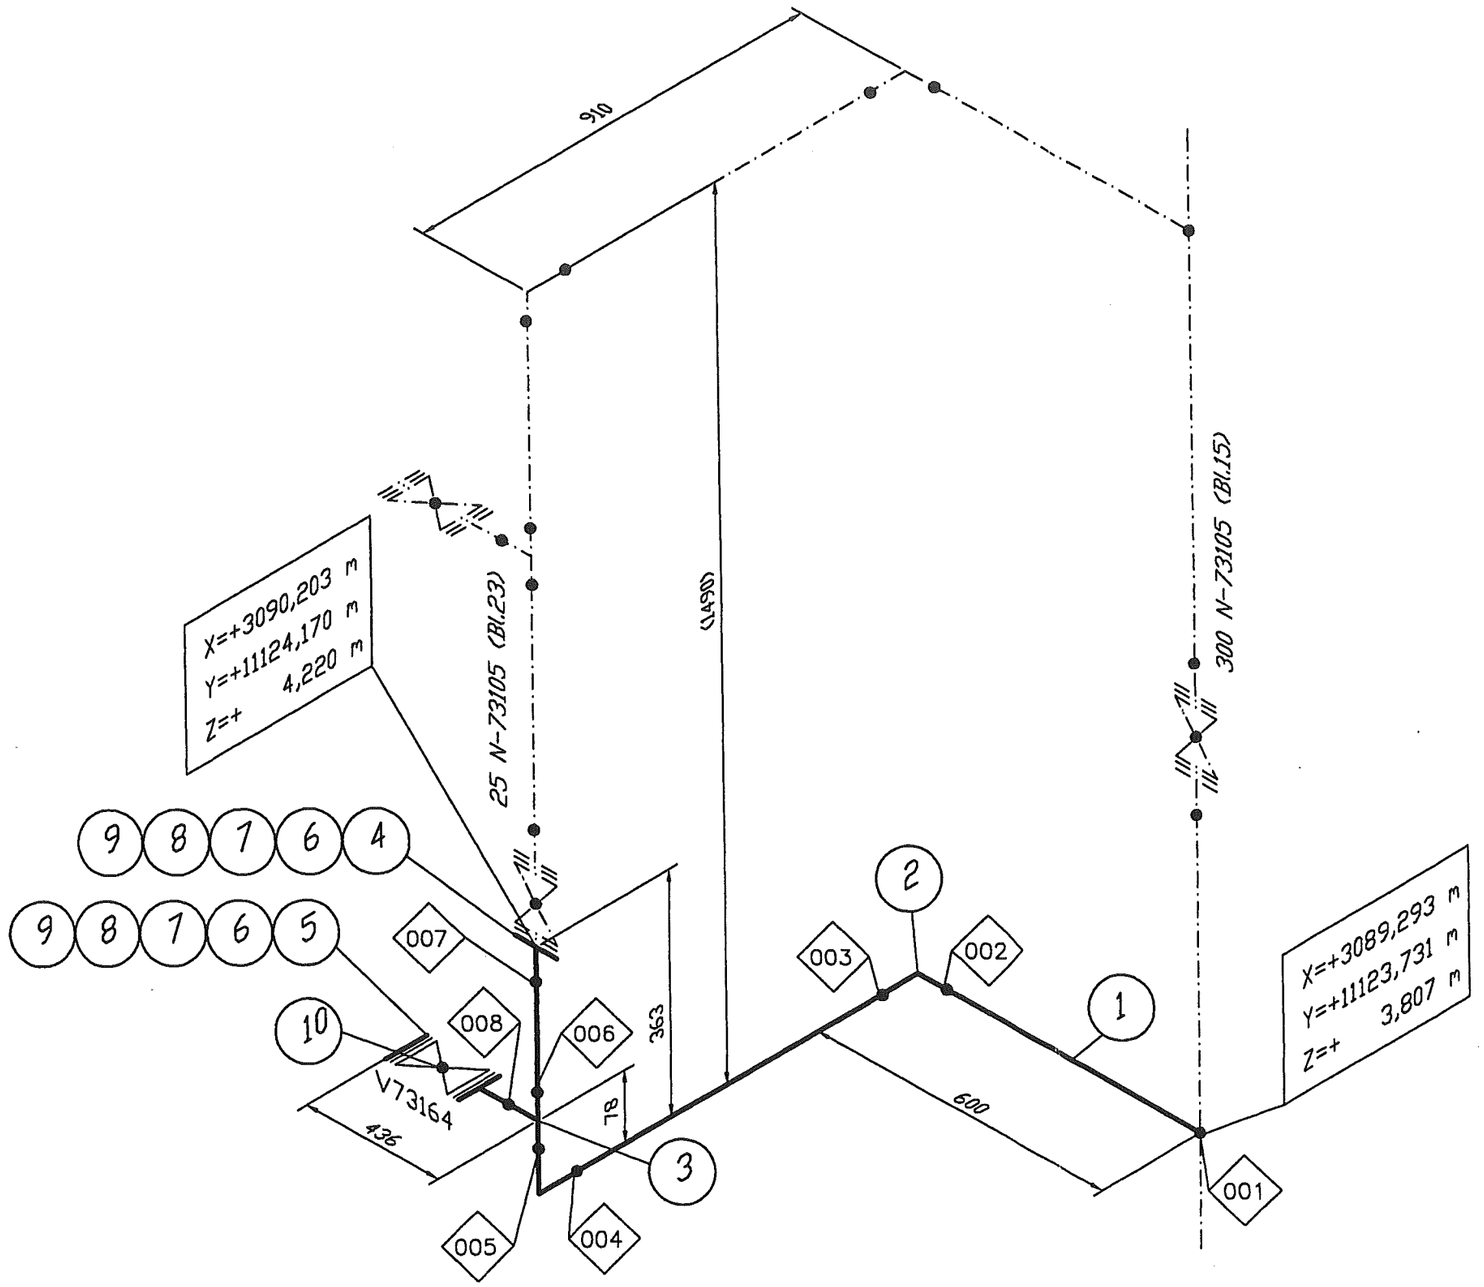

Welding No.	DN	ø	Welder No.	Protoc. No.
001	25	33,7	___	___
002	25	33,7	___	___
003	25	33,7	___	___
004	25	33,7	___	___
005	25	33,7	___	___
006	25	33,7	___	___
007	25	33,7	___	___
008	25	33,7	___	___

Remarks:

Responsibility of the assembling company:
- Situation of mounting seams
- Situation of pass-lengths
- Check of measure details and pipe courses on the construction site
- Situation of the spindle at valve

Accompanying drawings:

- 300 N-73105
- 25 S-73105-ZB40C1

Accompanying lists:

- Parts list: 25 N-73105

Pipe Standard:

- AL Standard No.: 50013 / AA40C1

AIR LIQUIDE	Date : 13.12.2004	Name : WIP/Rad.	Checked: –	History file: 79287106.doc
Air Liquide AGS GmbH	Job code: K70101 Reference: ASU Kosice		Scale --:--	Original format DIN A3
			Sheet: 024	of – Sheets
Replaces: 79_.____ Replaced by: 79_.-----	Title: 25 N 73105		Drawing No.: 792.87106	Rev. A

This drawing is protected by copyright.
It may not be copied or used without our written authorization and it is strictly prohibited to disclose it to any third parties.

Welding No.	DN	ø	Welder No.	Protoc. No.
001	150	168,3	———	———
002	300	329,9	———	———
003	300	329,9	———	———
004			———	———
005	300	329,9	———	———
006			———	———
007		12	———	———
008			———	———
009	300	329,9	———	———
010			———	———
011	300	329,9	———	———
012			———	———
013	300	329,9	———	———
014	300	329,9	———	———

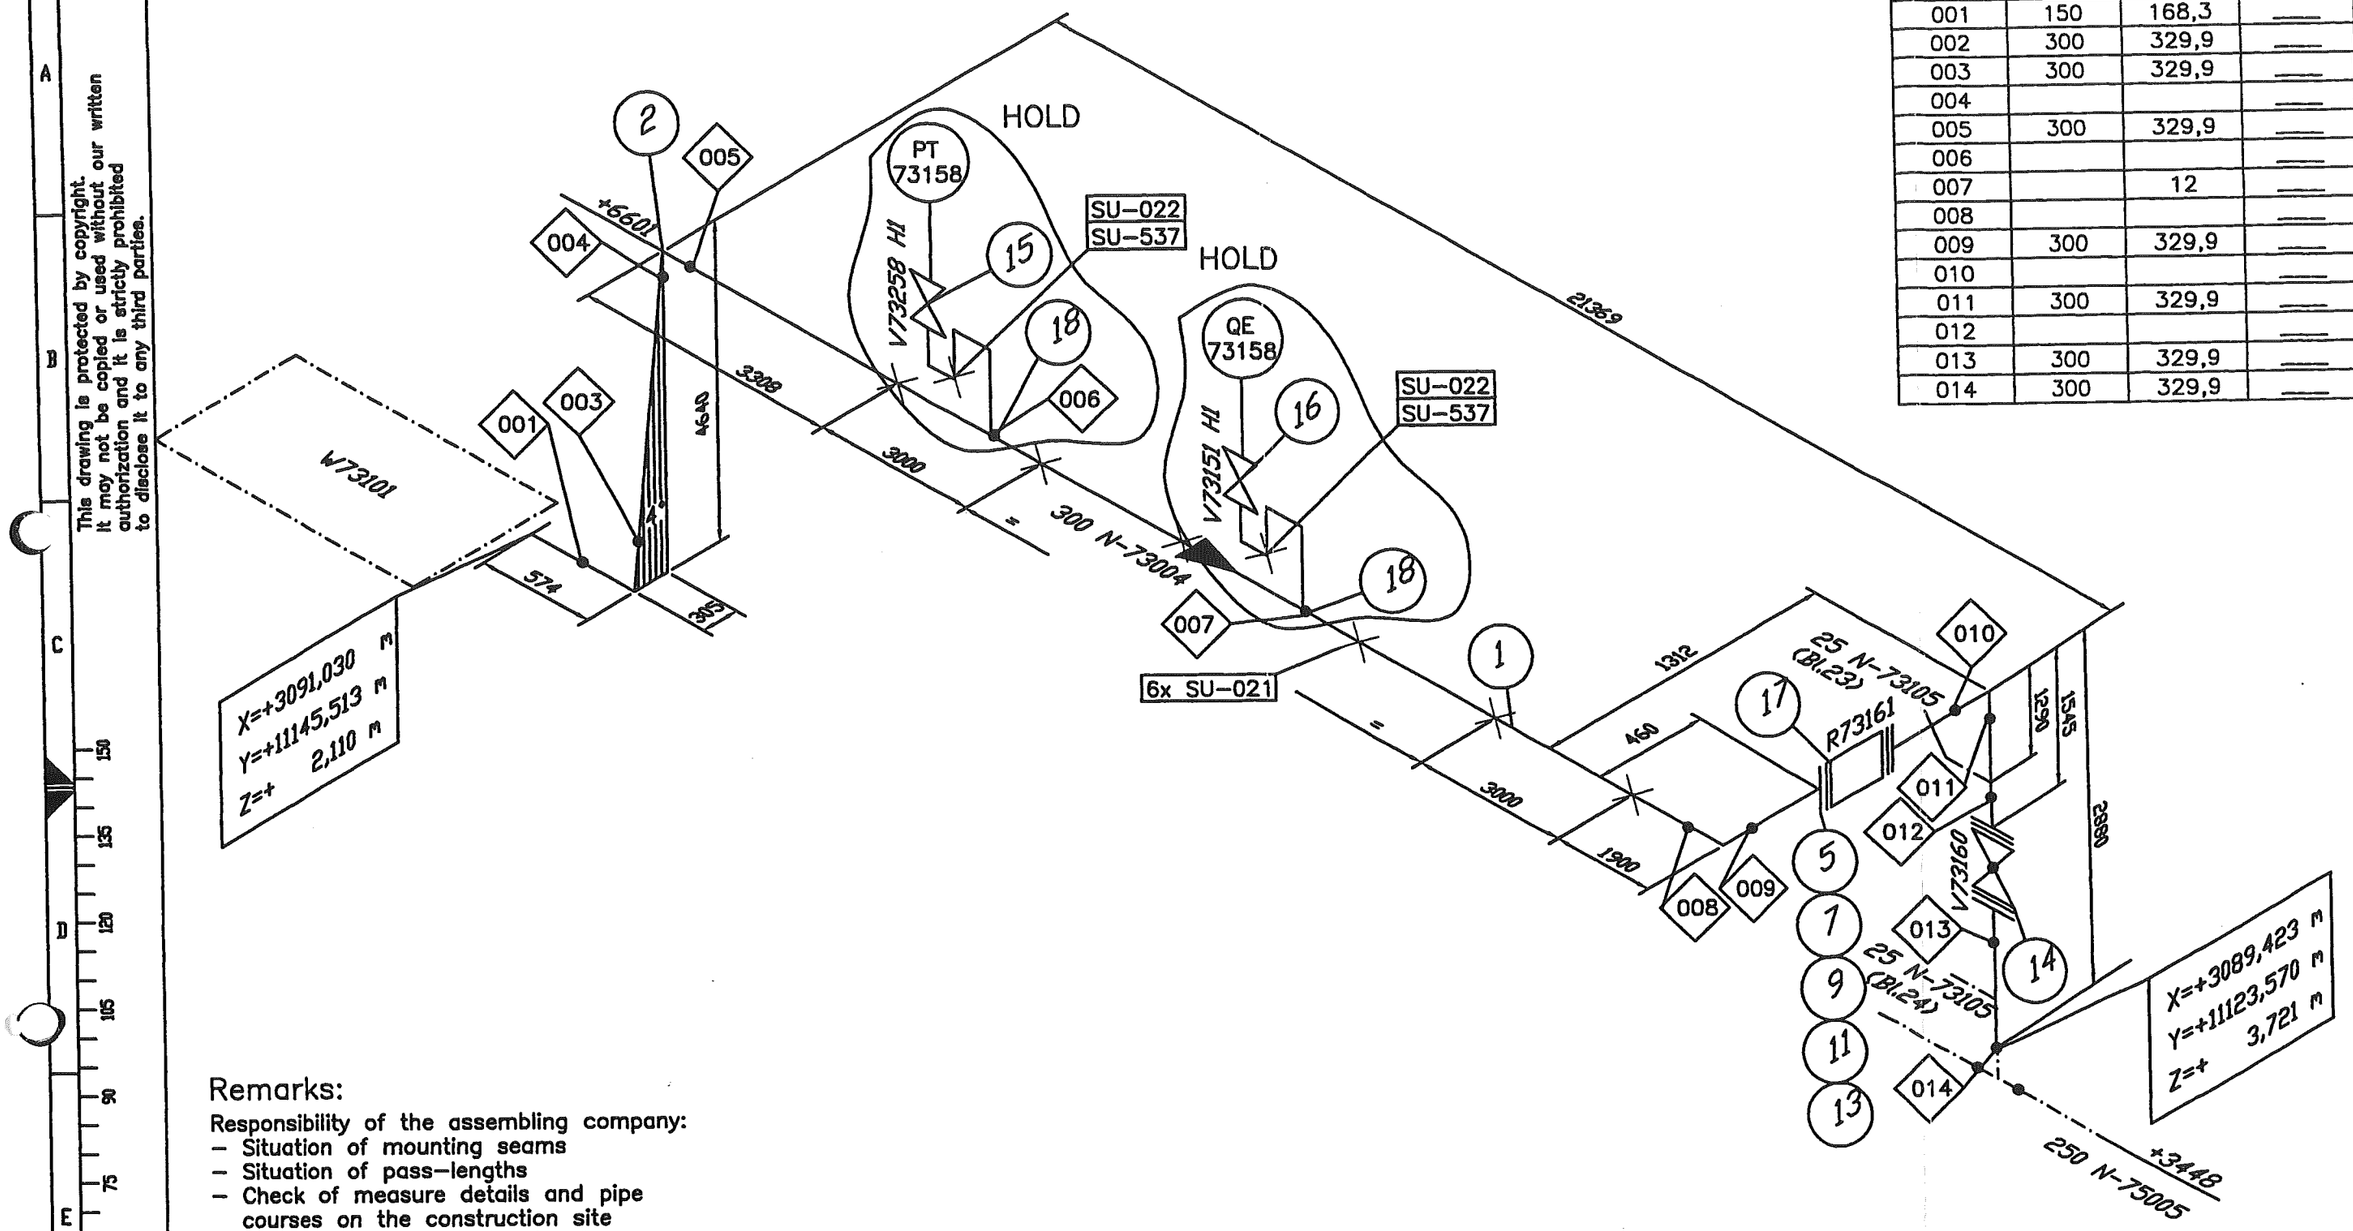

Remarks:

Responsibility of the assembling company:
- Situation of mounting seams
- Situation of pass-lengths
- Check of measure details and pipe courses on the construction site
- Situation of the spindle at valve

Accompanying drawings:

- 250 N-75005
- 25 N-73105 ZB25C1
- 25 N-73105 AA40C1

Accompanying lists:

- Parts list: 300 N-73105

Pipe Standard:

- AL Standard No.: 50013 / AA40C1

AIR LIQUIDE	Date : 08.11.2004	Name : WIP/Rad.	Checked: –	History file: 79287106.doc
Air Liquide AGS GmbH	Job code: K70101	Reference: ASU Kosice	Scale ---:--	Original format DIN A3
Replaces: 79_.———	Sheet: 015	of – Sheets		
Replaced by: 79_.-----	Title: 300 N 73105	Drawing No.: 792.87106	Rev. A	

This drawing is protected by copyright.
It may not be copied or used without our written authorization and it is strictly prohibited to disclose it to any third parties.

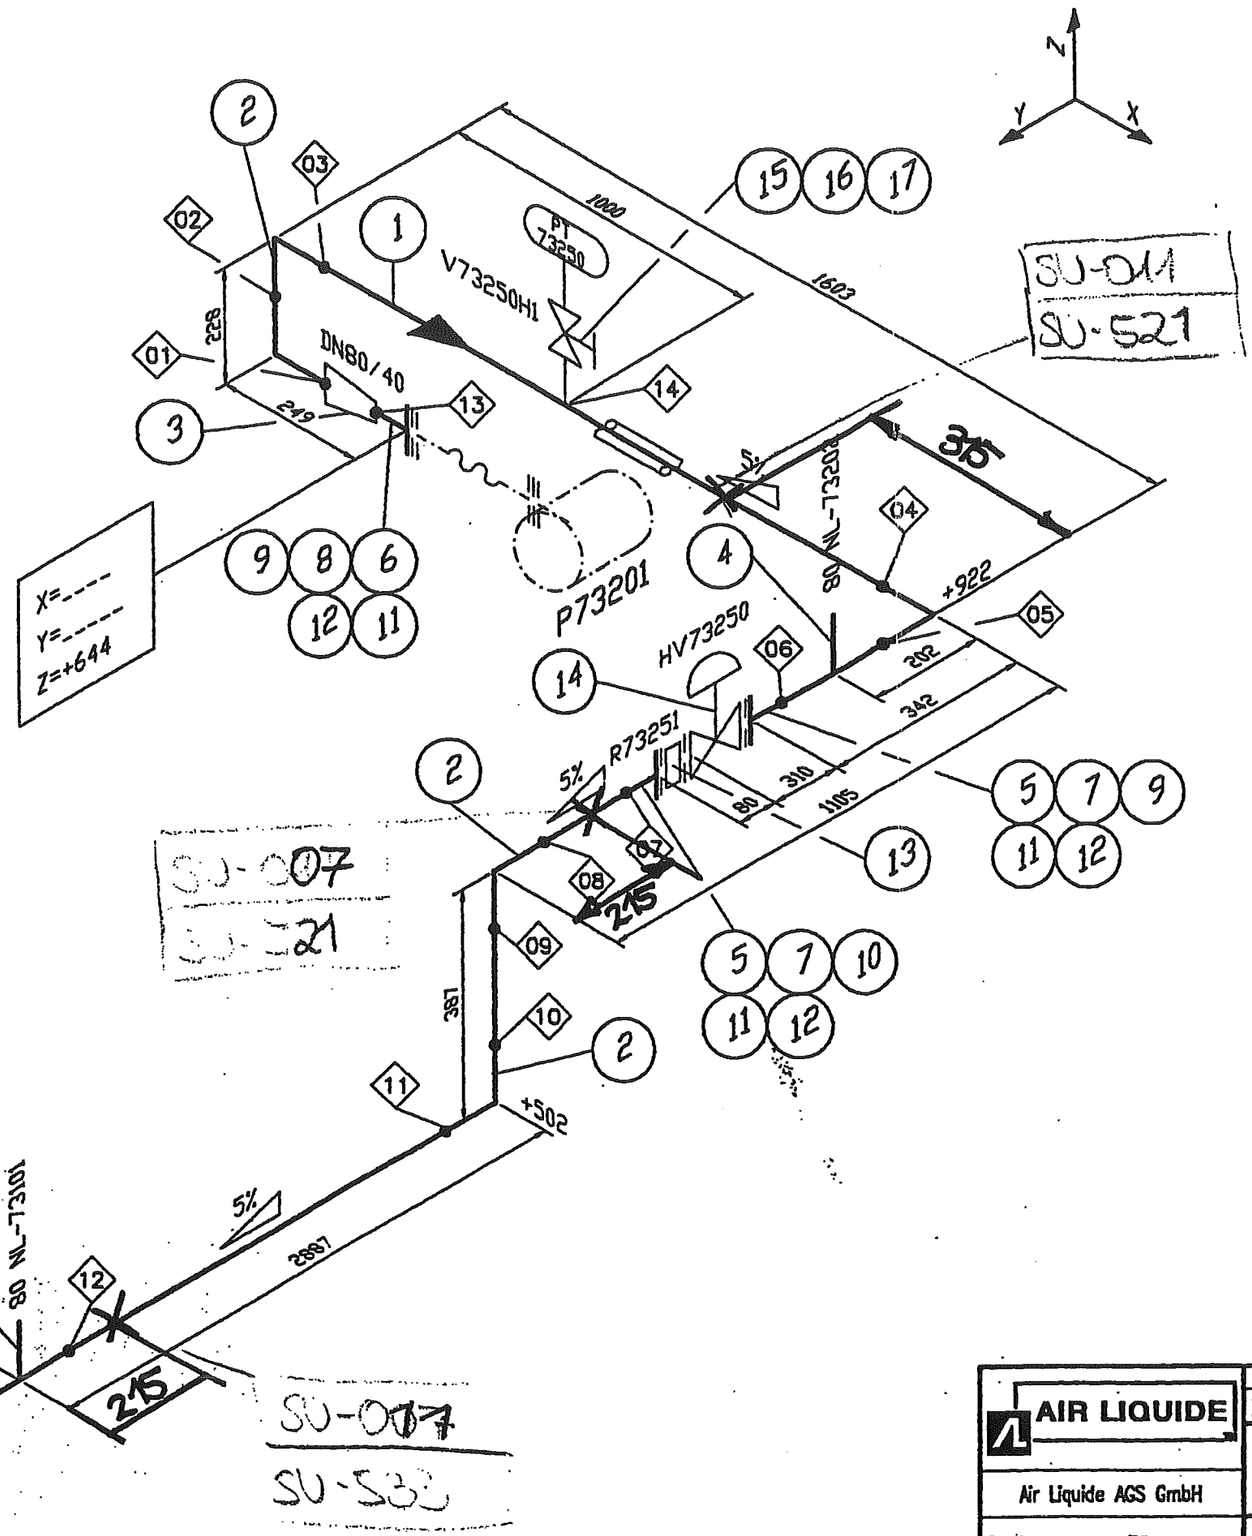

Welding No.	DN	Diameter	Welder No.	Protocoll No.
01	80	88,9	----	----
02	80	88,9	----	----
03	80	88,9	----	----
04	80	88,9	----	----
05	80	88,9	----	----
06	80	88,9	----	----
07	80	88,9	----	----
08	80	88,9	----	----
09	80	88,9	----	----
10	80	88,9	----	----
11	80	88,9	----	----
12	80	88,9	----	----
13	40	48,3	----	----
14		22	----	----

Remarks:

Responsibility of the assembling company:
- Situation of mounting seams
- Situation of pass-lengths
- Check of measure details and pipe courses on the construction site
- Situation of the spindle at valve

Accompanying drawings:

- 80 NL-73202 ZB25C1C
- 80 NL-73101 ZB25C1C
- 80 NL-73001 ZB25C1C

Accompanying lists:

- Parts list:
  80 NL-73201 ZB25C1C

Pipe standard:

- AL Standard No.:
  50026

AIR LIQUIDE	Date : 25.10.2004	Name : Reid./IES	Checked: Hr. Gans
Air Liquide AGS GmbH	Job code: K70101	Reference: ASU Kosice	History file: 79287106.doc
Replaces: 79_____ Replaced by: 79_____	Title: 80 NL-73201	Scale --:--	Original format DIN A3
		Sheet: 001	of 001 Sheets
		Drawing No.: 792.87106	Rev. ___

This drawing is protected by copyright.
It may not be copied or used without our written authorization and it is strictly prohibited to disclose it to any third parties.

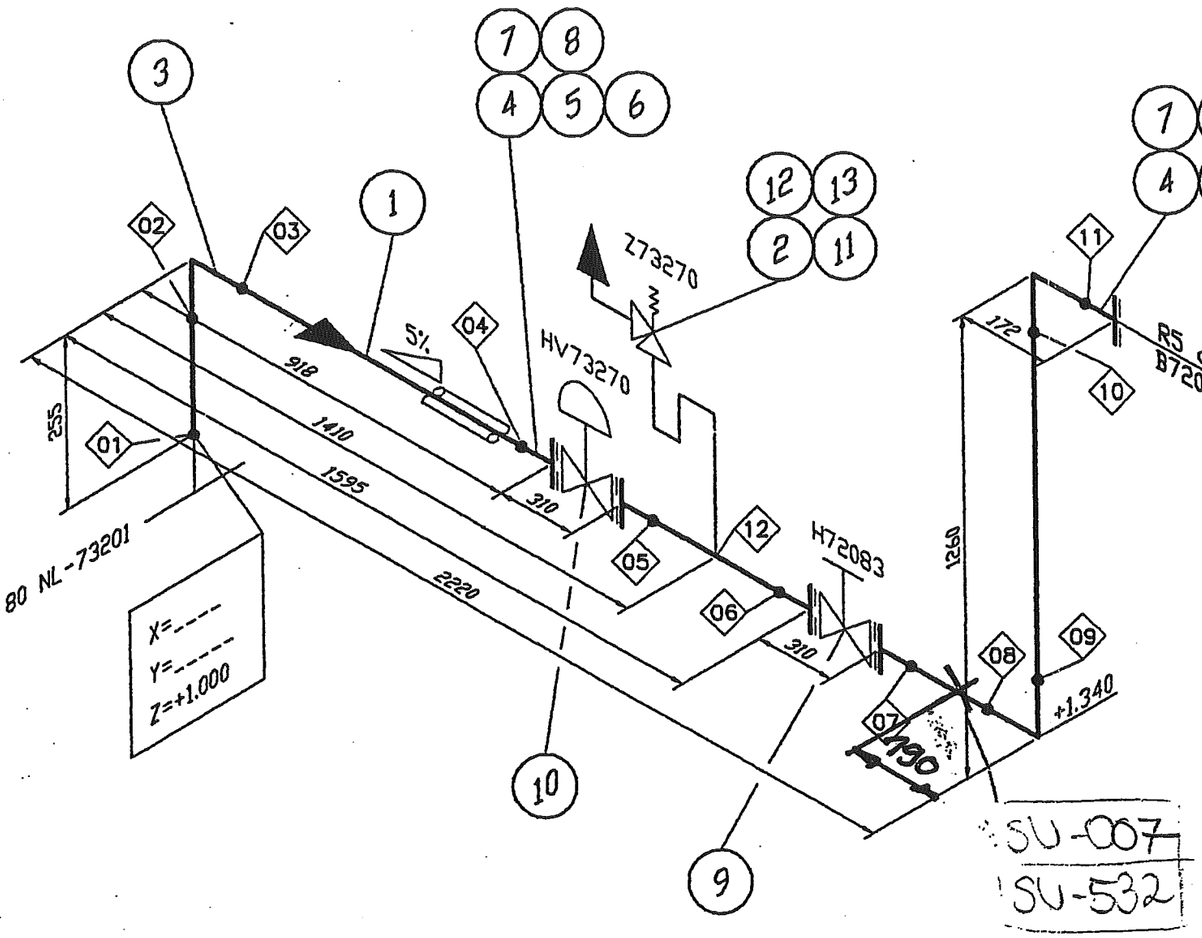

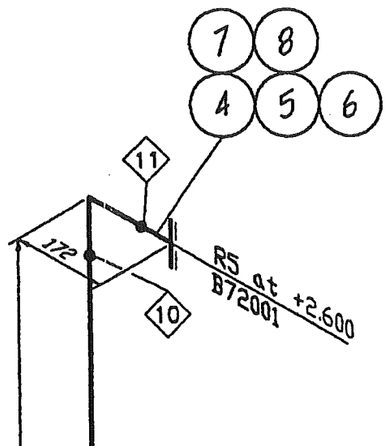

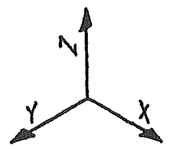

Welding No.	DN	Diameter	Welder No.	Protocoll No.
01	80	88,9	----	----
02	80	88,9	----	----
03	80	88,9	----	----
04	80	88,9	----	----
05	80	88,9	----	----
06	80	88,9	----	----
07	80	88,9	----	----
08	80	88,9	----	----
09	80	88,9	----	----
10	80	88,9	----	----
11	80	88,9	----	----
12		12	----	----

Remarks:

Responsibility of the assembling company:
- Situation of mounting seams
- Situation of pass-lengths
- Check of measure details and pipe courses on the construction site
- Situation of the spindle at valve

Accompanying drawings:

- 80 NL-73201 ZB25C1C

Accompanying lists:

- Parts list:
  80 NL-73202 ZB25C1C

Pipe standard:

- AL Standard No.:
  50026

AIR LIQUIDE	Date : 27.10.2004	Name : Reid./IES	Checked: Hr. Gans	History file: 79287106.doc
Air Liquide AGS GmbH	Job code: K70101	Reference: ASU Kosice	Scale --:--	Original format DIN A3
			Sheet: 001	of 001 Sheets
Replaces: 79_.____	Title: 80 NL-73202X		Drawing No.: 792.87106	Rev. ___
Replaced by: 79_.----				

This drawing is protected by copyright.
It may not be copied or used without our written authorization and it is strictly prohibited to disclose it to any third parties.

Welding No.	DN	ø	Welder No.	Protoc. No.
001	100	114,3	___	___
002	100	114,3	___	___
003	100	114,3	___	___
004	100	114,3	___	___
005	100	114,3	___	___
006	100	114,3	___	___
007	100	114,3	___	___
008	100	114,3	___	___
009	100	114,3	___	___
010	100	114,3	___	___
011	100	114,3	___	___
012	100	114,3	___	___
013	100	114,3	___	___
014	100	114,3	___	___
015	100	114,3	___	___
016	100	114,3	___	___

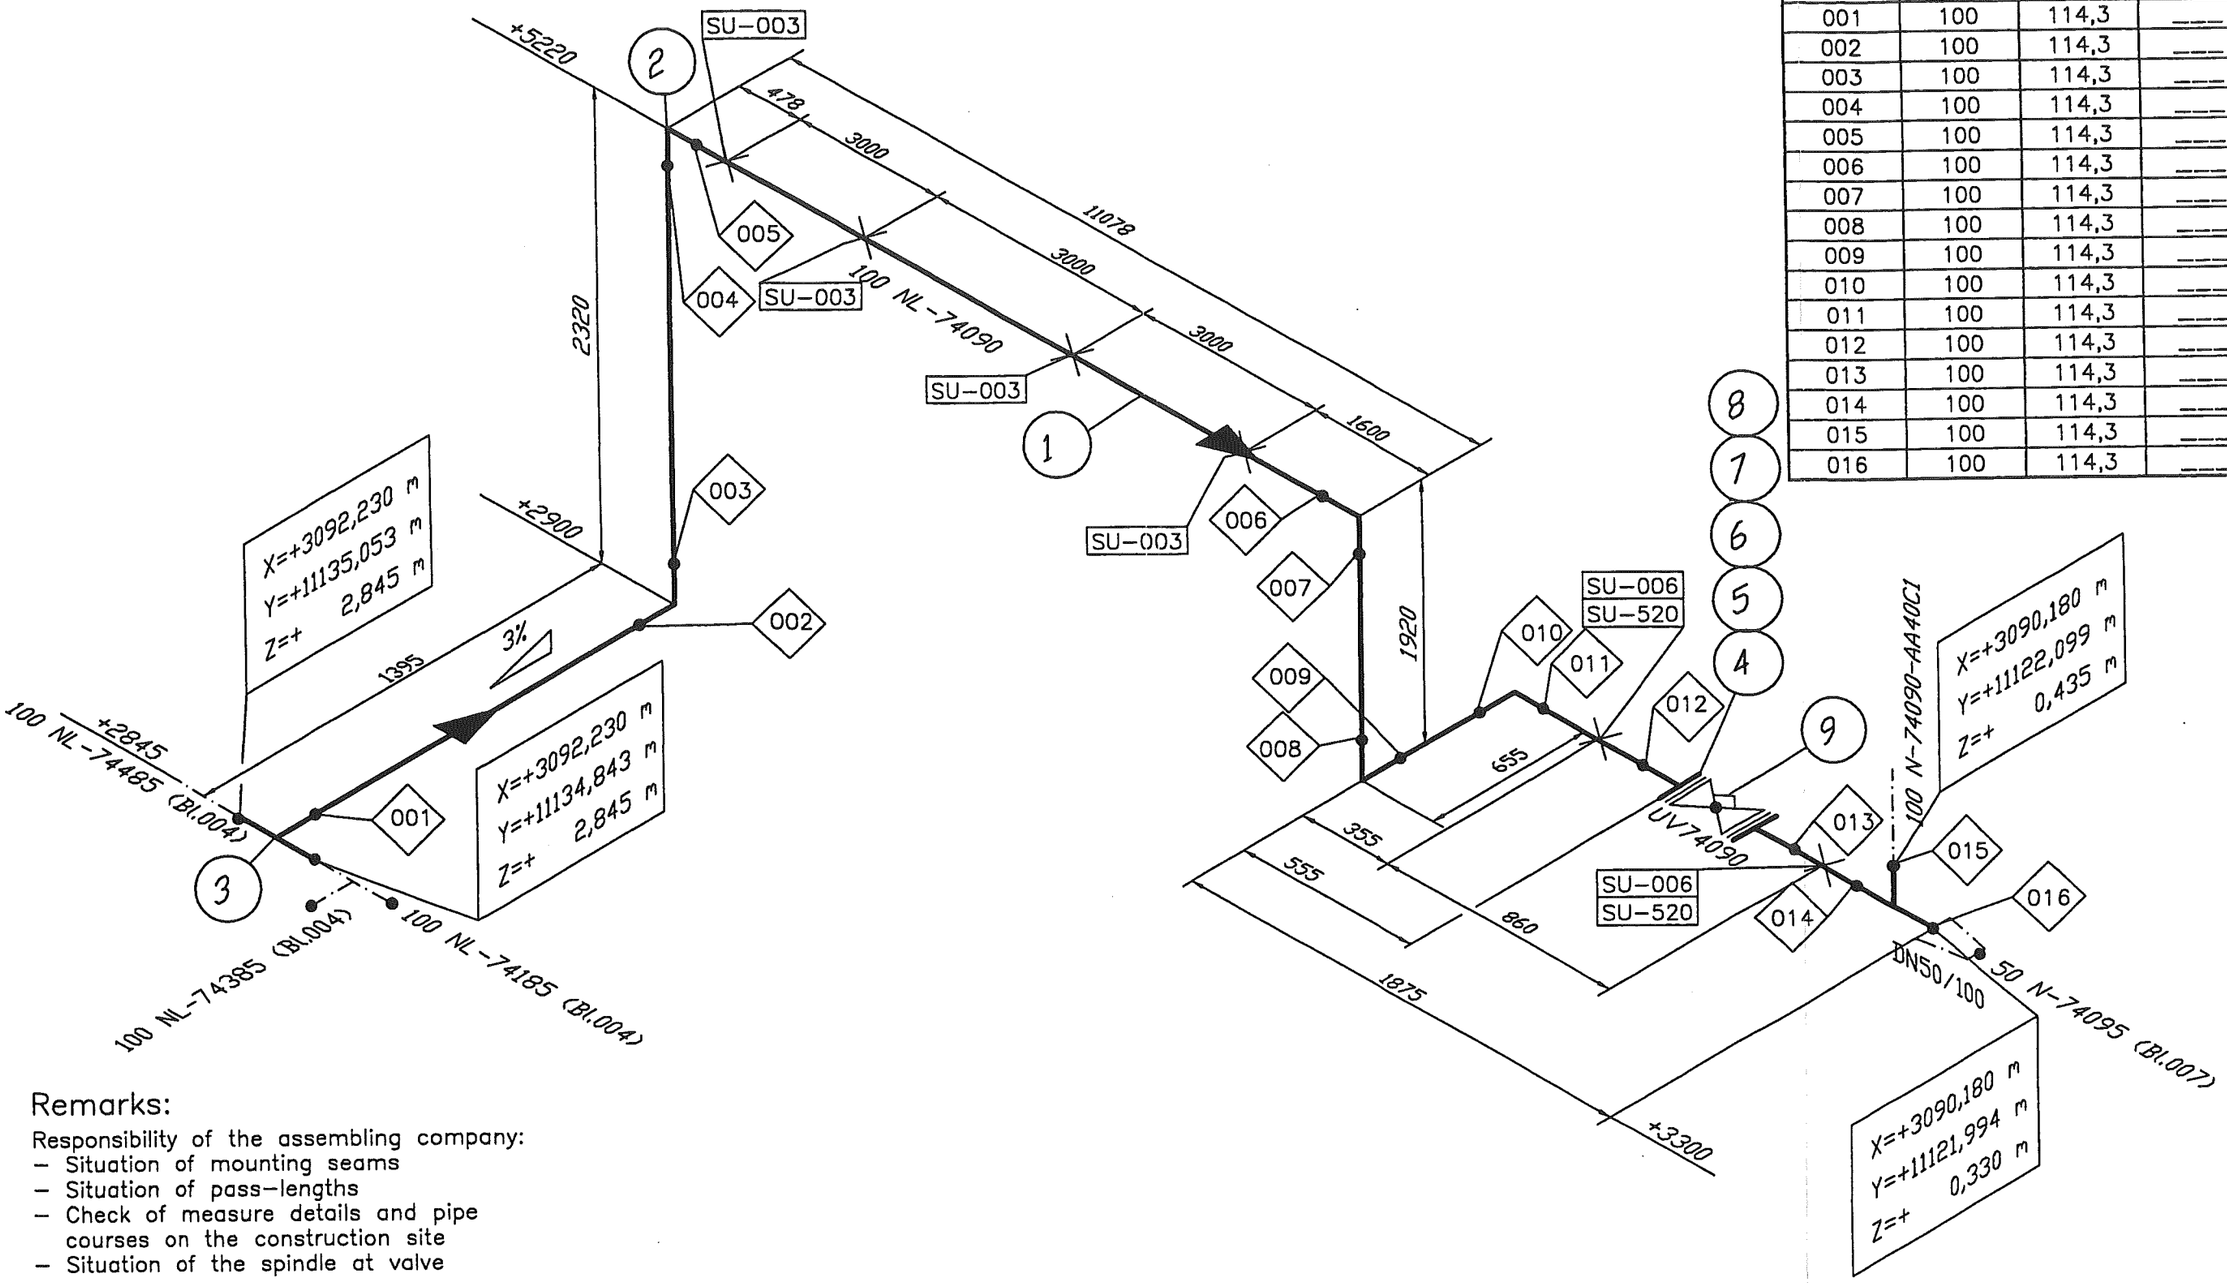

Remarks:

Responsibility of the assembling company:
- Situation of mounting seams
- Situation of pass-lengths
- Check of measure details and pipe courses on the construction site
- Situation of the spindle at valve

Accompanying drawings:

- 100 NL-74185
- 100 NL-74385
- 100 NL-74485
- 100 NL-74095

Accompanying lists:

- Parts list:
  100 NL 74090

Pipe Standard:

- AL Standard No.:
  50006 / ZB40C1

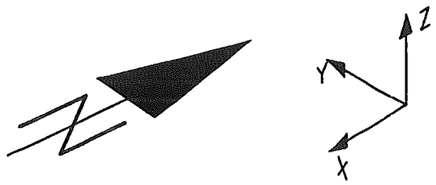

AIR LIQUIDE	Date : 22.10.2004	Name : WIP/Rad.	Checked: –
Air Liquide AGS GmbH	Job code: K70101	Reference: ASU Kosice	
Replaces: 79_.____ Replaced by: 79_.-----	Title: 100 NL 74090		

History file: 79287106.doc	Scale --:--	Original format DIN A3
	Sheet: 006	of – Sheets
Drawing No.: 792.87106		Rev. A

This drawing is protected by copyright.
It may not be copied or used without our written authorization and it is strictly prohibited to disclose it to any third parties.

Welding No.	DN	ø	Welder No.	Protoc No.
001	50	60,3	___	___
002	50	60,3	___	___
003	50	60,3	___	___
004	50	60,3	___	___
005	50	60,3	___	___
006	50	60,3	___	___
007	50	60,3	___	___
008	50	60,3	___	___
009	50	60,3	___	___
010	50	60,3	___	___

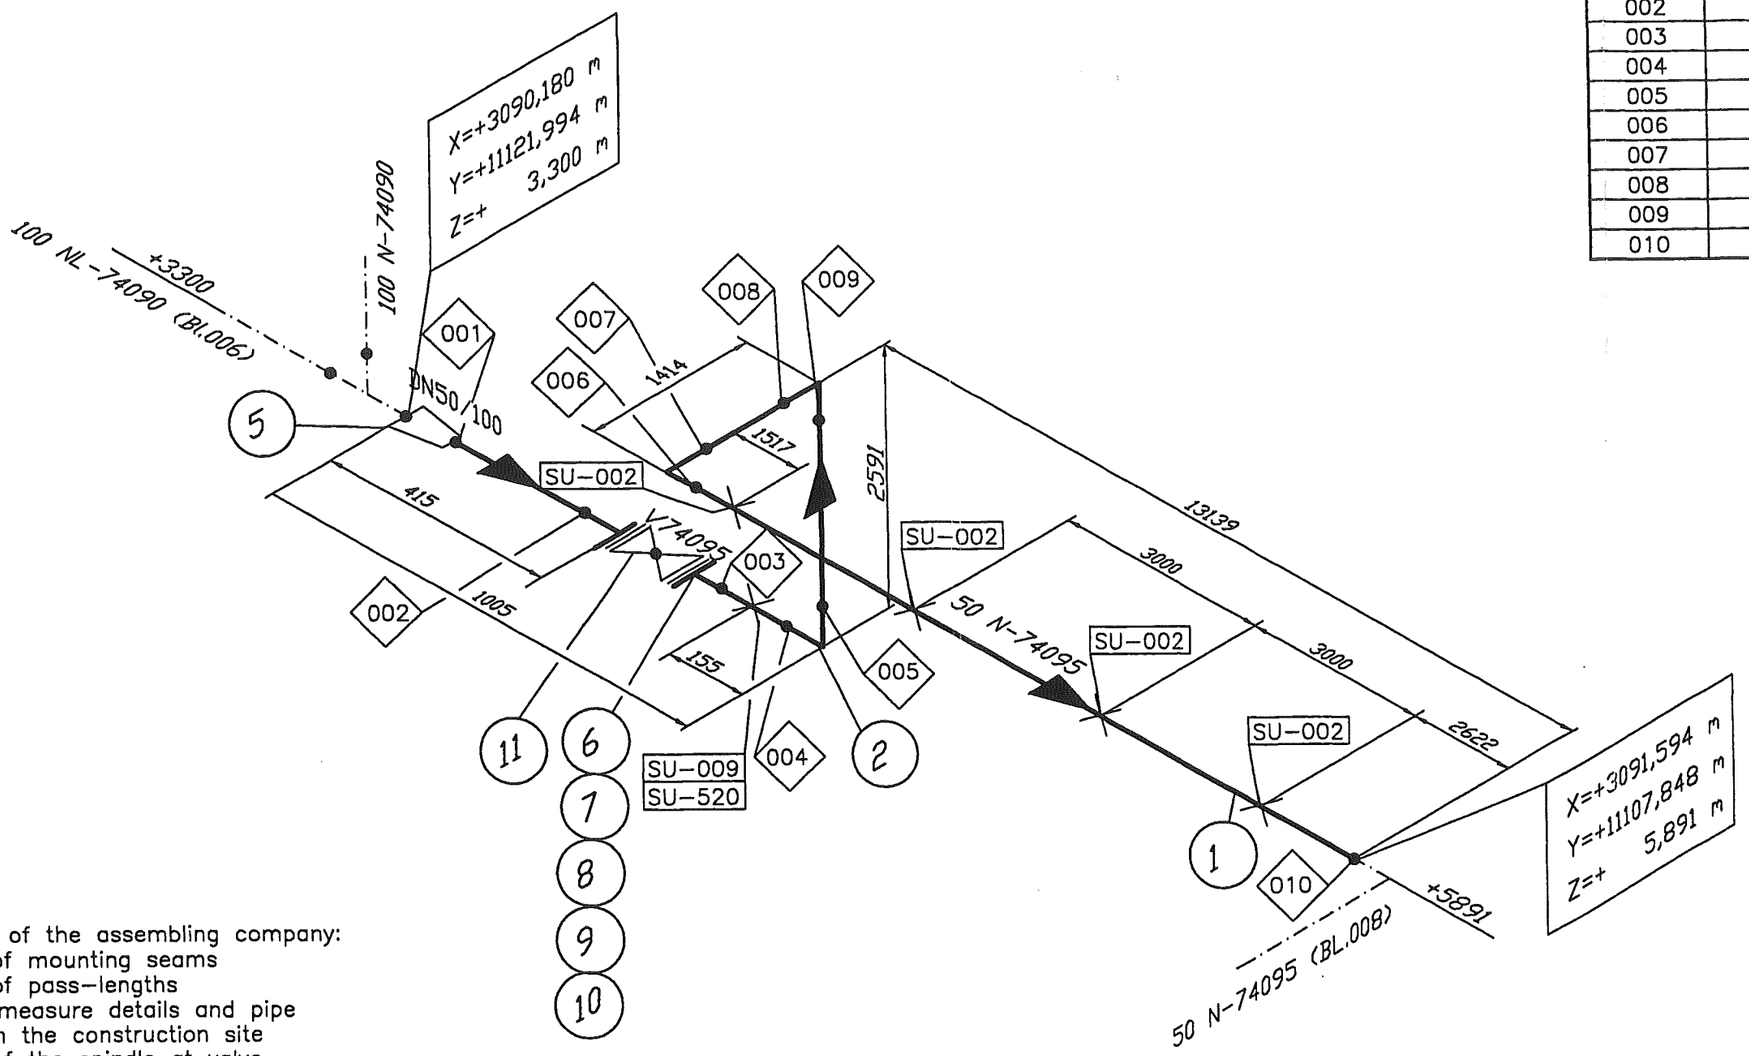

Remarks:

Responsibility of the assembling company:
- Situation of mounting seams
- Situation of pass-lengths
- Check of measure details and pipe courses on the construction site
- Situation of the spindle at valve

Accompanying drawings:

- 100 NL-74090
- 100 N-74095

Accompanying lists:

- Parts list:
  50 N 74095

Pipe Standard:

- AL Standard No.:
  50013 / AA40C1

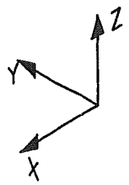

AIR LIQUIDE	Date : 22.10.2004	Name : WIP/Rad.	Checked: –
Air Liquide AGS GmbH	Job code: K70101	Reference: ASU Kosice	
Replaces: 79_._____ Replaced by: 79_.-----	Title: 50 N 74095		

History file:	Scale	Original format
79287106.doc	--:--	DIN A3
	Sheet: 007	of – Sheets
Drawing No.: 792.87106		Rev. A

This drawing is protected by copyright.
It may not be copied or used without our written authorization and it is strictly prohibited to disclose it to any third parties.

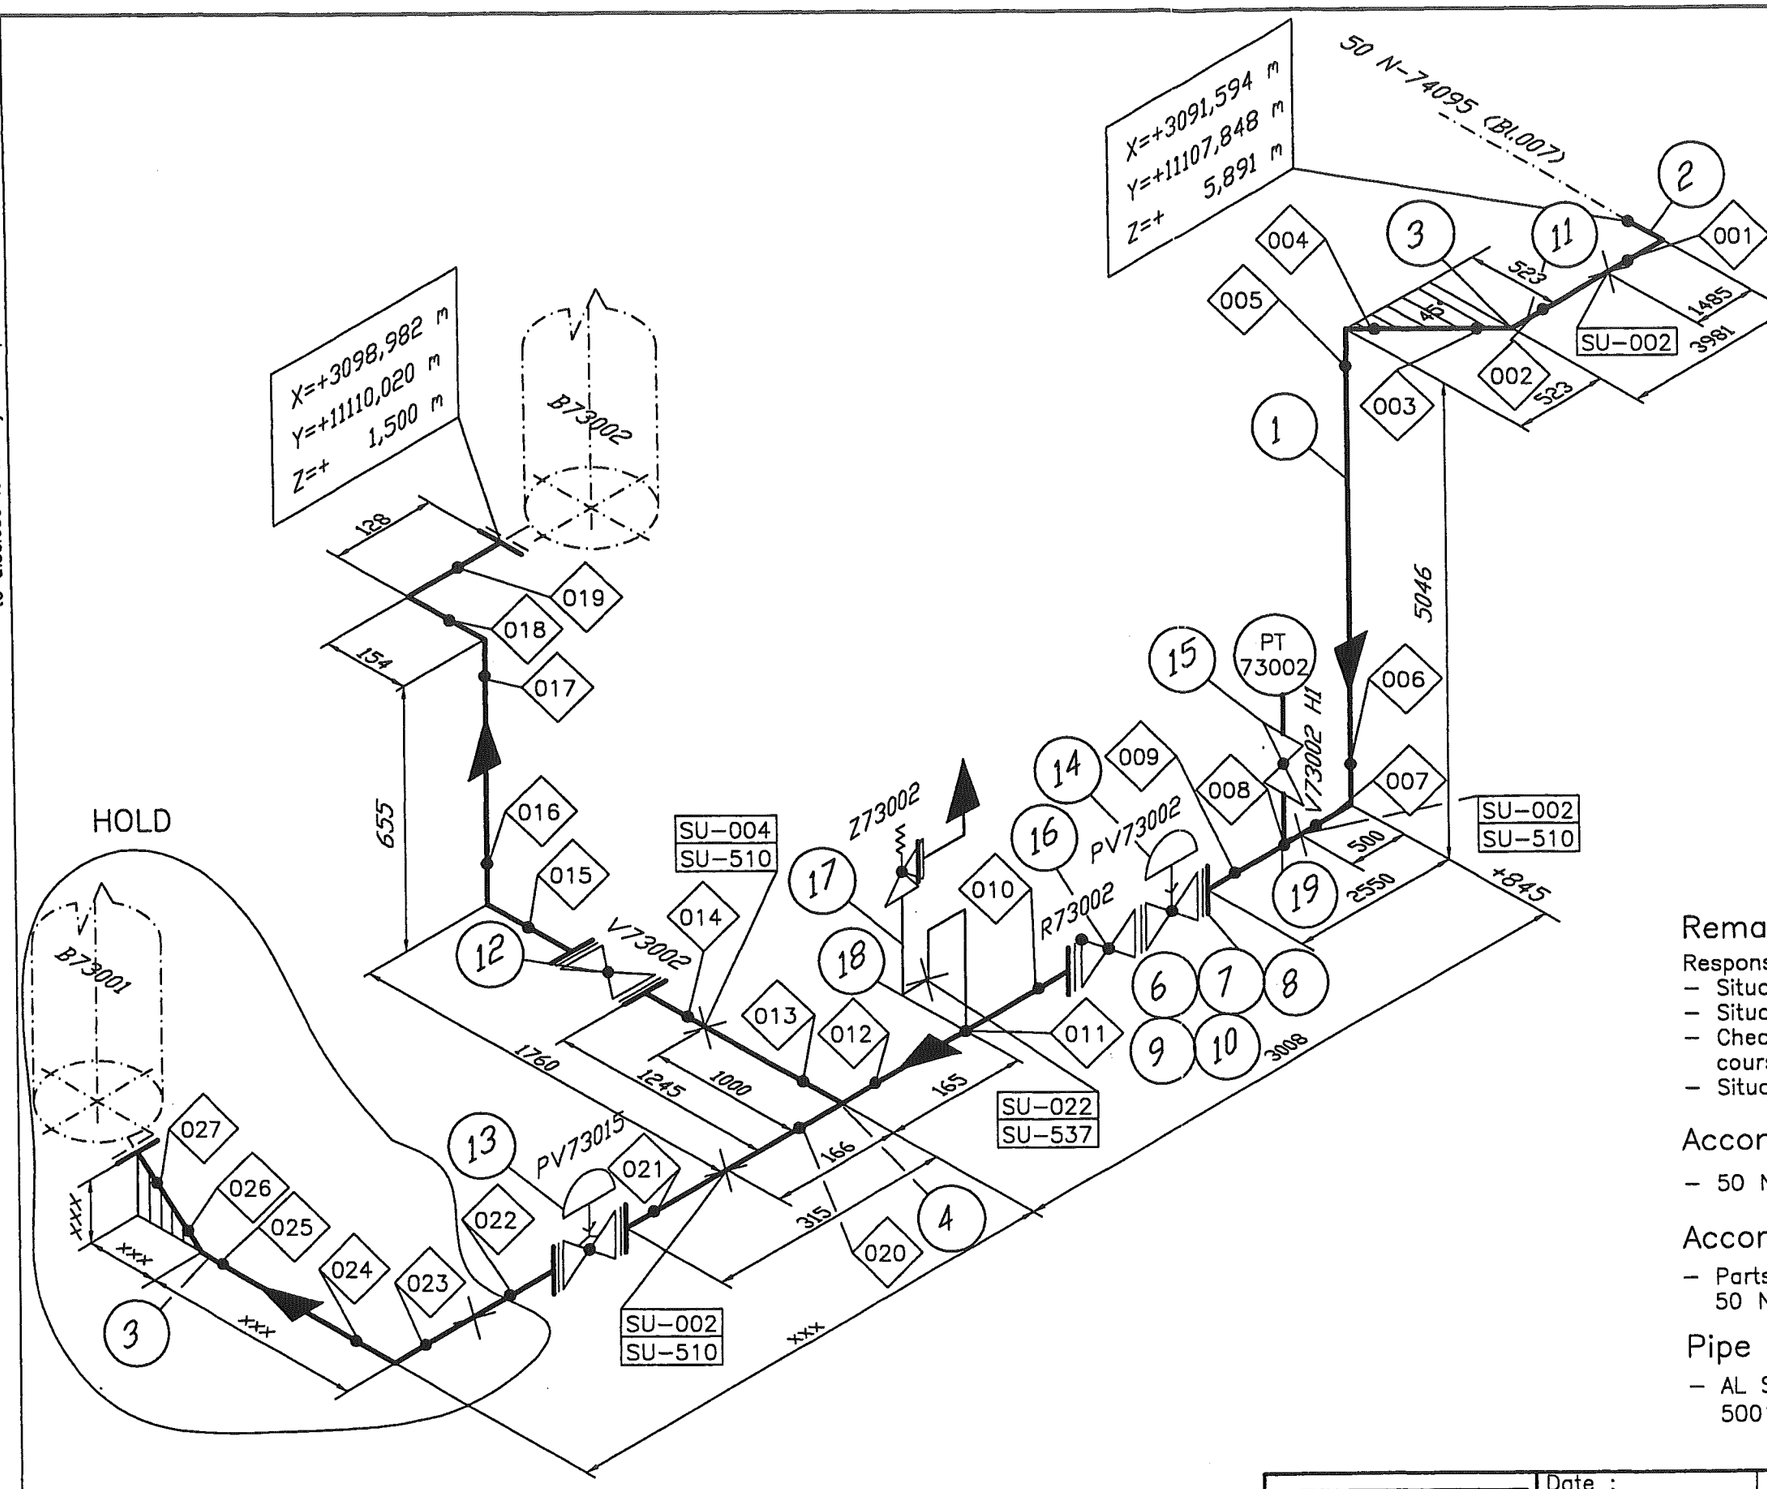

Welding No.	DN	ø	Welder No.	Protoc. No.
001	50	60,3	___	___
002	50	60,3	___	___
003	50	60,3	___	___
004	50	60,3	___	___
005	50	60,3	___	___
006	50	60,3	___	___
007	50	60,3	___	___
008		12	___	___
009	50	60,3	___	___
010		12	___	___
011	50	60,3	___	___
012	50	60,3	___	___
013	50	60,3	___	___
014	50	60,3	___	___
015	50	60,3	___	___
016	50	60,3	___	___
017	50	60,3	___	___
018	50	60,3	___	___
019	50	60,3	___	___
020	50	60,3	___	___
021	50	60,3	___	___
022	50	60,3	___	___
023	50	60,3	___	___
024	50	60,3	___	___
025	50	60,3	___	___
026	50	60,3	___	___
027	50	60,3	___	___

Remarks:

Responsibility of the assembling company:
- Situation of mounting seams
- Situation of pass-lengths
- Check of measure details and pipe courses on the construction site
- Situation of the spindle at valve

Accompanying drawings:

- 50 N-74095

Accompanying lists:

- Parts list:
  50 N 74095

Pipe Standard:

- AL Standard No.:
  50013 / AA40C1

AIR LIQUIDE	Date : 22.10.2004	Name : WIP/Rad.	Checked: –	History file: 79287106.doc
Air Liquide AGS GmbH	Job code: K70101 Reference: ASU Kosice		Scale --:--	Original format DIN A3
			Sheet: 008	of – Sheets
Replaces: 79_.----- Replaced by: 79_.-----	Title: 50 N 74095		Drawing No.: 792.87106	Rev. A

This drawing is protected by copyright.
It may not be copied or used without our written authorization and it is strictly prohibited to disclose it to any third parties.

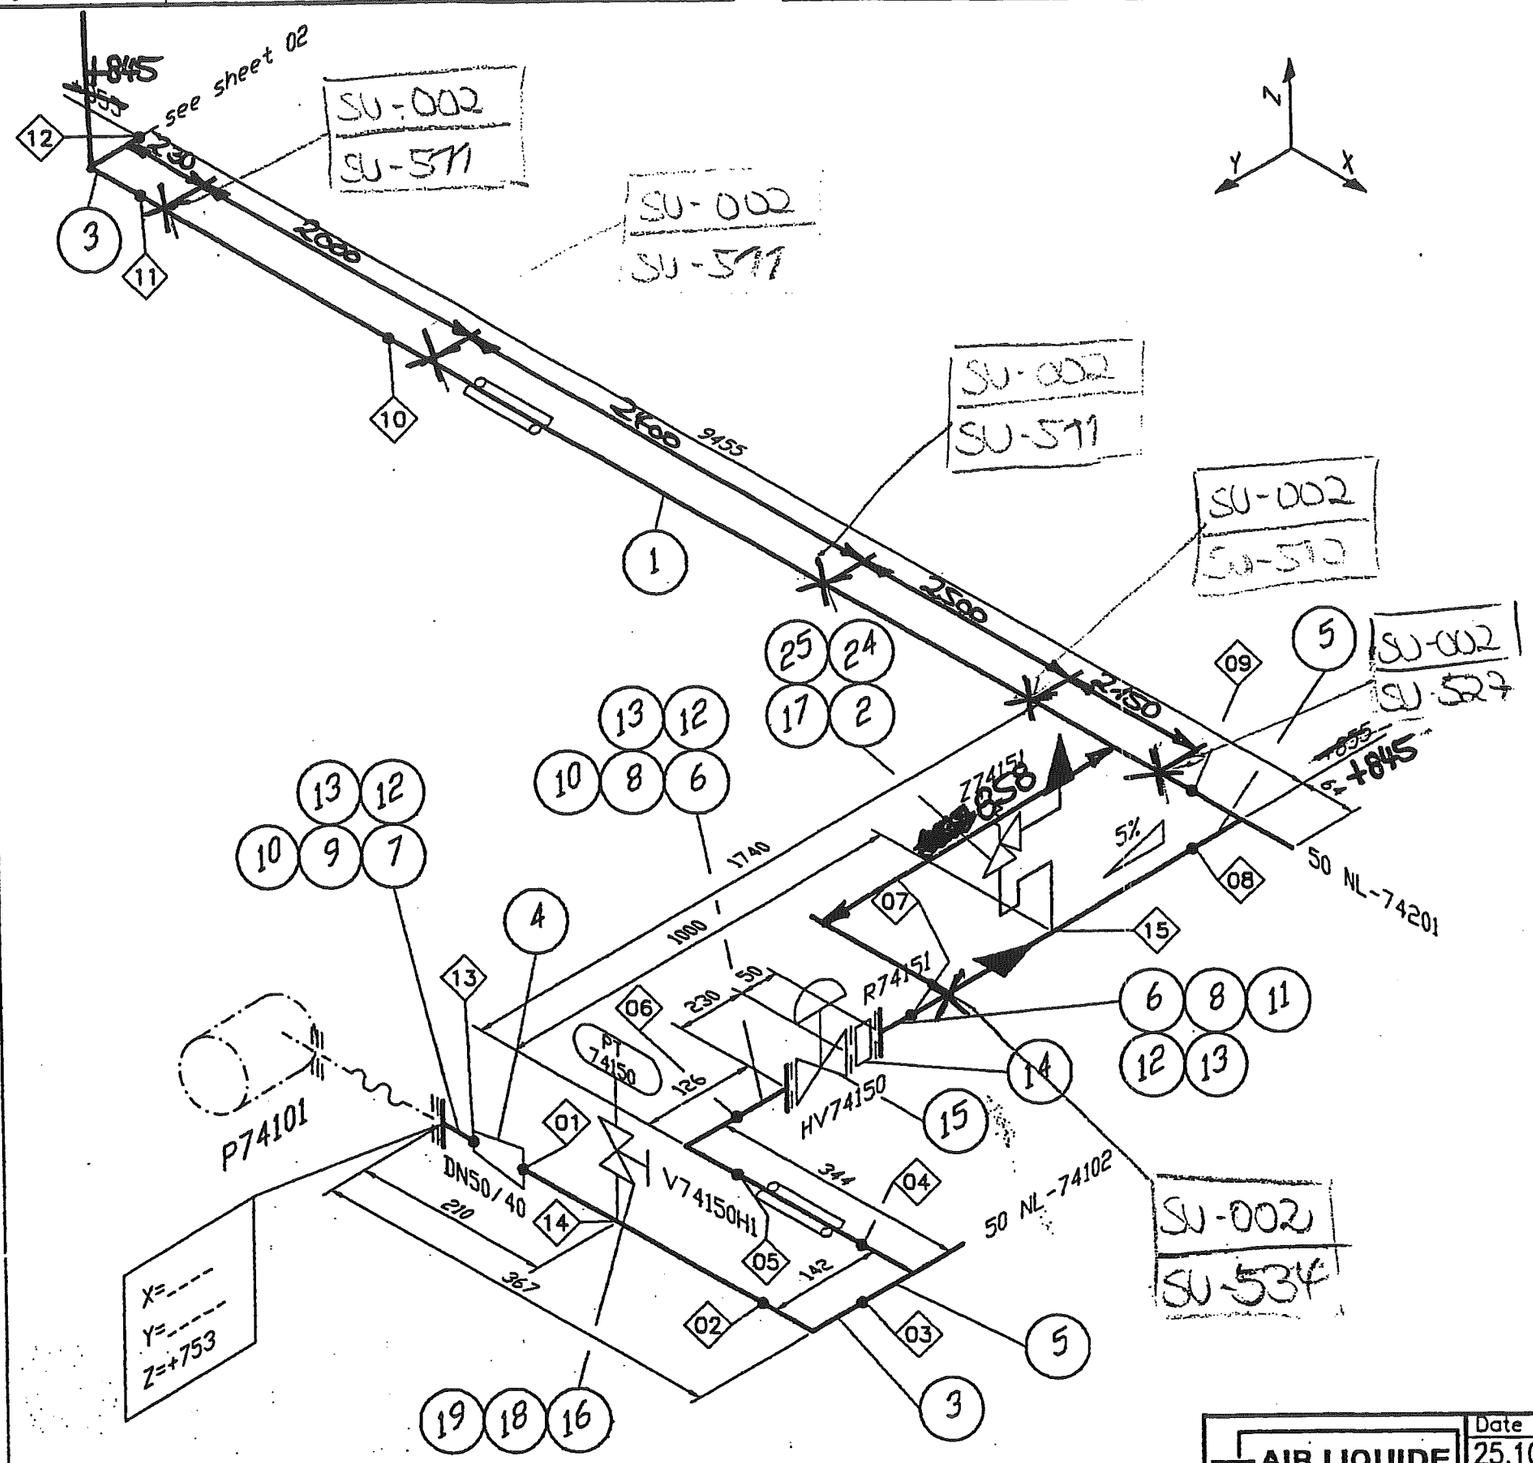

Welding No.	DN	Diameter	Welder No.	Protocoll No.
01	50	60,3	---	---
02	50	60,3	---	---
03	50	60,3	---	---
04	50	60,3	---	---
05	50	60,3	---	---
06	50	60,3	---	---
07	50	60,3	---	---
08	50	60,3	---	---
09	50	60,3	---	---
10	50	60,3	---	---
11	50	60,3	---	---
12	50	60,3	---	---
13	40	48,3	---	---
14		22	---	---
15		12	---	---

Remarks:

Responsibility of the assembling company:
- Situation of mounting seams
- Situation of pass-lengths
- Check of measure details and pipe courses on the construction site
- Situation of the spindle at valve

Accompanying drawings:

- 50 NL-74101 ZB40C1C Blatt 02
- 50 NL-74102 ZB40C1C
- 50 NL-74201 ZB40C1C

Accompanying lists:

- Parts list:
  50 NL-74101 ZB40C1C

Pipe standard:

- AL Standard No.:
  50006

AIR LIQUIDE	Date : 25.10.2004	Name : Reid./IES	Checked: Hr. Gans	History file: 79287106.doc
Air Liquide AGS GmbH	Job code: K70101	Reference: ASU Kosice	Scale --:--	Original format DIN A3
			Sheet: 001	of 003 Sheets
Replaces: 79_____	Title: 50 NL-74101		Drawing No.: 792.87106	Rev. ___
Replaced by: 79_-----				

This drawing is protected by copyright.
It may not be copied or used without our written authorization and it is strictly prohibited to disclose it to any third parties.

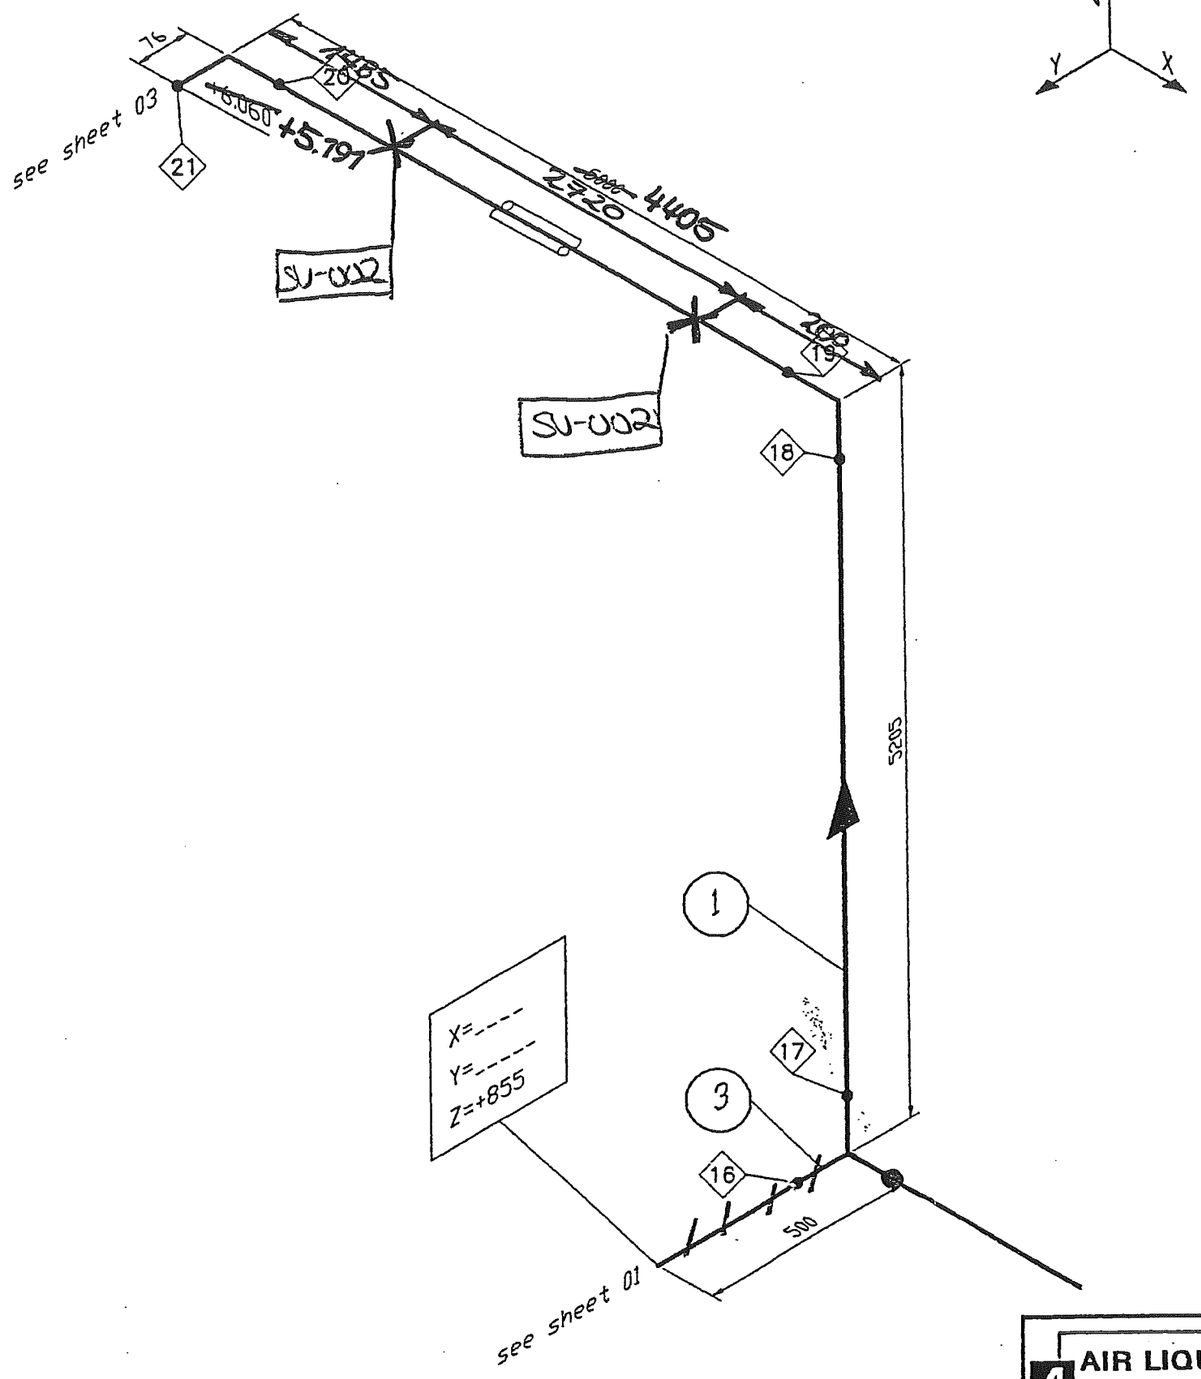

Welding No.	DN	Diameter	Welder No.	Protocoll No.
16	50	60,3	---	---
17	50	60,3	---	---
18	50	60,3	---	---
19	50	60,3	---	---
20	50	60,3	---	---
21	50	60,3	---	---

Remarks:

Responsibility of the assembling company:
- Situation of mounting seams
- Situation of pass-lengths
- Check of measure details and pipe courses on the construction site
- Situation of the spindle at valve

Accompanying drawings:

- 50 NL-74101 ZB40C1C Blatt 01
- 50 NL-74101 ZB40C1C Blatt 03

Accompanying lists:

- Parts list:
  50 NL-74101 ZB40C1C

Pipe standard:

- AL Standard No.:
  50006

AIR LIQUIDE	Date : 25.10.2004	Name : Reid./IES	Checked: Hr. Gans	History file: 79287106.doc
Air Liquide AGS GmbH	Job code: K70101 Reference: ASU Kosice		Scale --:--	Original format DIN A3
			Sheet: 002	of 003 Sheets
Replaces: 79_.----- Replaced by: 79_.-----	Title: 50 NL-74101		Drawing No.: 792.87106	Rev. ---

This drawing is protected by copyright.
It may not be copied or used without our written authorization and it is strictly prohibited to disclose it to any third parties.

Welding No.	DN	ø	Welder No.	Protoc. No.
001	50	60,3	___	___
002	50	60,3	___	___
003	50	60,3	___	___
004	50	60,3	___	___
005	50	60,3	___	___
006	50	60,3	___	___

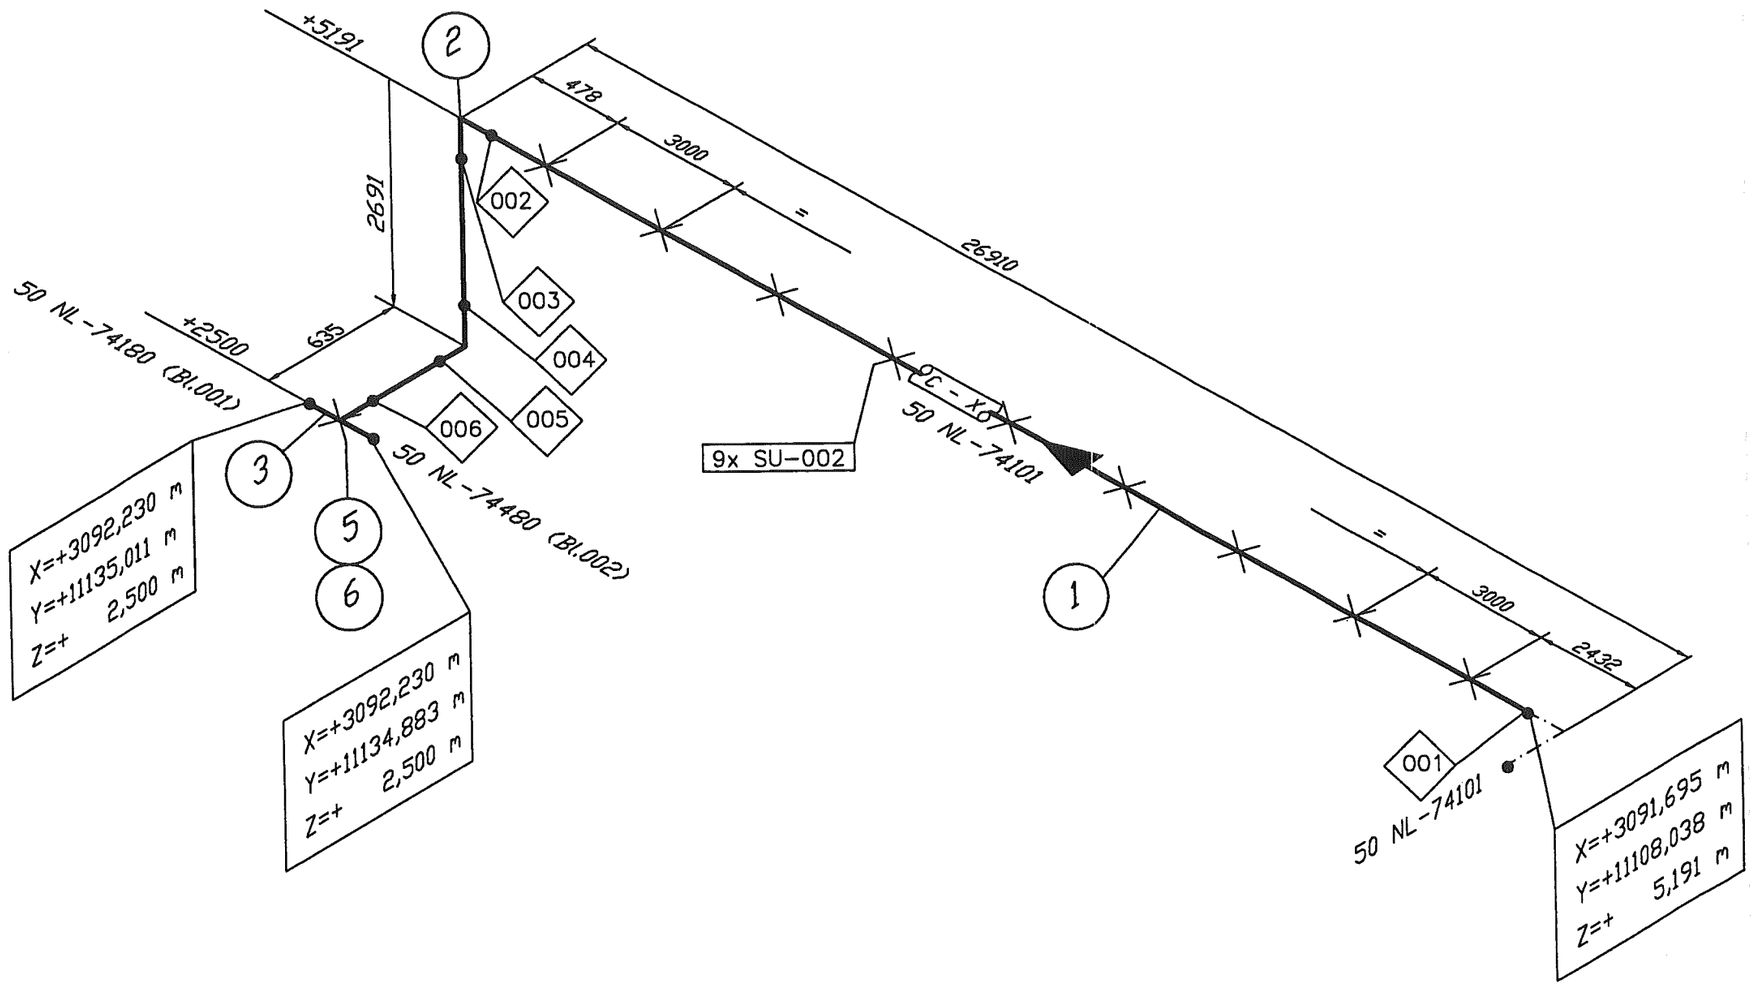

Remarks:

Responsibility of the assembling company:
- Situation of mounting seams
- Situation of pass–lengths
- Check of measure details and pipe courses on the construction site
- Situation of the spindle at valve

Accompanying drawings:

- 50 NL–74180
- 50 NL–74480
- 50 NL–74101

Accompanying lists:

- Parts list:
  50 NL 74101

Pipe Standard:

- AL Standard No.:
  50006 / ZB40C1

AIR LIQUIDE	Date : 18.10.2004	Name : WIP/Rad.	Checked: –	History file: 79287106.doc
Air Liquide AGS GmbH	Job code: K70101 Reference: ASU Kosice		Scale --:--	Original format DIN A3
			Sheet: 003	of – Sheets
Replaces: 79_.____ Replaced by: 79_.-----	Title: 50 NL 74101		Drawing No.: 792.87106	Rev. A

This drawing is protected by copyright.
It may not be copied or used without our written authorization and it is strictly prohibited to disclose it to any third parties.

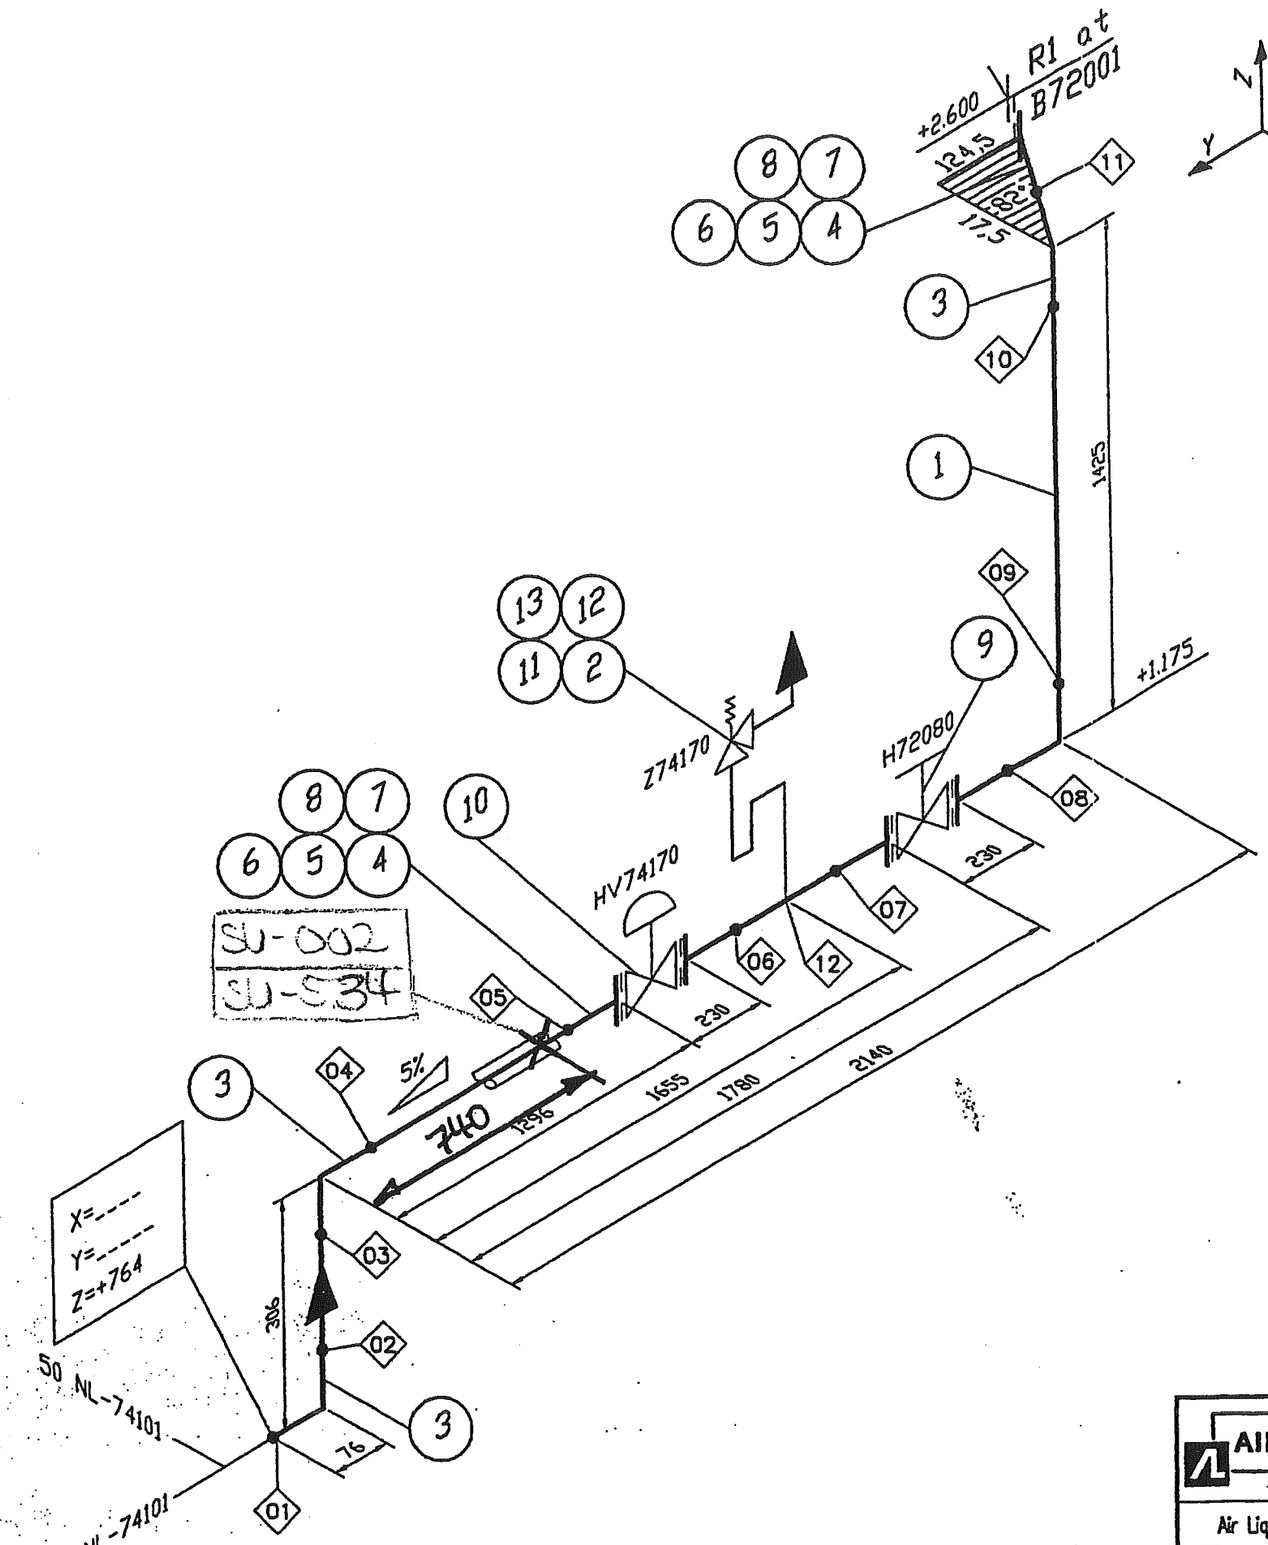

Welding No.	DN	Diameter	Welder No.	Protocoll No.
01	50	60,3	---	---
02	50	60,3	---	---
03	50	60,3	---	---
04	50	60,3	---	---
05	50	60,3	---	---
06	50	60,3	---	---
07	50	60,3	---	---
08	50	60,3	---	---
09	50	60,3	---	---
10	50	60,3	---	---
11	50	60,3	---	---
12		12	---	---

Remarks:

Responsibility of the assembling company:
- Situation of mounting seams
- Situation of pass-lengths
- Check of measure details and pipe courses on the construction site
- Situation of the spindle at valve

Accompanying drawings:

- 50 NL-74101 ZB40C1C

Accompanying lists:

- Parts list:
  50 NL-74102 ZB40C1C

Pipe standard:

- AL Standard No.:
  50006

AIR LIQUIDE

Air Liquide AGS GmbH

Replaces: 79_____
Replaced by: 79_____

Date :	Name :	Checked:	History file:
25.10.2004	Reid./IES	Hr. Gans	79287106.doc

Job code: K70101
Reference: ASU Kosice

Scale --:--
Original format DIN A3
Sheet: 001 of 001 Sheets

Title: 50 NL-74102

Drawing No.: 792.87106
Rev.: ___

This drawing is protected by copyright.
It may not be copied or used without our written authorization and it is strictly prohibited to disclose it to any third parties.

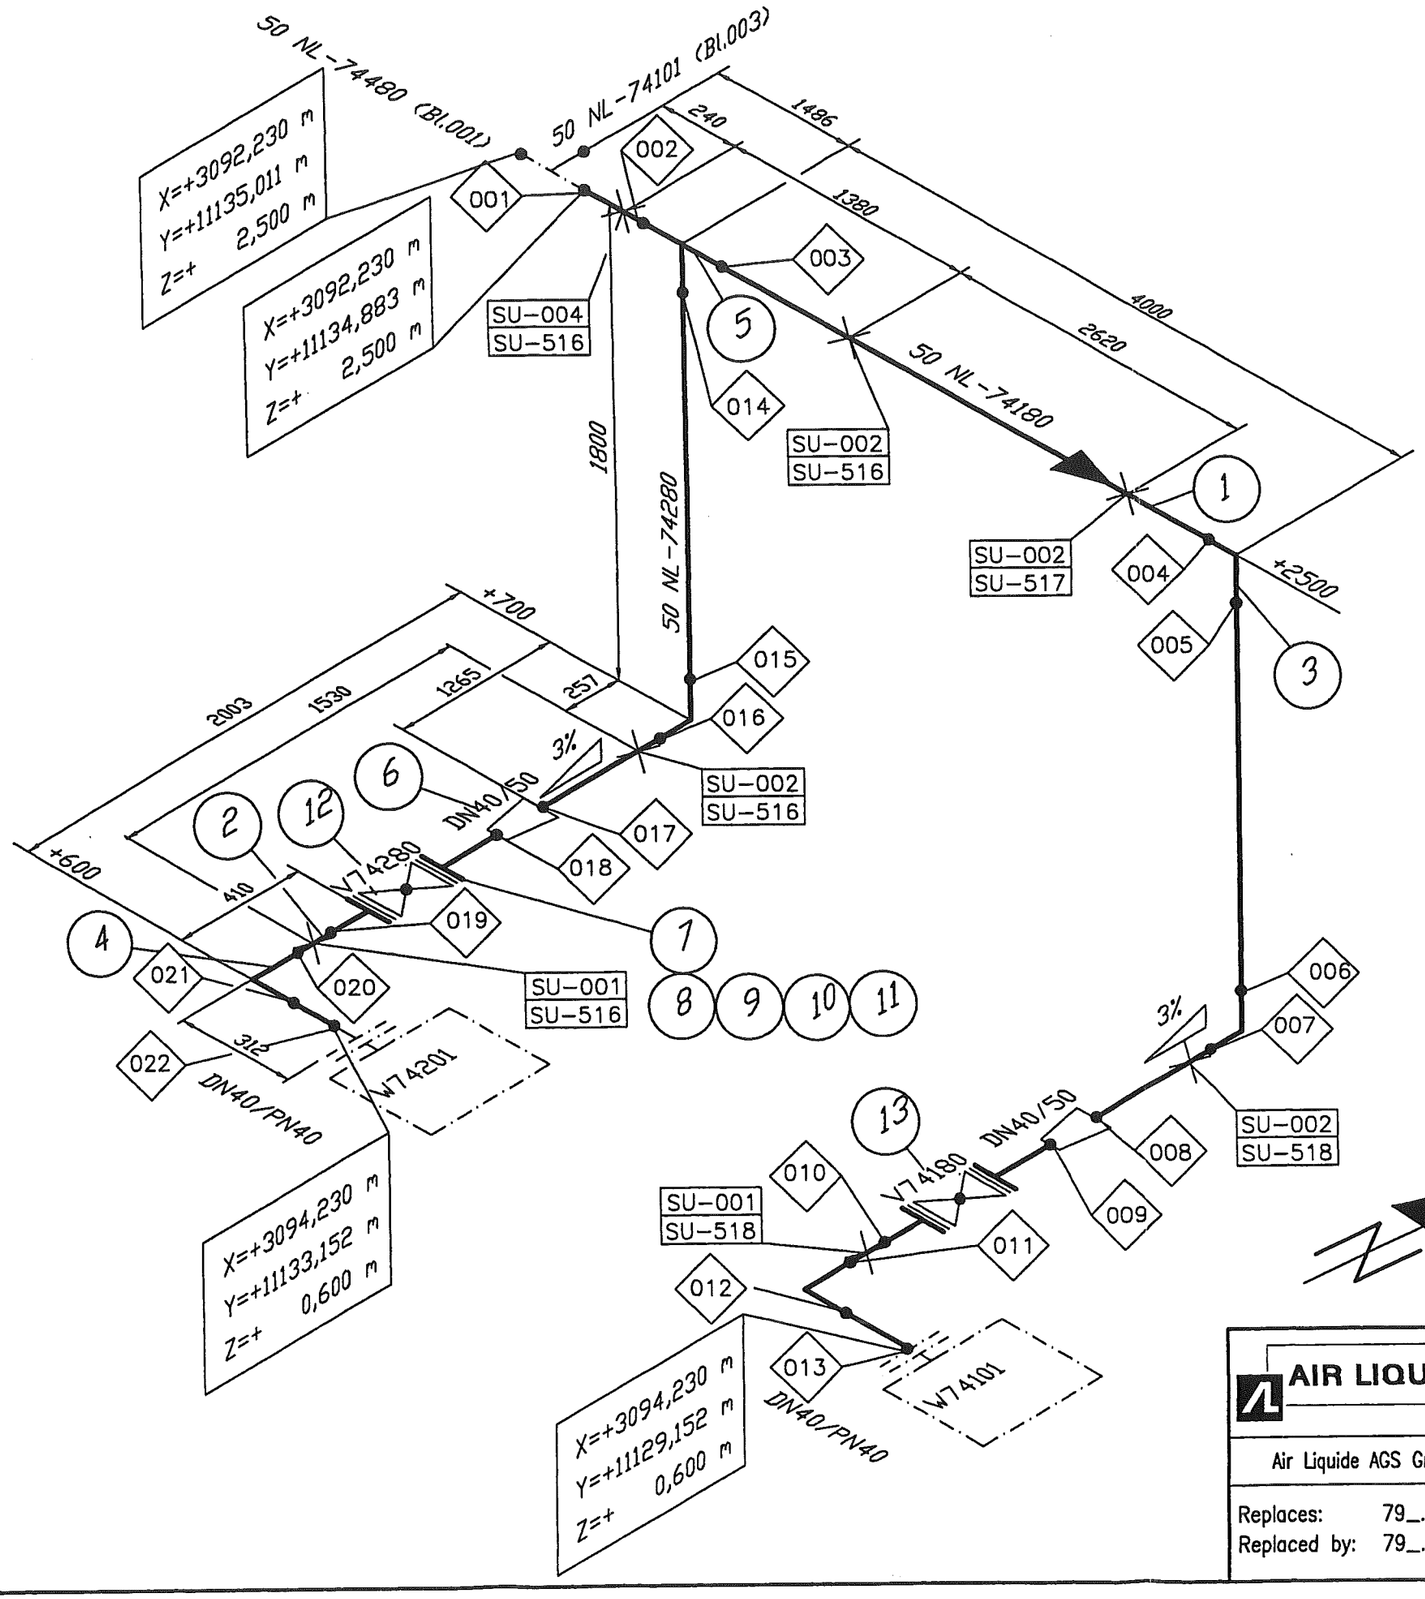

Welding No.	DN	ø	Welder No.	Protoc. No.
001	50	60,3	___	___
002	50	60,3	___	___
003	50	60,3	___	___
004	50	60,3	___	___
005	50	60,3	___	___
006	50	60,3	___	___
007	50	60,3	___	___
008	50	60,3	___	___
009	40	48,3	___	___
010	40	48,3	___	___
011	40	48,3	___	___
012	40	48,3	___	___
013	40	48,3	___	___
014	50	60,3	___	___
015	50	60,3	___	___
016	50	60,3	___	___
017	50	60,3	___	___
018	40	48,3	___	___
019	40	48,3	___	___
020	40	48,3	___	___
019	40	48,3	___	___
020	40	48,3	___	___

Remarks:

Responsibility of the assembling company:
- Situation of mounting seams
- Situation of pass-lengths
- Check of measure details and pipe courses on the construction site
- Situation of the spindle at valve

Accompanying drawings:

- 50 NL-74480
- 50 NL-74380
- 50 NL-74101

Accompanying lists:

- Parts list:
  50 NL 74180
  50 NL 74280

Pipe Standard:

- AL Standard No.:
  50006 / ZB40C1

AIR LIQUIDE	Date : 18.10.2004	Name : WIP/Rad.	Checked: –
Air Liquide AGS GmbH	Job code: K70101	Reference: ASU Kosice	
Replaces: 79_.____	Title: 50 NL 74180 50 NL 74280		
Replaced by: 79_.-----			

History file:	
79287106.doc	
Scale --:--	Original format DIN A3
Sheet: 002	of – Sheets
Drawing No.: 792.87106	Rev. A

This drawing is protected by copyright.
It may not be copied or used without our written authorization and it is strictly prohibited to disclose it to any third parties.

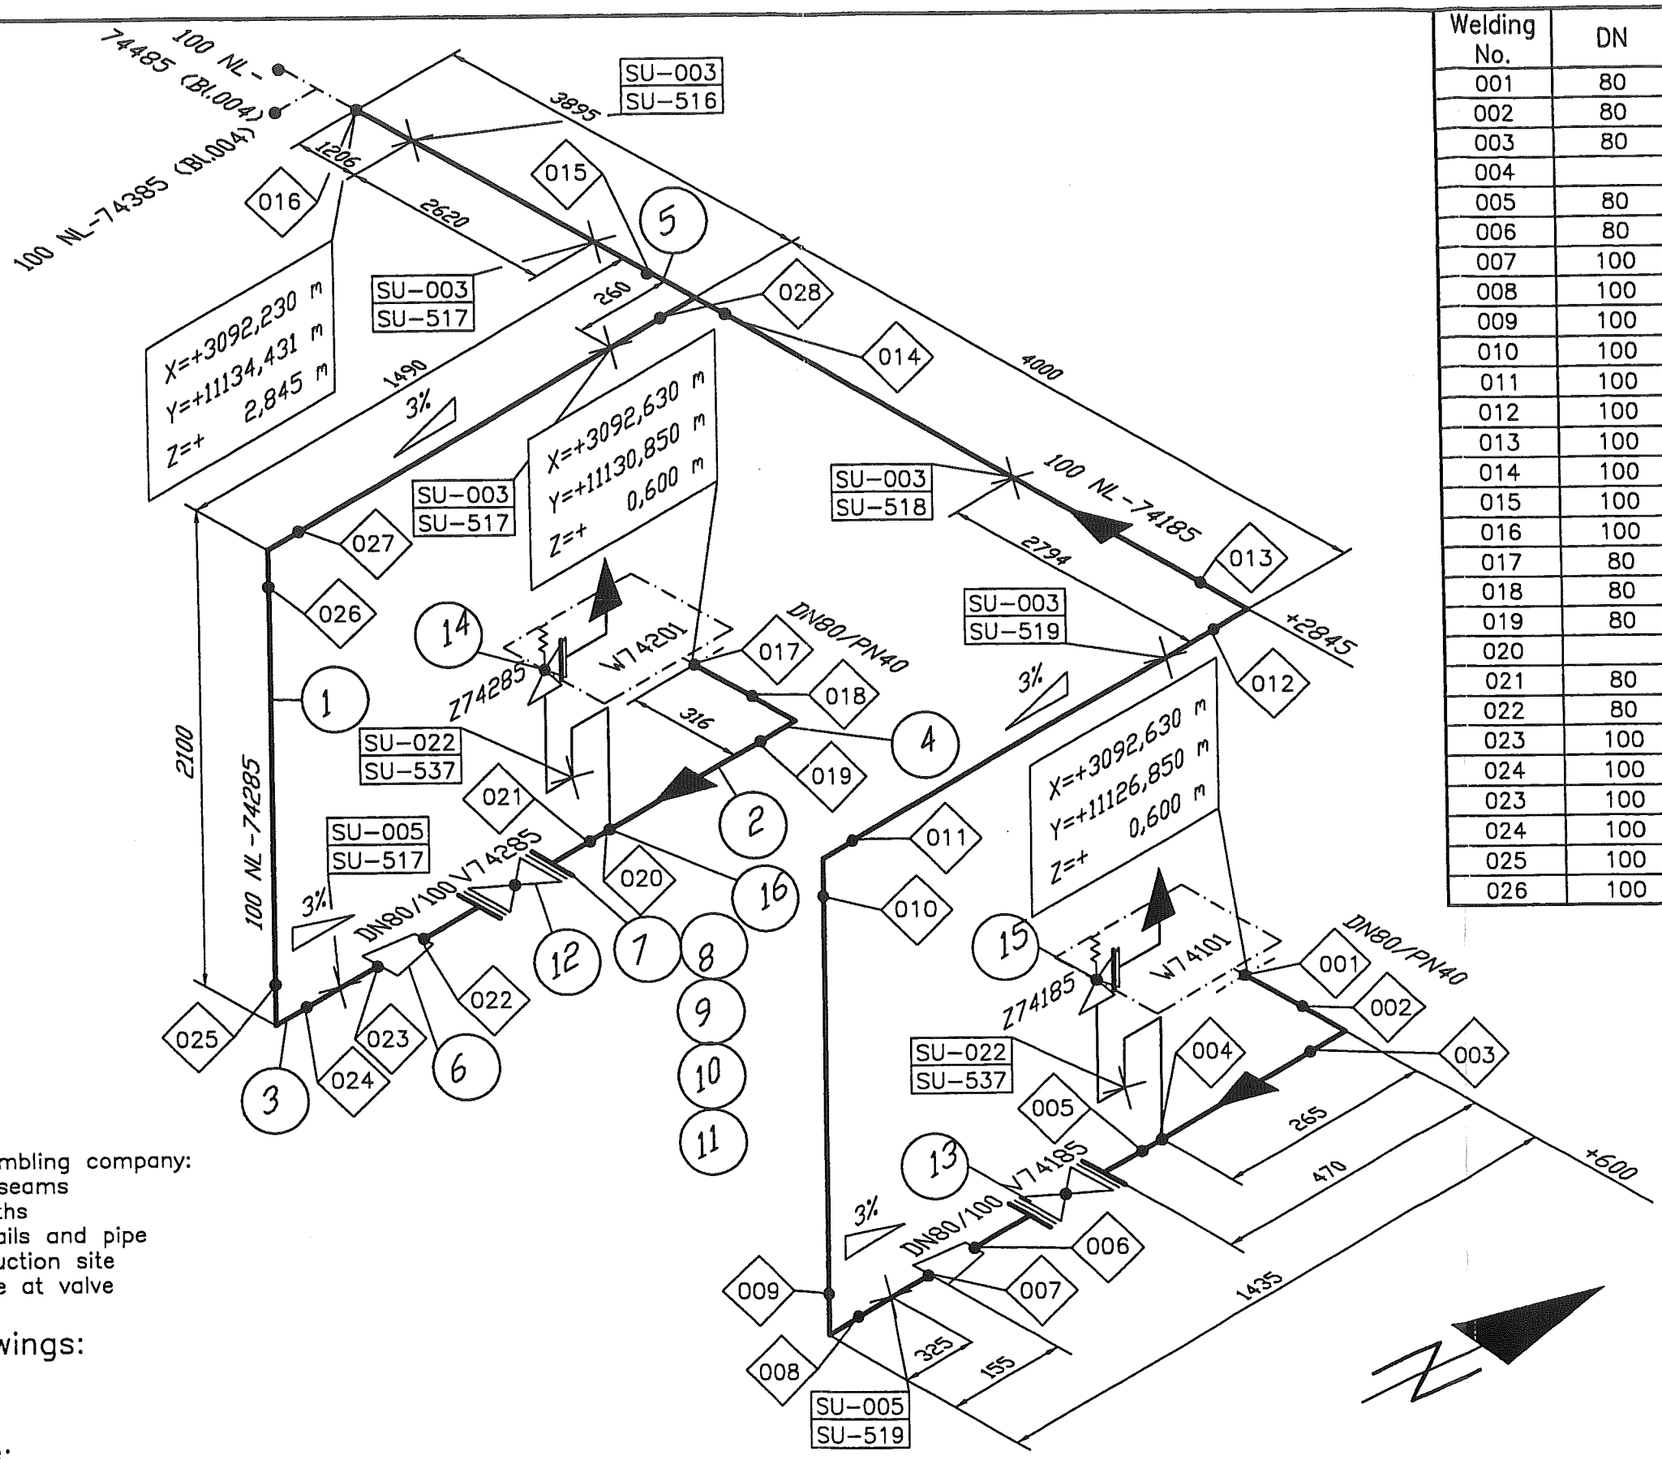

Welding No.	DN	ø	Welder No.	Protoc. No.
001	80	88,9	___	___
002	80	88,9	___	___
003	80	88,9	___	___
004		12	___	___
005	80	88,9	___	___
006	80	88,9	___	___
007	100	114,3	___	___
008	100	114,3	___	___
009	100	114,3	___	___
010	100	114,3	___	___
011	100	114,3	___	___
012	100	114,3	___	___
013	100	114,3	___	___
014	100	114,3	___	___
015	100	114,3	___	___
016	100	114,3	___	___
017	80	88,9	___	___
018	80	88,9	___	___
019	80	88,9	___	___
020		12	___	___
021	80	88,9	___	___
022	80	88,9	___	___
023	100	114,3	___	___
024	100	114,3	___	___
023	100	114,3	___	___
024	100	114,3	___	___
025	100	114,3	___	___
026	100	114,3	___	___

Remarks:

Responsibility of the assembling company:
- Situation of mounting seams
- Situation of pass-lengths
- Check of measure details and pipe courses on the construction site
- Situation of the spindle at valve

Accompanying drawings:

- 100 NL-74385
- 100 NL-74485

Accompanying lists:

- Parts list:
  100 NL 74185
  100 NL 74285

Pipe Standard:

- AL Standard No.:
  50006 / ZB40C1

AIR LIQUIDE	Date : 21.10.2004	Name : WIP/Rad.	Checked: –
Air Liquide AGS GmbH	Job code: K70101	Reference: ASU Kosice	
Replaces: 79_._____ Replaced by: 79_._-----	Title: 100 NL 74185 100 NL 74285		

History file:	Scale	Original format
79287106.doc	--:--	DIN A3
	Sheet: 005	of – Sheets
Drawing No.: 792.87106		Rev. A

This drawing is protected by copyright.
It may not be copied or used without our written authorization and it is strictly prohibited to disclose it to any third parties.

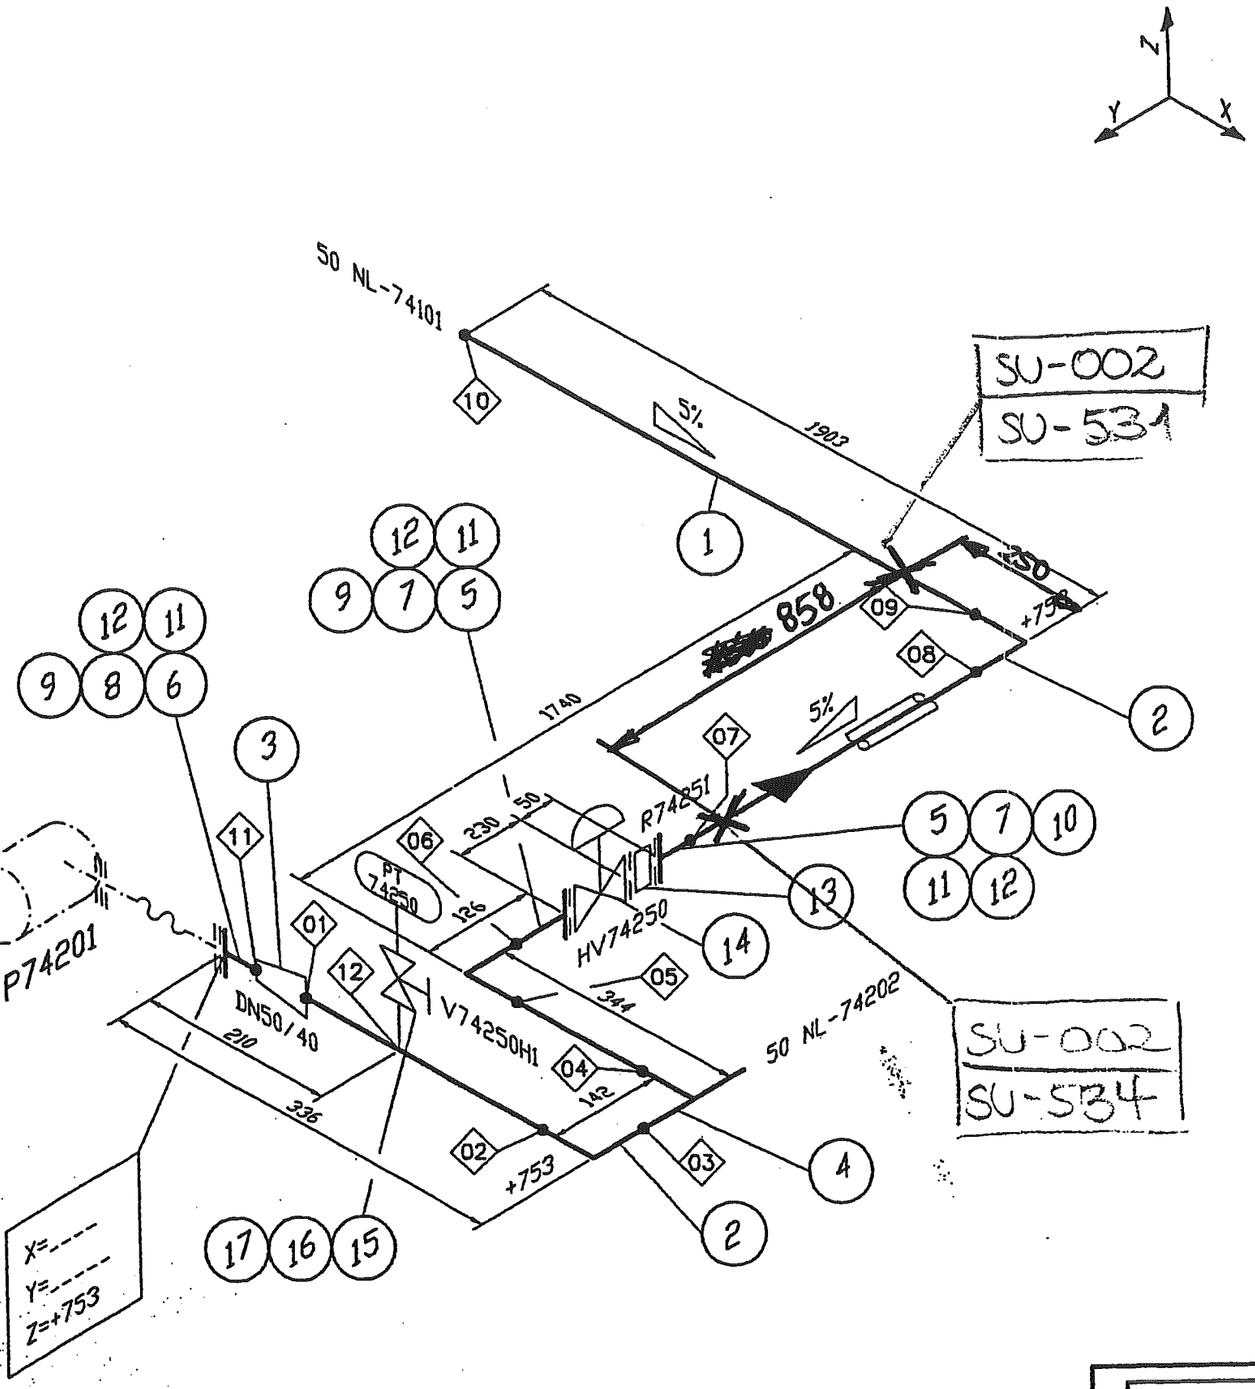

Welding No.	DN	Diameter	Welder No.	Protocoll No.
01	50	60,3	----	----
02	50	60,3	----	----
03	50	60,3	----	----
04	50	60,3	----	----
05	50	60,3	----	----
06	50	60,3	----	----
07	50	60,3	----	----
08	50	60,3	----	----
09	50	60,3	----	----
10	50	60,3	----	----
11	40	48,3	----	----
12		22	----	----

Remarks:

Responsibility of the assembling company:
- Situation of mounting seams
- Situation of pass-lengths
- Check of measure details and pipe courses on the construction site
- Situation of the spindle at valve

Accompanying drawings:

- 50 NL-74101 ZB40C1C
- 50 NL-74202 ZB40C1C

Accompanying lists:

- Parts list:
  50 NL-74201 ZB40C1C

Pipe standard:

- AL Standard No.:
  50006

AIR LIQUIDE	Date : 25.10.2004	Name : Reid./IES	Checked: Hr. Gans	History file: 79287106.doc
	Job code: K70101		Scale --:--	Original format DIN A3
Air Liquide AGS GmbH	Reference: ASU Kosice		Sheet: 001	of 001 Sheets
Replaces: 79_____	Title:		Drawing No.:	Rev.
Replaced by: 79_-----	50 NL-74201		792.87106	

This drawing is protected by copyright.
It may not be copied or used without our written authorization and it is strictly prohibited to disclose it to any third parties.

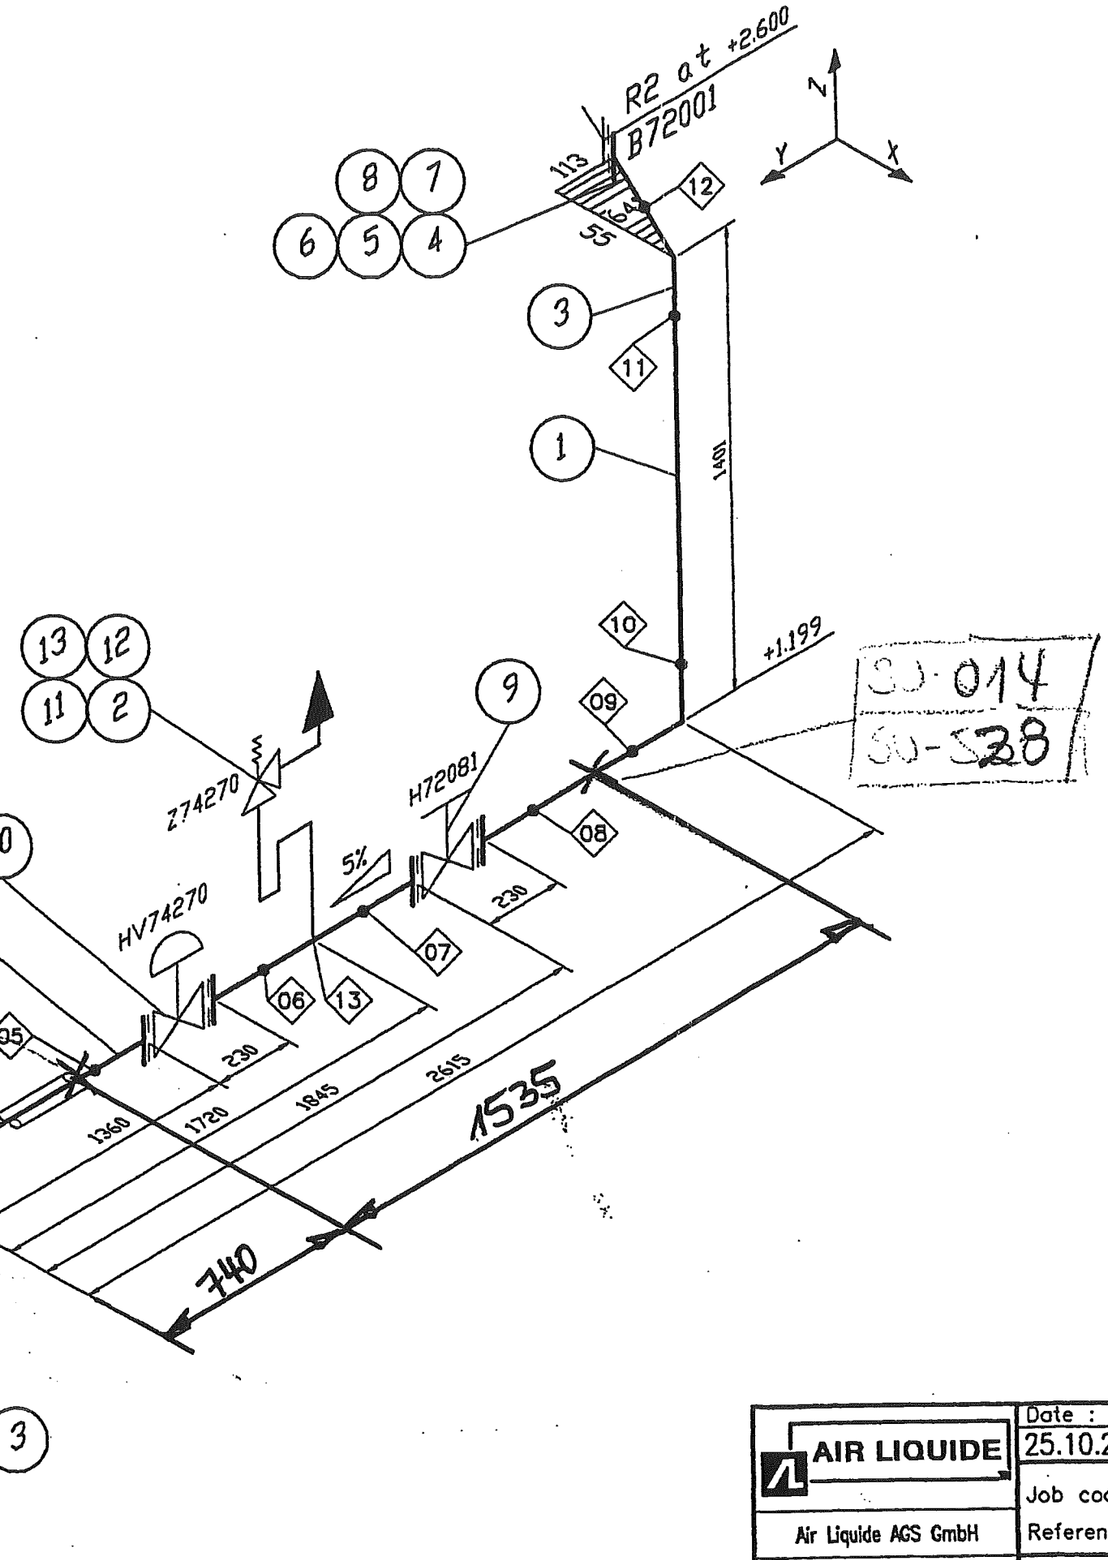

Welding No.	DN	Diameter	Welder No.	Protocall No.
01	50	60,3	___	___
02	50	60,3	___	___
03	50	60,3	___	___
04	50	60,3	___	___
05	50	60,3	___	___
06	50	60,3	___	___
07	50	60,3	___	___
08	50	60,3	___	___
09	50	60,3	___	___
10	50	60,3	___	___
11	50	60,3	___	___
12	50	60,3	___	___
13		12	___	___

Remarks:

Responsibility of the assembling company:
- Situation of mounting seams
- Situation of pass-lengths
- Check of measure details and pipe courses on the construction site
- Situation of the spindle at valve

Accompanying drawings:

- 50 NL-74201 ZB40C1C

Accompanying lists:

- Parts list:
  50 NL-74202 ZB40C1C

Pipe standard:

- AL Standard No.:
  50006

AIR LIQUIDE	Date : 25.10.2004	Name : Reid./IES	Checked: Hr. Gans	History file: 79287106.doc
Air Liquide AGS GmbH	Job code: K70101	Reference: ASU Kosice	Scale --:--	Original format DIN A3
Replaces: 79_____			Sheet: 001	of 001 Sheets
Replaced by: 79_-----	Title: 50 NL-74202X		Drawing No.: 792.87106	Rev. ___

This drawing is protected by copyright.
It may not be copied or used without our written authorization and it is strictly prohibited to disclose it to any third parties.

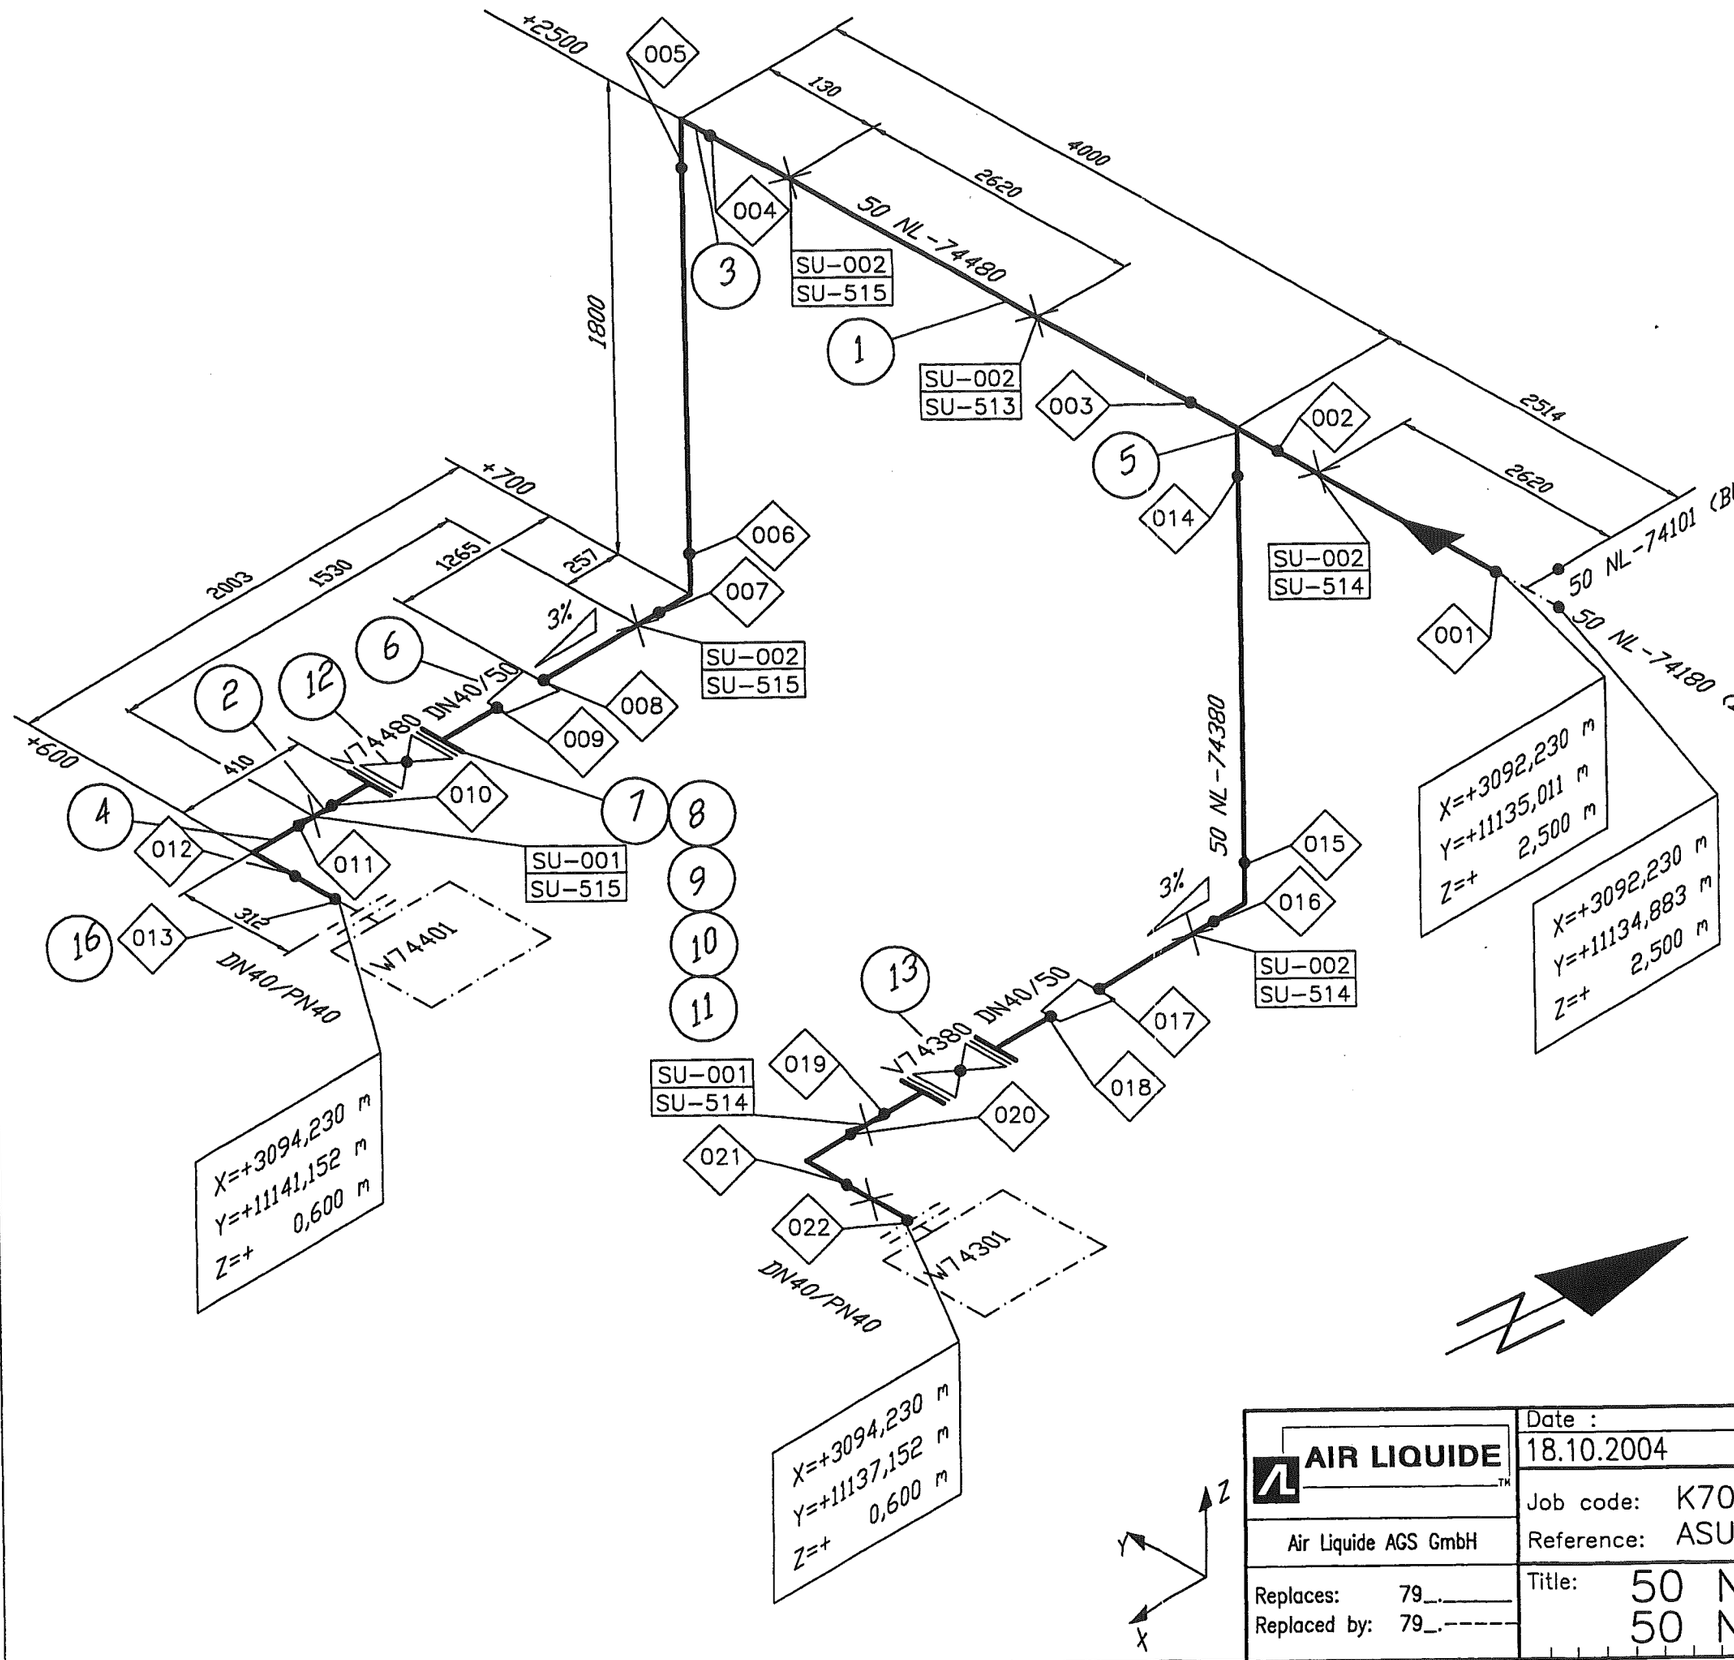

Welding No.	DN	ø	Welder No.	Protoc No.
001	50	60,3	___	___
002	50	60,3	___	___
003	50	60,3	___	___
004	50	60,3	___	___
005	50	60,3	___	___
006	50	60,3	___	___
007	50	60,3	___	___
008	50	60,3	___	___
009	40	48,3	___	___
010	40	48,3	___	___
011	40	48,3	___	___
012	40	48,3	___	___
013	40	48,3	___	___
014	50	60,3	___	___
015	50	60,3	___	___
016	50	60,3	___	___
017	50	60,3	___	___
018	40	48,3	___	___
019	40	48,3	___	___
020	40	48,3	___	___
021	40	48,3	___	___
022	40	48,3	___	___

Remarks:

Responsibility of the assembling company:
- Situation of mounting seams
- Situation of pass-lengths
- Check of measure details and pipe courses on the construction site
- Situation of the spindle at valve

Accompanying drawings:

- 50 NL-74180
- 50 NL-74280
- 50 NL-74101

Accompanying lists:

- Parts list:
  50 NL 74480
  50 NL 74380

Pipe Standard:

- AL Standard No.:
  50006 / ZB40C1

AIR LIQUIDE

Air Liquide AGS GmbH

Replaces: 79_.-----
Replaced by: 79_.-----

Date :	Name :	Checked:	History file:
18.10.2004	WIP/Rad.	-	79287106.doc

Job code: K70101
Reference: ASU Kosice

Scale --:--
Original format DIN A3
Sheet: 001
of - Sheets

Title: 50 NL 74480
50 NL 74380

Drawing No.: 792.87106
Rev. A

This drawing is protected by copyright.
It may not be copied or used without our written authorization and it is strictly prohibited to disclose it to any third parties.

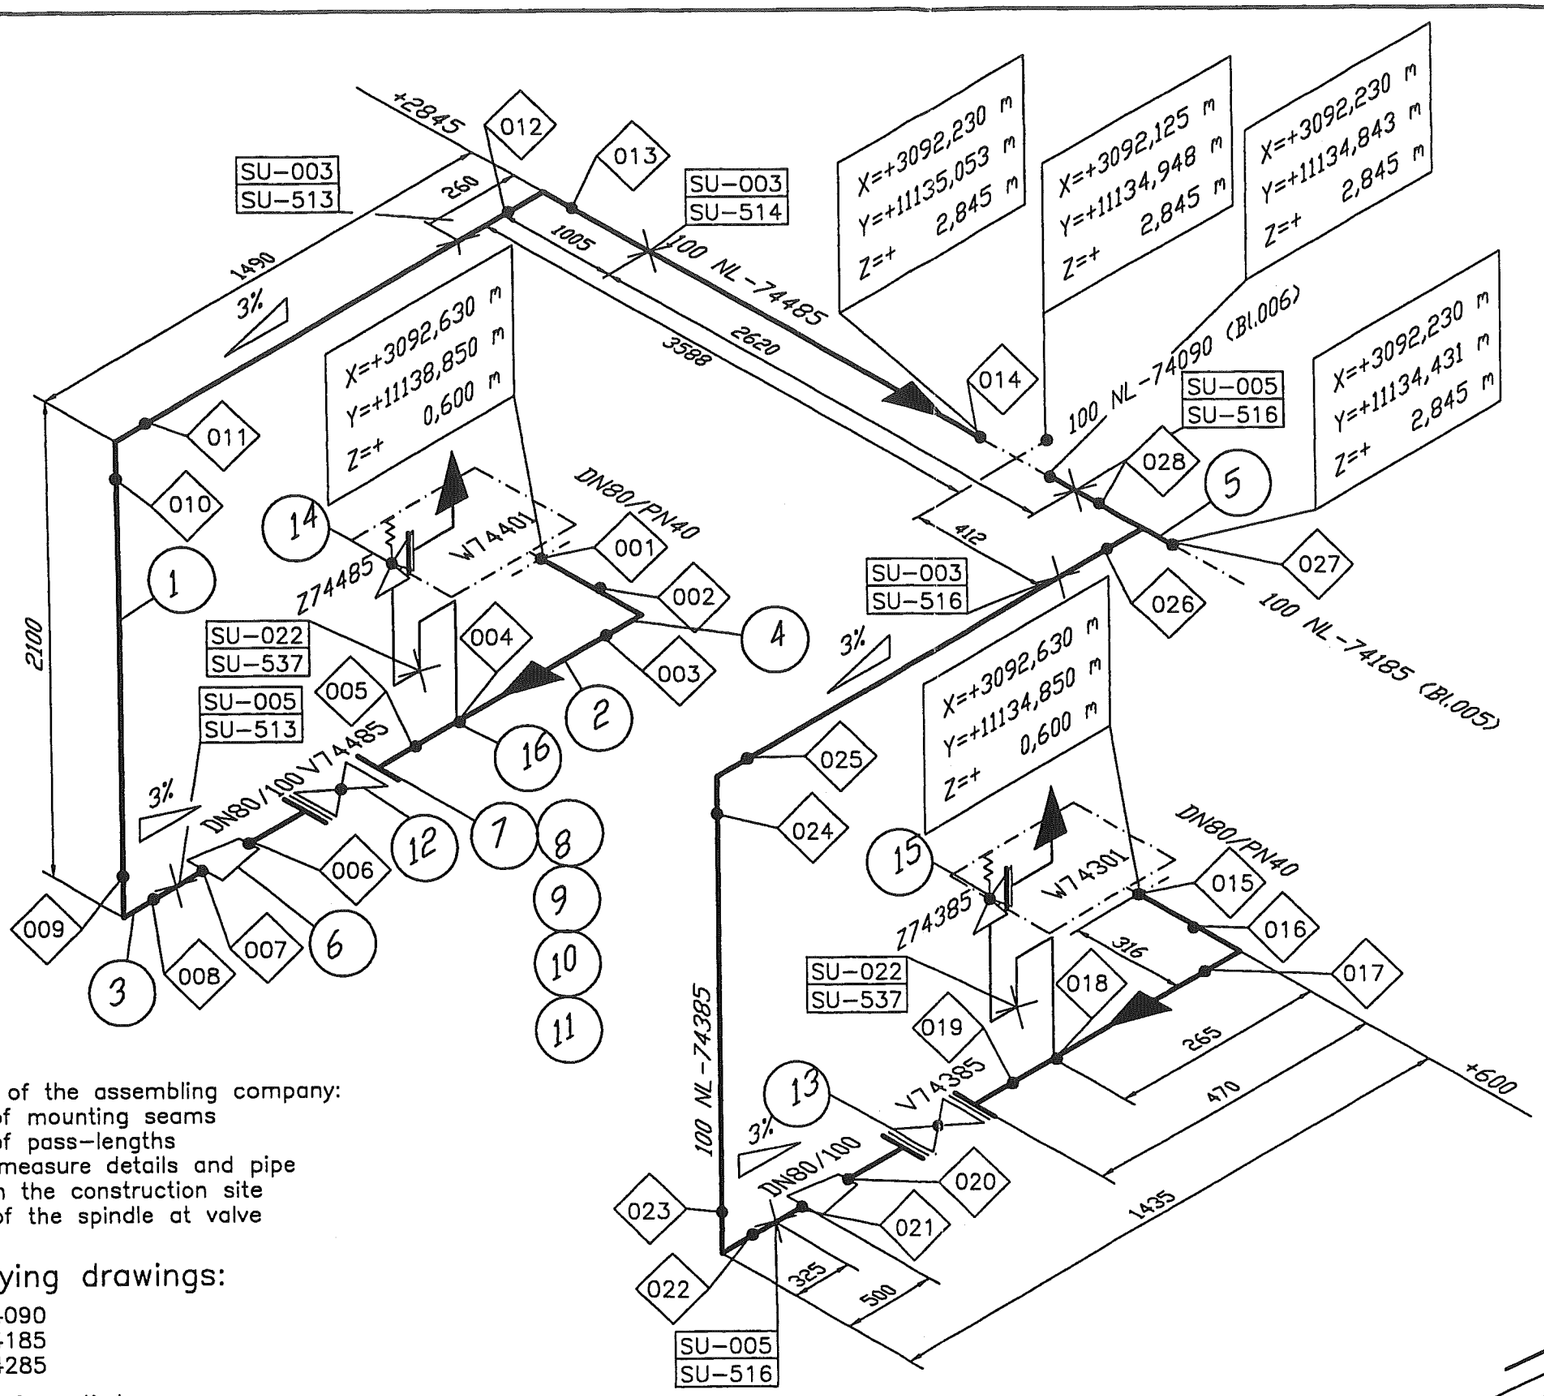

Welding No.	DN	ø	Welder No.	Protoc. No.
001	80	88,9	____	____
002	80	88,9	____	____
003	80	88,9	____	____
004		12	____	____
005	80	88,9	____	____
006	80	88,9	____	____
007	100	114,3	____	____
008	100	114,3	____	____
009	100	114,3	____	____
010	100	114,3	____	____
011	100	114,3	____	____
012	100	114,3	____	____
013	100	114,3	____	____
014	100	114,3	____	____
015	80	88,9	____	____
016	80	88,9	____	____
017	80	88,9	____	____
018		12	____	____
019	80	88,9	____	____
020	80	88,9	____	____
021	100	114,3	____	____
022	100	114,3	____	____
023	100	114,3	____	____
024	100	114,3	____	____
025	100	114,3	____	____
026	100	114,3	____	____
027	100	114,3	____	____
028	100	114,3	____	____

Remarks:

Responsibility of the assembling company:
- Situation of mounting seams
- Situation of pass-lengths
- Check of measure details and pipe courses on the construction site
- Situation of the spindle at valve

Accompanying drawings:

- 100 NL-74090
- 100 NL-74185
- 100 NL-74285

Accompanying lists:

- Parts list:
  100 NL 74485
  100 NL 74385

Pipe Standard:

- AL Standard No.:
  50006 / ZB40C1

AIR LIQUIDE	Date : 18.10.2004	Name : WIP/Rad	Checked: –	History file: 79287106.doc
Air Liquide AGS GmbH	Job code: K70101	Reference: ASU Kosice	Scale --:--	Original format DIN A3
Replaces: 79_.____	Title: 100 NL 74485		Sheet: 004	of – Sheets
Replaced by: 79_.-----	100 NL 74385		Drawing No.: 792.87106	Rev. A

This drawing is protected by copyright.
It may not be copied or used without our written authorization and it is strictly prohibited to disclose it to any third parties.

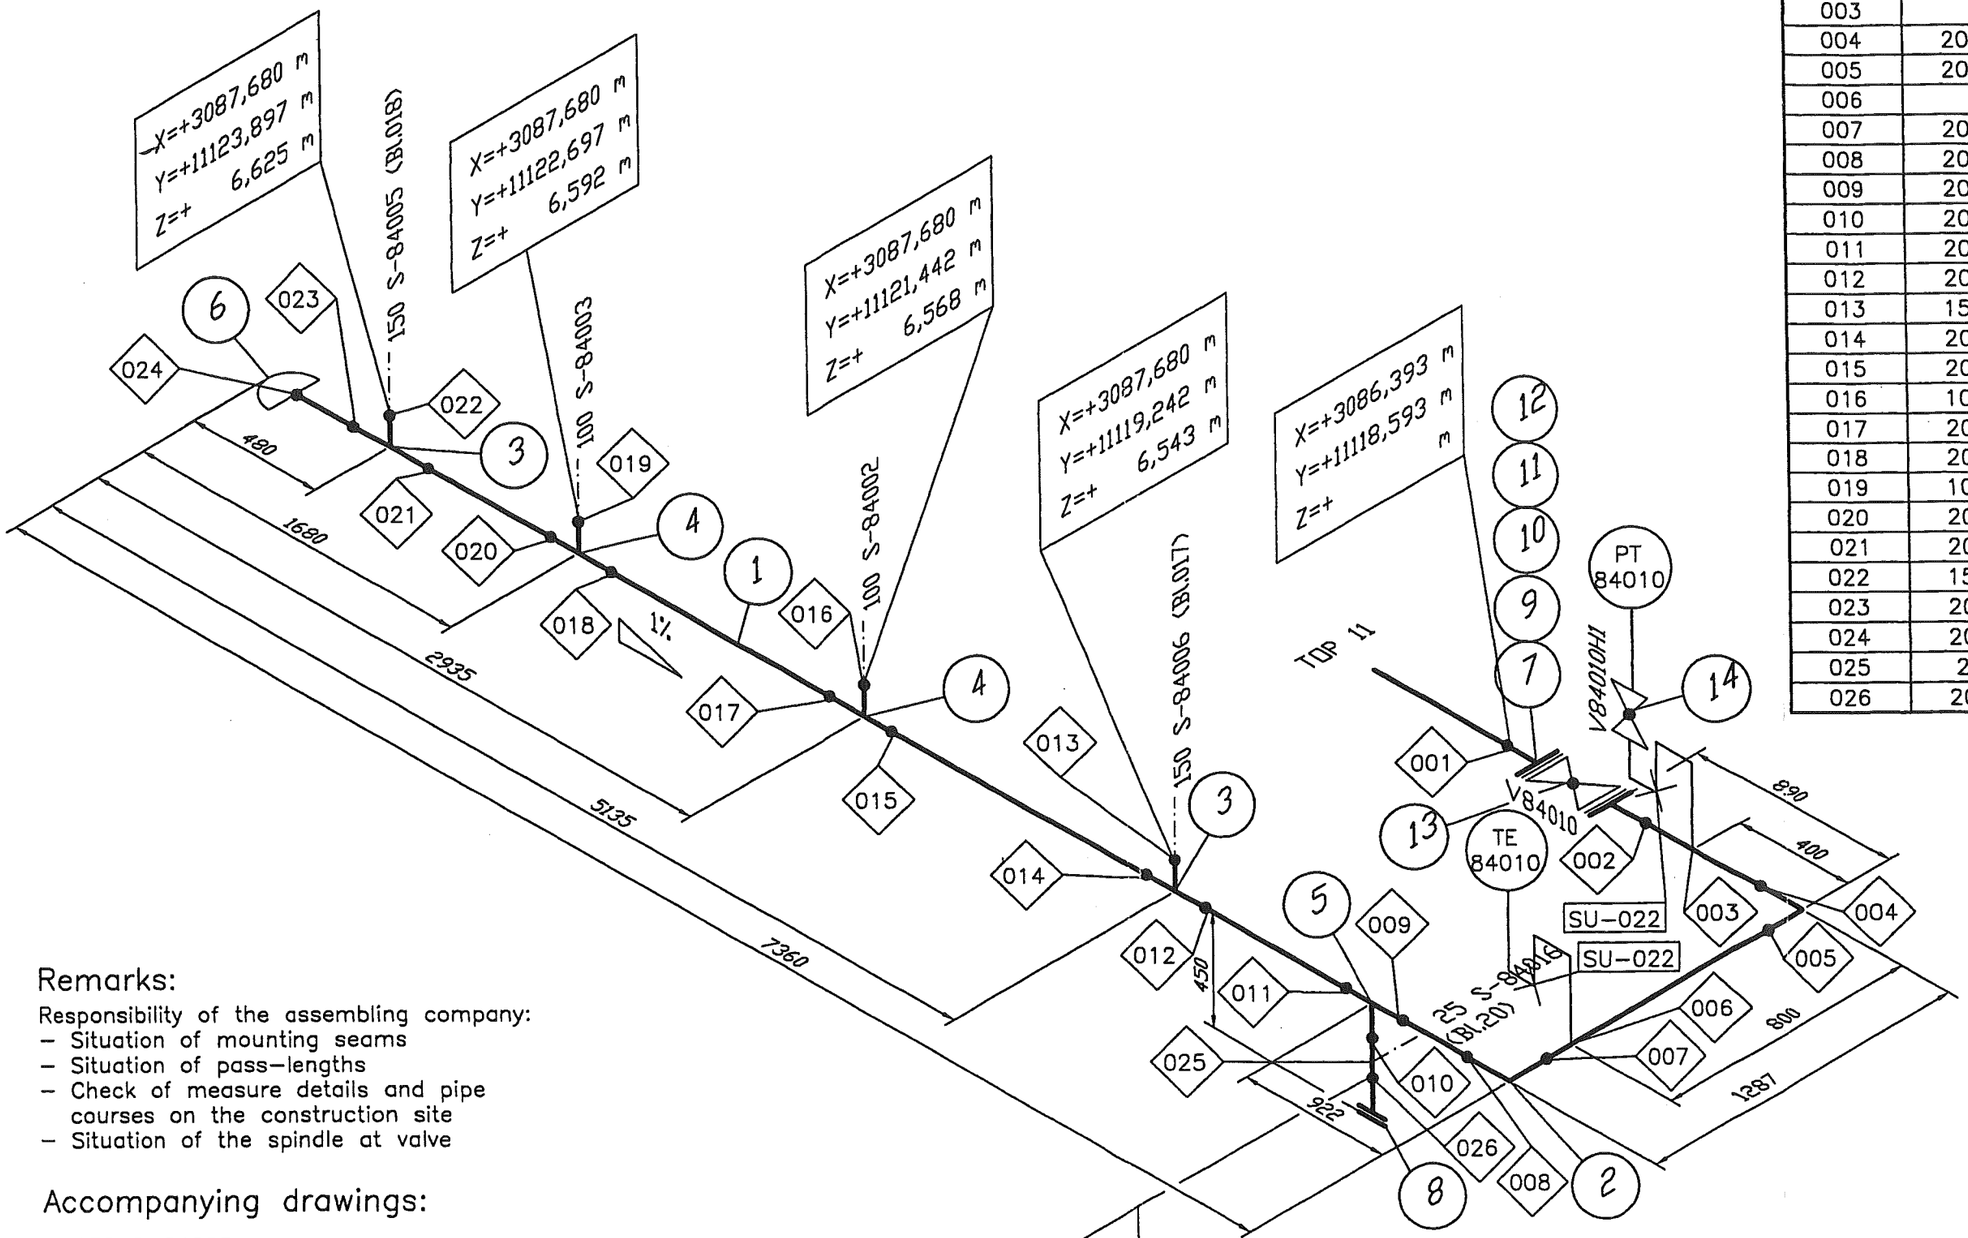

Welding No.	DN	ø	Welder No.	Protoc. No.
001	200	219,1	___	___
002	200	219,1	___	___
003		12	___	___
004	200	219,1	___	___
005	200	219,1	___	___
006		12	___	___
007	200	219,1	___	___
008	200	219,1	___	___
009	200	219,1	___	___
010	200	219,1	___	___
011	200	219,1	___	___
012	200	219,1	___	___
013	150	168,3	___	___
014	200	219,1	___	___
015	200	219,1	___	___
016	100	114,3	___	___
017	200	219,1	___	___
018	200	219,1	___	___
019	100	114,3	___	___
020	200	219,1	___	___
021	200	219,1	___	___
022	150	168,3	___	___
023	200	219,1	___	___
024	200	219,1	___	___
025	25	33,7	___	___
026	200	219,1	___	___

Remarks:

Responsibility of the assembling company:
- Situation of mounting seams
- Situation of pass-lengths
- Check of measure details and pipe courses on the construction site
- Situation of the spindle at valve

Accompanying drawings:

- 150 S-84005
- 100 S-84003
- 100 S-84002
- 150 S-84006
- 25 S-84016

Accompanying lists:

- Parts list: 200 S-84001

Pipe Standard:

- AL Standard No.: 50034 / BA25C1

X=+3087,680 m
Y=+11117,942 m
Z=+ 6,175 m

Z Y X

AIR LIQUIDE	Date : 09.12.2004	Name : WIP/Rad.	Checked: –	History file: 79287106.doc
Air Liquide AGS GmbH	Job code: K70101	Reference: ASU Kosice	Scale --:--	Original format DIN A3
Replaces: 79_._____	Replaced by: 79_._-----	Title: 200 S-84001	Sheet: 019	of – Sheets
			Drawing No.: 792.87106	Rev. A

This drawing is protected by copyright.
It may not be copied or used without our written authorization and it is strictly prohibited to disclose it to any third parties.

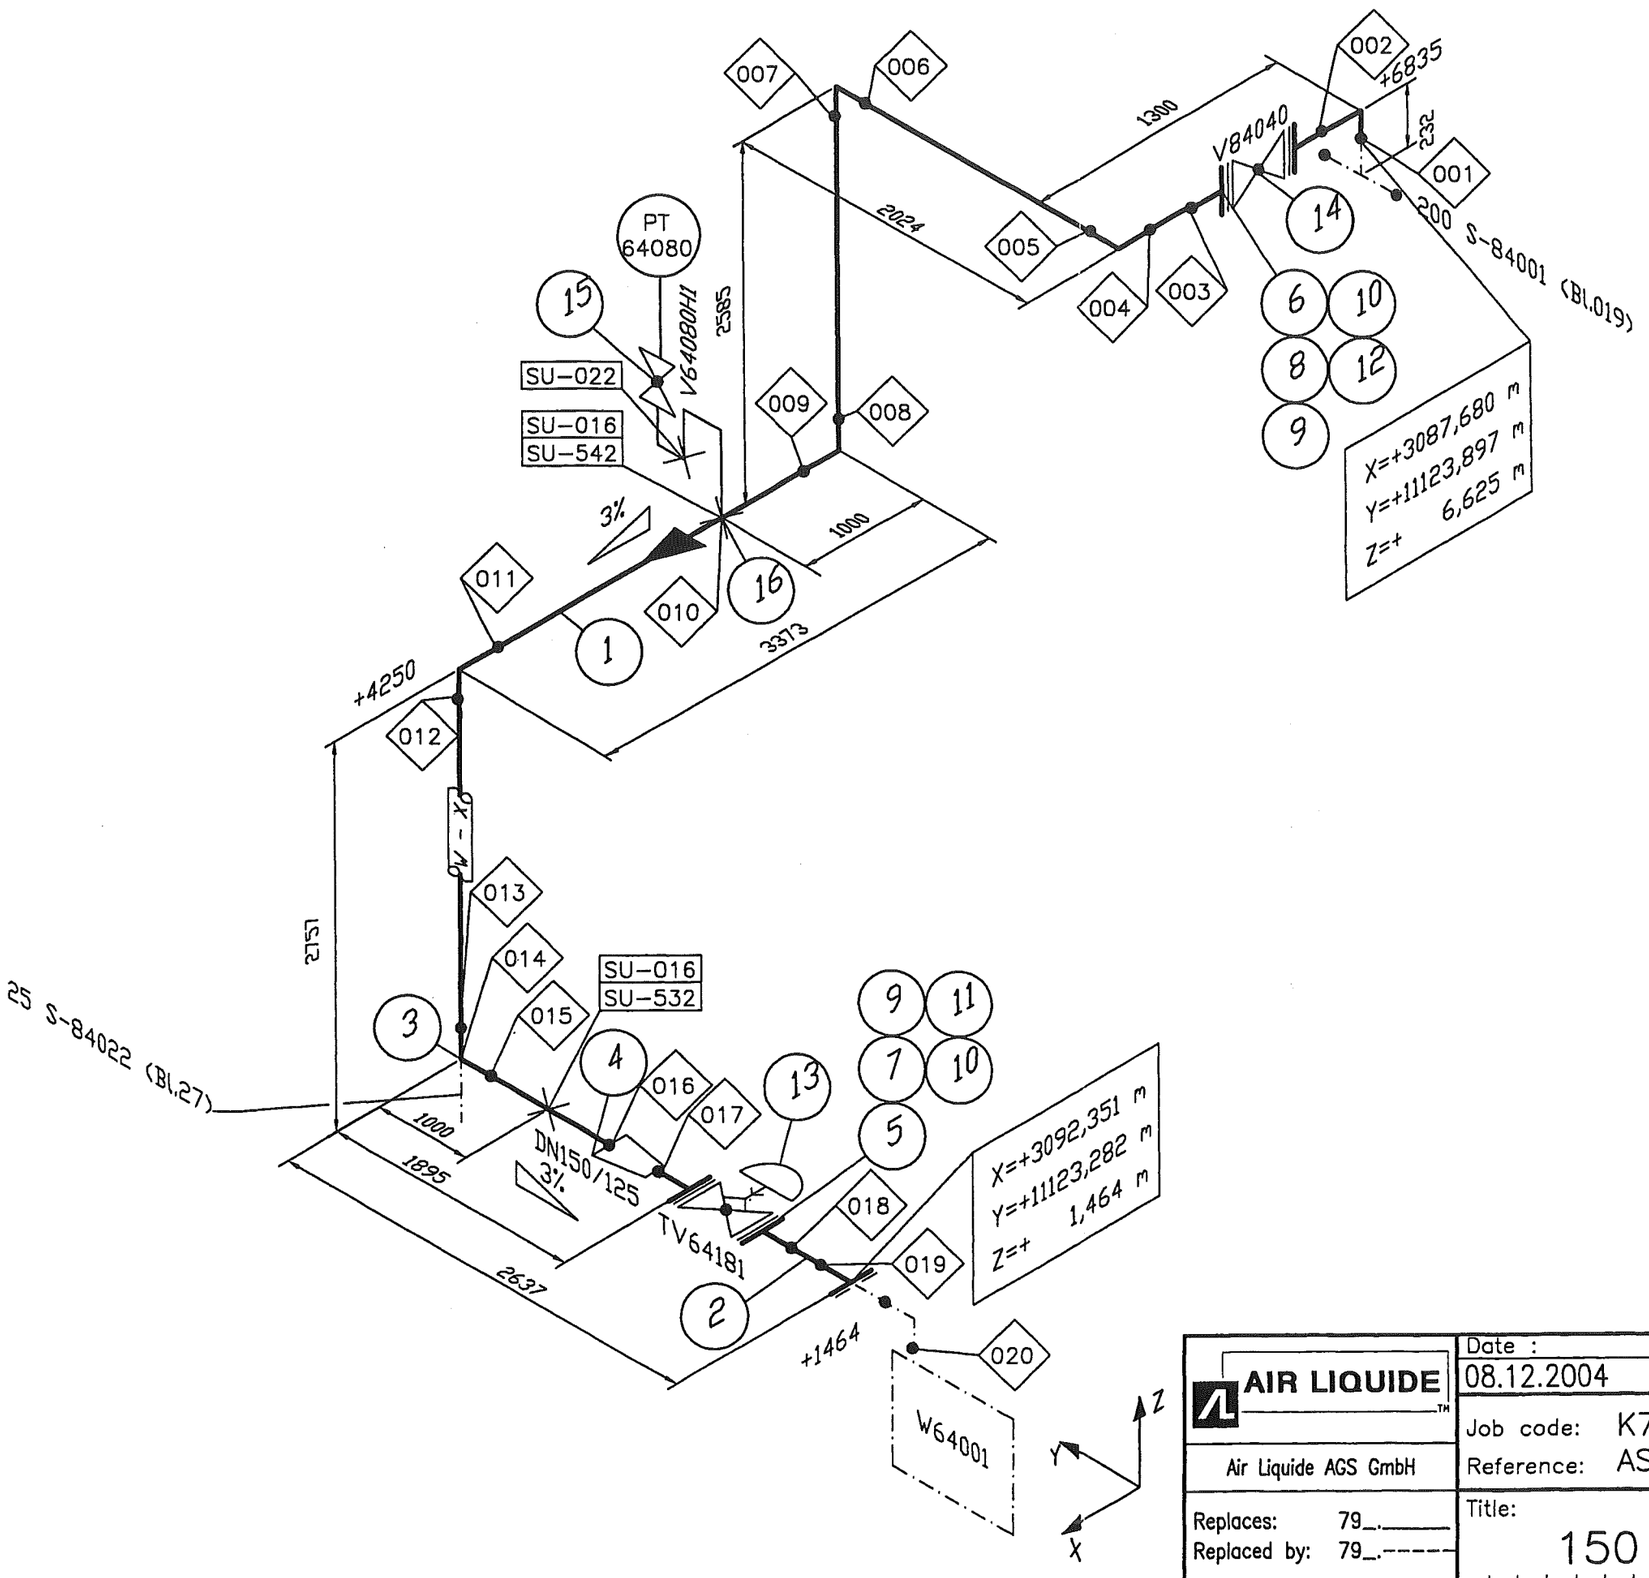

Welding No.	DN	ø	Welder No.	Protoc No.
001	150	168,3	___	___
002	150	168,3	___	___
003	150	168,3	___	___
004	150	168,3	___	___
005	150	168,3	___	___
006	150	168,3	___	___
007	150	168,3	___	___
008	150	168,3	___	___
009	150	168,3	___	___
010		12	___	___
011	150	168,3	___	___
012	150	168,3	___	___
013	150	168,3	___	___
014	25	33,7	___	___
015	150	168,3	___	___
016	150	168,3	___	___
017	125	139,7	___	___
018	125	139,7	___	___
019	125	139,7	___	___
020	125	139,7	___	___

Remarks:

Responsibility of the assembling company:
- Situation of mounting seams
- Situation of pass-lengths
- Check of measure details and pipe courses on the construction site
- Situation of the spindle at valve

Accompanying drawings:

- 25 S-84022
- 200 S-84001

Accompanying lists:

- Parts list: 150 S-84005

Pipe Standard:

- AL Standard No.: 50034 / BA25C1

AIR LIQUIDE

Air Liquide AGS GmbH

Replaces: 79_.____
Replaced by: 79_.-----

Date :	Name :	Checked:	History file:
08.12.2004	WIP/Rad.	–	79287106.doc

Job code: K70101
Reference: ASU Kosice

Scale --:--
Original format DIN A3
Sheet: 018 of – Sheets

Title: 150 S-84005

Drawing No.: 792.87106
Rev.: A

This drawing is protected by copyright.
It may not be copied or used without our written authorization and it is strictly prohibited to disclose it to any third parties.

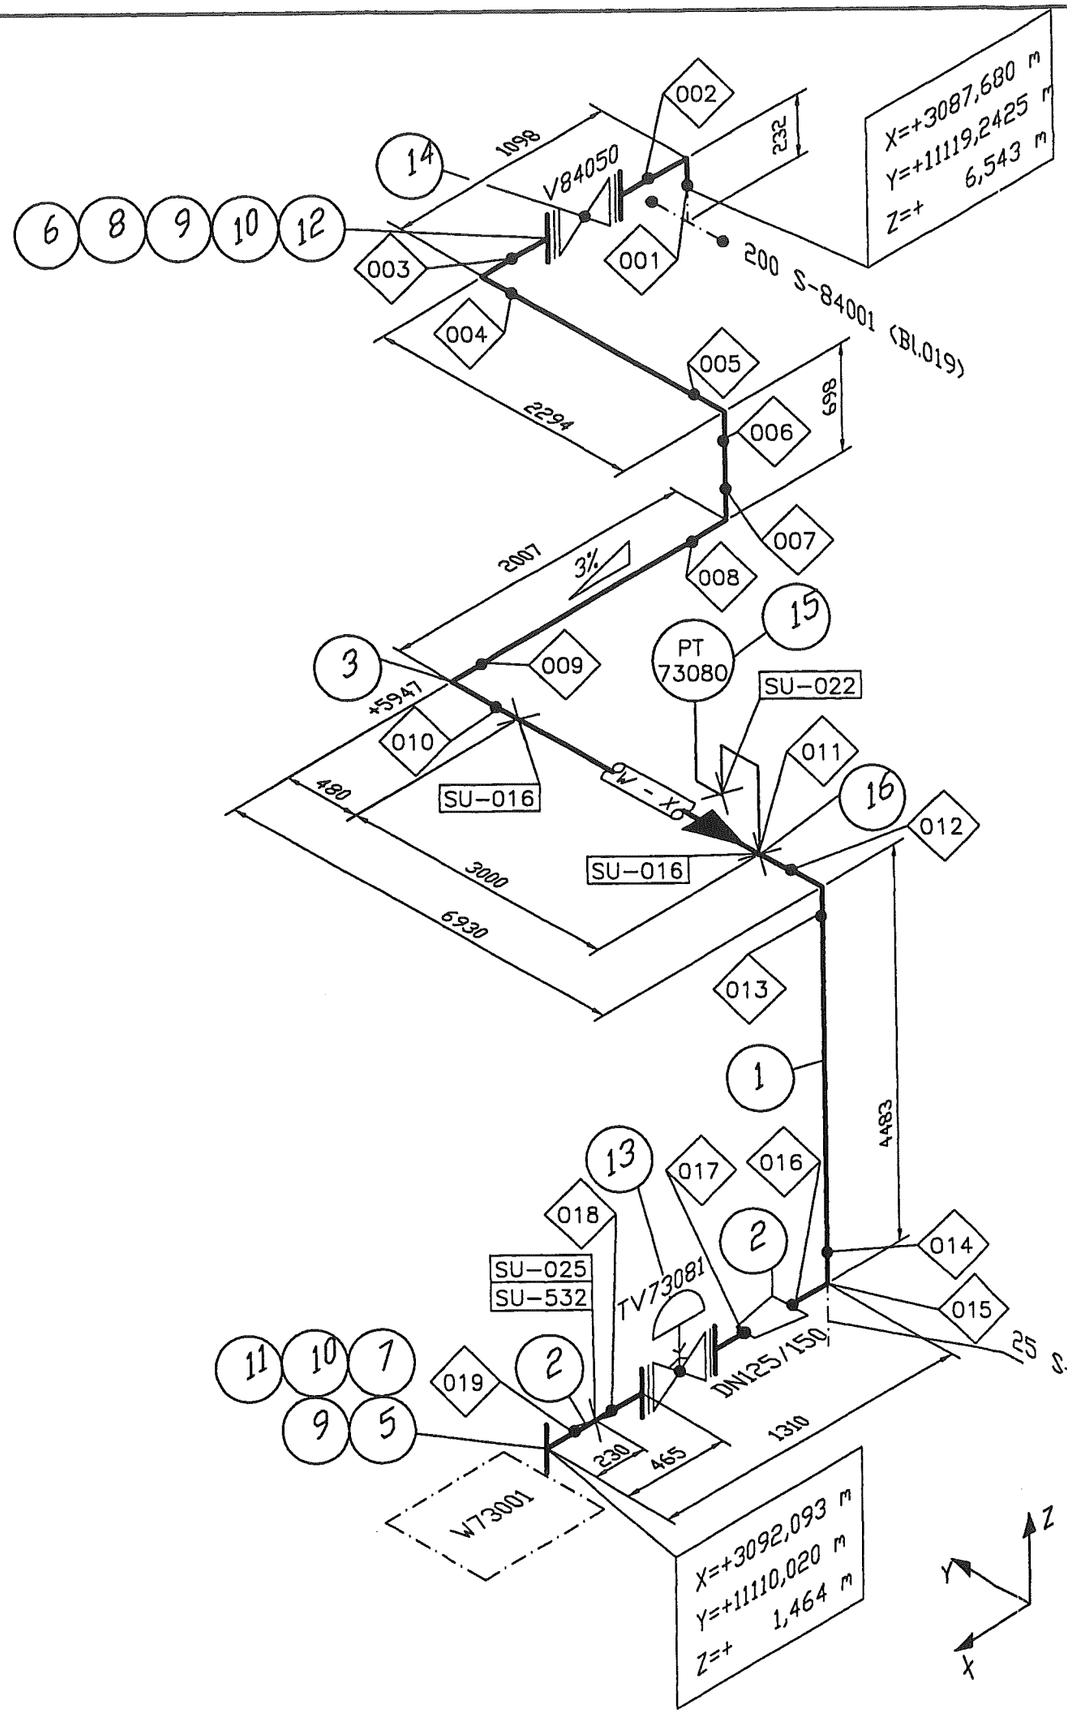

Welding No.	DN	ø	Welder No.	Protoc. No.
001	150	168,3	___	___
002	150	168,3	___	___
003	150	168,3	___	___
004	150	168,3	___	___
005	150	168,3	___	___
006	150	168,3	___	___
007	150	168,3	___	___
008	150	168,3	___	___
009	150	168,3	___	___
010	150	168,3	___	___
011		12	___	___
012	150	168,3	___	___
013	150	168,3	___	___
150	150	168,3	___	___
015	25	33,7	___	___
016	125	139,7	___	___
017	125	139,7	___	___
018	125	139,7	___	___
019	125	139,7	___	

Remarks:

Responsibility of the assembling company:
- Situation of mounting seams
- Situation of pass-lengths
- Check of measure details and pipe courses on the construction site
- Situation of the spindle at valve

Accompanying drawings:

- 25 S-84026
- 200 S-84001

Accompanying lists:

- Parts list: 150 S-84006

Pipe Standard:

- AL Standard No.: 50034 / BA25C1

AIR LIQUIDE

Air Liquide AGS GmbH

Replaces: 79_.____
Replaced by: 79_.-----

Date :	Name :	Checked:	History file:
08.12.2004	WIP/Rad.	-	79287106.doc

Job code: K70101
Reference: ASU Kosice

Scale --:--
Original format DIN A3
Sheet: 017
of - Sheets

Title: 150 S-84006

Drawing No.: 792.87106
Rev. A

This drawing is protected by copyright.
It may not be copied or used without our written authorization and it is strictly prohibited to disclose it to any third parties.

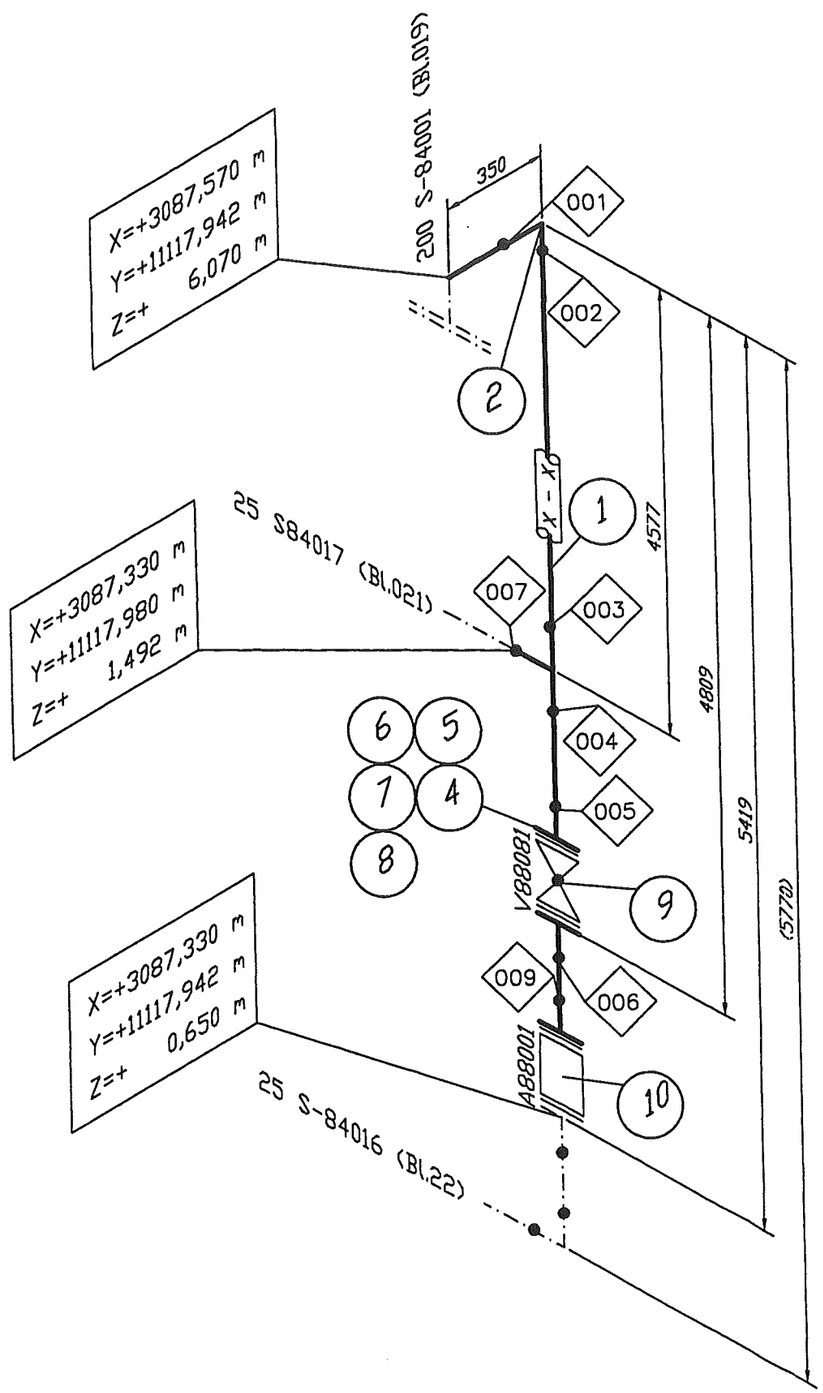

Welding No.	DN	ø	Welder No.	Protoc. No.
001	25	33,7	———	———
002	25	33,7	———	———
003	25	33,7	———	———
004	25	33,7	———	———
005	25	33,7	———	———
006	25	33,7	———	———
007	25	33,7	———	———

Remarks:

Responsibility of the assembling company:
- Situation of mounting seams
- Situation of pass-lengths
- Check of measure details and pipe courses on the construction site
- Situation of the spindle at valve

Accompanying drawings:

- 200 S-84001
- 25 S-84016
- 25 S-84017

Accompanying lists:

- Parts list: 25 S-84016

Pipe Standard:

- AL Standard No.: 50034 / BA25C1

AIR LIQUIDE	Date : 10.12.2004	Name : WIP/Rad.	Checked: –	History file: 79287106.doc
Air Liquide AGS GmbH	Job code: K70101 Reference: ASU Kosice		Scale --:--	Original format DIN A3
			Sheet: 020	of – Sheets
Replaces: 79_.——— Replaced by: 79_.-----	Title: 25 S-84016		Drawing No.: 792.87106	Rev. A

This drawing is protected by copyright.
It may not be copied or used without our written authorization and it is strictly prohibited to disclose it to any third parties.

Welding No.	DN	ø	Welder No.	Protoc No.
001	25	33,7	___	___
002	25	33,7	___	___
003	25	33,7	___	___
004	25	33,7	___	___
005	25	33,7	___	___
006	25	33,7	___	___
007	25	33,7	___	___
008	25	33,7	___	___

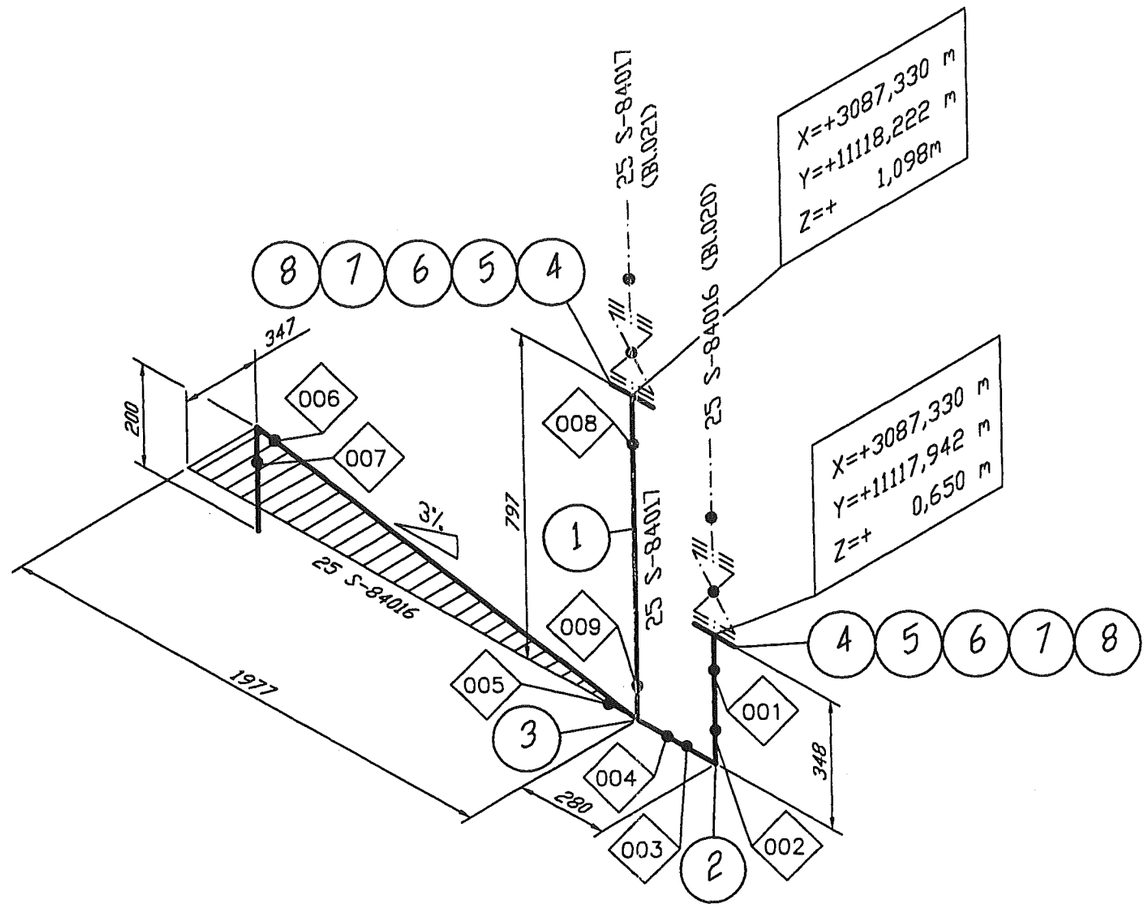

Remarks:

Responsibility of the assembling company:
- Situation of mounting seams
- Situation of pass-lengths
- Check of measure details and pipe courses on the construction site
- Situation of the spindle at valve

Accompanying drawings:

- 25 S-84016
- 25 S-84017

Accompanying lists:

- Parts list:
  25 S-84016
  25 S-84017

Pipe Standard:

- AL Standard No.:
  50018 / AA10C1

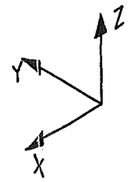

AIR LIQUIDE	Date : 13.12.2004	Name : WIP/Rad.	Checked: –
Air Liquide AGS GmbH	Job code: K70101	Reference: ASU Kosice	
Replaces: 79_.____	Replaced by: 79_.-----	Title: 25 S-84016 25 S-84017	

History file: 79287106.doc		
Scale --:--	Original format DIN A3	
Sheet: 022	of – Sheets	
Drawing No.: 792.87106	Rev. A	

This drawing is protected by copyright.
It may not be copied or used without our written authorization and it is strictly prohibited to disclose it to any third parties.

Welding No.	DN	ø	Welder No.	Protoc No.
001	25	33,7	____	____
002	25	33,7	____	____
003	25	33,7	____	____

Remarks:

Responsibility of the assembling company:
- Situation of mounting seams
- Situation of pass-lengths
- Check of measure details and pipe courses on the construction site
- Situation of the spindle at valve

Accompanying drawings:

-- 25 S-84016
- 25 S-84017

Accompanying lists:

- Parts list:
  25 S-84017

Pipe Standard:

- AL Standard No.:
  50034 / BA25C1

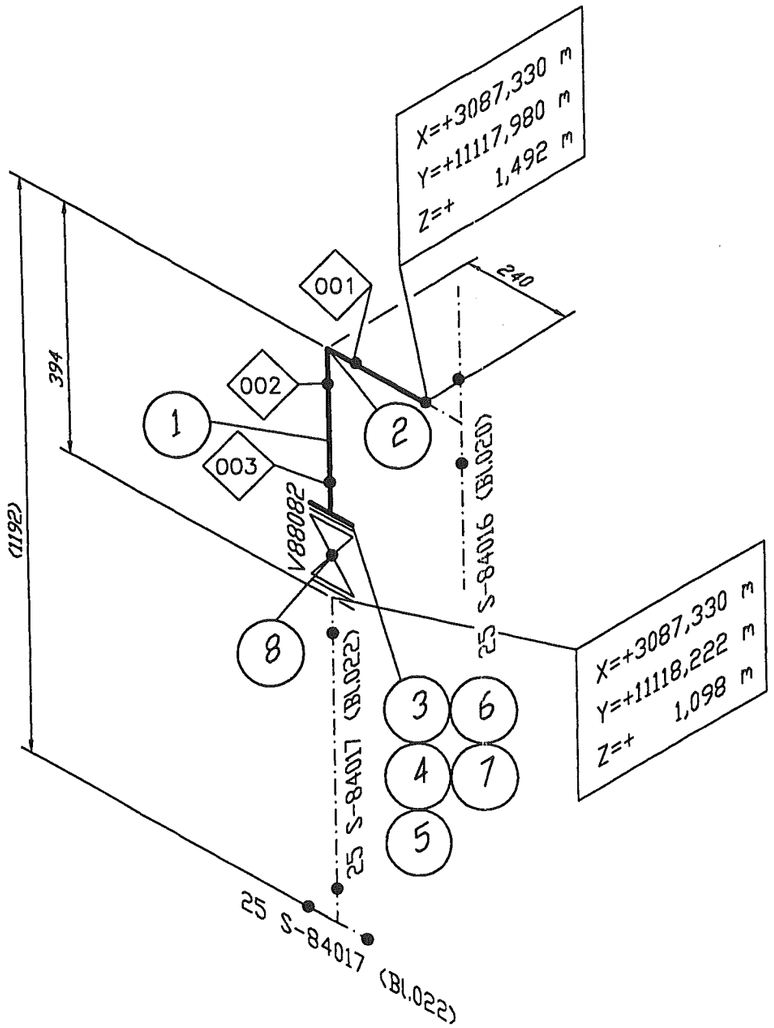

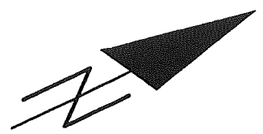

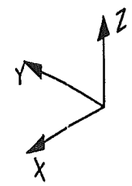

AIR LIQUIDE	Date :	Name :	Checked:	History file:
	10.12.2004	WIP/Rad.	–	79287106.doc
	Job code: K70101		Scale --:--	Original format DIN A3
Air Liquide AGS GmbH	Reference: ASU Kosice		Sheet: 021	of – Sheets
Replaces: 79_.____	Title:		Drawing No.:	Rev.
Replaced by: 79_.-----	25 S-84017		792.87106	A

This drawing is protected by copyright.
. may not be copied or used without our written authorization and it is strictly prohibited to disclose it to any third parties.

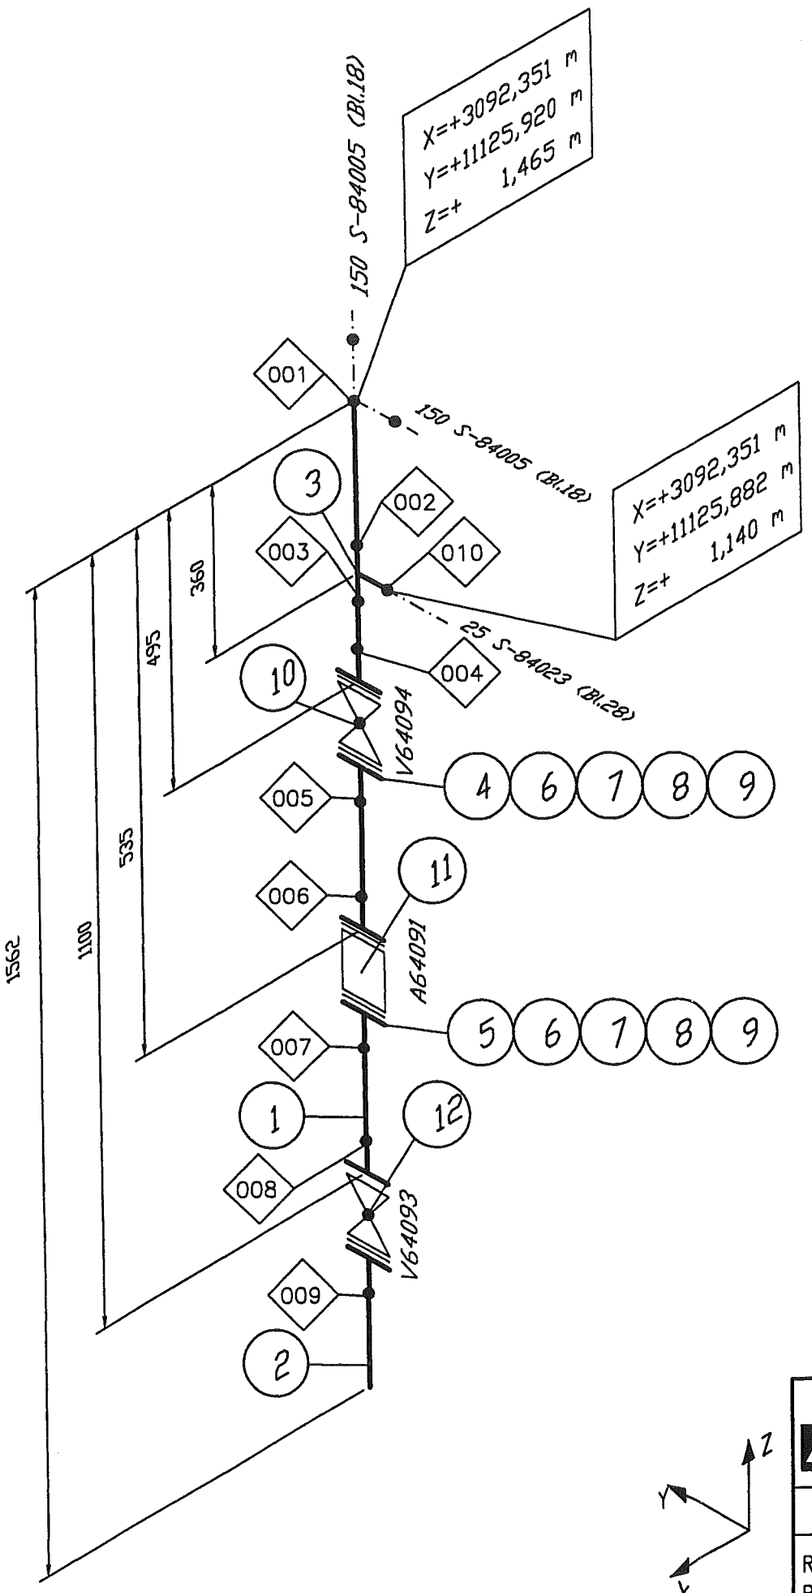

Welding No.	DN	ø	Welder No.	Protoc No.
001	25	33,9	___	___
002	25	33,9	___	___
003	25	33,9	___	___
004	25	33,9	___	___
005	25	33,9	___	___
006	25	33,9	___	___
007	25	33,9	___	___
008	25	33,9	___	___
009	25	33,9	___	___
010	25	33,9	___	___

Remarks:

Responsibility of the assembling company:
- Situation of mounting seams
- Situation of pass–lengths
- Check of measure details and pipe courses on the construction site
- Situation of the spindle at valve

Accompanying drawings:

- 150 S–84005
- 25 S–84023

Accompanying lists:

- Parts list:
  25 S–84022

Pipe Standard:

- AL Standard No.:
  50034 / BA25C1
  50013 / AA10C1

AIR LIQUIDE

Air Liquide AGS GmbH

Replaces: 79_.____
Replaced by: 79_.----

Date :	Name :	Checked:	History file:
13.12.2004	WIP/Rad.	–	79287106.doc

Job code: K70101
Reference: ASU Kosice

Scale --:--
Original format DIN A3
Sheet: 027
of – Sheets

Title: 25 S 84022

Drawing No.: 792.87106
Rev.: A

This drawing is protected by copyright.
It may not be copied or used without our written authorization and it is strictly prohibited to disclose it to any third parties.

Welding No.	DN	ø	Welder No.	Protoc. No.
001	25	33,9	———	———
002	25	33,9	———	———
003	25	33,9	———	———
004	25	33,9	———	———
005	25	33,9	———	———

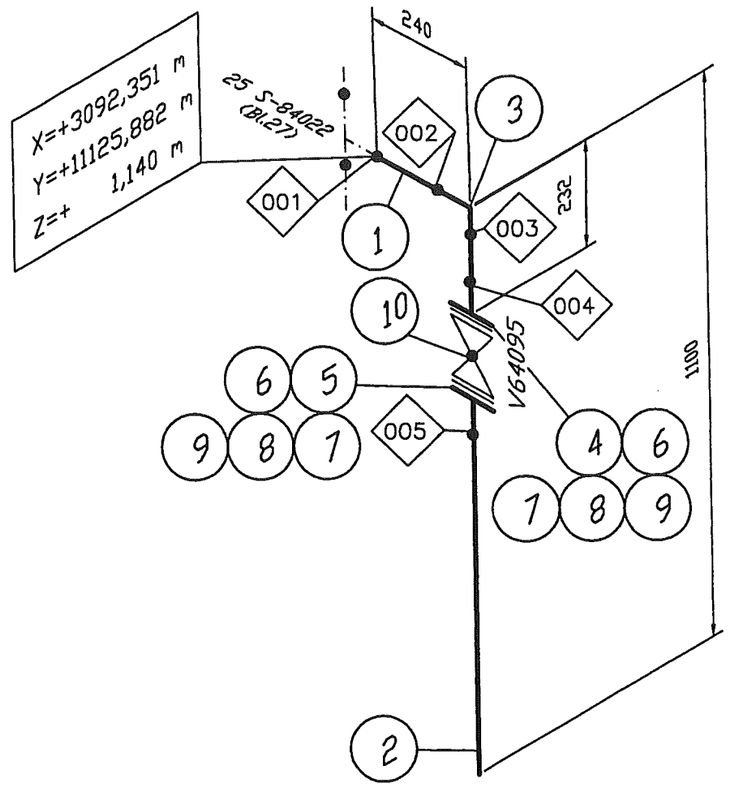

Remarks:

Responsibility of the assembling company:
- Situation of mounting seams
- Situation of pass-lengths
- Check of measure details and pipe courses on the construction site
- Situation of the spindle at valve

Accompanying drawings:

- 25 S-84022

Accompanying lists:

- Parts list: 25 S-84023

Pipe Standard:

- AL Standard No.: 50034 / BA25C1

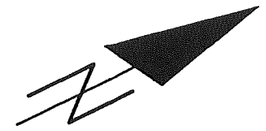

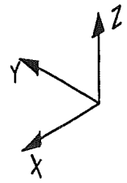

AIR LIQUIDE	Date : 13.12.2004	Name : WIP/Rad.	Checked: –	History file: 79287106.doc
Air Liquide AGS GmbH	Job code: K70101 Reference: ASU Kosice		Scale --:--	Original format DIN A3
			Sheet: 028	of – Sheets
Replaces: 79_.——— Replaced by: 79_.-----	Title: 25 S 84023		Drawing No.: 792.87106	Rev. A

This drawing is protected by copyright.
It may not be copied or used without our written authorization and it is strictly prohibited to disclose it to any third parties.

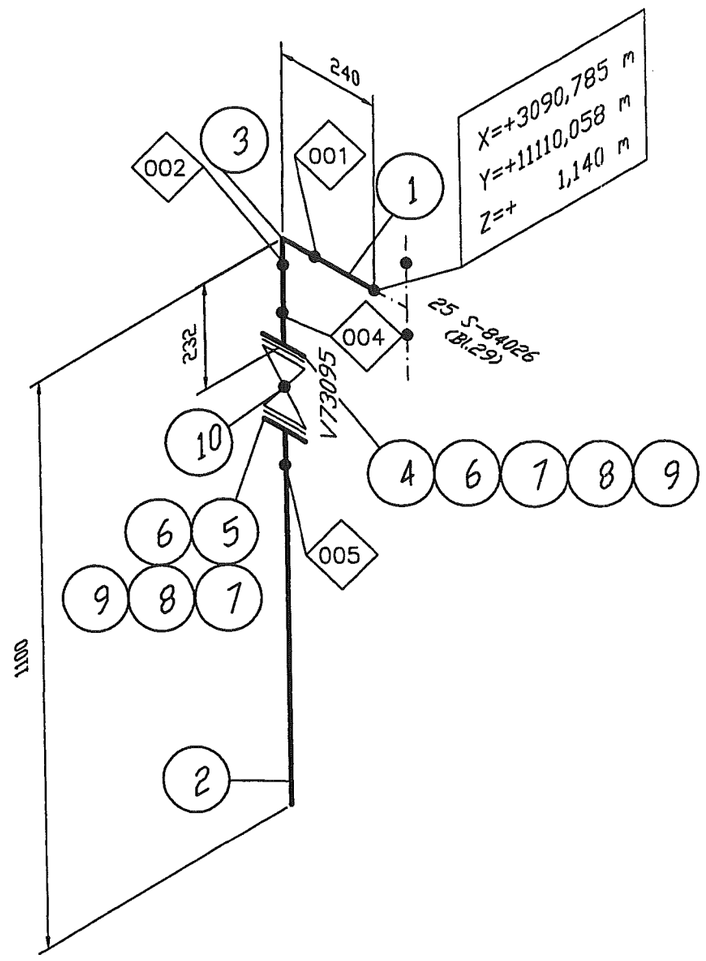

Welding No.	DN	ø	Welder No.	Protoc. No.
001	25	33,9	___	___
002	25	33,9	___	___
003	25	33,9	___	___
004	25	33,9	___	___
005	25	33,9	___	___
006	25	33,9	___	___
007	25	33,9	___	___
008	25	33,9	___	___

Remarks:

Responsibility of the assembling company:
- Situation of mounting seams
- Situation of pass-lengths
- Check of measure details and pipe courses on the construction site
- Situation of the spindle at valve

Accompanying drawings:

- 25 S-84026

Accompanying lists:

- Parts list:
  25 S-84027

Pipe Standard:

- AL Standard No.:
  50034 /BA25C1

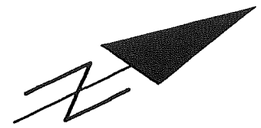

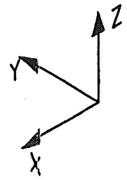

AIR LIQUIDE™	Date : 13.12.2004	Name : WIP/Rad.	Checked: –	History file: 79287106.doc
Air Liquide AGS GmbH	Job code: K70101 Reference: ASU Kosice		Scale --:--	Original format DIN A3
			Sheet: 030	of – Sheets
Replaces: 79_.____ Replaced by: 79_.-----	Title: 25 S 84027		Drawing No.: 792.87106	Rev. A

This drawing is protected by copyright.
It may not be copied or used without our written authorization and it is strictly prohibited to disclose it to any third parties.

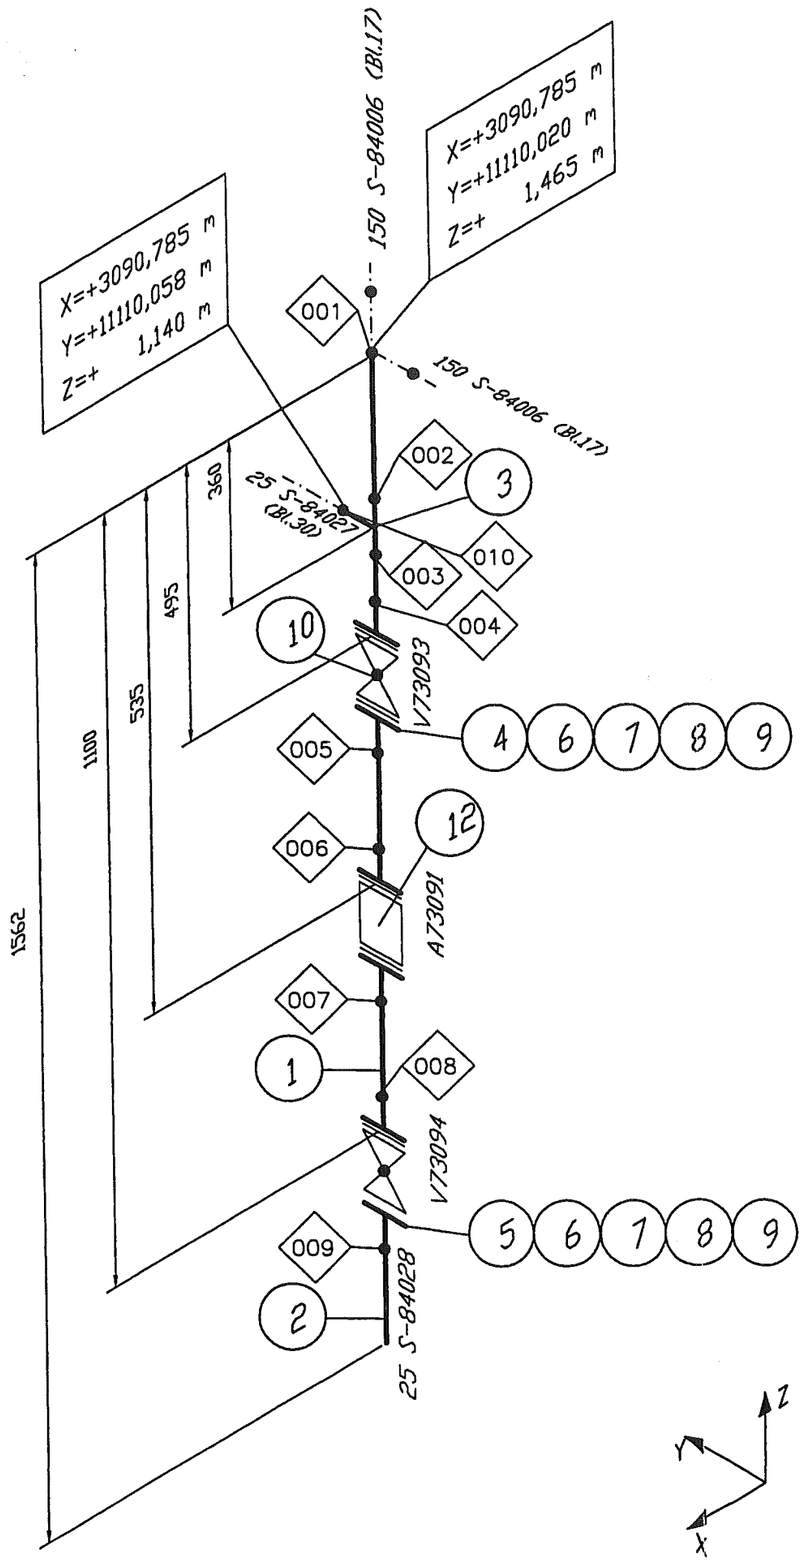

Welding No.	DN	ø	Welder No.	Protoc. No.
001	25	33,9	___	___
002	25	33,9	___	___
003	25	33,9	___	___
004	25	33,9	___	___
005	25	33,9	___	___
006	25	33,9	___	___
007	25	33,9	___	___
008	25	33,9	___	___
009	25	33,9	___	___
010	25	33,9	___	___

Remarks:

Responsibility of the assembling company:
- Situation of mounting seams
- Situation of pass–lengths
- Check of measure details and pipe courses on the construction site
- Situation of the spindle at valve

Accompanying drawings:

- 150 S–84006
- 25 S–84027

Accompanying lists:

- Parts list:
  25 S–84026

Pipe Standard:

- AL Standard No.:
  50034 / BA25C1
  50018 / AA10C1

AIR LIQUIDE

Air Liquide AGS GmbH

Replaces: 79_.____
Replaced by: 79_.-----

Date :	Name :	Checked:	History file:
13.12.2004	WIP/Rad.	–	79287106.doc

Job code: K70101
Reference: ASU Kosice

Scale --:--
Original format DIN A3
Sheet: 029
of – Sheets

Title: 25 S 84028
25 S 84026

Drawing No.: 792.87106
Rev. A