


SEE DWG 792.87811

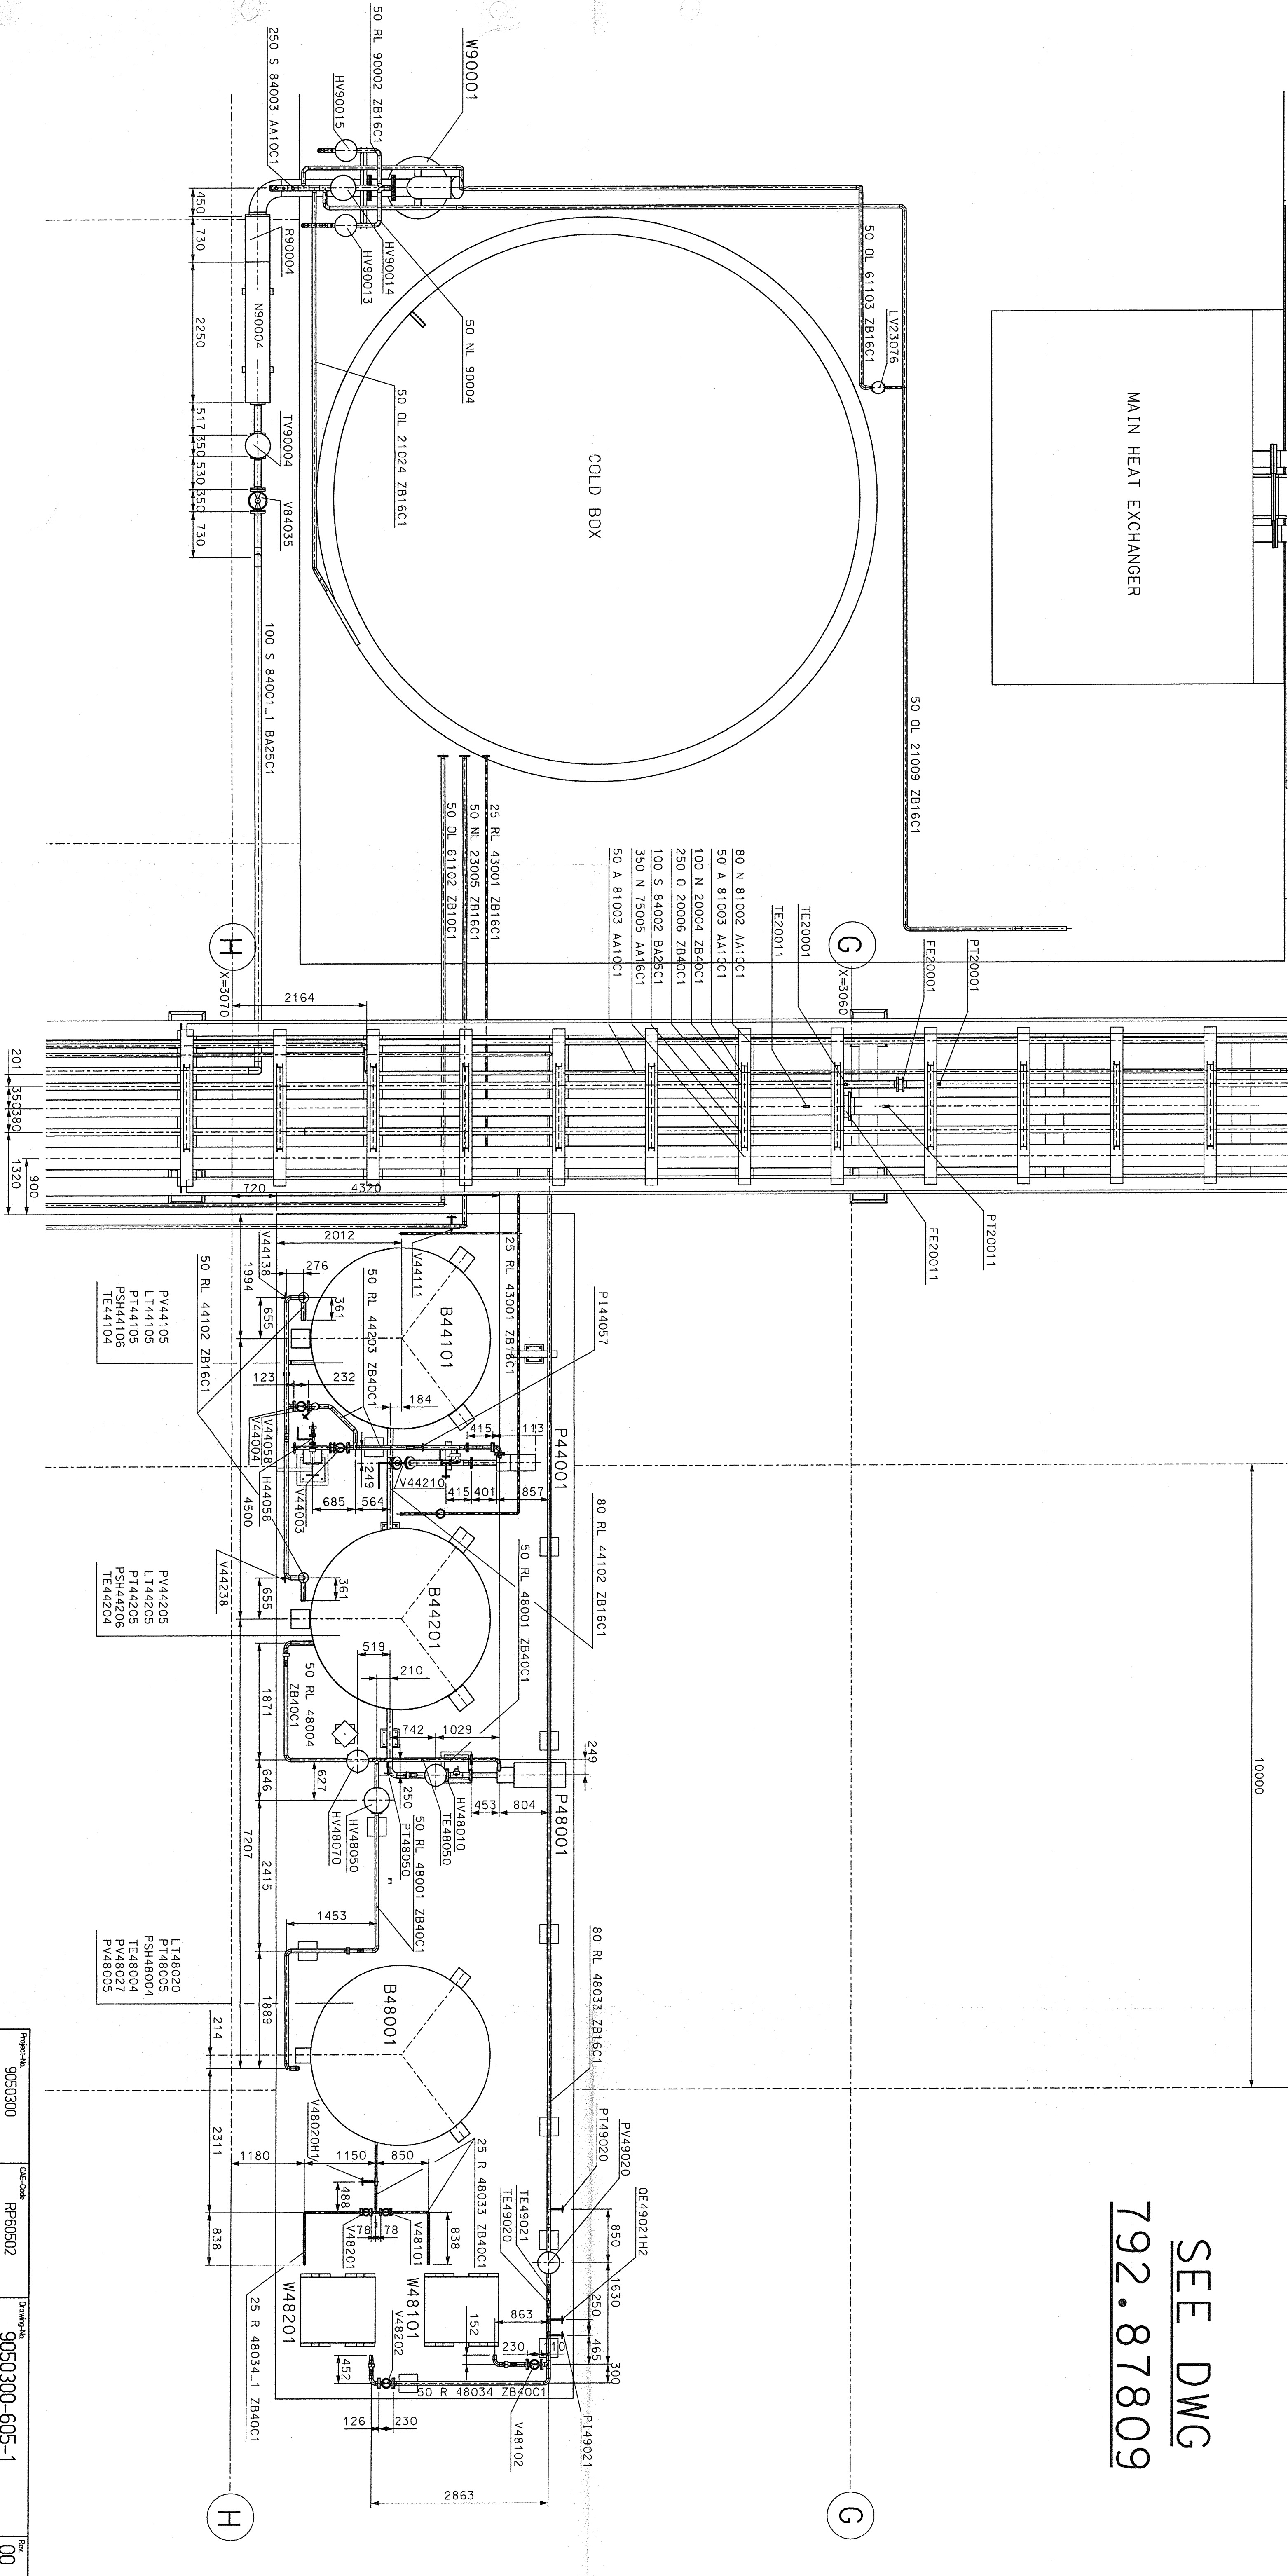

Plant North

SEE DWG
792.87809

LEVELS

TOP OF INTERNAL ROADS: 225.00m n. m.
TOP OF FOUNDATION: 225.10m
BOTTOM OF STEEL STRUCTURE: 225.15 = ±0.00



Air Liquide AOS GmbH

Project No. 9050300		Drawing No. 9050300-605-1		Rev. 00

REV.	DATE	DESCRIPTION	BY	DATE
1	2005/06/20	TOP VIEW 05	792.87812	00