



7

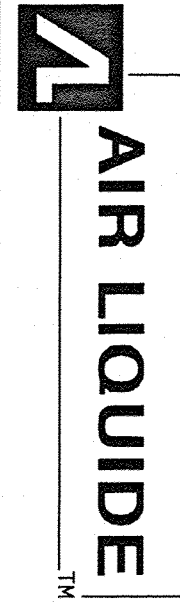

TOP OF INTERNAL ROADS: 225.00m n. m.

BOTTOM OF STEEL STRUCTURE: 225,15 = ±0,00

REVISIONS

AIR LIQUIDETM

VIEW Z 792.87813 00