


SEE DWG 792.87815

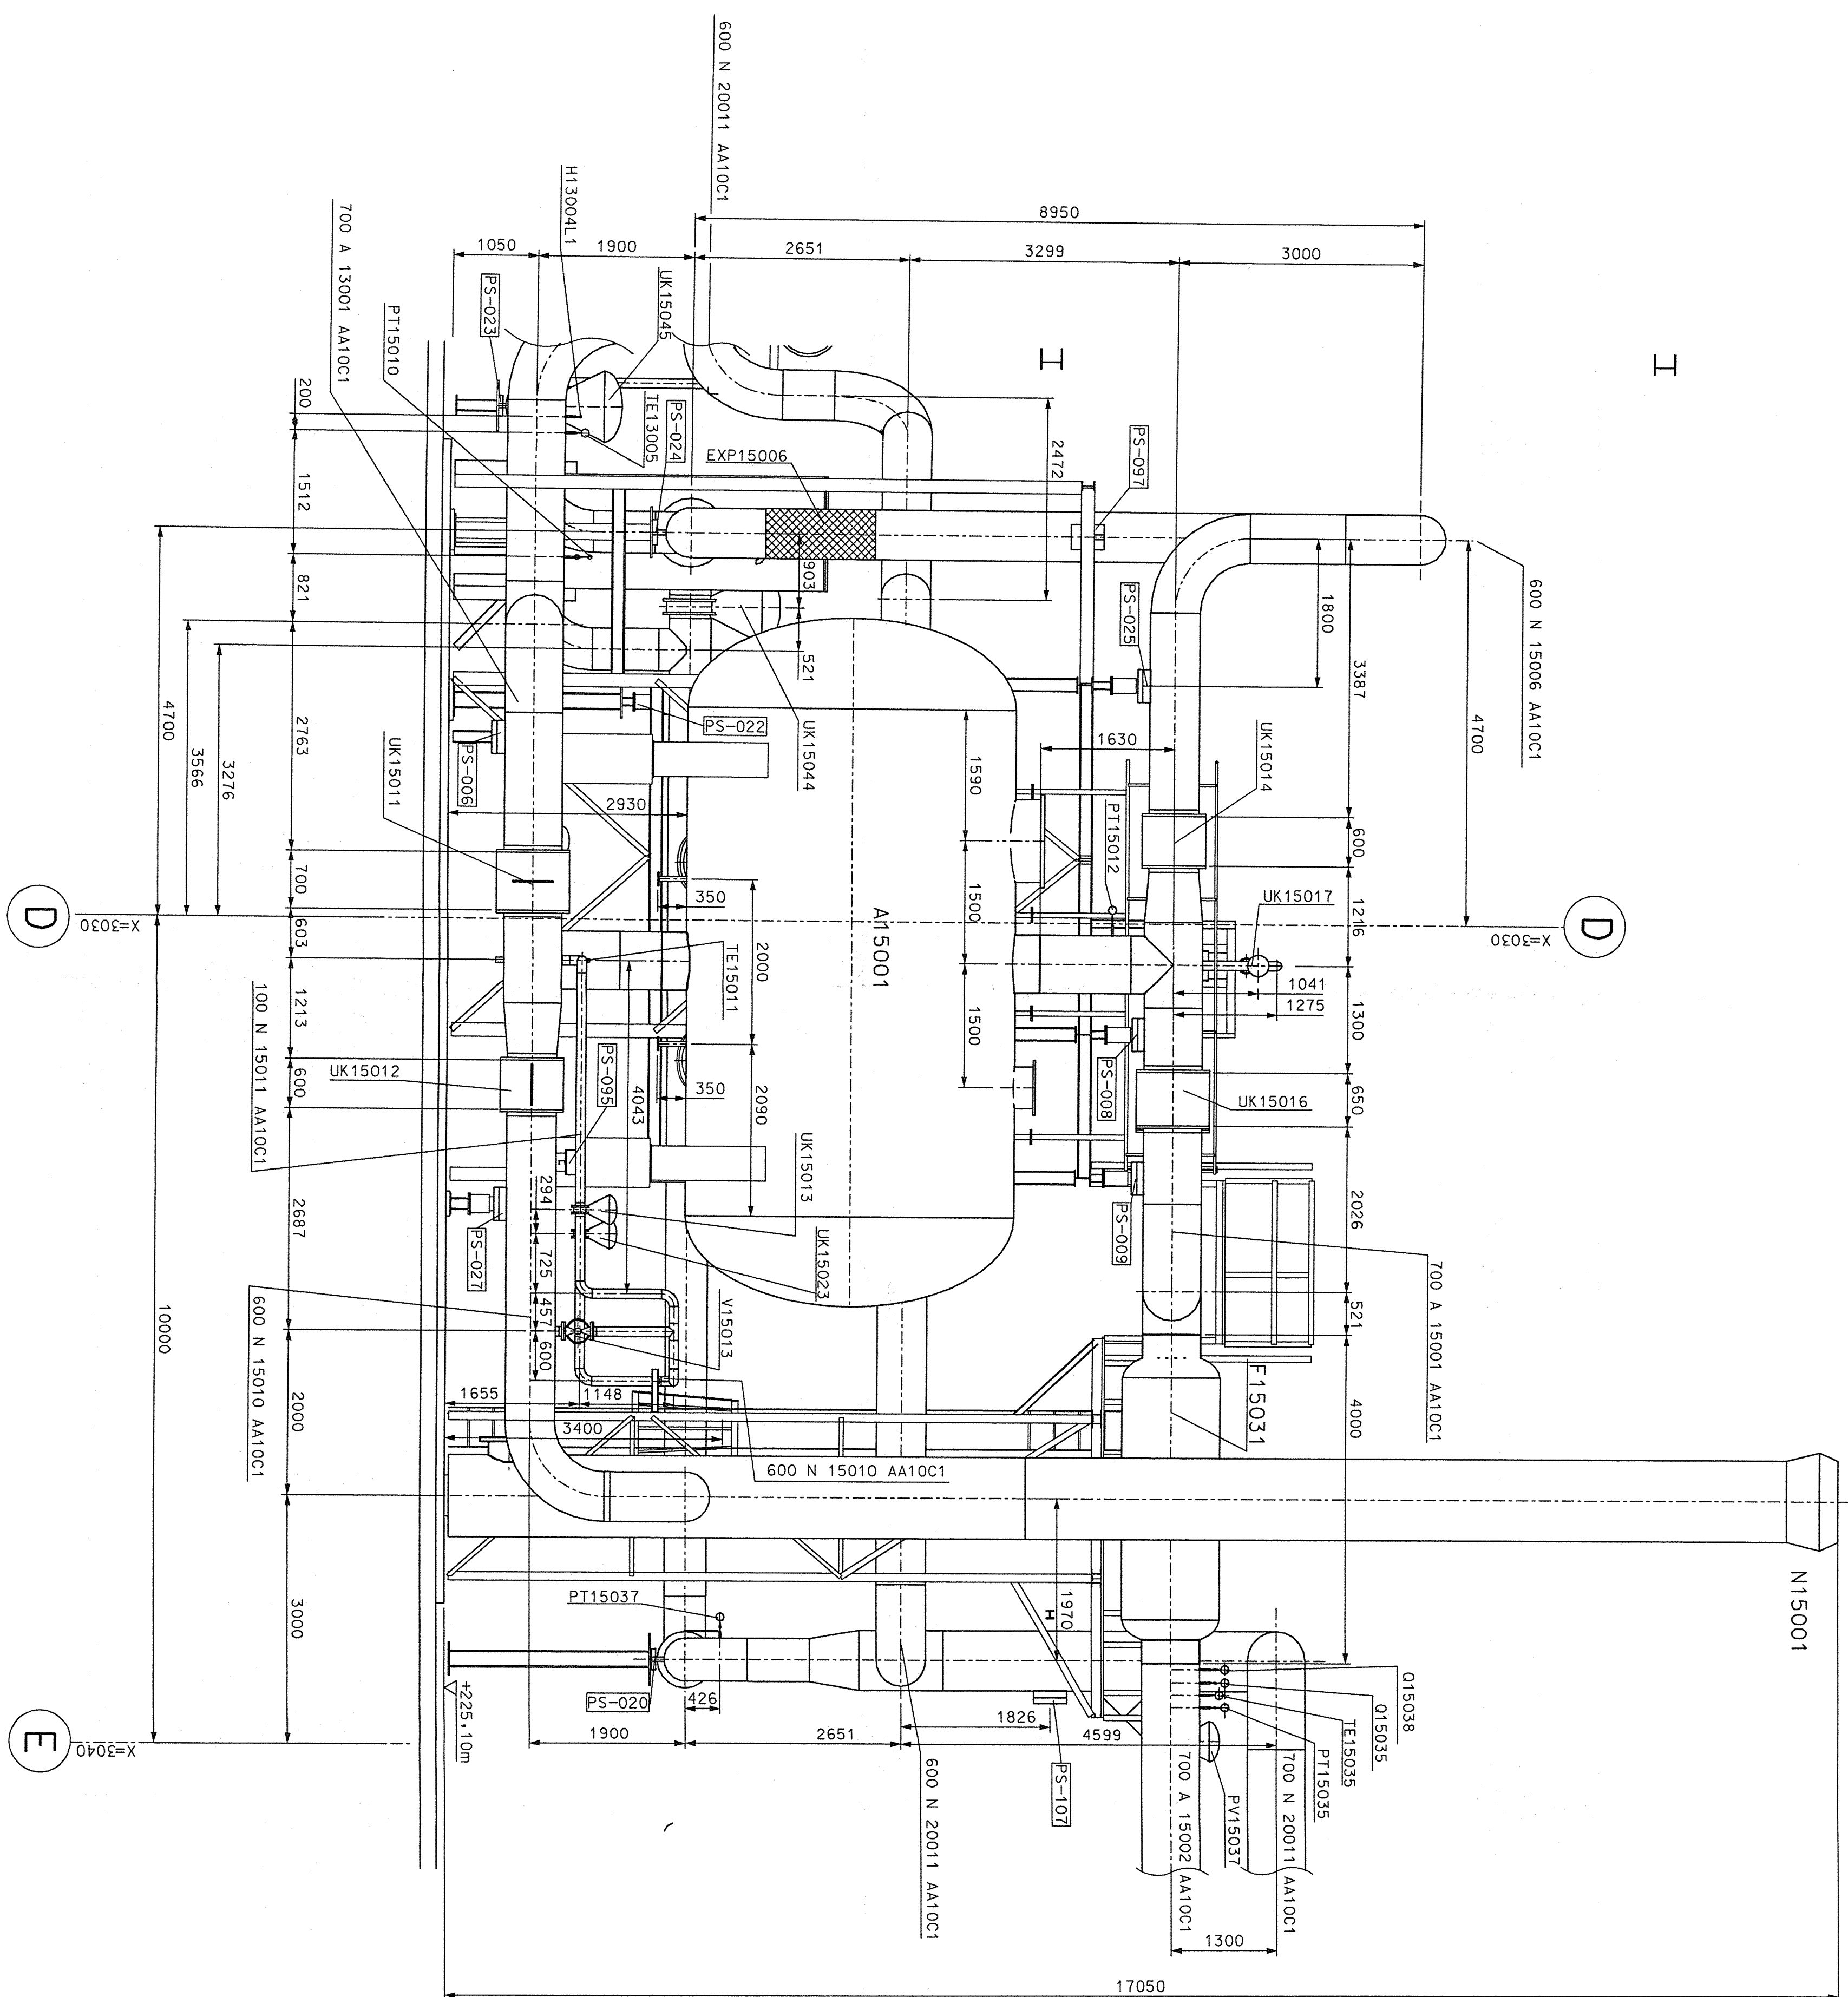

SEE DWG 792.87813

## LEVELS

TOP OF INTERNAL ROADS:	225.00m n. m.
TOP OF FOUNDATION:	225.10m
BOTTOM OF STEEL STRUCTURE:	225.15 = ±0.00

[illegible]

**AIR LIQUIDE**<sup>TM</sup>

Air Liquide AGS GmbH

DATE	CHECKED	DATE	SHEET FILE
2005/06/20	AR	11 JUL 2005	✓
JOB CODE	K001 ASU NO. 3 Kasece	SCALE	OPENING FORMAT
REFERENCE	INSTALLATION DRAWING	150	1/4"
		SHEET	8
		OF 8 SHEETS	
FEJ 0025	VIEW Y	79287814	FEJ
FEJ 0026			00