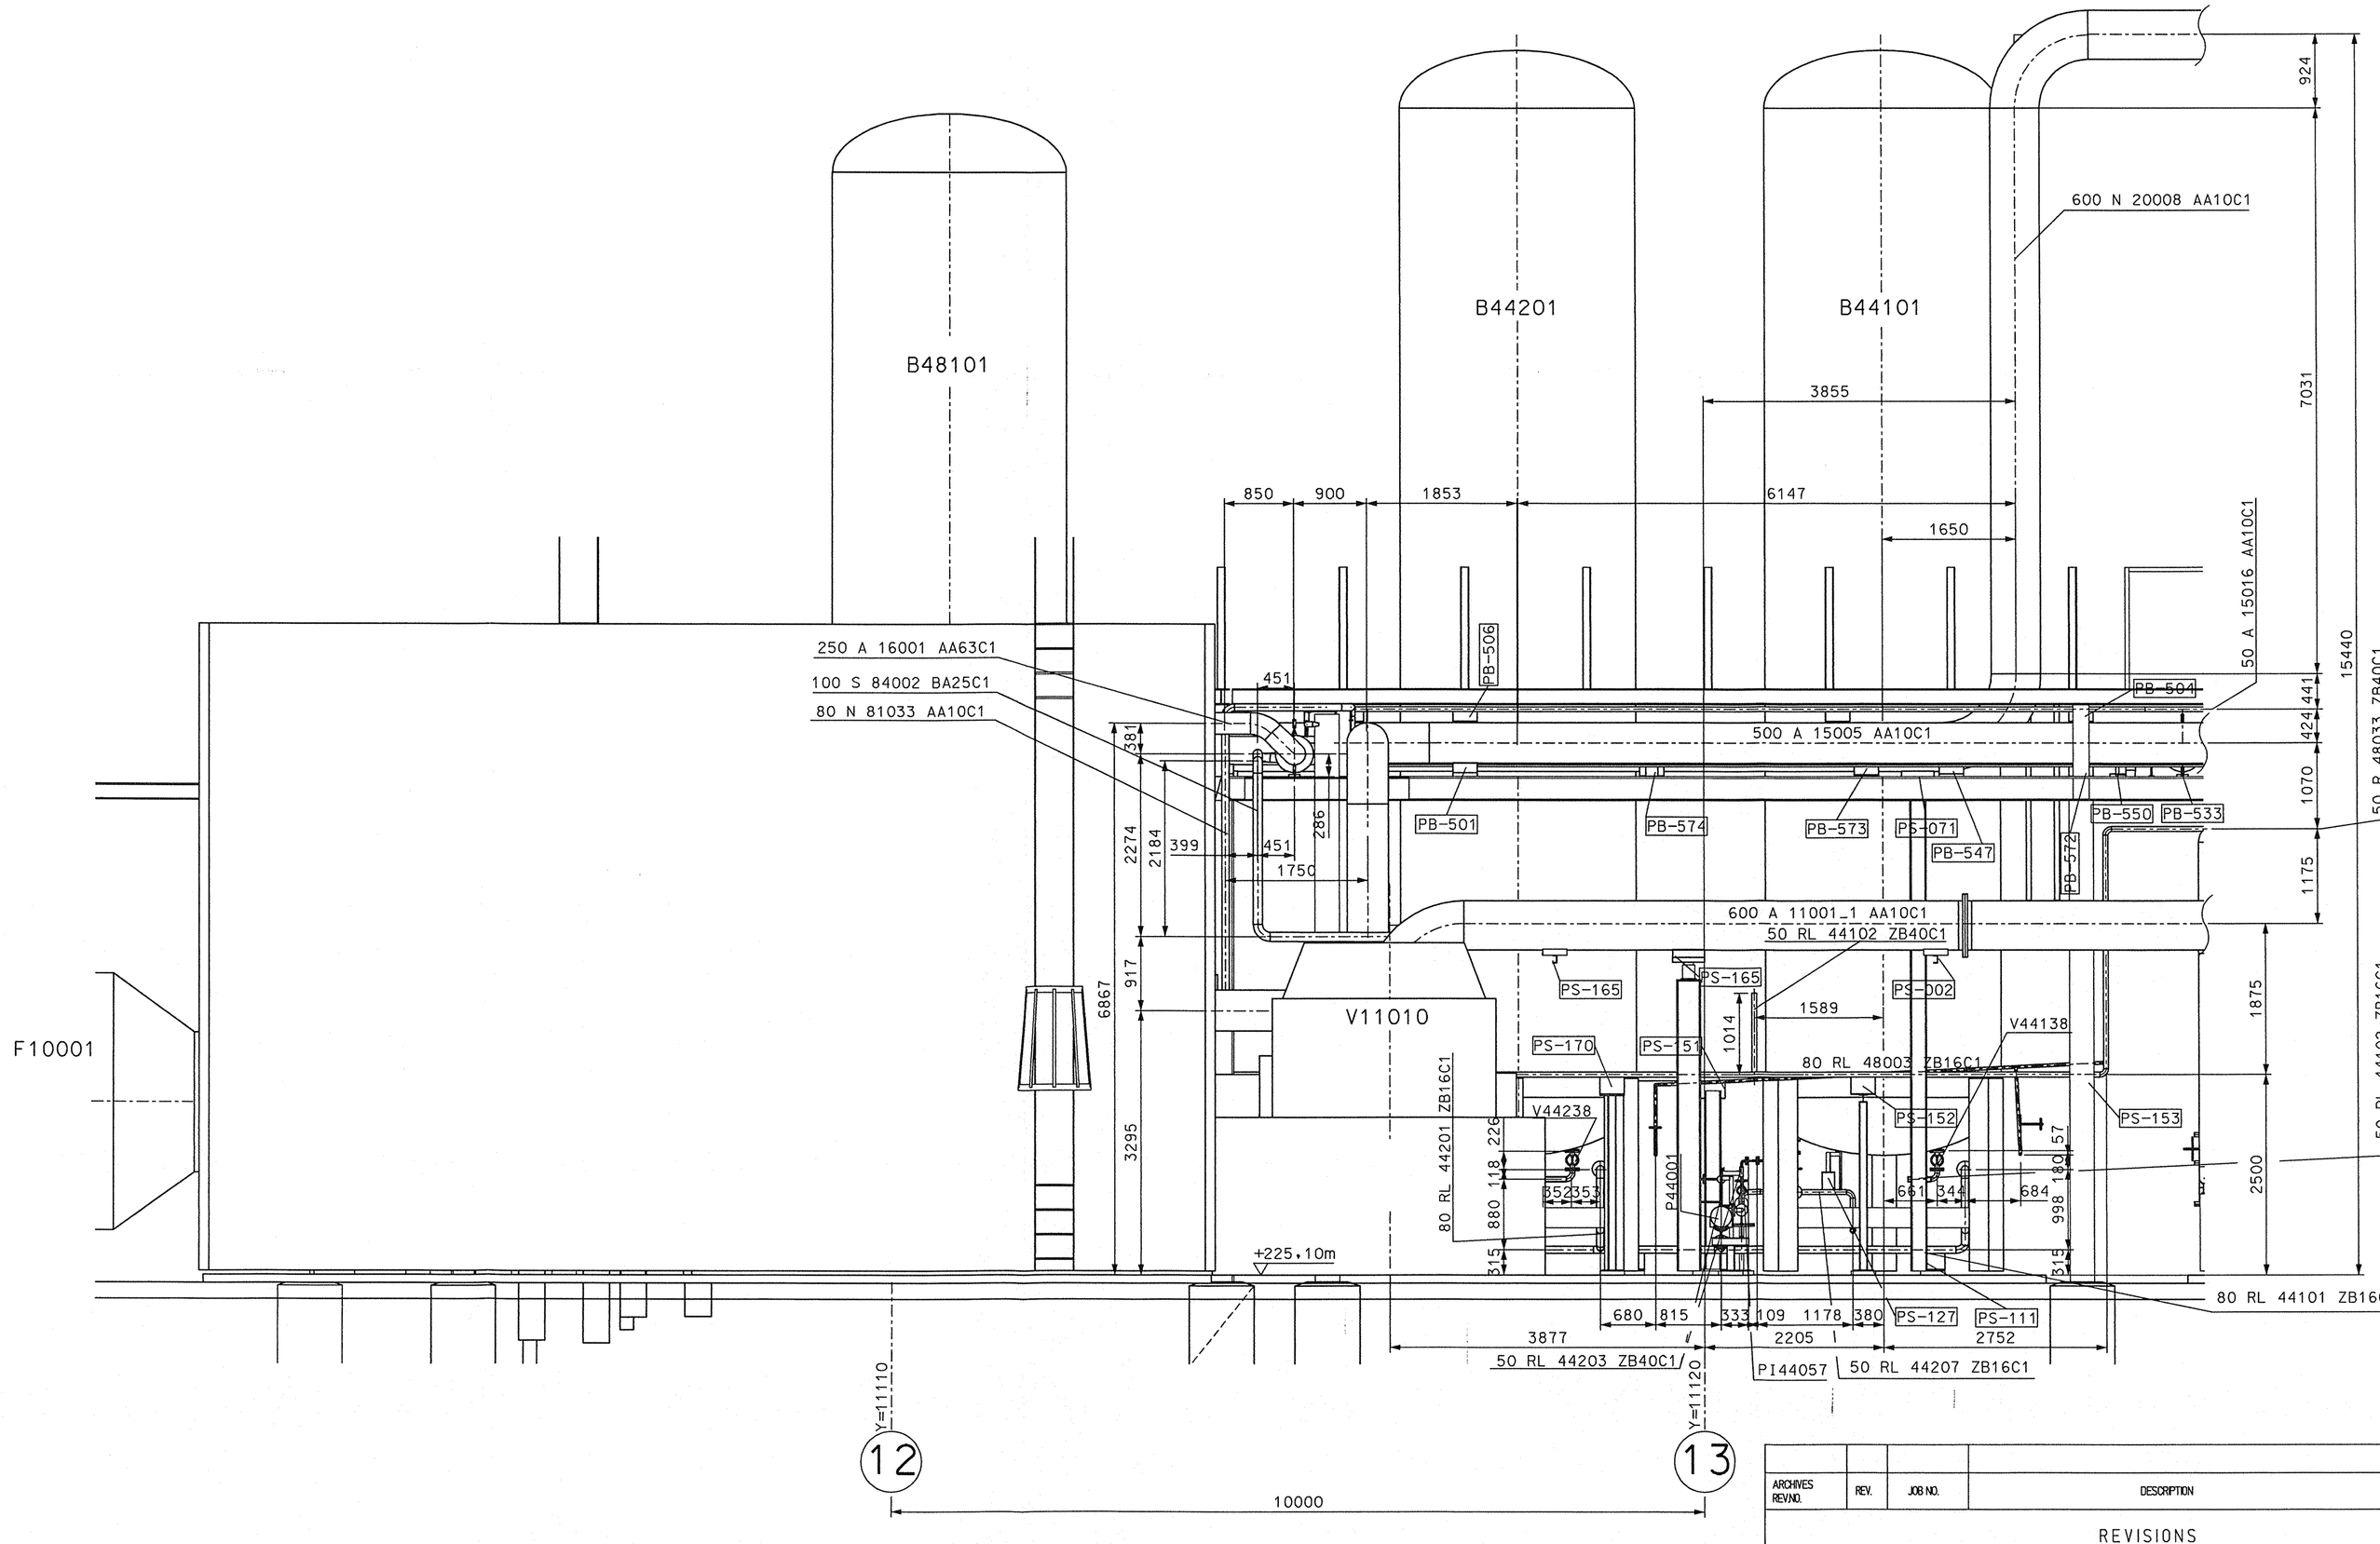

SEE DWG 792.87816

LEVELS

TOP OF INTERNAL ROADS:	225,00m n. m.
TOP OF FOUNDATION:	225,10m
BOTTOM OF STEEL STRUCTURE:	225,15 = ±0.00

Project-Nr.	CAE-Code	Drawing-No.	Rev.
9050300	RP61002	9050300-610-1	00

Rev.	drawed Date	checked Date	Input from	Pers.-No. 2039 Date 200405	Customer Air Liquide AGS
				1205 050705	Installation Kosice ASU No. 09 Building-No.

Ingenieurgesellschaft für den Anlagenbau

AIR LIQUIDE

Air Liquide AGS GmbH

DATE:	NAME:	CHECKED:	HISTORY FILE:
2005/06/20	AR	11. JUL. 2005	

JOB CODE: K70101 ASU No. 9 Kosice
REFERENCE: INSTALLATION DRAWING
SCALE 1:50 | ORIGINAL FORMAT DIN A1 | SHEET: 11 OF 19 SHEETS

REPLACES:
REPLACED BY:

TITLE: View V

DRAWING No.: 792.87817 | REV. 00

ARCHIVES REV.NO.	REV.	JOB NO.	DESCRIPTION	SIGN.	DATE

REVISIONS