


STRECHA-ROOF


M1:75

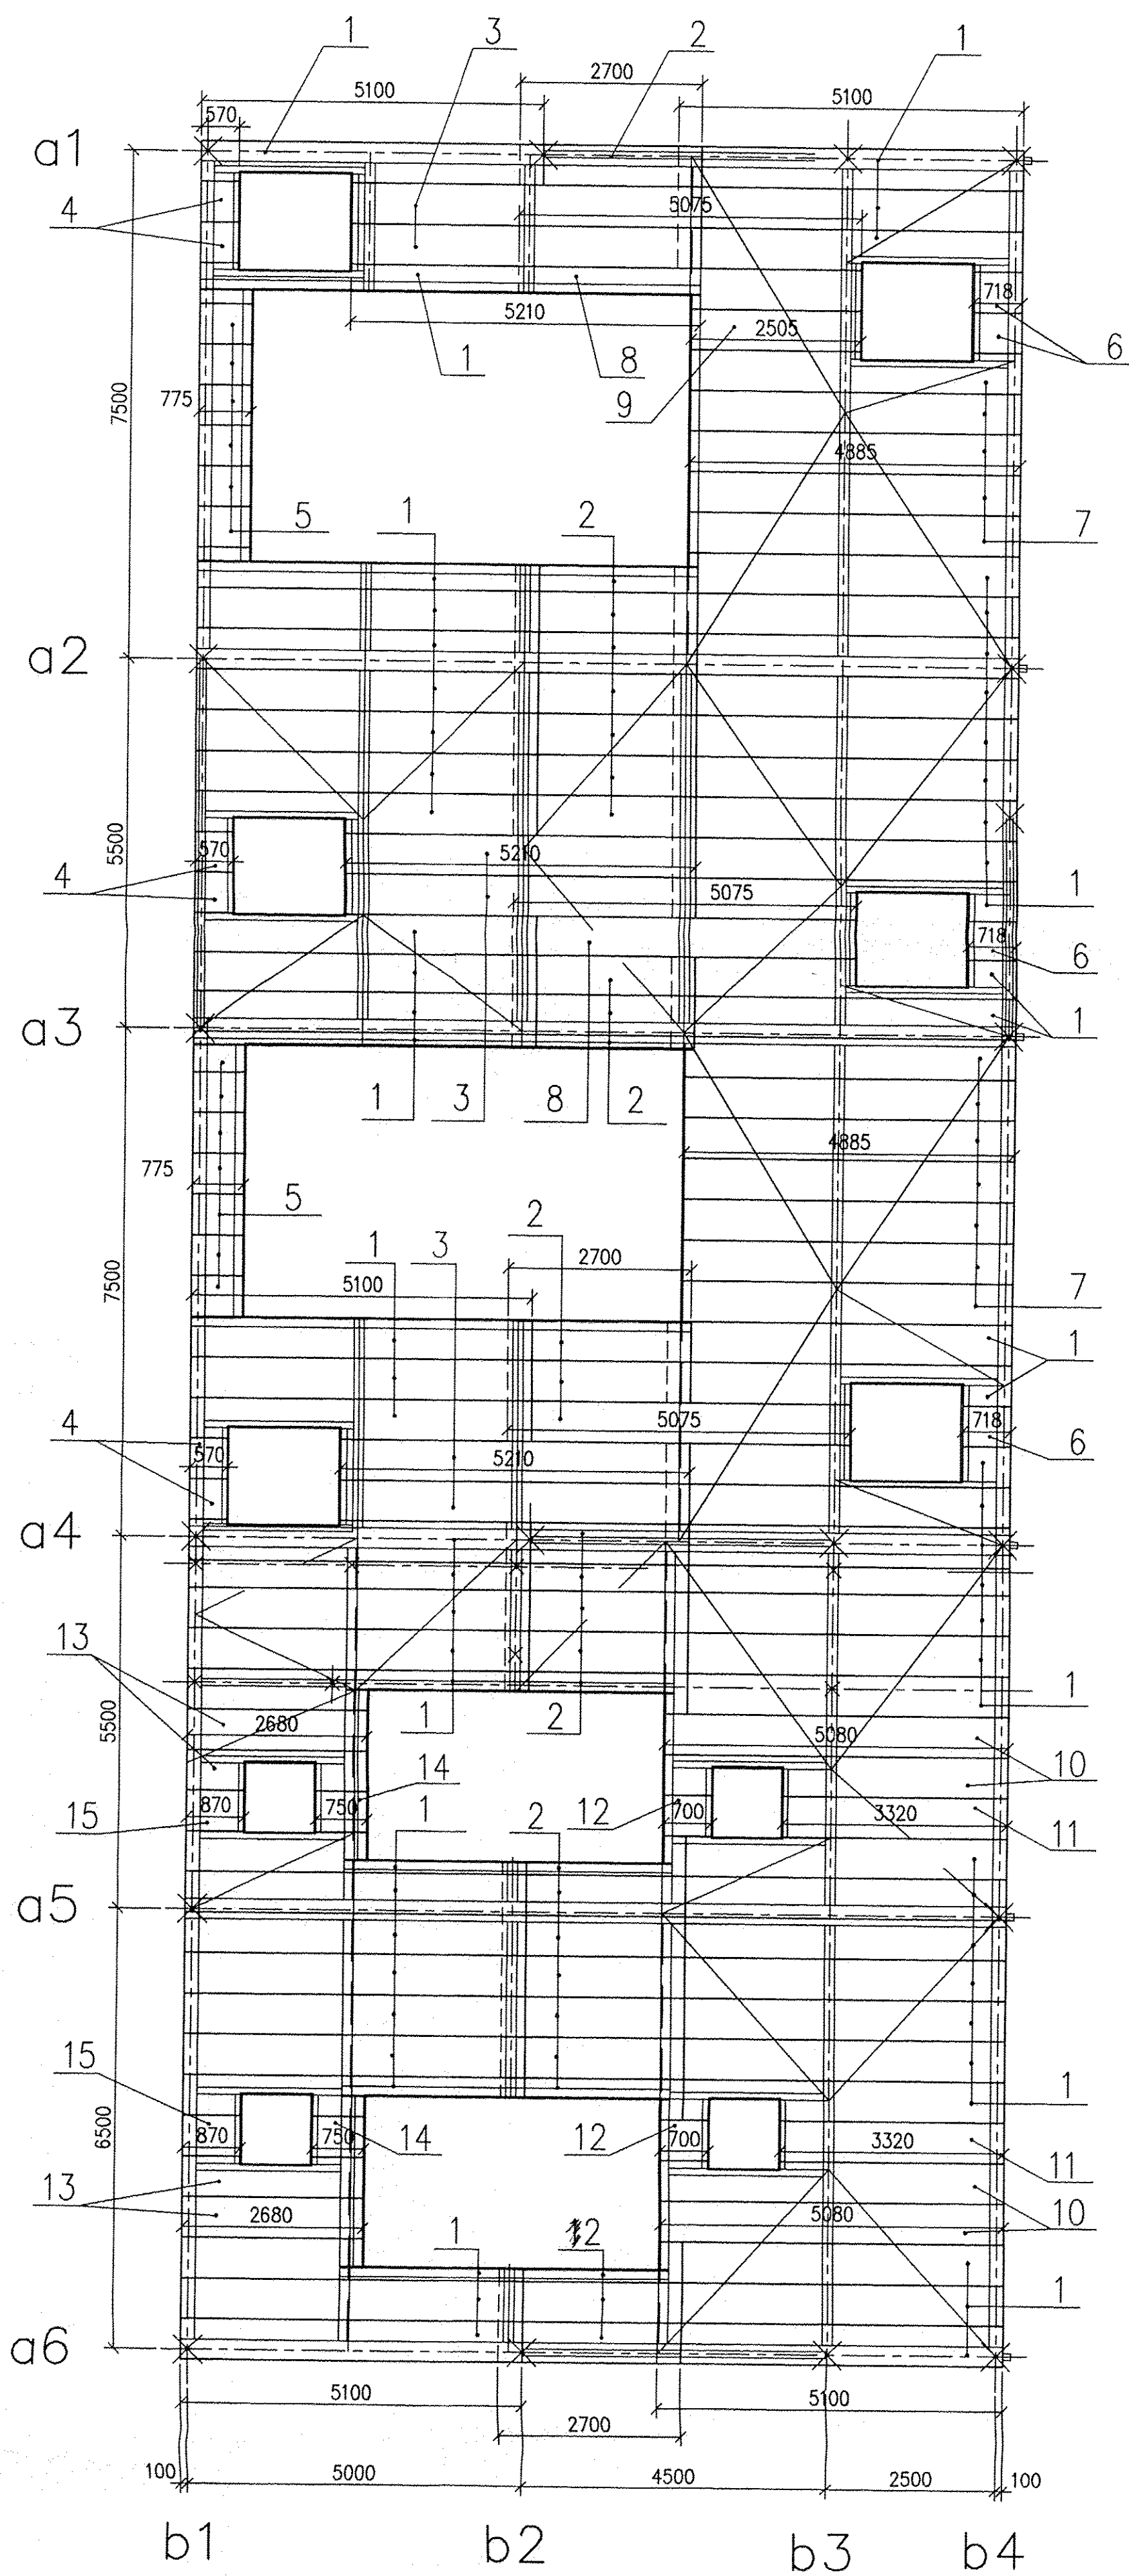

| Pol. | nazov | Dlžka | ks | Poznamky |
|------|----------|-------|----|-------------|
| 1 | OP 11001 | 5100 | 65 | pozinkovany |
| 2 | OP 11001 | 2700 | 30 | pozinkovany |
| 3 | OP 11001 | 5210 | 6 | pozinkovany |
| 4 | OP 11001 | 570 | 6 | pozinkovany |
| 5 | OP 11001 | 775 | 13 | pozinkovany |
| 6 | OP 11001 | 718 | 4 | pozinkovany |
| 7 | OP 11001 | 4885 | 12 | pozinkovany |
| 8 | OP 11001 | 5075 | 2 | pozinkovany |
| 9 | OP 11001 | 2505 | 1 | pozinkovany |
| 10 | OP 11001 | 5080 | 4 | pozinkovany |
| 11 | OP 11001 | 3320 | 2 | pozinkovany |
| 12 | OP 11001 | 700 | 2 | pozinkovany |
| 13 | OP 11001 | 2680 | 4 | pozinkovany |
| 14 | OP 11001 | 750 | 2 | pozinkovany |
| 15 | OP 11001 | 870 | 2 | pozinkovany |
| 16 | OP 11001 | 6660 | 14 | pozinkovany |
| 17 | OP 11001 | 4560 | 10 | pozinkovany |

ODOBERATELNÉ KRYTY
REMOVABLE COVERS

M1:75

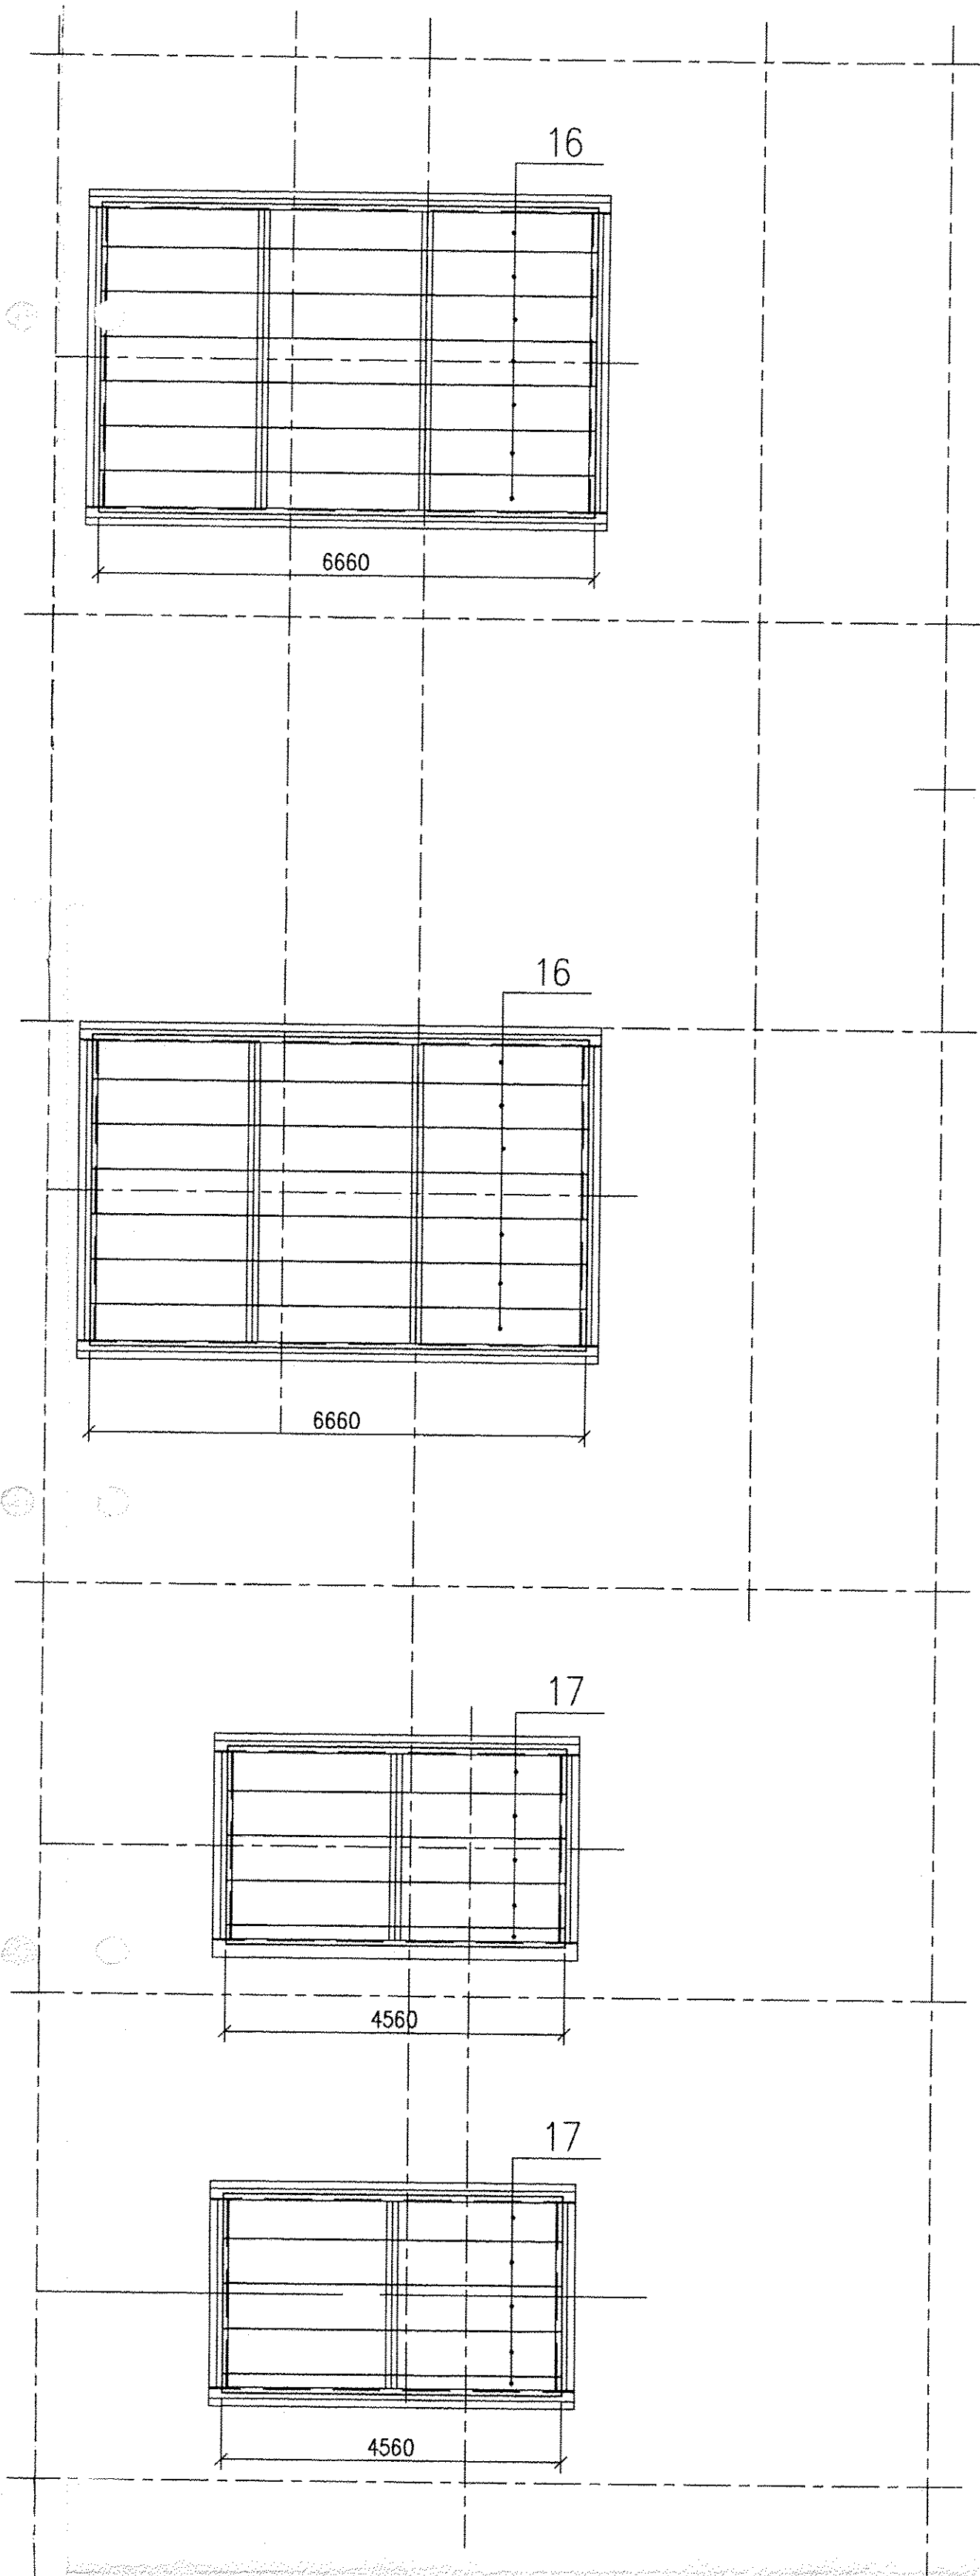

Poznamky:

-OP ku ocelovej konstr. prichytit kazdu vlnu so samoreznymi skrutkami, vzajomne spajat so samoreznymi skrutkami po 500mm.

PROJEKT SKUTOČNÉHO
VYHOTOVENIA

| | | | |
|--------------------------|-------|-------|---------------|
| KOREX PLUS | | | |
| 2005 | Date | Name | №zov: 1071 |
| Kresil | 29.08 | Kozma | №zov: 1071-08 |
| Made by | 29.08 | Kozma | №zov: 1071-08 |
| Checked | 29.08 | Kozma | №zov: 1071-08 |
| Mierka Scale 1:15 | | | |
| Názov: Title: USS-Kosice | | | |
| Zaplechovanie strechy | | | |
| Kompresorova stanica | | | |