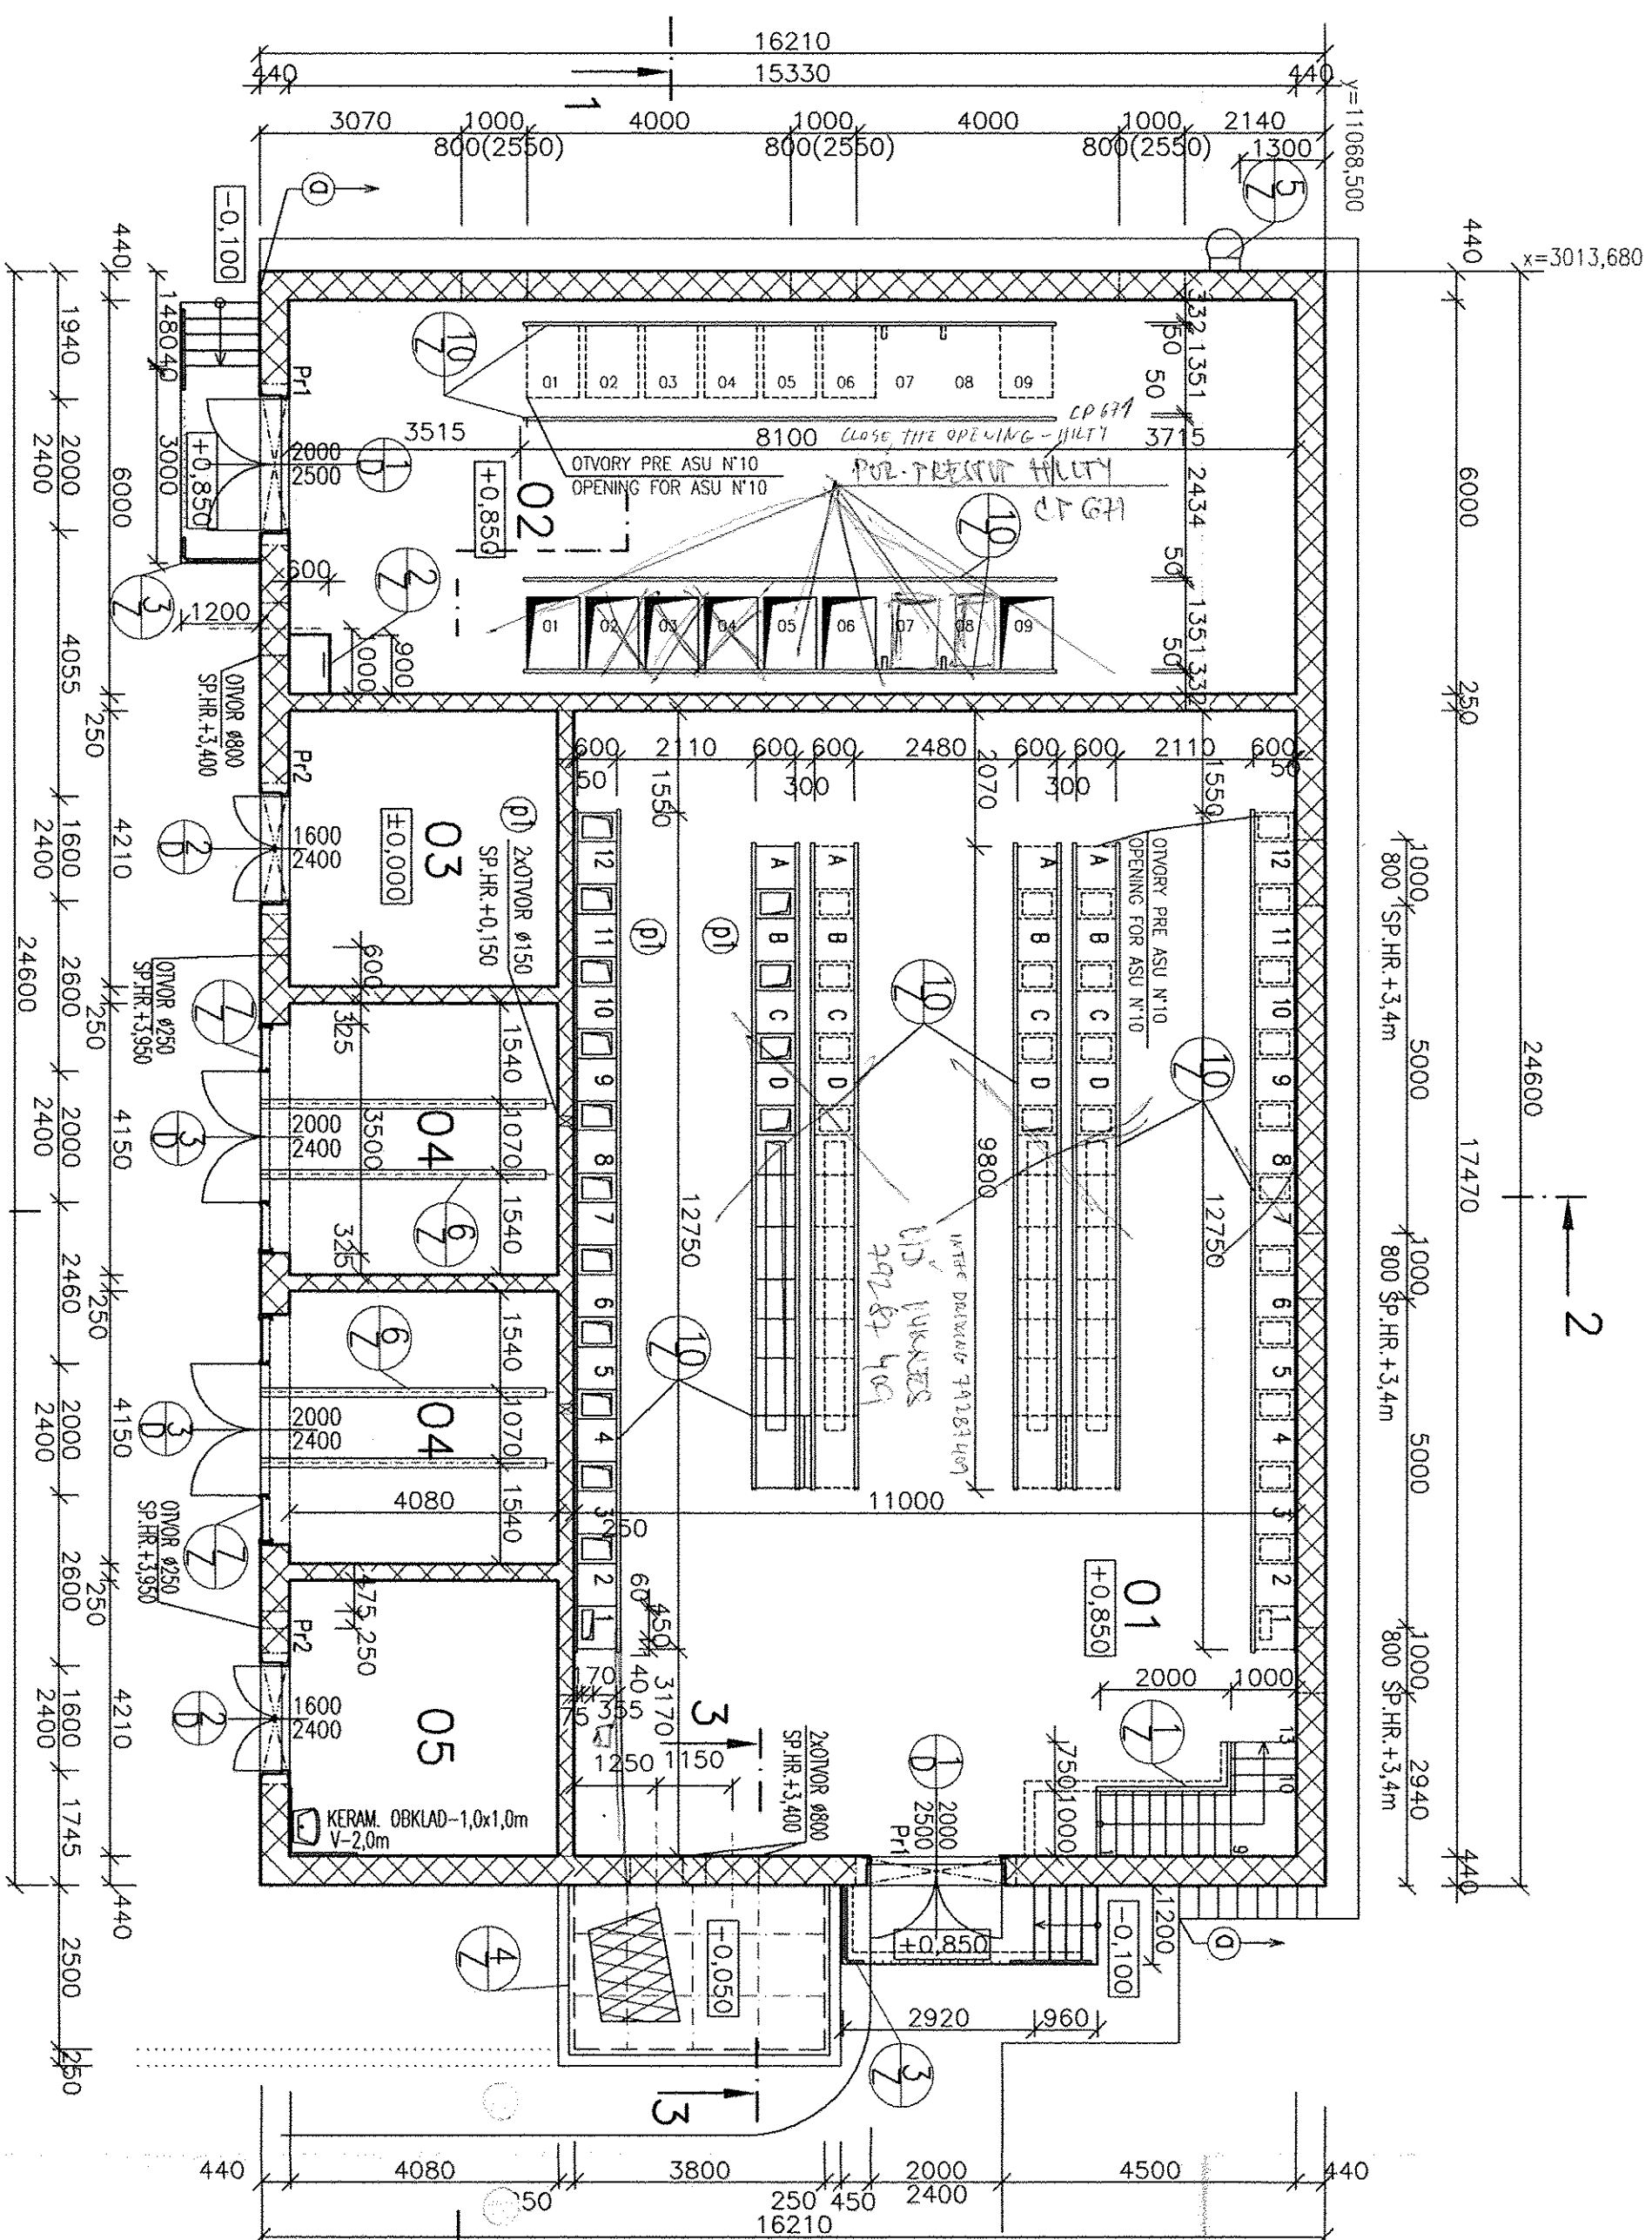


PÔDORYS $\pm 0,000/\text{PLANE}$ 

VÝKAZ PREKLADOV KP 23,8
SUMMARY OF CAPPING KP 23,8

	dzina nosmaņa length beam	svēstos atkuru speed opening	ks pieces	poēt pērkšid	poēt celkion pieces total
P1	2300	2000	2	6	12
P2	2000	1600	2	6	12

POZNÁMKY/NOTES

-REZY 1-2-2-3-3 POZRI 792.87403 A
SECTIONS 1-1-2-2; SEE 792.87403 A
-ROZERY ANDROU A STUOVANIE POZRI VYKRES 792.87400.
PRODUCTIONS OPENING SEE 792.87400 A
-LITA PODLAHA S POSTUPENNOU UPRAVOU MASTERTOP TC47.
CAST FLOOR MASTERTOP TC 472
-VYKAZ ZAMOCNICKYCH PRAC POZRI 792.87408 A
SUMMARY OF FITTING WORKS SEE 792.87408 A

1) PRESTUPY POŽIARNE UZTAVORŇ POŽIARNOU HILTI MALTOU CP 6336
 POD MALTU PRÍPEVNŇ OCELOVŮ SIEŤ
 FIRE PASSAGE CLOSE FIRE MORTAR HILTY CP 6336

⑨ OKAPOVÝ CHODNÍK 500x300x100mm TBM 8/30 34,00kg/ks 190ks
SIDE-WALK 500x300x100mm TBM 8/30 34,00kg/ks

PROJECT SKILOG

LEVELS

TOP OF INTERNAL ROADS:	225.00m n.m.
TOP OF FOUNDATION:	225.10m
BOTTOM OF STEEL STRUCTURE:	225.15m = ± 0.00


PLANT
NORTH



TENTO VÝKRES V PŮLNOH ROZSAHU NAHRÁDZA VÝKRES Č. 792.87401

 $\pm 0,000 = 225,150 \text{ m.n.m}$

SPRACOVANÉ POD ZÁKAZKOVÝM ČÍSLOM:158/2004/SO/

 KRETA-PRO spol. s r.o.				
10.06. 2003	INC.KOSTENSKÁ INC.PACEK	INC.KOSTENSKÁ INC.PACEK	ZEMIA DISPOZICE A	

		AIR LIQUIDE	
Date :	10.02. 2005	Name :	ING.KOSTENSKA
Checked:	ING.RACEK	History title:	
Job code:	K 70101	Scale	1:100
Reference:	ASU No.9 KOSICE	Original format	DIN A2
Sheet: ---	of --- Sheet		

Replaces:	79_-----	Title: ROZVODNA T81	Drawing No.:	792.87401	Rev:
Replaced by:	79_-----	ELECTRICAL ROOM T81			A
		P000RYS+0.000/PLANE+0.000			