


SKETCH DWG-NO. 792.87681


ORJEDNAT

PODORYS
SECTION PLAN

oprava vystuže

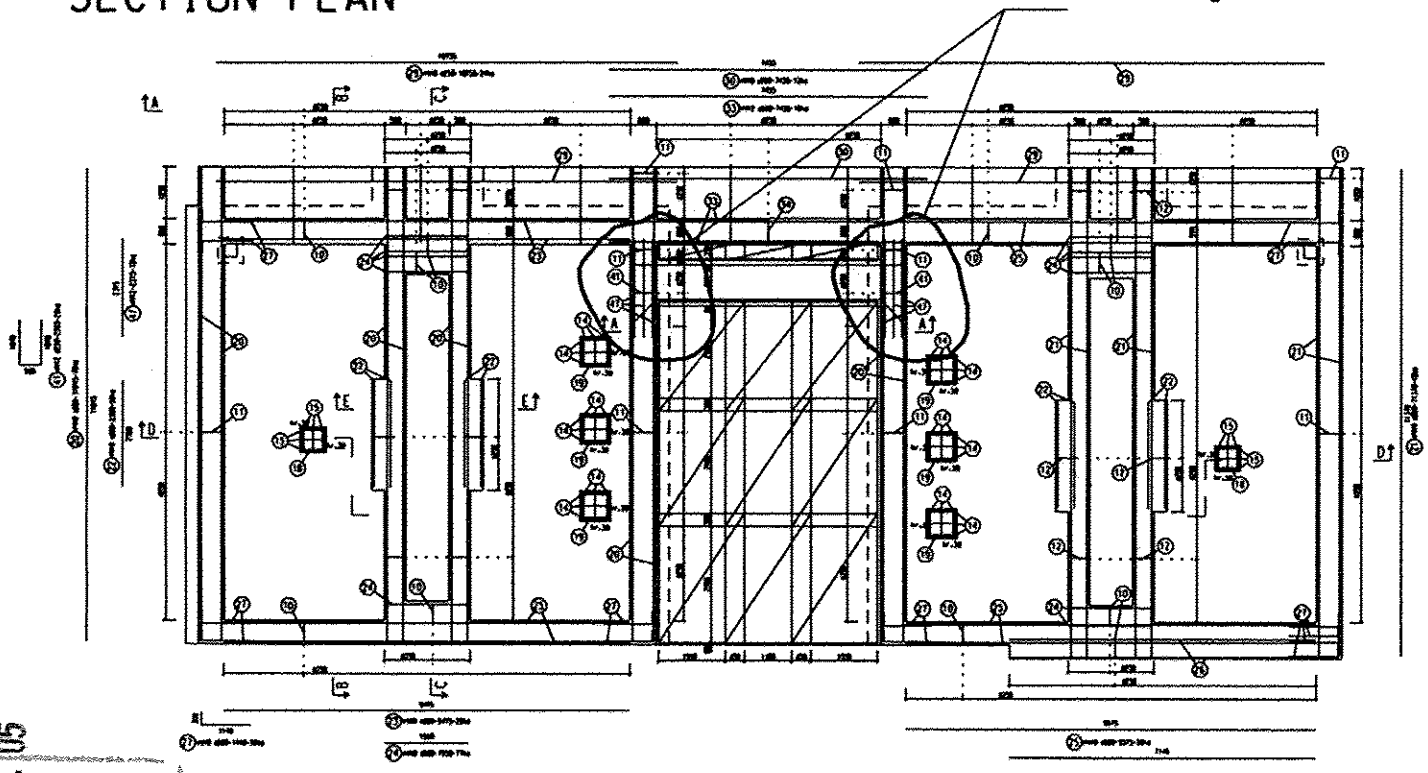


oprava vystuže / MODIFICATION OF REINFORCEMENT

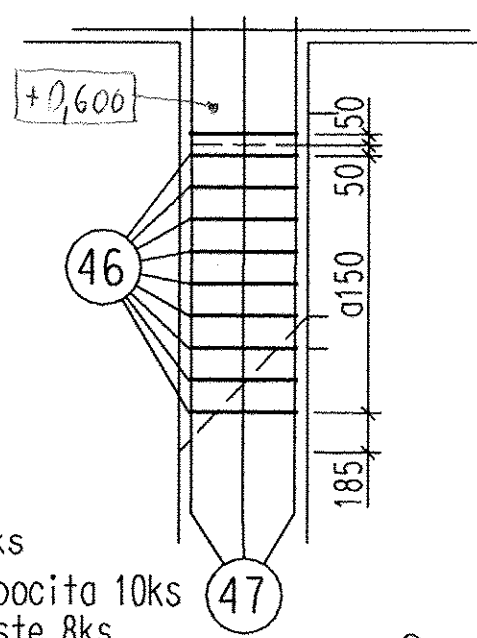

46 $\varnothing V10-1480-18ks$
povodny navrh pocita 10ks
t.j. vyrobit este 8ks
ORIGINAL PROPOSAL 10pcs
PREPARE 8pcs MORE

HS HSV s.r.o. KOŠICE
Technický úsek

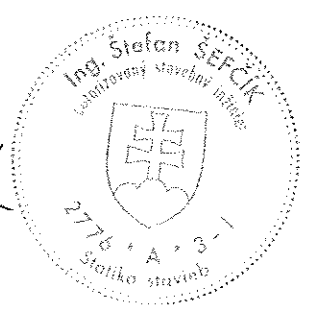

[Handwritten signature]

780

Freigabe 17.08.05
FOR CONSTRUCTION